SUITE 510

KAZ-10

K. M C.R.

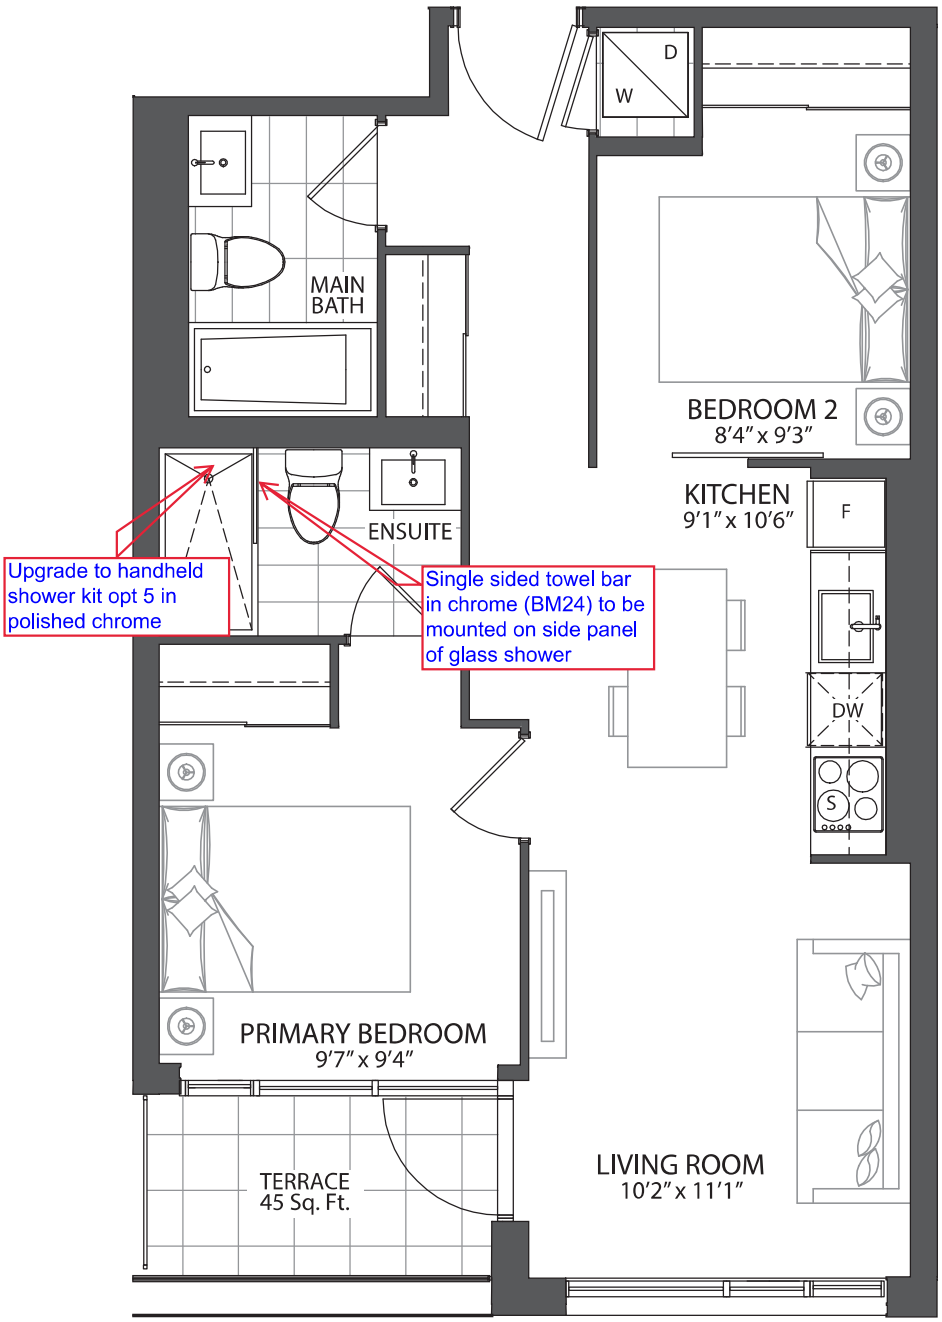

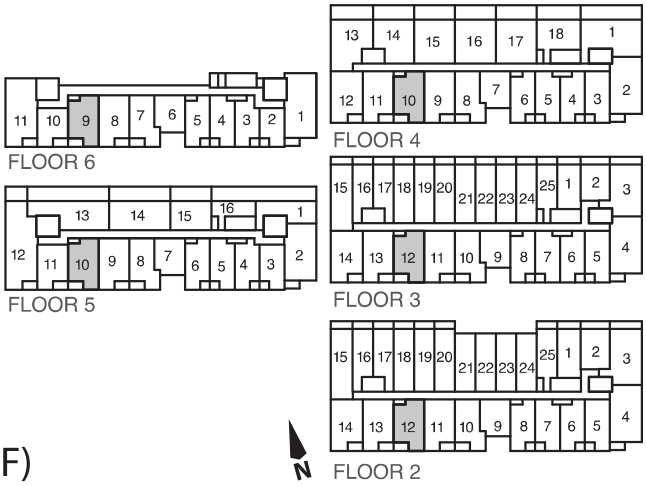

LORMEL
KAZMIR
212-312-410-510-609 - 2B (641 SF)