

3D VIEW #5

CUSTOMER APPROVAL

I have reviewed these drawings and understand the details of the layout and the Cartier Kitchens specifications.

Signature: [Signature]
Date: Feb. 22 / 12


Note: This drawing is an artistic interpretation of the general appearance of the design. It is not meant to be an exact rendition.

DESIGNED BY: LORI DISAVERIO.
DCR #74 SM5 - kitchen 2



Designed: 12/9/2011
Printed: 12/9/2011

All Drawing #: 1

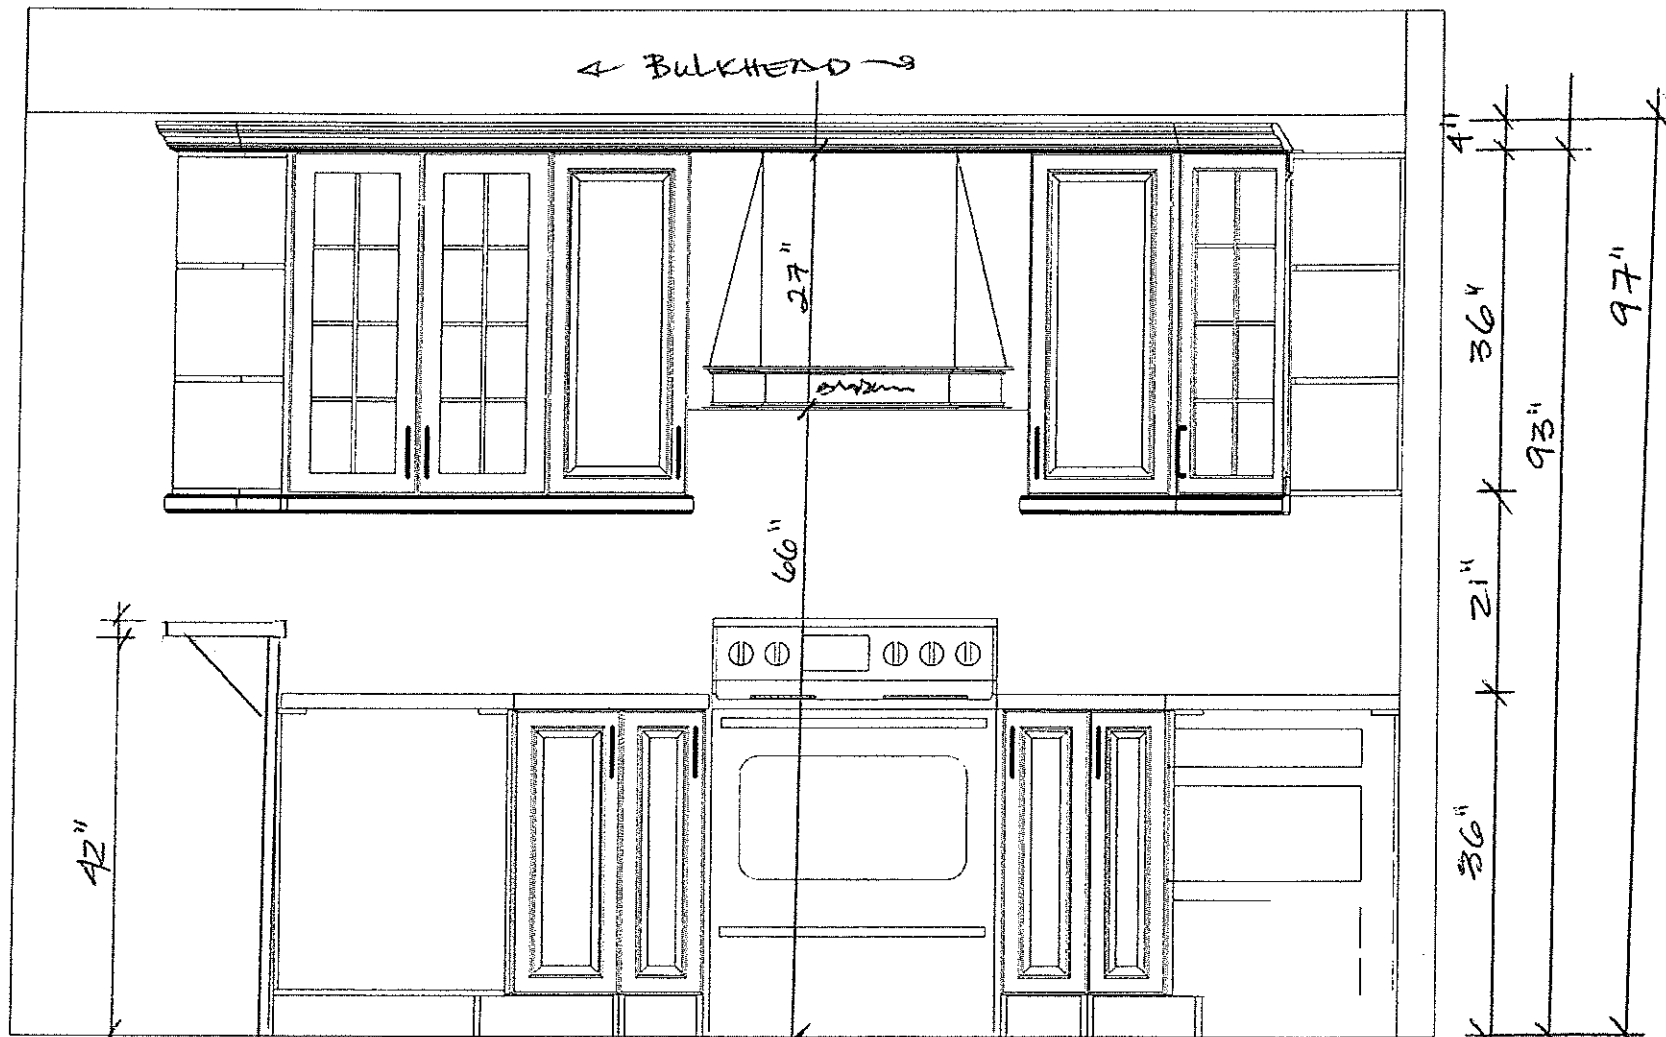

CUSTOMER APPROVAL

I have reviewed these drawings and understand the details of the layout and the Cartier Kitchens specifications.

Signature

Date

Feb. 22/12

STONE WALL ELEVATION

Note: This drawing is an artistic interpretation of the general appearance of the design. It is not meant to be an exact rendition.

DESIGNED BY: LORI DISAVERIO,
DCR #74 SM5 - kitchen 2




Designed: 12/9/2011
Printed: 12/9/2011

All

Drawing #: 1

97"
93"
36"
21"
36"
4"
4"

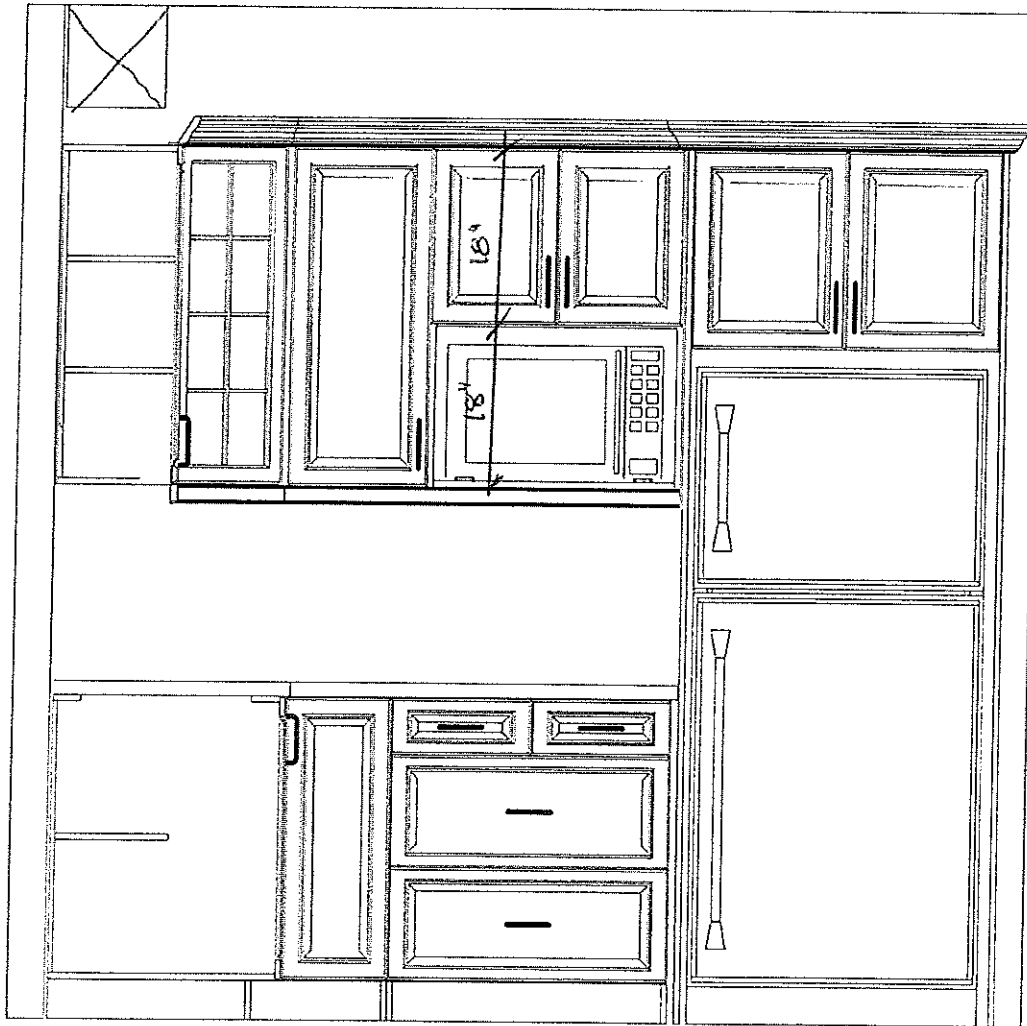

72"
93"
21"
4"
97"



FRIDGE WALL ELEVATION

CUSTOMER APPROVAL

I have reviewed these drawings and understand the details of the layout and the Cartier Kitchens specifications.

Signature [Signature]
Date Feb. 22/12

Note: This drawing is an artistic interpretation of the general appearance of the design. It is not meant to be an exact rendition.





DESIGNED BY: LORI DISAVERIO,
DCR #74 SM5 - kitchen 2

Designed: 12/9/2011
Printed: 12/9/2011

All

Drawing #: 1

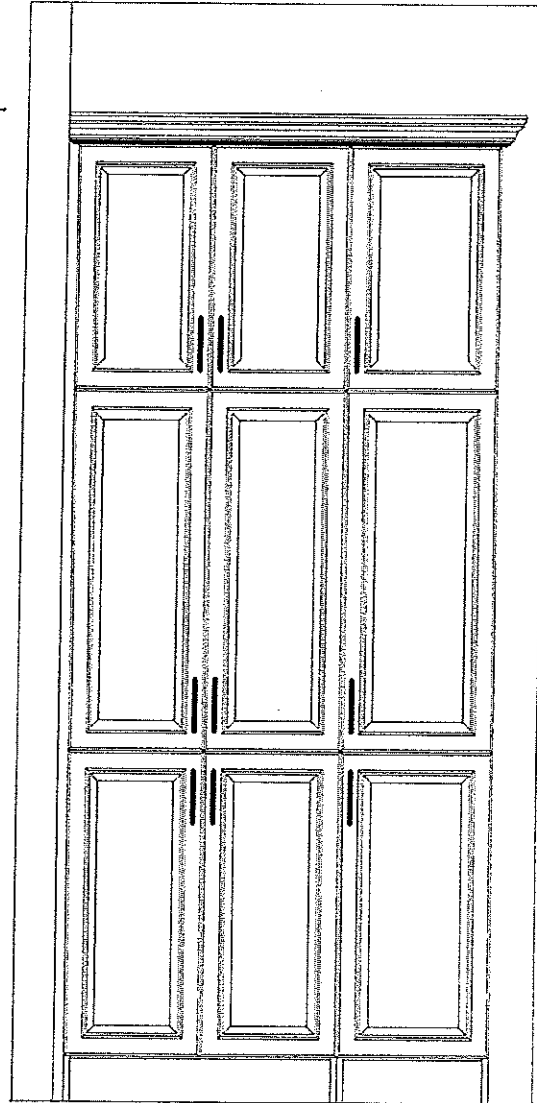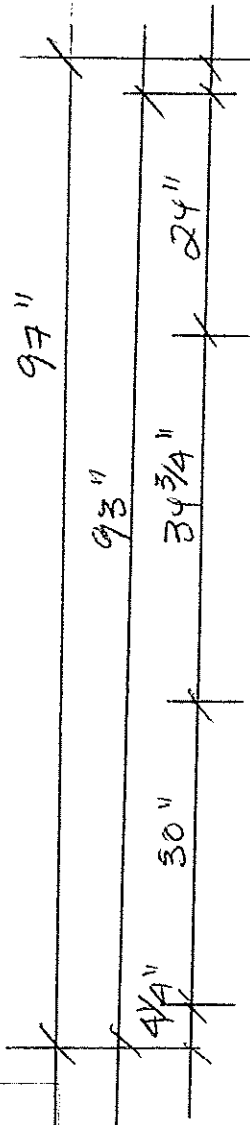

PANTRY ELEVATION

CUSTOMER APPROVAL

I have reviewed these drawings and understand the details of the layout and the Cartier Kitchens specifications.

Signature [Signature]
Date Feb. 22 / 12

Note: This drawing is an artistic interpretation of the general appearance of the design. It is not meant to be an exact rendition.

DESIGNED BY: LORI DISAVERIO.
DCR #74 SM5 - kitchen 2



Designed: 12/9/2011
Printed: 12/9/2011

All

Drawing #: 1