









 
 









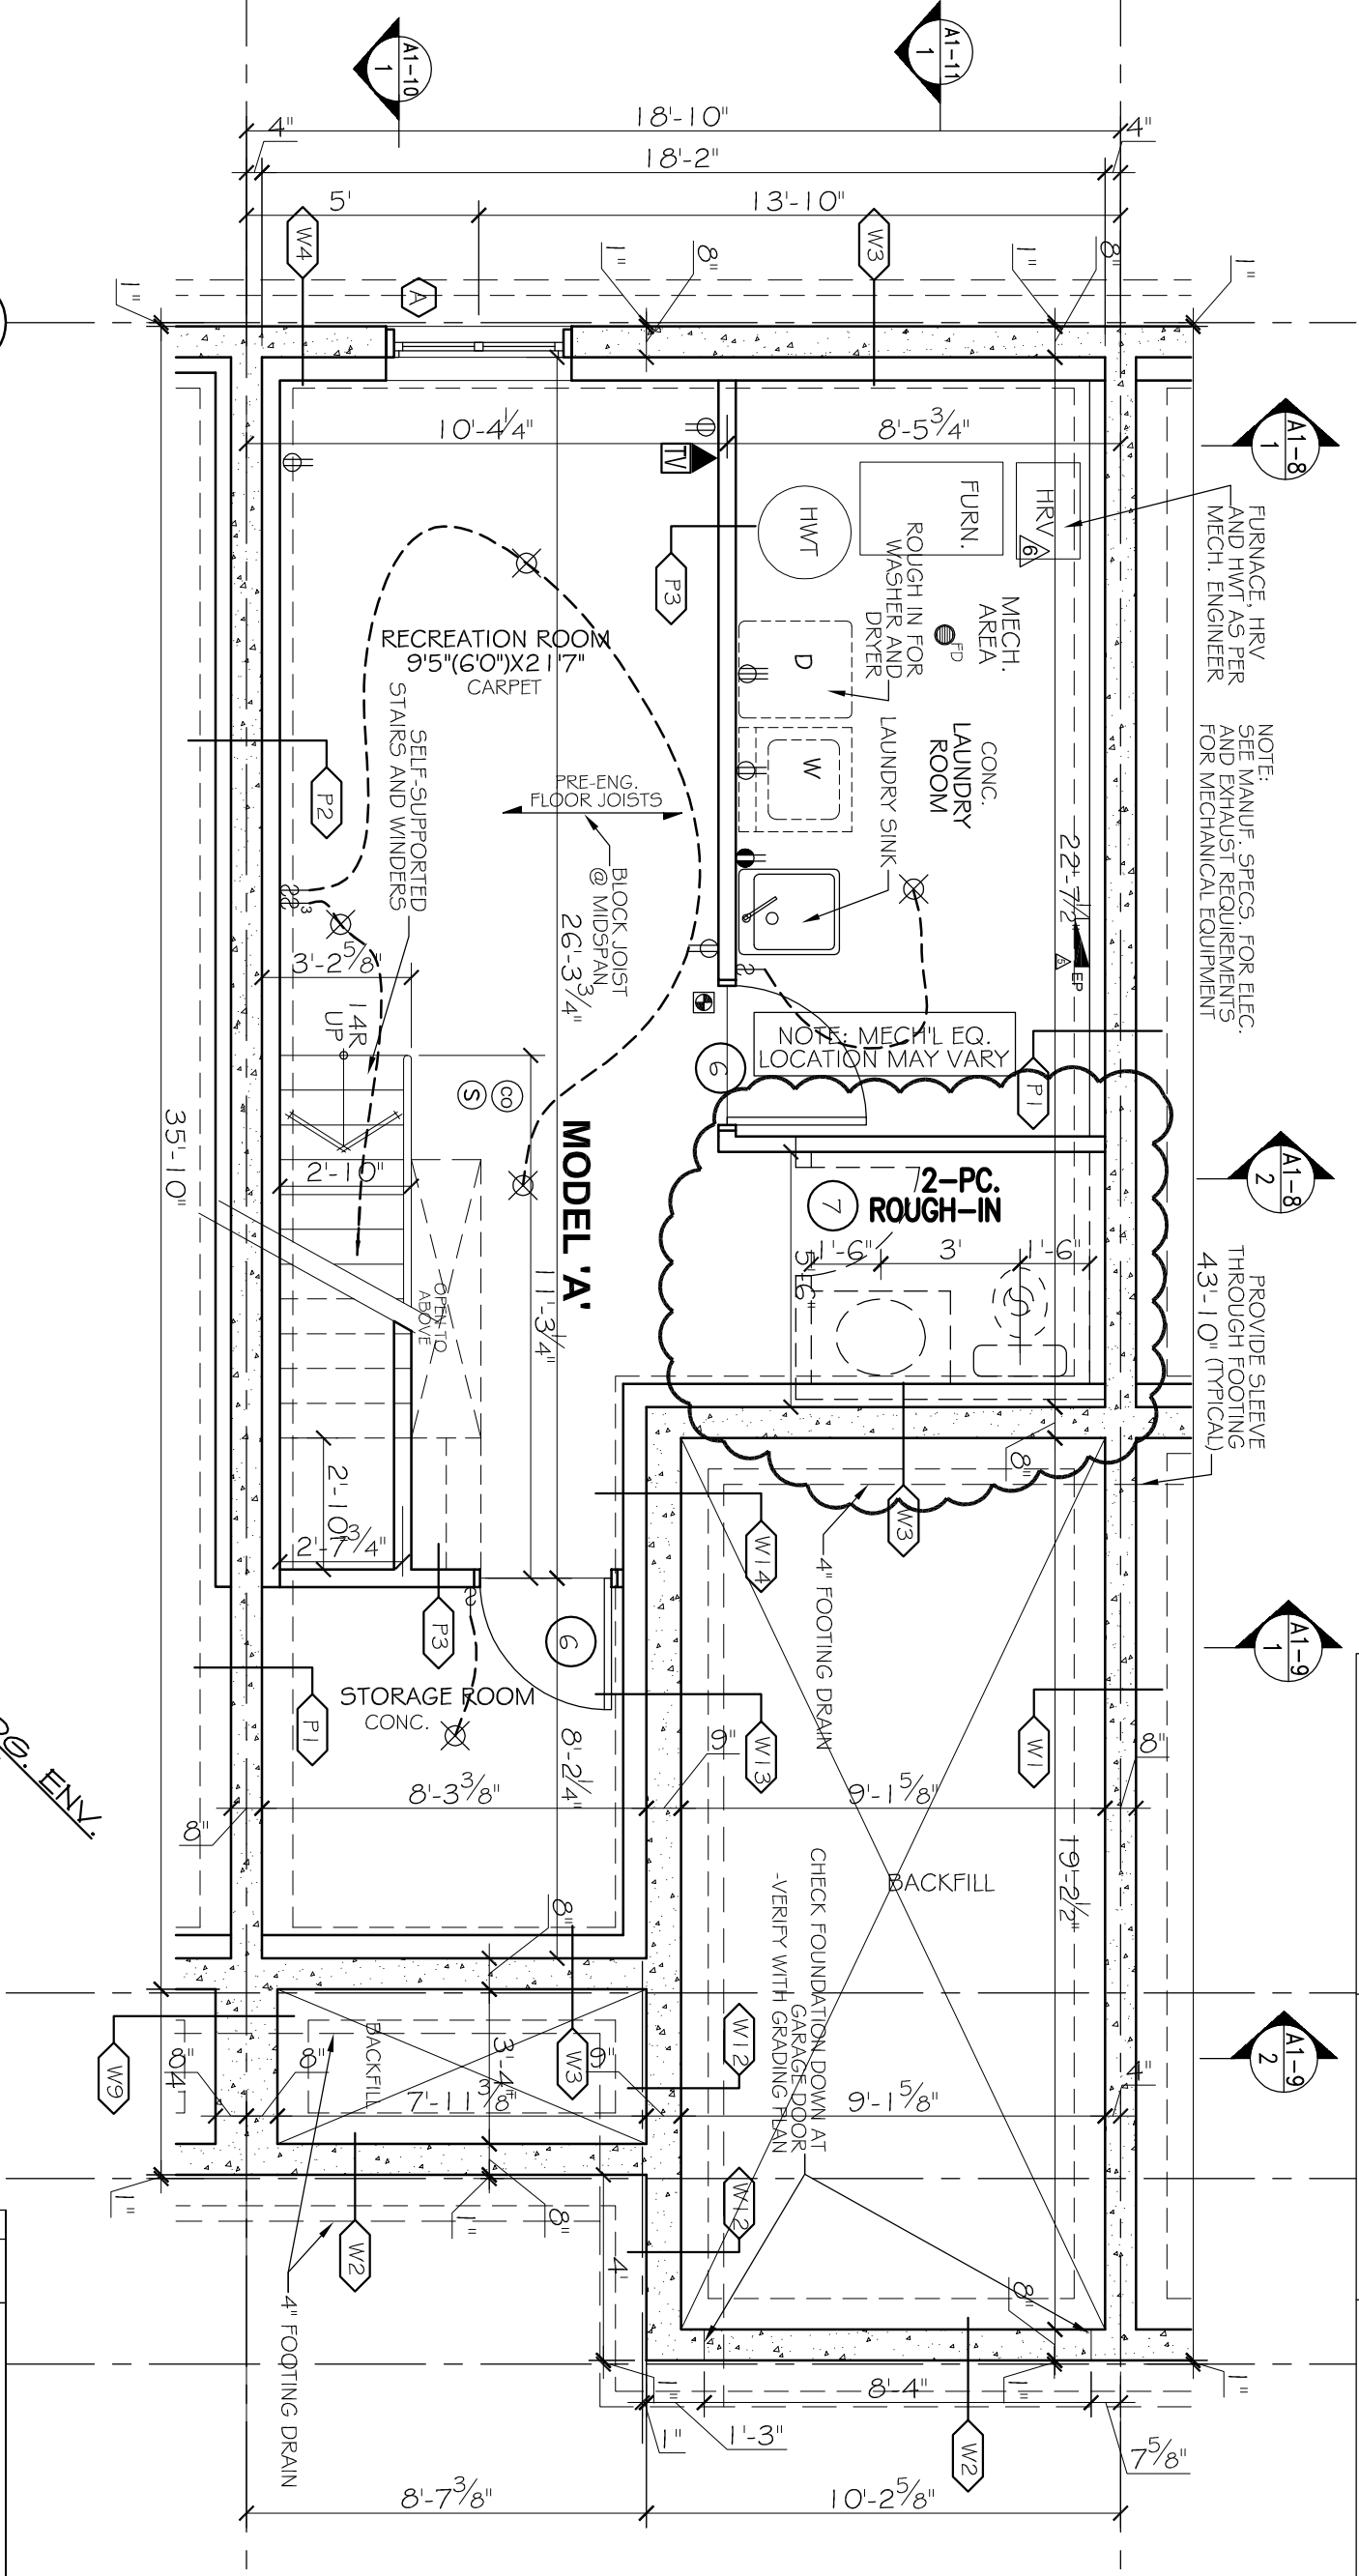


   
- NOTES
1. SEE DWG. A4 FOR WALL & PARTITION ASSEMBLIES.
 2. SEE DWG. A5 FOR DOOR AND WINDOW SCHEDULES.
 3. SEE DWGS. A6 & A7 FOR SPECIFICATIONS.
 4. PROVIDE SLEEVES WHERE FOOTING DRAIN CROSSES FOOTINGS.
 5. INTERIOR PARTITION WALLS MAY BE INCREASED TO 2x6 STUDS FOR STRUCTURAL AND PLUMBING REQUIREMENTS. ADJUST DIMENSIONS ACCORDINGLY.

- STRUCTURAL NOTES
1. SEE PRE-ENG. FLOOR JOIST AND ROOF TRUSS DWGS. FOR FLOOR JOISTS, LVLS AND ROOF TRUSSES. USE 9 1/2" PRE-ENGINEERED JOISTS FOR ALL FLOOR ASSEMBLIES. DOUBLE UP STUDS UNDER ALL LVLS TO FOUNDATION LEVEL. FLOOR JOIST AND ROOF TRUSS DWGS. TO BE REVIEWED AND APPROVED BY STRUCTURAL ENGINEER.

ELEC./MECH. LEGEND	
	FLOOR DRAIN
	SMOKE ALARM (120V)
	CARBON MONOXIDE DETECTOR
	CEILING MOUNTED INCAND. LIGHT FIXTURE
	CAPPED CEILING OUTLET
	WALL-MOUNTED INCAND. LIGHT FIXTURE
	WALL-MOUNTED EXTERIOR INCAND. LIGHT FIXTURE
	LIGHT SWITCH
	3-WAY LIGHT SWITCH
	THERMOSTAT
	120V ELECTRICAL OUTLET
	CEILING MOUNTED 120V ELECTRICAL OUTLET
	220V ELECTRICAL OUTLET
	GFI ELECTRICAL OUTLET
	SWITCH ELECTRICAL OUTLET
	EXHAUST FAN
	TELEPHONE OUTLET
	CABLE TV OUTLET
	WATER HOOKUP
	CENTRAL VACUUM
	ELECTRICAL PANEL



"MODEL A" - BASEMENT FLOOR PLAN
SCALE: 1/4"=1'

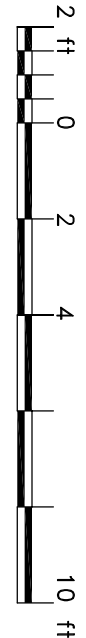


 



 
 
 












 
ISSUED FOR BLDG. ENV.
DRAFT

SPECIFIC NOTE:
SEE SHOP DRAWINGS AND THE REST OF ARCHITECTURAL & STRUCTURAL PLANS FOR COMPLETE WORKING DRAWINGS NOTES, SCHEDULES AND LEGENDS.

1	APRIL 14, 2010	ISSUED FOR BLDG. ENVELOPE ONLY

 - NOTES
1. SEE DWG. A4 FOR WALL & PARTITION ASSEMBLIES.
 2. SEE DWG. A5 FOR DOOR AND WINDOW SCHEDULES.
 3. SEE DWGS. AG & A7 FOR SPECIFICATIONS.
 4. SEE ENG. DWGS FOR FLOOR JOISTS, LVLS AND ROOF TRUSSES. USE 9 1/2" PRE-ENGINEERED JOISTS FOR ALL FLOOR ASSEMBLIES.
 5. INTERIOR PARTITION WALLS MAY BE INCREASED TO 2x6 STUDS FOR STRUTURAL AND PLUMBING REQUIREMENTS. ADJUST DIMENSIONS ACCORDINGLY.
 6. CONCRETE FRONT PORCH w/ PRE-CAST CONCRETE STEP. SLOPE TOP SURFACES 1/4" IN 12"
 7. FIRESTOP ALL PLUMBING AND ELECTRICAL PENETRATIONS AT PARTY WALL.

  - STRUCTURAL NOTES
1. SEE PRE-ENG. FLOOR JOIST AND ROOF TRUSS DWGS. FOR FLOOR JOISTS, LVLS AND ROOF TRUSSES. USE 9 1/2" PRE-ENGINEERED JOISTS FOR ALL FLOOR ASSEMBLIES. DOUBLE UP STUDS UNDER ALL LVLS TO FOUNDATION LEVEL. FLOOR JOIST AND ROOF TRUSS DWGS. TO BE REVIEWED AND APPROVED BY STRUCTURAL ENGINEER.

ELEC./MECH. LEGEND	
	FLOOR DRAIN
	SMOKE ALARM (120V)
	CARBON MONOXIDE DETECTOR
	CEILING MOUNTED INCAND. LIGHT FIXTURE
	CAPPED CEILING OUTLET
	WALL-MOUNTED INCAND. LIGHT FIXTURE
	WALL-MOUNTED EXTERIOR INCAND. LIGHT FIXTURE
	LIGHT SWITCH
	3-WAY LIGHT SWITCH
	THERMOSTAT
	120V ELECTRICAL OUTLET
	CEILING MOUNTED 120V ELECTRICAL OUTLET
	220V ELECTRICAL OUTLET
	GFI ELECTRICAL OUTLET
	SWITCH ELECTRICAL OUTLET
	EXHAUST FAN
	TELEPHONE OUTLET
	CABLE TV OUTLET
	WATER HOOKUP
	CENTRAL VACUUM
	ELECTRICAL PANEL

- NOTES
1. F.T.O.L.
- DO NOT SCALE DRAWINGS
- ALL DIMENSIONS TO BE VERIFIED ON SITE AND REPORT ANY ERRORS TO BUILDER
- ALL FINISHES TO BE COORDINATED ON SITE BY BUILDER
- ALL MATERIALS TO BE USED SHALL BE APPROVED BY THE ARCHITECT
- ALL ELECTRICAL & MECHANICAL SHALL CONFORM TO MINIMUM A.S.P. & I.E.C. STANDARDS
- ALL DIMENSIONS FOR WALLS ARE TAKEN FROM CENTERLINE OF PARTITION WALLS, EXCEPT FACE OF EX. WALLS, MINOR FACE OF EXTERIOR WALLS, AND CENTERLINE OF PARTITION WALLS
- ALL AREA CALCULATIONS ARE DETERMINED FROM OUTSIDE WALLS
- ALL DIMENSIONS SHALL NOT BE USED FOR CONSTRUCTION
- ALL DIMENSIONS SHALL BE SHOWN AND SIGNED BY THE ARCHITECT

- LEGEND
- WALL / PARTITION ASSEMBLY
 - DOOR TYPE
 - WINDOW TYPE
 - STRUCTURAL NOTE


STRUCTURAL DESIGN BY
JOHN STUART HALL, P. ENG.
FOR THE ARCHITECT
THIS DRAWING IS THE PROPERTY OF THE ARCHITECT
AND IS NOT TO BE REPRODUCED OR USED FOR CONSTRUCTION
WITHOUT THE WRITTEN PERMISSION OF THE ARCHITECT

5	JAN. 2013	REISSUED FOR PERMIT
4	APR. 2012	REVISED TO MEET CBC 98.12
3	DEC. 2011	REVISED AS PER STRUCTURAL
2	DEC. 2011	ISSUED FOR PERMIT
1	OCT. 2010	ISSUED FOR PRELIM. REVIEW
AA	DATE	REVISION

DO NOT SCALE THIS DRAWING - FIELD DIMENSIONS ONLY

THIS DRAWING SHALL NOT BE USED FOR CONSTRUCTION PURPOSES UNTIL SIGNED BY THE ARCHITECT

SignedSeal3.jpg

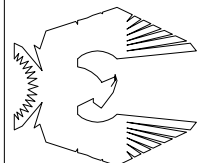


PROJECT
SAWGRASS TOWNS
JOCKVALE RD.
OTTAWA, ON


DRAWING NAME
"MODEL A REVERSED"
GROUND FLOOR PLAN

DRAWN BY	RDB	DATE	OCT. 1, 2010
SCALE	1/4" = 1'	DRAWING NO.	A1-2
JOB NO.	967		

MORRIS MELAMED
architect - ottawa
(613) 727-7400 FAX (613) 727-7334

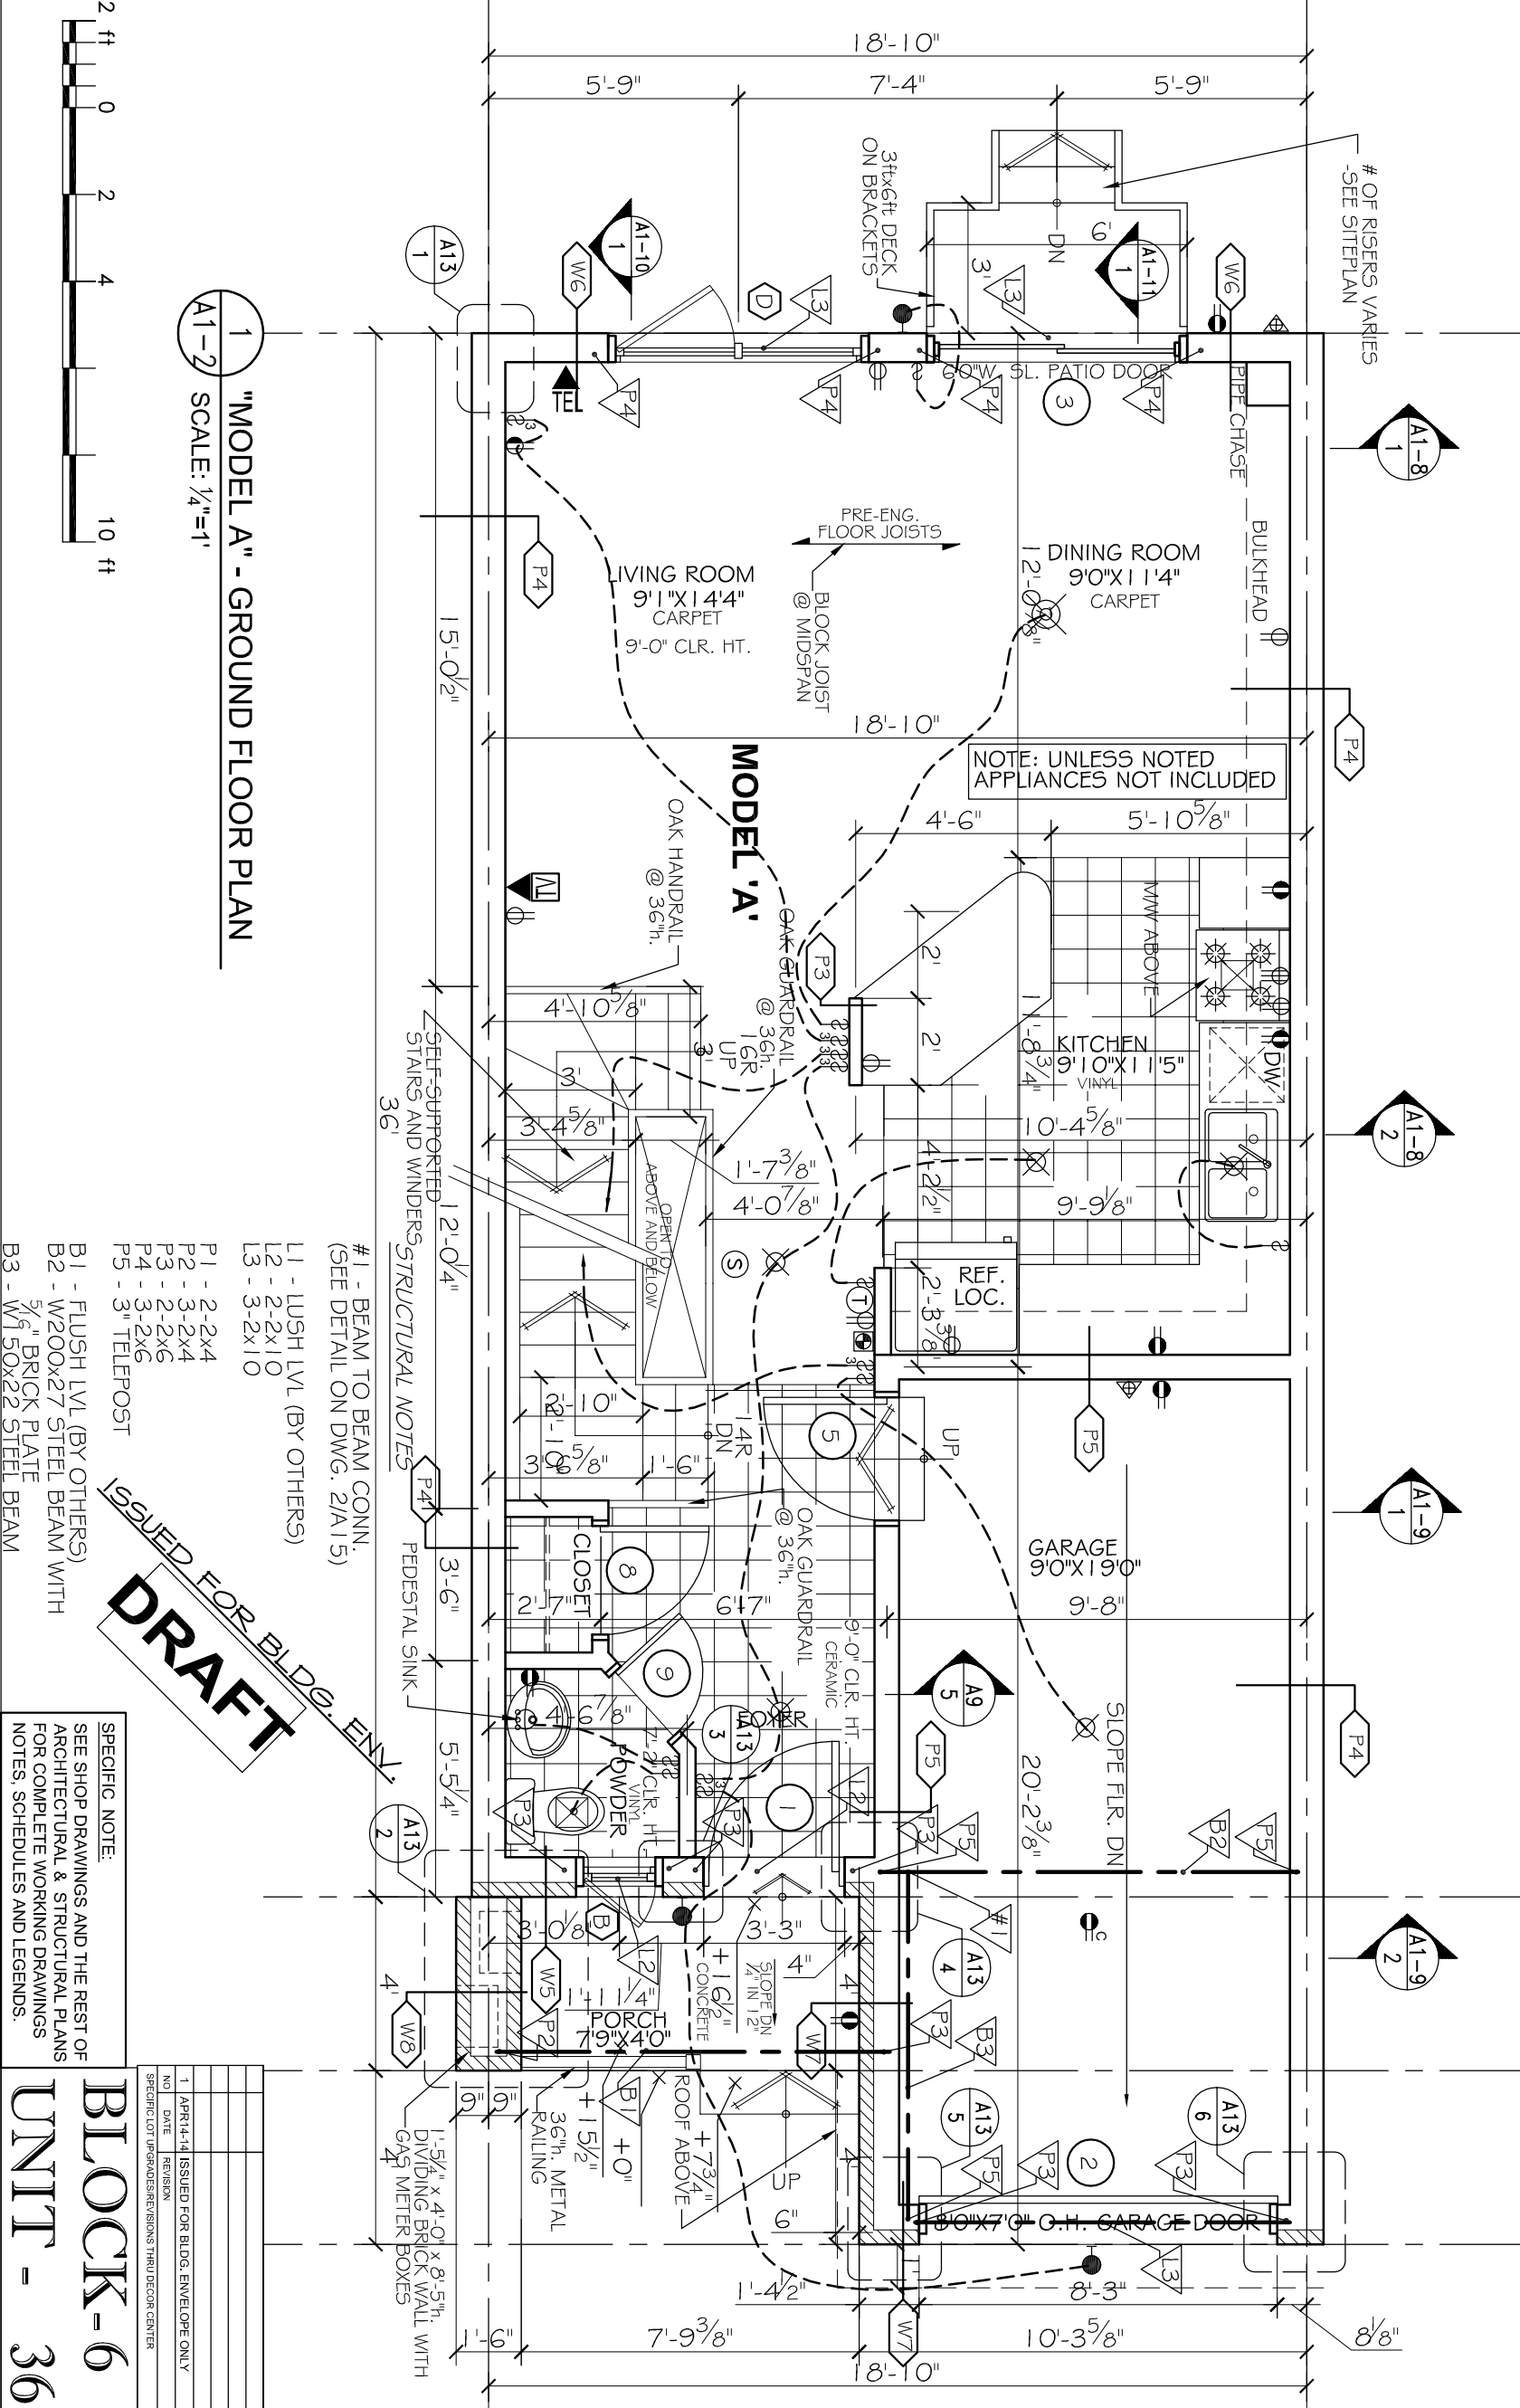

"MODEL A" - GROUND FLOOR PLAN
SCALE: 1/4"=1'

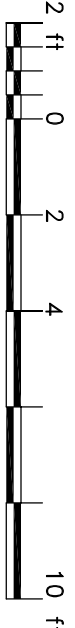

- STRUCTURAL NOTES
- #1 - BEAM TO BEAM CONN. (SEE DETAIL ON DWG. 2/A115)
 - L1 - LUSH LVL (BY OTHERS)
 - L2 - 2-2x10
 - L3 - 3-2x10
 - P1 - 2-2x4
 - P2 - 3-2x4
 - P3 - 2-2x6
 - P4 - 3-2x6
 - P5 - 3" TELEPOST
 - B1 - FLUSH LVL (BY OTHERS)
 - B2 - W200x27 STEEL BEAM WITH 5/8" BRICK PLATE
 - B3 - W150x22 STEEL BEAM

SPECIFIC NOTE:
SEE SHOP DRAWINGS AND THE REST OF ARCHITECTURAL & STRUCTURAL PLANS FOR COMPLETE WORKING DRAWINGS NOTES, SCHEDULES AND LEGENDS.

1	DATE	REVISION
1	APRIL 14	ISSUED FOR BLDG. ENVELOPE ONLY
		SPECIFIC LOT UPDATES/REVISIONS THRU DECOR CENTER

BLOCK-6
UNIT - 36

NOTES

DO NOT SCALE DRAWINGS
ALL DIMENSIONS TO BE VERIFIED ON SITE AND REPORT ANY ERRORS TO BUILDER
SPECIES AND GRADES TO BE CONFIRMED ON SITE BY BUILDER
CHECK FOR UNUSUAL SOILS TO BE REMOVED OR STABILIZED
MECHANICAL & ELECTRICAL SHALL CONFORM TO PROVINCIAL & MUNICIPAL CODES & BY-LAWS
DO NOT SCALE DRAWINGS
CHECK WITH MANUFACTURER FOR EXACT ROOF DRAINING REQUIREMENTS FOR ALL DOORS & WINDOWS
DIMENSIONS FOR WALLS ARE TAKEN FROM CENTRELINE OF PARTITION WALLS, EXTERIOR FACE OF EX. WALLS, AND/OR FACE OF CONCRETE AND CONCRETE BLOCK WALLS.
ALL AREA CALCULATIONS ARE OBTAINED FROM OUTSIDE SURFACE OF EXTERIOR WALLS AND CENTRELINE OF PARTITION WALLS.
THIS DRAWING SHALL NOT BE USED FOR CONSTRUCTION PURPOSES UNLESS SHOWN AND SIGNED BY THE ARCHITECT.


LEGEND

6	JAN. 2013	REISSUED FOR PERMIT
5	JUL. 10/12	FOOTING & USE REVISED. CIRC. VENT & BAND REV.
4	APR. 20/12	REVISED TO MEET CBC 58.42
3	DEC. 20/11	REVISED AS PER STRUCTURAL
2	DEC. 7/11	ISSUED FOR PERMIT
1	OCT. 1/10	ISSUED FOR PRELIM. REVIEW
AA	DATE	REVISION

DO NOT SCALE THIS DRAWINGS - READ DIMENSIONS ONLY

THIS DRAWING SHALL NOT BE USED FOR CONSTRUCTION PURPOSES UNTIL SIGNED BY THE ARCHITECT

SignedSeal3.jpg

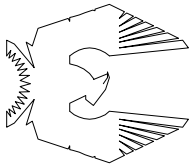

PHOENIX HOMES

PROJECT
SAWGRASS TOWNS
JOCKVALE RD.
OTTAWA, ON


DRAWING NAME

"MODEL A REVERSED"
ELEVATIONS

DRAWN BY	RDB	DATE	OCT. 1, 2010
SCALE	3/16" = 1'	DRAWING NO.	A1-4
JOB NO.	967		

MORRIS MELAMED
architect - ottawa


(613) 727-7400 FAX (613) 727-7334

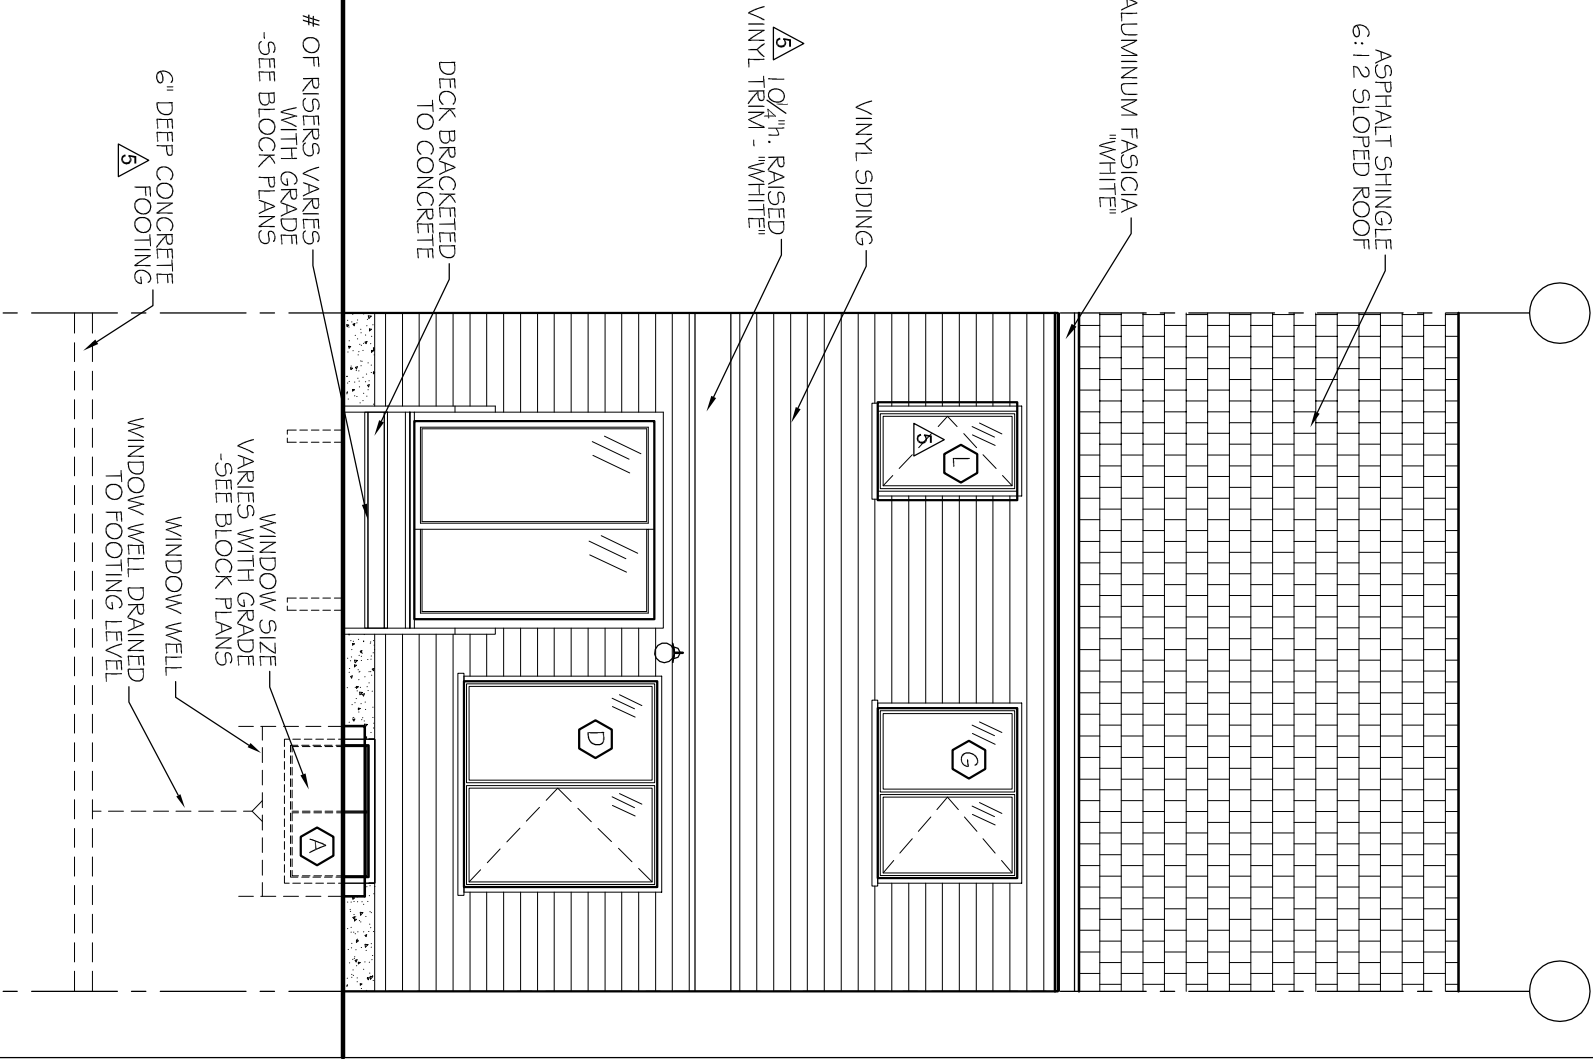

"MODEL A" - TYPICAL UNIT
REAR ELEVATION

SCALE: 3/16"=1'

A1-4

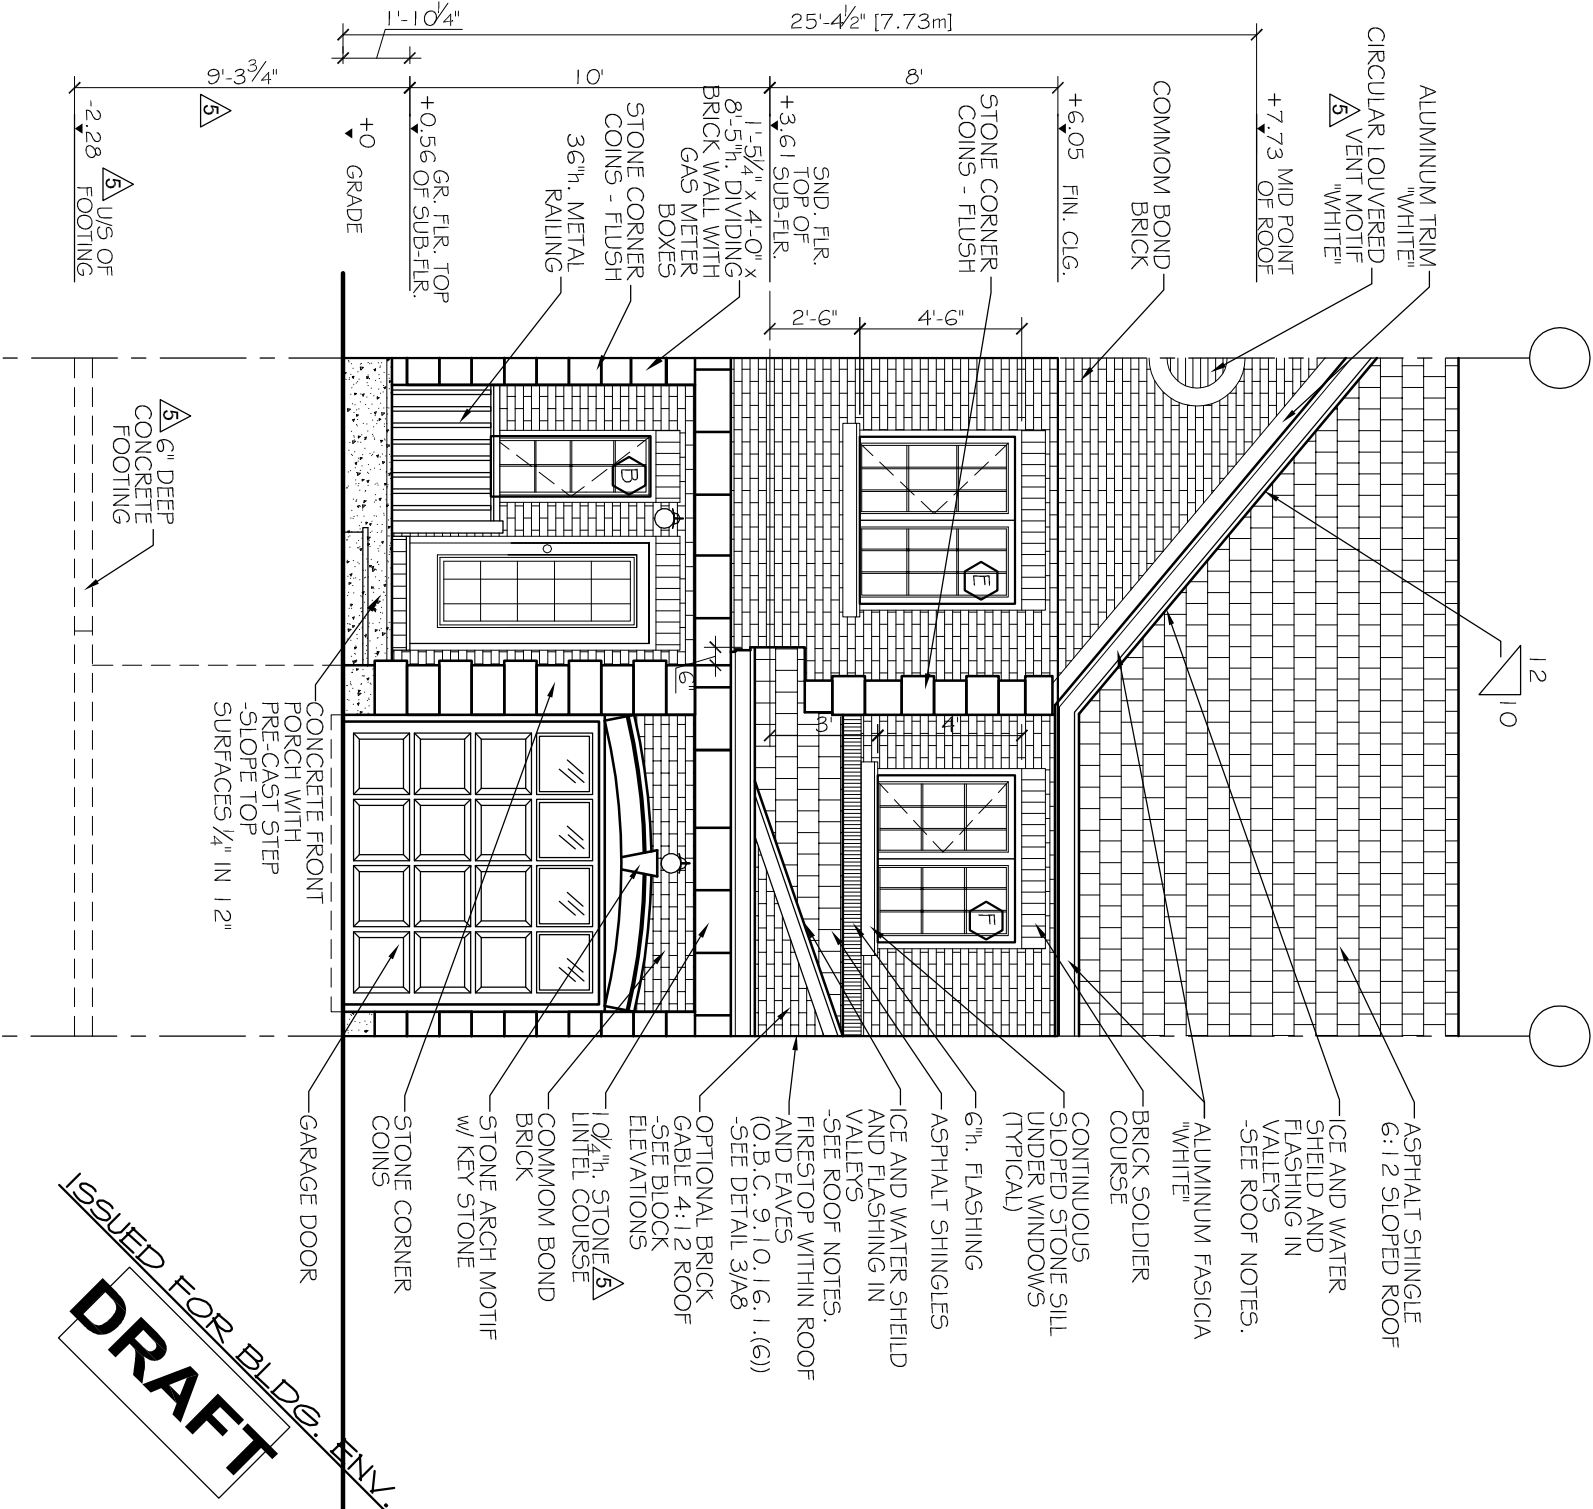

"MODEL A" - TYPICAL UNIT
FRONT ELEVATION

SCALE: 3/16"=1'

A1-4

NOTES

- SEE DWG. A5 FOR WINDOW SCHEDULE AND NOTES.
- SEE DWGS. A6 & A7 FOR SPECIFICATIONS.
- VERIFY DEPTH OF FOOTING WITH GRADING PLAN AND STRUCTURAL ENGINEER.
- PARGE ALL EXPOSED CONCRETE.
- FLASH ALL OPENINGS AS PER O.B.C. 9.20.1.3.
- PROVIDE WEEP HOLES @ 2'-7" o.c. MAX. AT BASE OF ALL BRICK AND STONE COURSES INCLUDING BRICK SOLDIER COURSE OVER WINDOWS.
- COLOURS AS PER CONTRACTORS SAMPLE BOARD.
- SEE DWG. A7 FOR ROOF SPECIFICATIONS.

ISSUED FOR BLDG. PERMIT
DRAFT

