


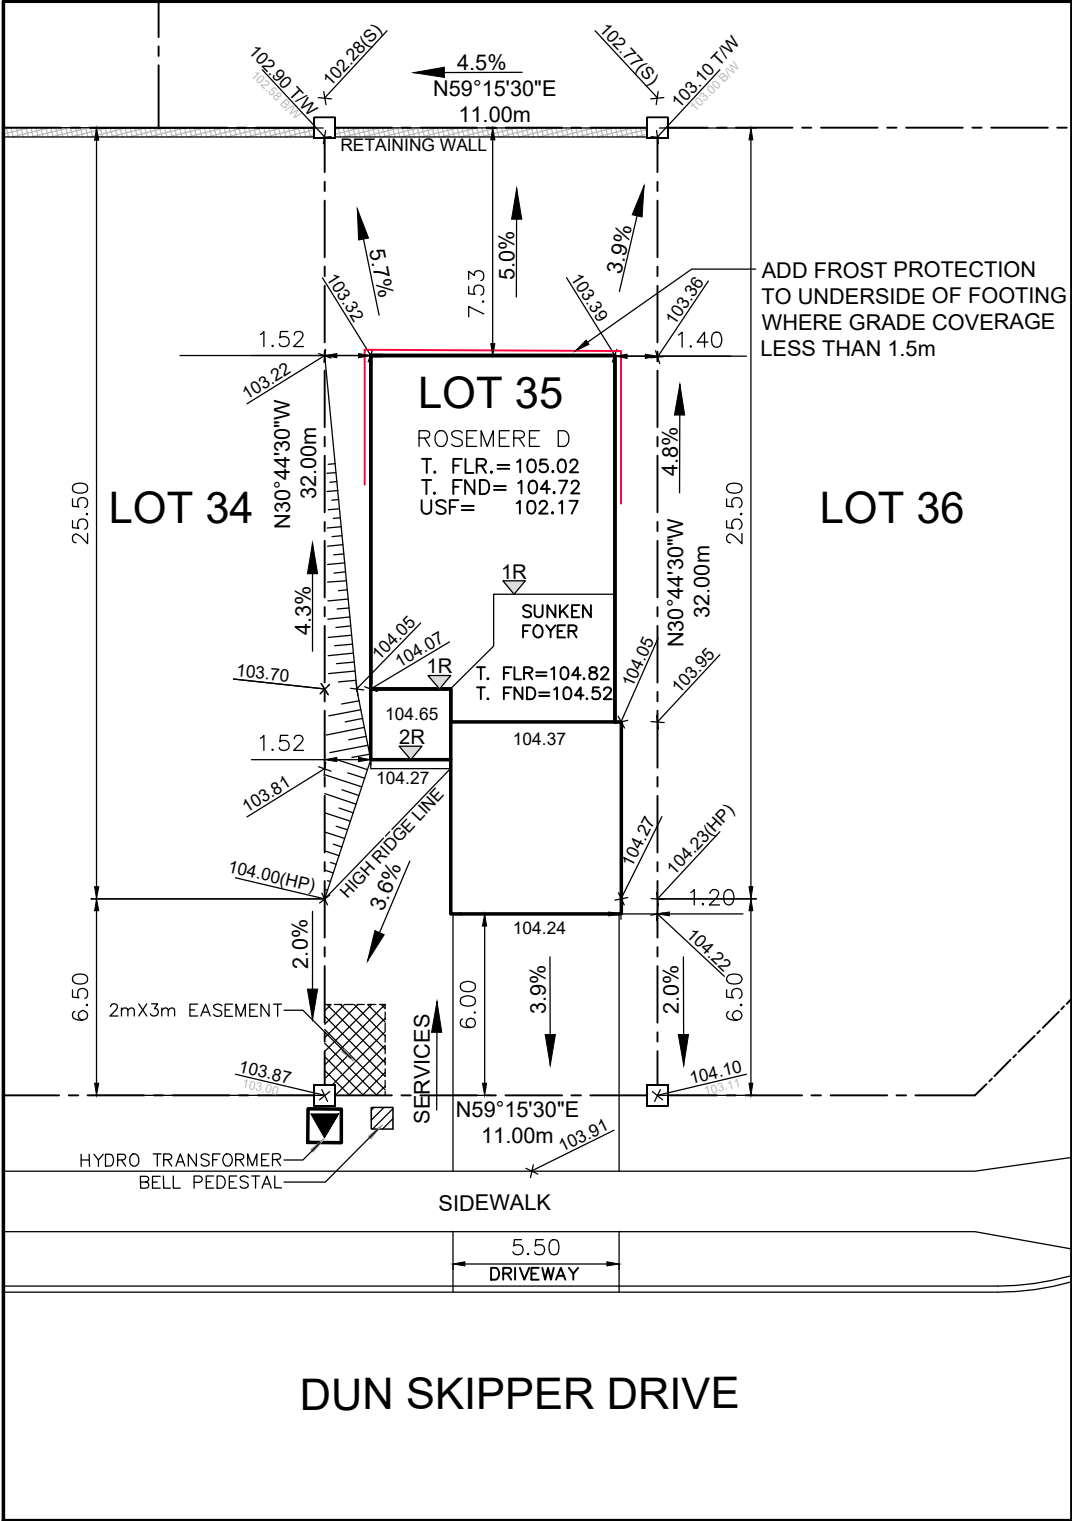

Owner/Applicant DCR/PHOENIX HOMES Telephone # <u>723-9227</u> Plan # <u>4M- 1617</u> Project name: <u>PATHWAYS</u> Civic Address:<u>90 DUN SKIPPER DR</u> House model: <u>ROSEMERE D</u>		 LOT 35 SITE/GRADING PLAN PATHWAYS INDIVIDUAL LOT GRADING REVIEW SUMMARY FOR SITED HOUSE AS COMPARED WITH OVERALL SUBDIVISION PLAN	
Bldg. Ht. <u> </u> m Lot coverage <u>38.9</u> % Scale <u>1: 250</u> Sod Area <u>205.9</u> m² Asphalt Area <u>57.9</u> m²		NOTE: THIS PLAN IS NOT A SURVEY PLAN OR SUBDIVISION PLAN WITHIN THE MEANING OF PLANNING ACT. THIS PLAN IS FOR REFERENCE ONLY AND IS PRELIMINARY IN NATURE, ALL DIMENSIONS SHOWN ARE APPROXIMATE. E.O&E.	
CHECKED/APPROVED BY: T.L.MAK ENG.			