


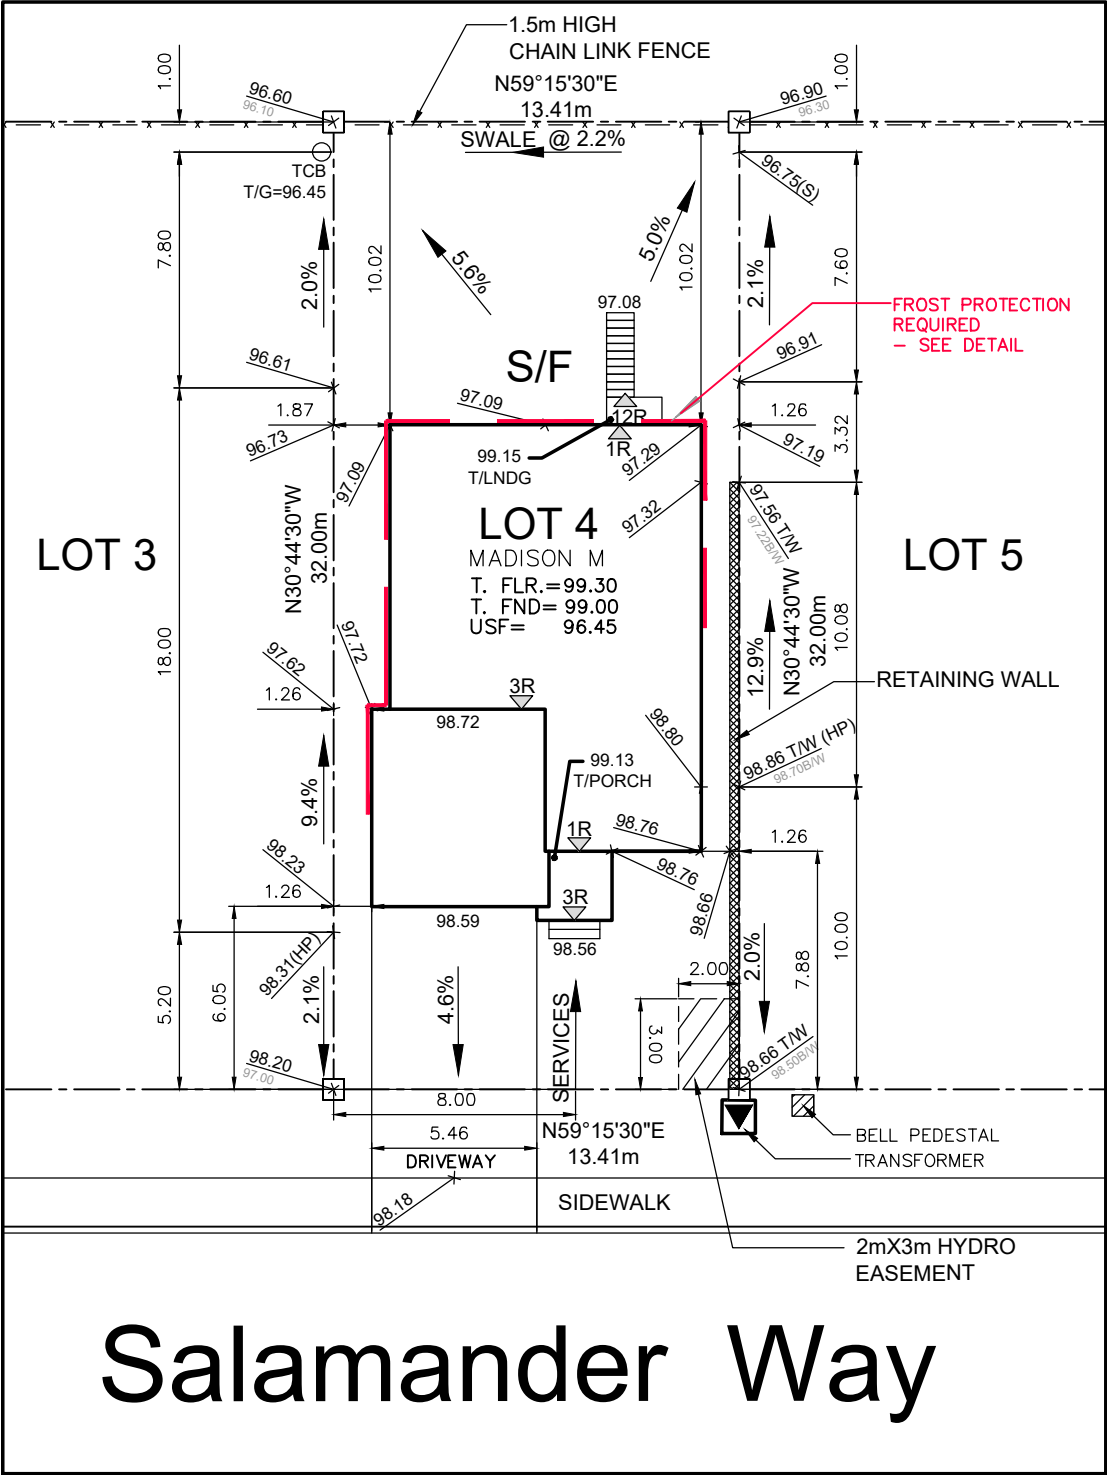

Salamander Way

Owner/Applicant DCR/PHOENIX HOMES Telephone # <u>723-9227</u> Plan # <u>4M- 1617</u> Project name: <u>PATHWAYS</u> Civic Address: <u>16 SALAMANDER WAY</u> House model: <u>MADISON M</u>	 LOT 4 SITE/GRADING PLAN PATHWAYS
Bldg. Ht. _____m Lot coverage <u>38.3</u>% Scale <u>1:250</u> Sod Area <u>255</u>m² Asphalt Area <u>50</u>m²	INDIVIDUAL LOT GRADING REVIEW SUMMARY FOR SITED HOUSE AS COMPARED WITH OVERALL SUBDIVISION PLAN NOTE: THIS PLAN IS NOT A SURVEY PLAN OR SUBDIVISION PLAN WITHIN THE MEANING OF PLANNING ACT. THIS PLAN IS FOR REFERENCE ONLY AND IS PRELIMINARY IN NATURE, ALL DIMENSIONS SHOWN ARE APPROXIMATE. E.O&E.
CHECKED/APPROVED BY: T.L.MAK ENG.	