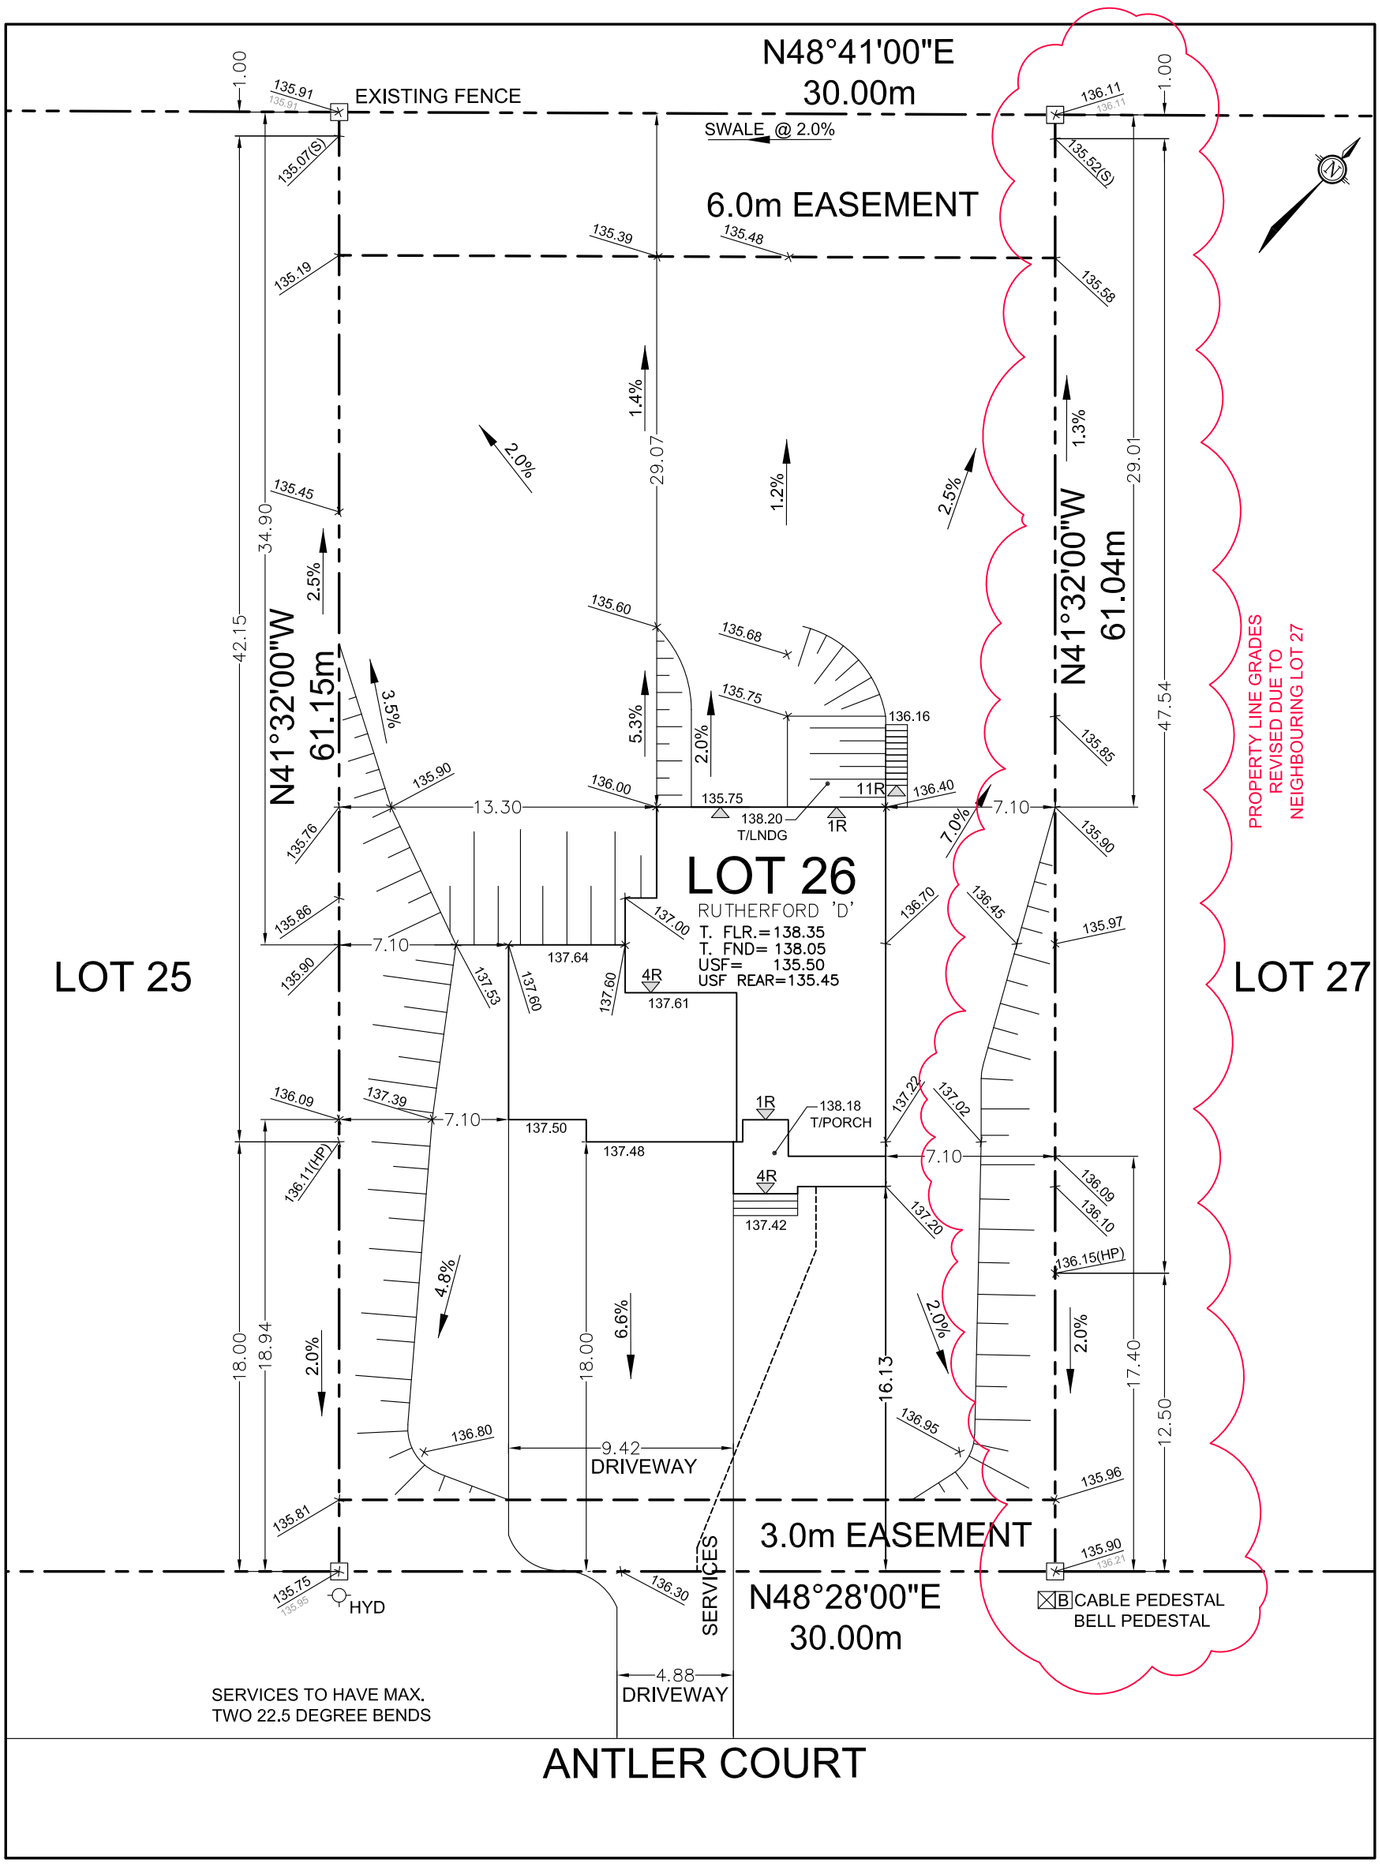


Owner/Applicant
**DCR/PHOENIX HOMES**
Telephone # 723-9227
Plan # 27M- 47
Project name: WHITE TAIL RIDGE
Civic Address: 208 ANTLER COURT
House model: RUTHERFORD 'D'

Bldg. Ht. _____ m
Lot coverage 10.8 %
Scale 1:250
Sod Area 1638 m²
Asphalt Area 207 m²

CHECKED/APPROVED BY: T.L.MAK ENG.

PHOENIX HOMES

LOT 26 SITE/GRADING PLAN
WHITE TAIL RIDGE PHASE 2

INDIVIDUAL LOT GRADING REVIEW SUMMARY FOR SITED HOUSE AS COMPARED WITH OVERALL SUBDIVISION PLAN

NOTE: THIS PLAN IS NOT A SURVEY PLAN OR SUBDIVISION PLAN WITHIN THE MEANING OF PLANNING ACT. THIS PLAN IS FOR REFERENCE ONLY AND IS PRELIMINARY IN NATURE, ALL DIMENSIONS SHOWN ARE APPROXIMATE. E,O&E.