DCR PHOENIX HOMES

LOT #116

WHITE TAIL RIDGE

MODEL - OAKSIDE (B-20)

(GARGAE RIGHT)

KITCHEN

MOUNTING HEIGHT - 96

42"H UPPERS @ 18" ABOVE COUNTER

LIGHT VALANCE

CROWN MOULDING

CABINETS

HARDWARE -

STANDARD WHITE INTERIOR

METAL DRAWER BOX

6 PCS - 5/8" KICK - FIN. BOTH ENDS

2 PCS - LOOSE FILLER - 6 x 96

1 PCS - 90 DEG. CORNER MOULD

1 PCS - T-MOULD

7 PCS - FLAT MOULD

CUSTOMER APPROVAL

I have reviewed these drawings and understand the details of the design and the CARTIER KITCHENS specifications.

Signature Richard Gillon

Date May 25, 21

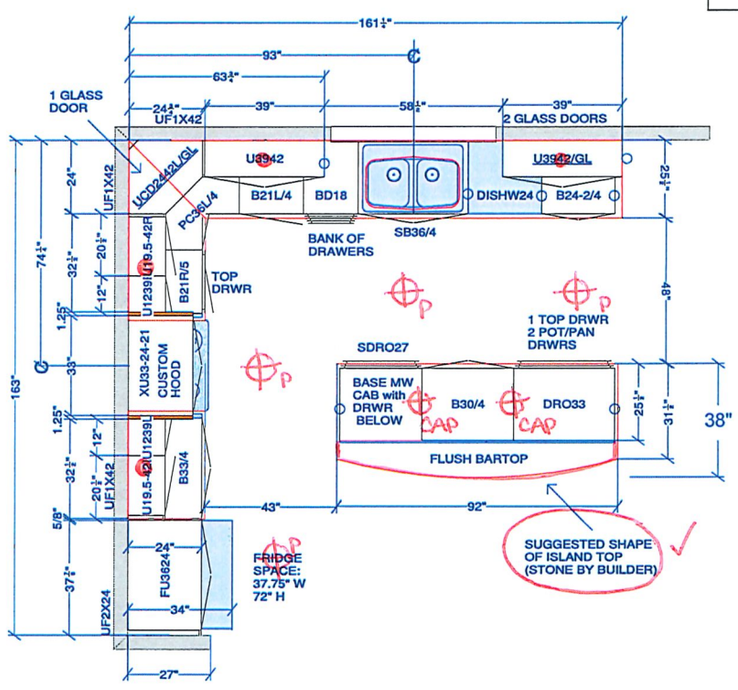

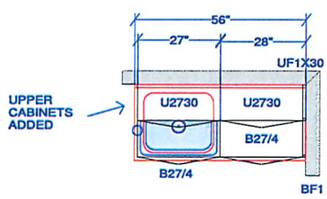

LAUNDRY ROOM

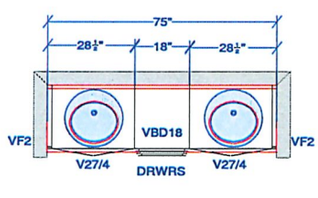

ENSUITE VANITY

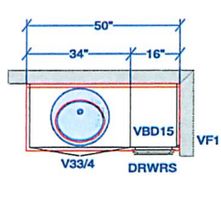

GUEST BATH VANITY

All dimensions _size designations given are subject to verification on job site and adjustment to fit job conditions. SPECTRUM KITCHEN and BATH DESIGN	SPECTRUM KITCHEN & BATH DESIGN	This is an original design and must not be released or copied unless applicable fee has been paid or job order placed. DRAWN BY: LORI DISAVERIO, B.I.D	Designed: 2021-01-28 Printed: 2021-01-28	
DCR #116 WTR2 - Oakside (B-20).kit		All	Drawing #: 1	No Scale.

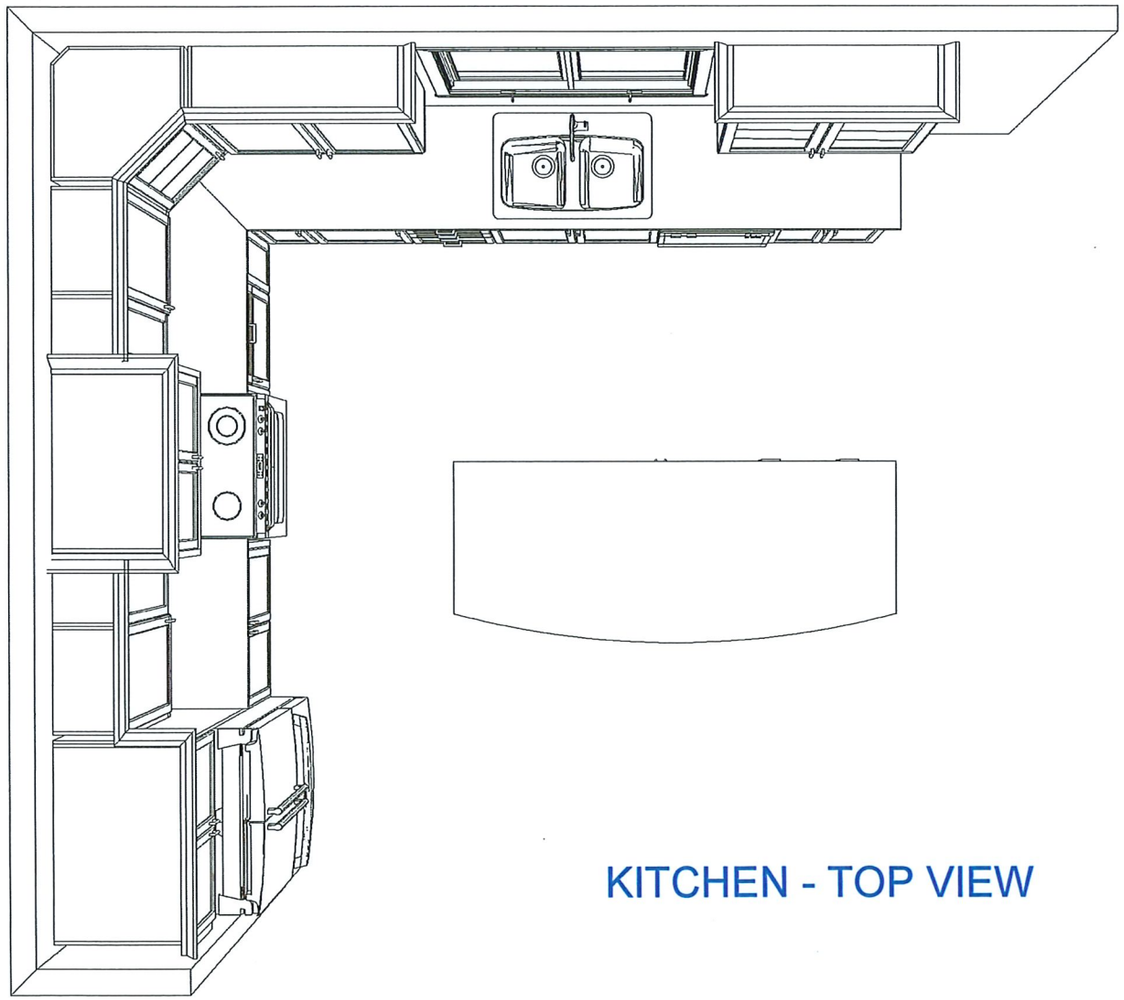

KITCHEN - TOP VIEW

CUSTOMER APPROVAL

I have reviewed these drawings and understand the details of the design and the CARTIER KITCHENS specifications.

Signature Richard Sullivan Jdeveland

Date May 25, 21

Note: This drawing is an artistic interpretation of the general appearance of the design. It is not meant to be an exact rendition.

SPECTRUM KITCHEN and BATH DESIGN

Designed: 2021-01-28
Printed: 2021-01-28

DCR #116 WTR2 - Oakside (B-20).kit	All	Drawing #: 1

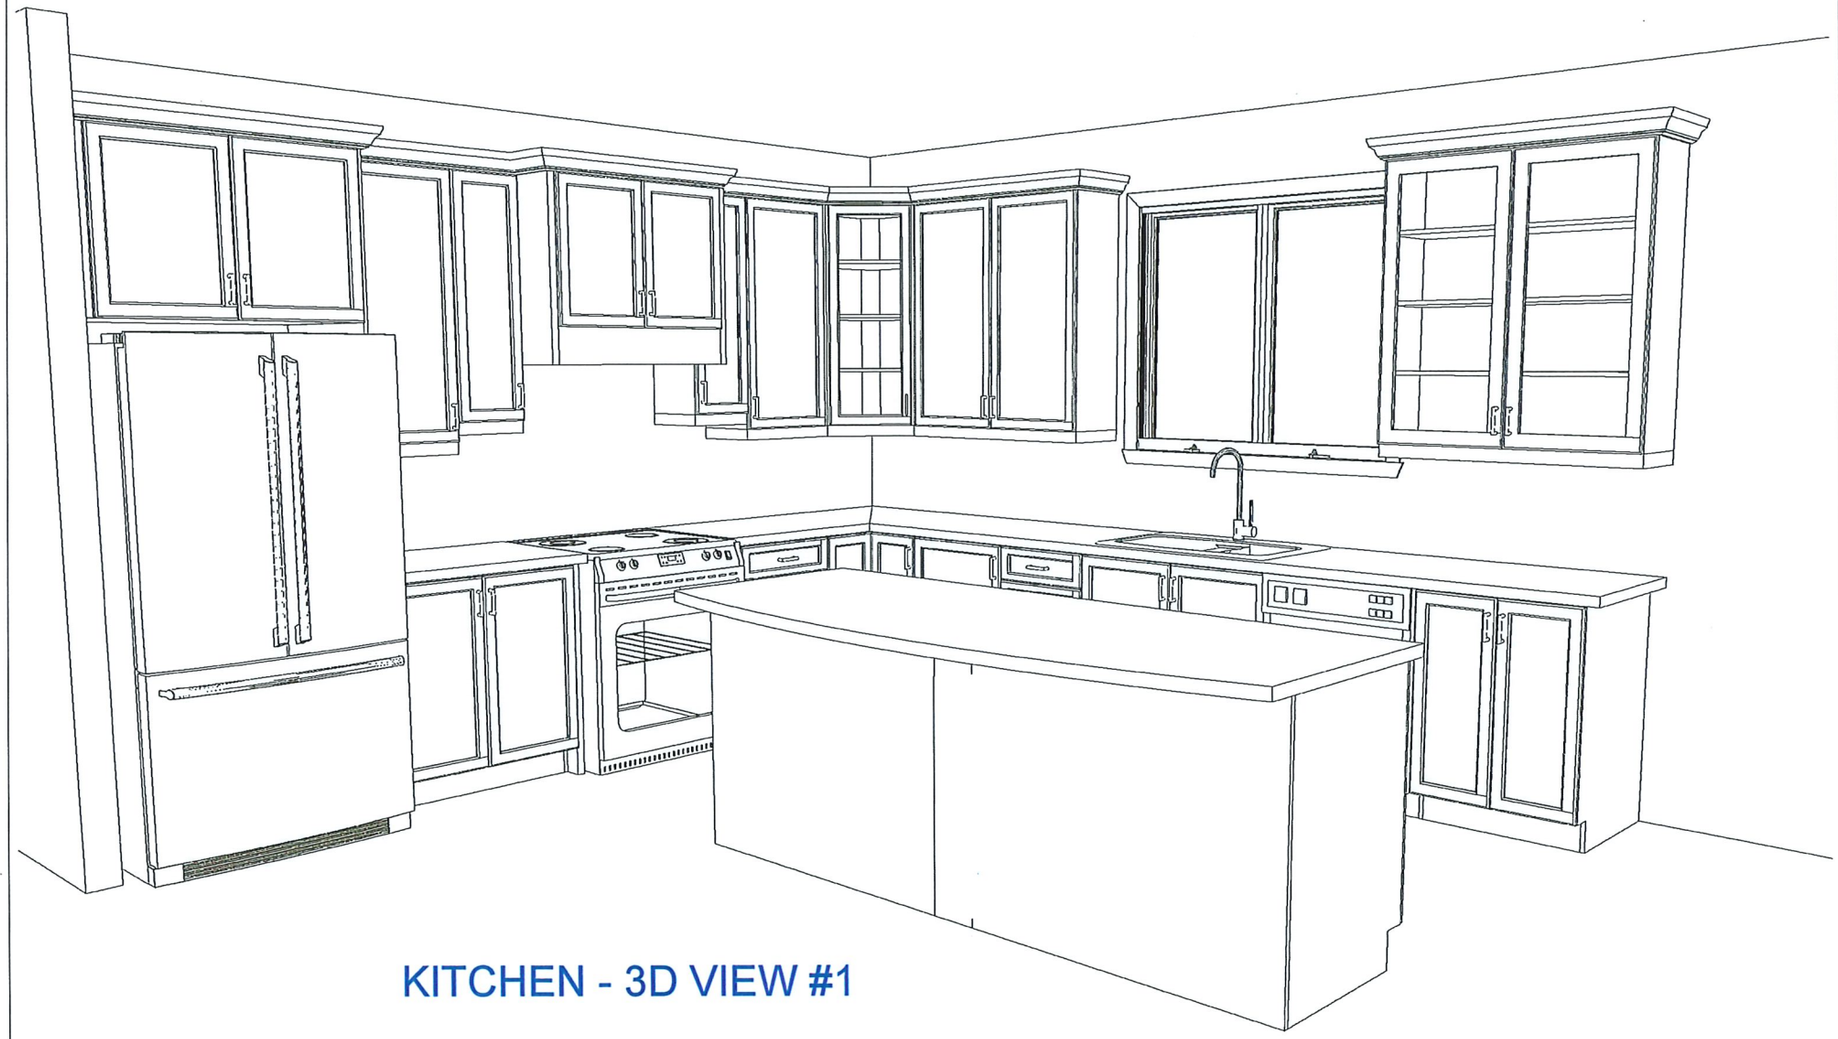

KITCHEN - 3D VIEW #1

CUSTOMER APPROVAL

I have reviewed these drawings and understand the details of the design and the CARTIER KITCHENS specifications.

Signature _____

Date May 25, 21

Note: This drawing is an artistic interpretation of the general appearance of the design. It is not meant to be an exact rendition.

SPECTRUM KITCHEN and BATH DESIGN

Designed: 2021-01-28
Printed: 2021-01-28

DCR #116 WTR2 - Oakside (B-20).kit | All | Drawing #: 1

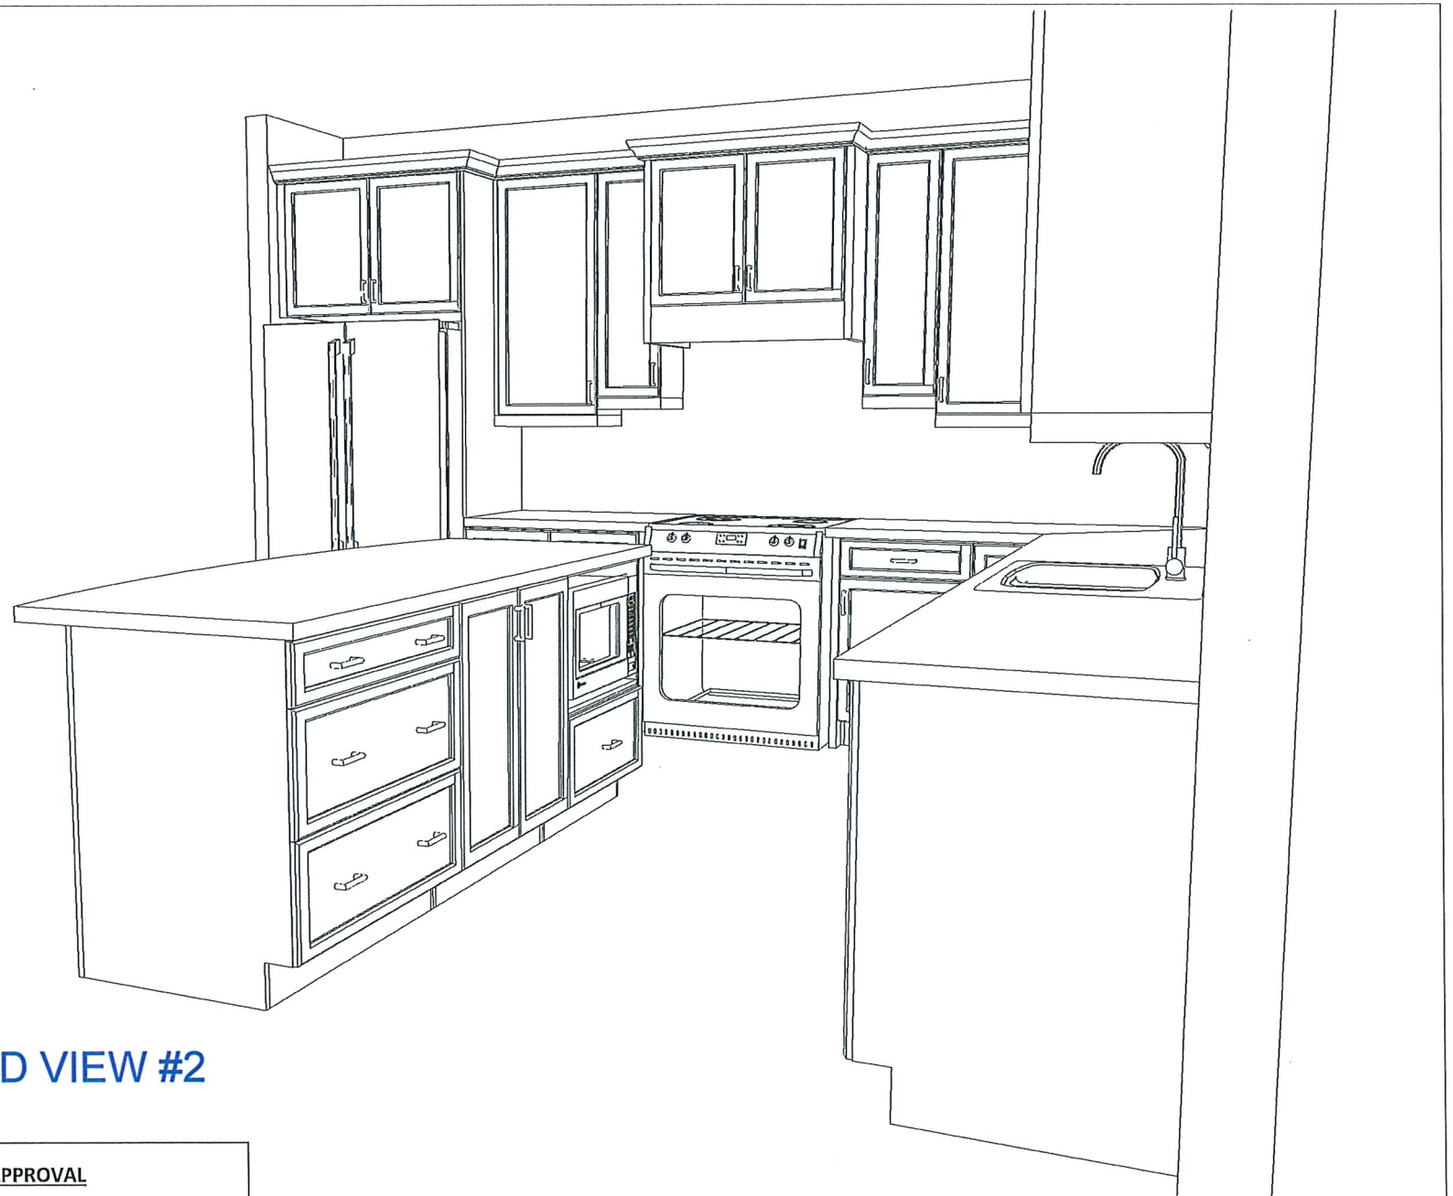

KITCHEN - 3D VIEW #2

CUSTOMER APPROVAL

I have reviewed these drawings and understand the details of the design and the CARTIER KITCHENS specifications.

Signature _____

Date May 25 21

Note: This drawing is an artistic interpretation of the general appearance of the design. It is not meant to be an exact rendition.

SPECTRUM KITCHEN and BATH DESIGN

Designed: 2021-01-28
Printed: 2021-01-28

DCR #116 WTR2 - Oakside (B-20).kit | All | Drawing #: 1

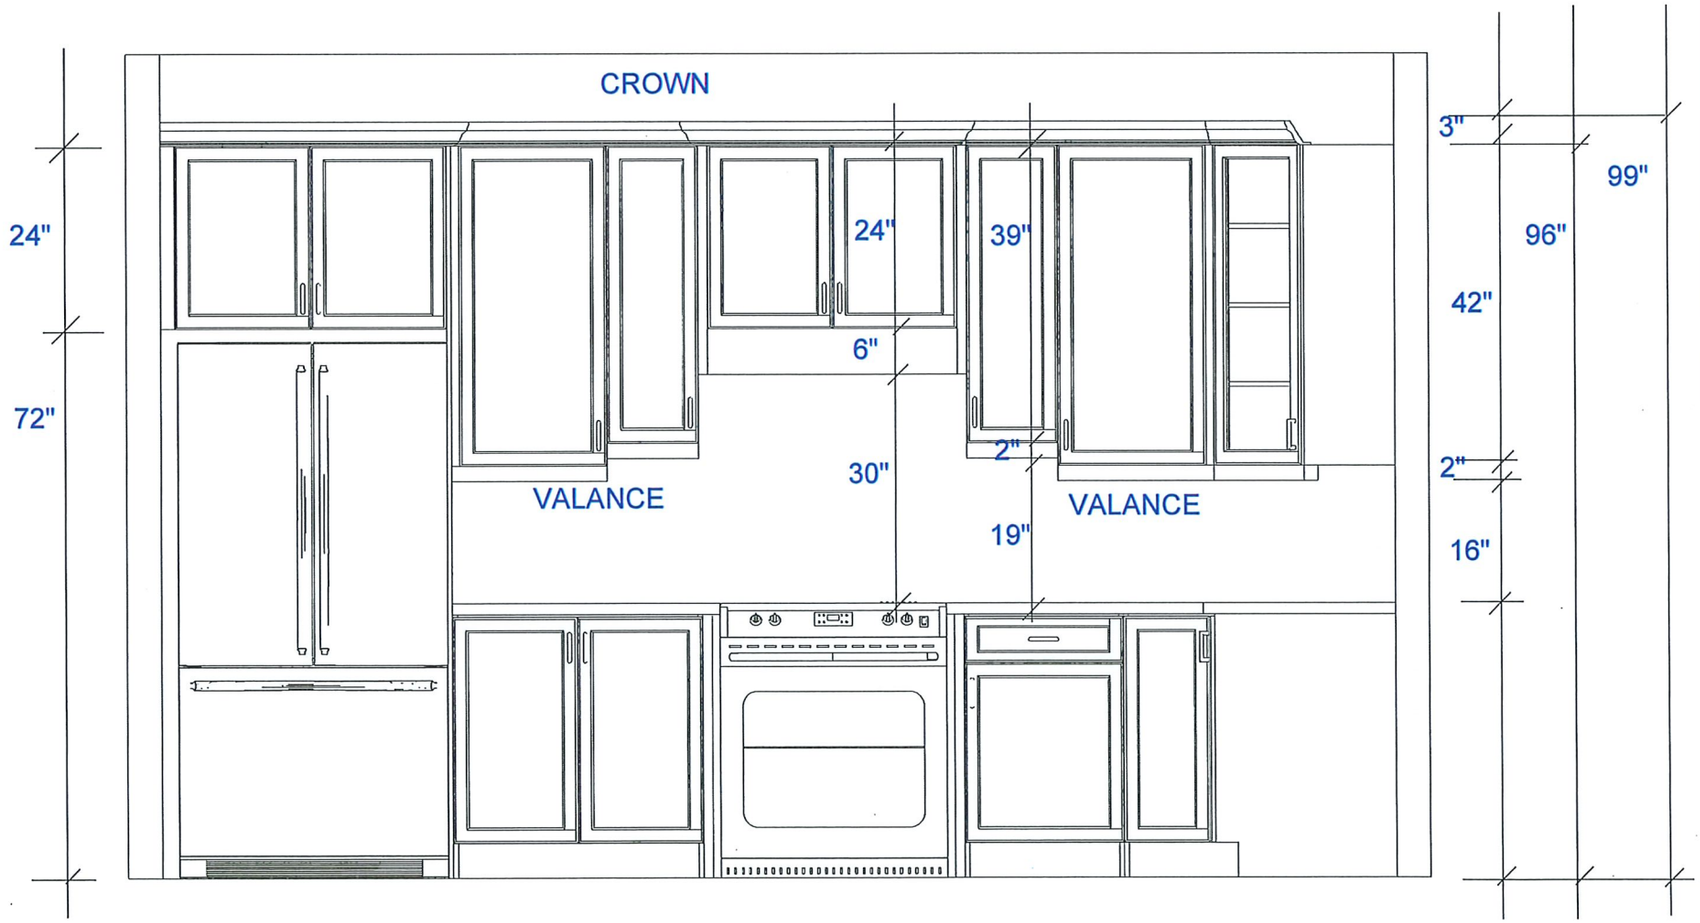

FRIDGE / RANGE WALL ELEVATION

CUSTOMER APPROVAL

I have reviewed these drawings and understand the details of the design and the CARTIER KITCHENS specifications.

Signature _____

Date May 25, 21

Note: This drawing is an artistic interpretation of the general appearance of the design. It is not meant to be an exact rendition.

SPECTRUM KITCHEN and BATH DESIGN

Designed: 2021-01-28
Printed: 2021-01-28

DCR #116 WTR2 - Oakside (B-20).kit | All | Drawing #: 1

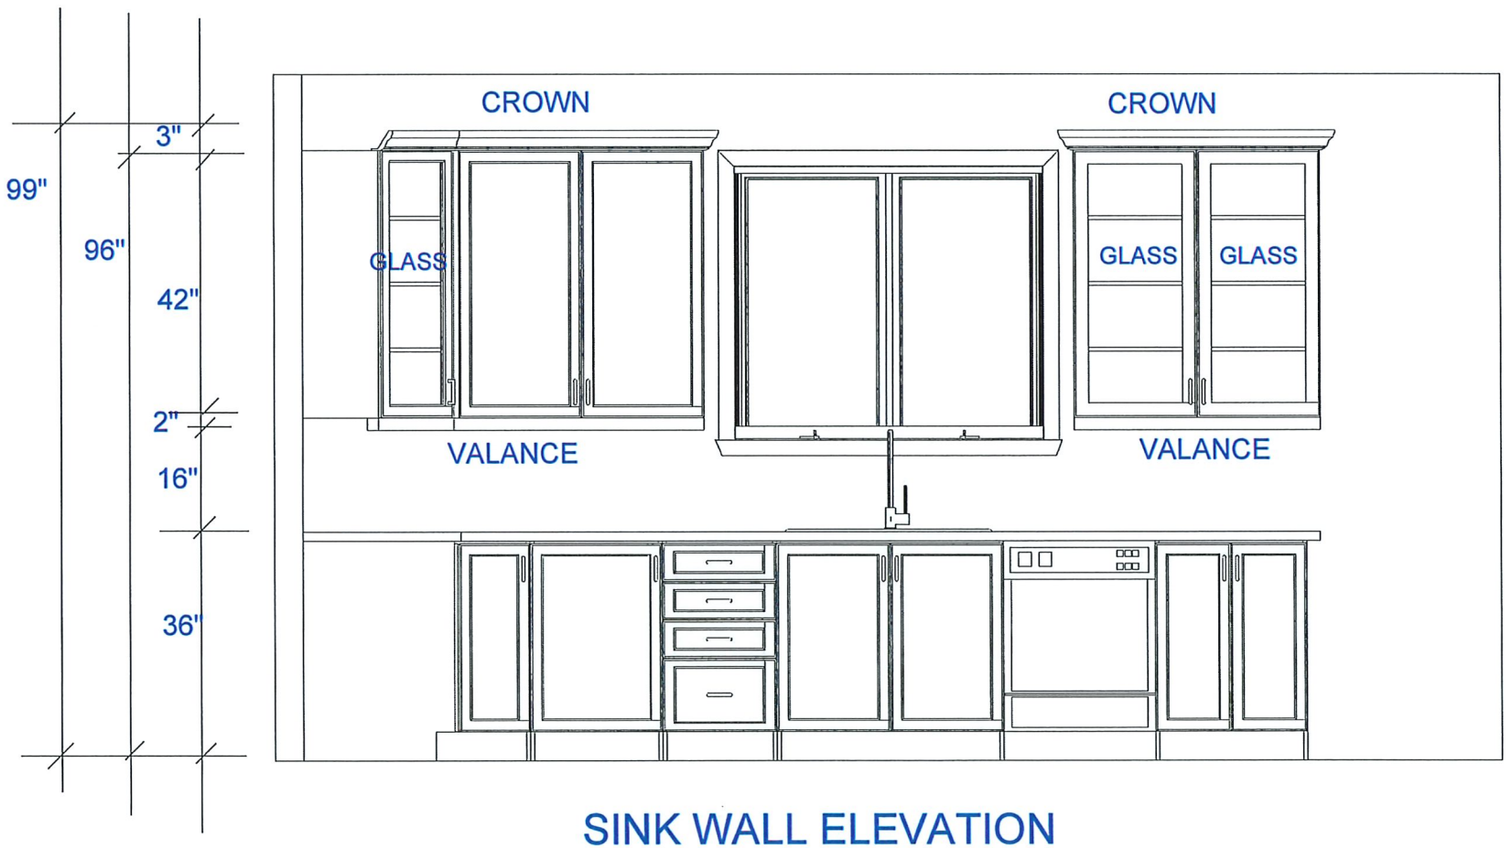

SINK WALL ELEVATION

CUSTOMER APPROVAL

I have reviewed these drawings and understand the details of the design and the CARTIER KITCHENS specifications.

Signature _____

Date May 25, 21

Note: This drawing is an artistic interpretation of the general appearance of the design. It is not meant to be an exact rendition. SPECTRUM KITCHEN and BATH DESIGN		Designed: 2021-01-28 Printed: 2021-01-28
DCR #116 WTR2 - Oakside (B-20).kit	All	Drawing #: 1

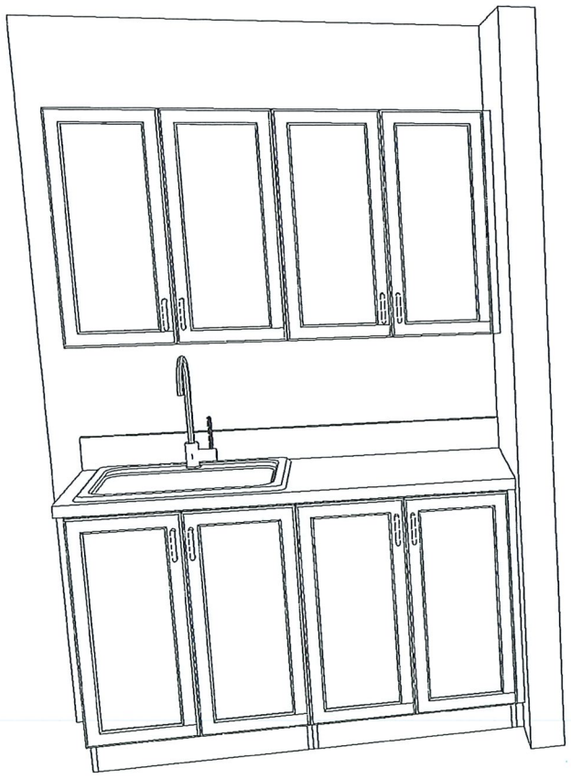

LAUNDRY

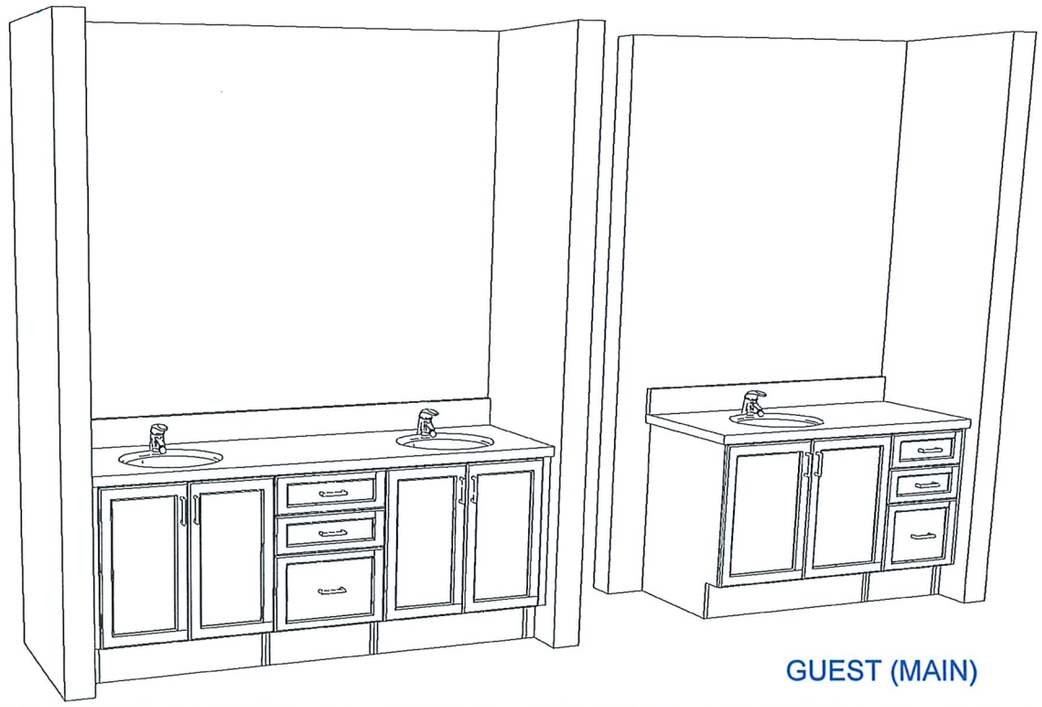

ENSUITE

GUEST (MAIN)

CUSTOMER APPROVAL

I have reviewed these drawings and understand the details of the design and the CARTIER KITCHENS specifications.

Signature _____

Date May 25, 21

Note: This drawing is an artistic interpretation of the general appearance of the design. It is not meant to be an exact rendition.		Designed: 2021-01-28 Printed: 2021-01-28
SPECTRUM KITCHEN and BATH DESIGN		
DCR #116 WTR2 - Oakside (B-20).kit	All	Drawing #: 1