


1 PARTIAL GROUND FLOOR PLAN


1 / scale: 3/16"=1'-0"



REVIEWED
BUBBLED
CHANGES ONLY TO BE READ WITH
APPROVED
MASTER PLANS

V.ATAYEV 100134699 2021/05/17 Owner OF ONT AR

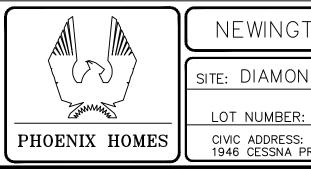

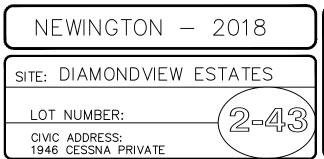

2	xx	xx/xx/xx	СВ	H
1	8' PATIO SLIDER	17/05/21	СВ	l
No	. Description	dd/mm/yy	Ву	Н
RE	REVISIONS			) (

footprint:	518		
drawn by:	SP		
date:	JUN 12/16		
scale: 3/16"=1'-			
sheet no:			