DocuSign Envelope ID: F04405CB-AAFE-42DA-986E-00DB21BCDDEA

PATHWAYS- PHASE 1- LOT 3

DCR PHOENIX HOMES

MODEL - WINCHESTER (43-4)

KITCHEN

MOUNTING HEIGHT - 84

42" HIGH UPPER CABINETS

LINE - 1 & 2

HARDWARE - STD & 1ST UPGRADE

STANDARD WHITE INTERIOR

METAL DRAWER BOX

4 PCS - 5/8" KICK - FIN. BOTH ENDS

2 PCS - LOOSE FILLER - 6 x 96

2 PCS - 90 DEG. CORNER MOULD

1 PCS - T-MOULD

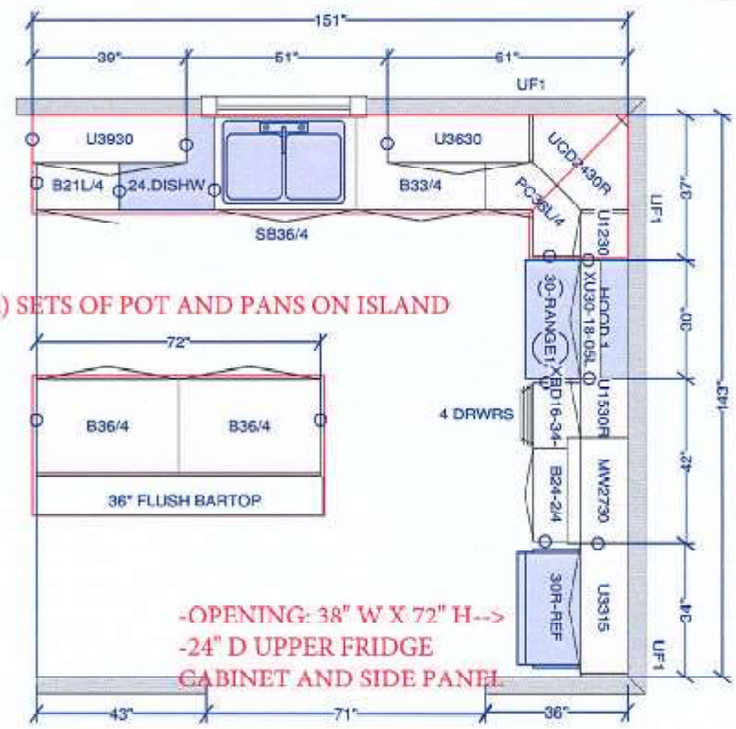

-(2) SETS OF POT AND PANS ON ISLAND

-OPENING: 38" W X 72" H-->
-24" D UPPER FRIDGE
CABINET AND SIDE PANEL

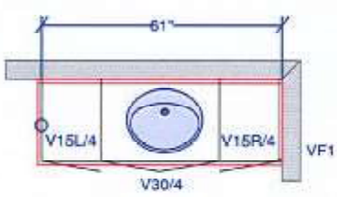

POWDER

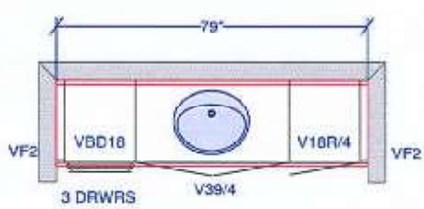

MAIN BATH

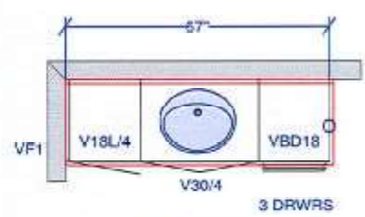

ENSUITE

JACK & JILL BATHROOM VANITY: APPROX 48"-49" WIDE

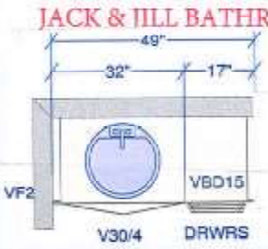

All dimensions ,size designations given are subject to verification on job site and adjustment to fit job conditions.	2020 TECHNOLOGIES	This is an original design and must not be released or copied unless applicable fee has been paid or job order placed.	Designed: 17/07/2013 Printed: 13/10/2014
Cartier Kitchens Ottawa		Drawn by: Lori Di Saverio. B.I.D. Cartier Kitchens Ottawa	DS HL DS LW
43-4 Winchester.kit		All	Drawing #: 1 / No Scale.