


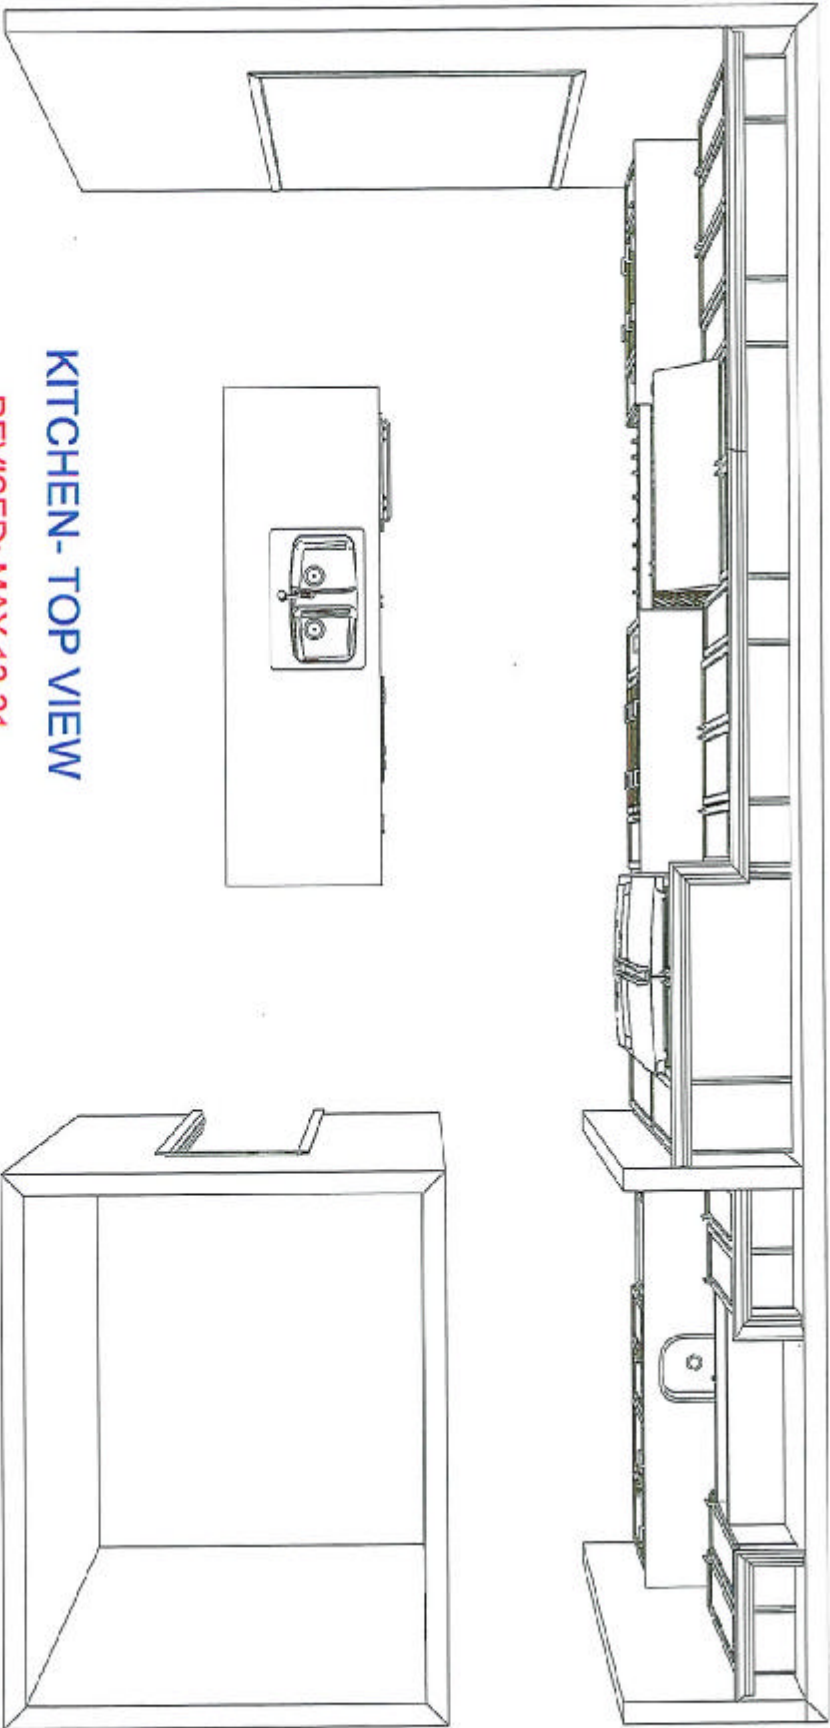

KITCHEN- TOP VIEW

REVISED: MAY 12-21

CUSTOMER APPROVAL

I have reviewed these drawings and understand the details of the design and the CARTER KITCHENS specifications.

Signature _____

Date _____

Note: This drawing is an artistic interpretation of the general appearance of the design. It is not meant to be an exact rendition.

SPECTRUM KITCHEN and BATH DESIGN




Designed: 2021-05-12
Printed: 2021-05-13

DCR#47--3.kit

All

Drawing #: 1

DS ME DS Ed

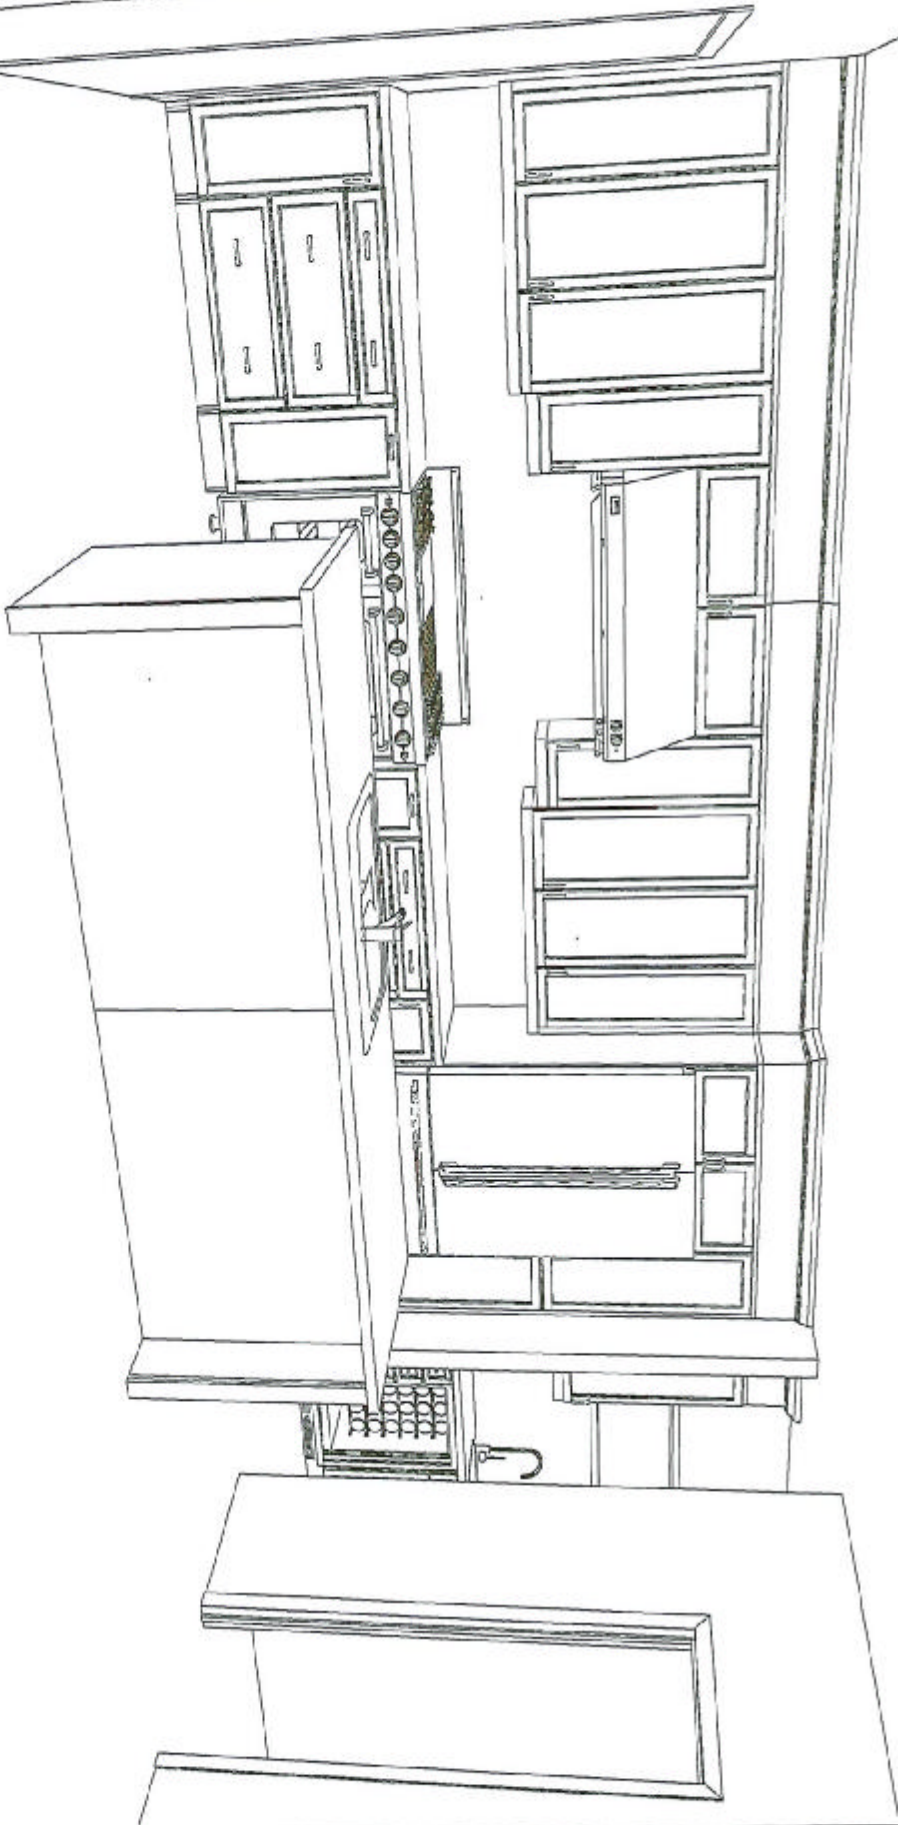

KITCEHN - 3D VIEW #1

REVISED: MAY 12-21

CUSTOMER APPROVAL

I have reviewed these drawings and understand the details of the design and the CARTIER KITCHENS specifications.

Signature _____

Date _____

Note: This drawing is an artistic interpretation of the general appearance of the design. It is not meant to be an exact rendition.

SPECTRUM KITCHEN and BATH DESIGN




Designed: 2021-05-12
Printed: 2021-05-12

DCR #47 Diamondview Estates 2 - NEWINGTON -

All

Drawing #: 1

DS ME DS Ed

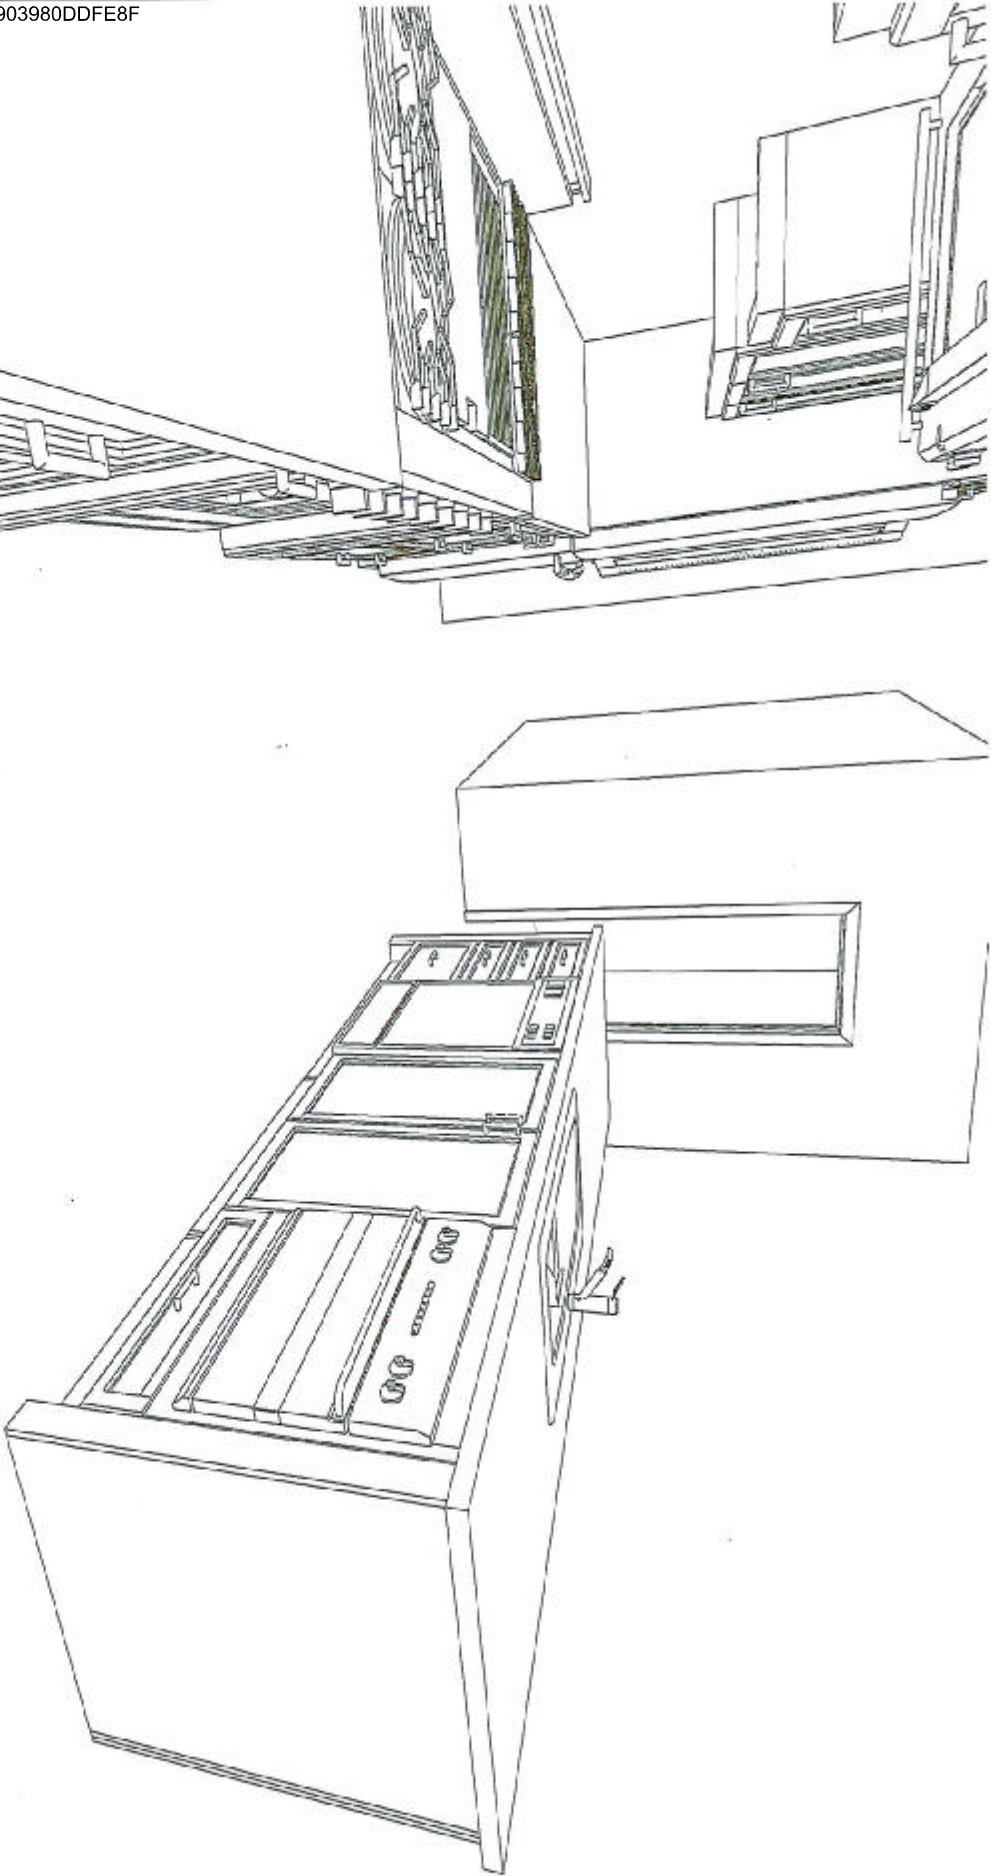

KITCHEN- 3D VIEW #2

REVISED: MAY 12-21

I have reviewed these drawings and understand the details of the design and the CARTER KITCHENS specifications.

Signature _____

Date _____

CUSTOMER APPROVAL

Note: This drawing is an artistic interpretation of the general appearance of the design. It is not meant to be an exact rendition.

SPECTRUM KITCHEN and BATH DESIGN



Designed: 2021-05-12
Printed: 2021-05-13


DCR#47~3.kit

All

Drawing #: 1

DS
ME

DS
EA

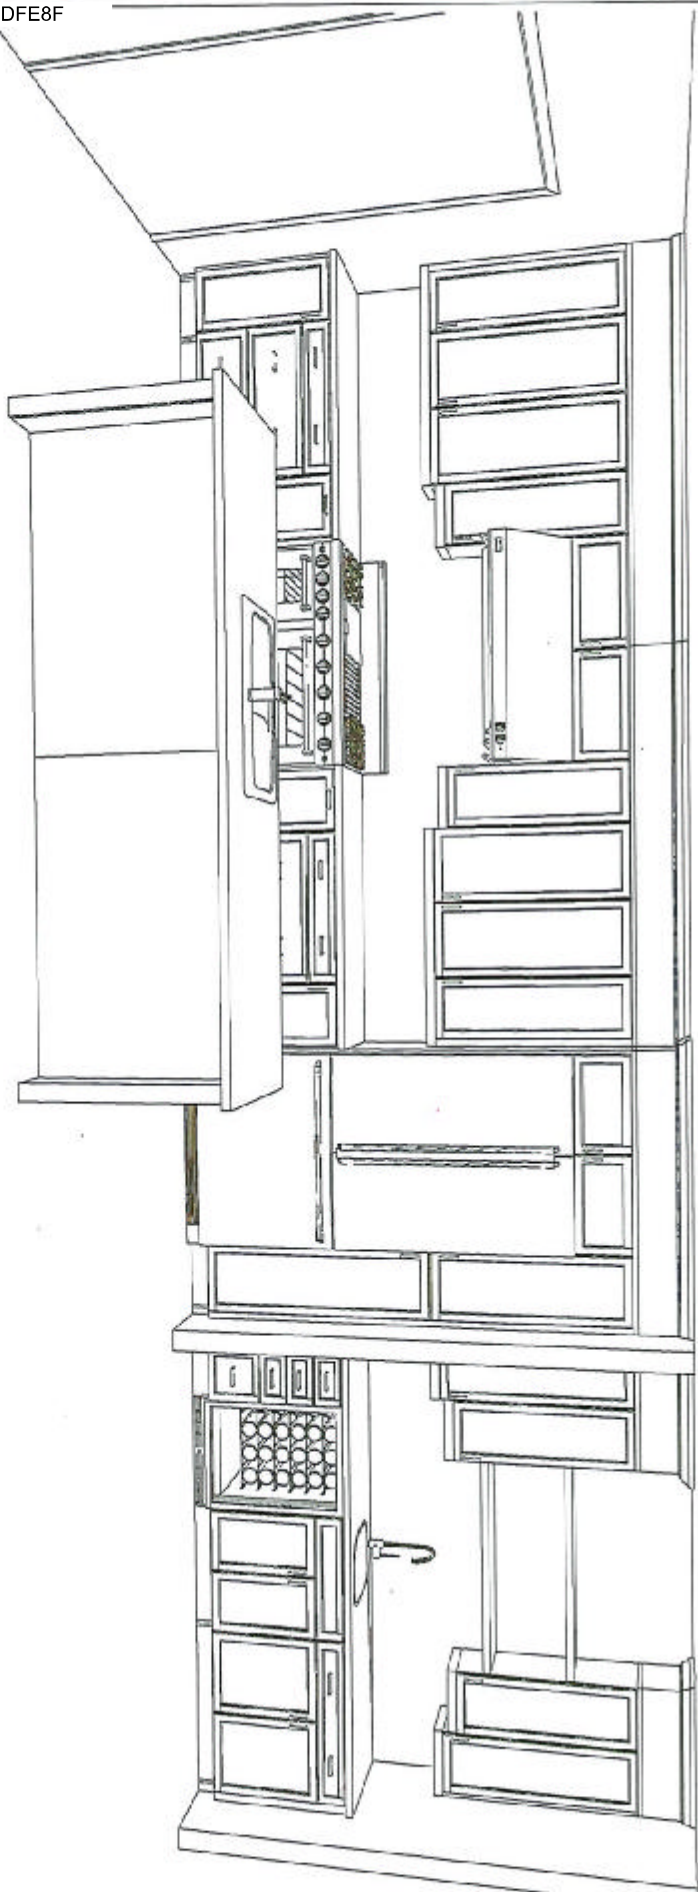

KITCHEN - 3D VIEW #3

REVISED: MAY 12-21

CUSTOMER APPROVAL

I have reviewed these drawings and understand the details of the design and the CARTIER KITCHEN'S specifications.

Signature _____

Date _____

Note: This drawing is an artistic interpretation of the general appearance of the design. It is not meant to be an exact rendition.

SPECTRUM KITCHEN and BATH DESIGN

DCR#47~3.kit




Designed: 2021-05-12
Printed: 2021-05-13

All

Drawing #: 1

DS
ME

DS
EA

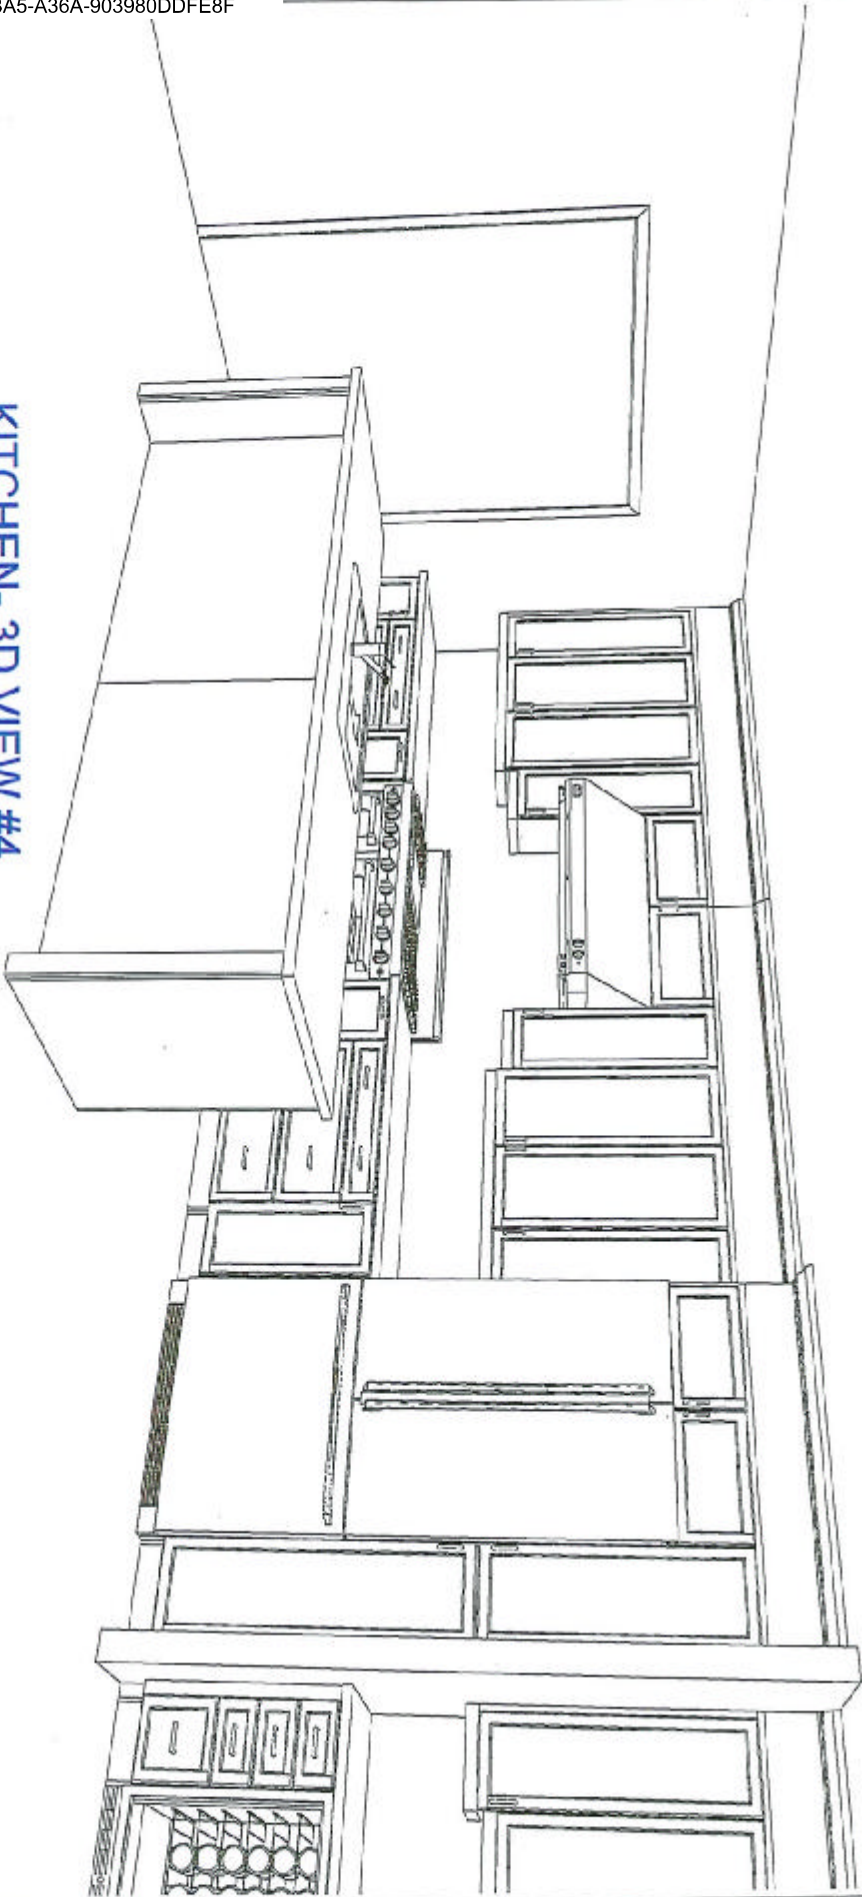

KITCHEN- 3D VIEW #4

REVISED: MAY 12-21

CUSTOMER APPROVAL

I have reviewed these drawings and understand the details of the design and the CARTIER KITCHENS specifications.

Signature _____

Date _____

Note: This drawing is an artistic interpretation of the general appearance of the design. It is not meant to be an exact rendition.



SPECTRUM KITCHEN and BATH DESIGN

DCR#47-3.kit


All

Drawing #: 1

Designed: 2021-05-12
Printed: 2021-05-13

DS
ME

DS
EA

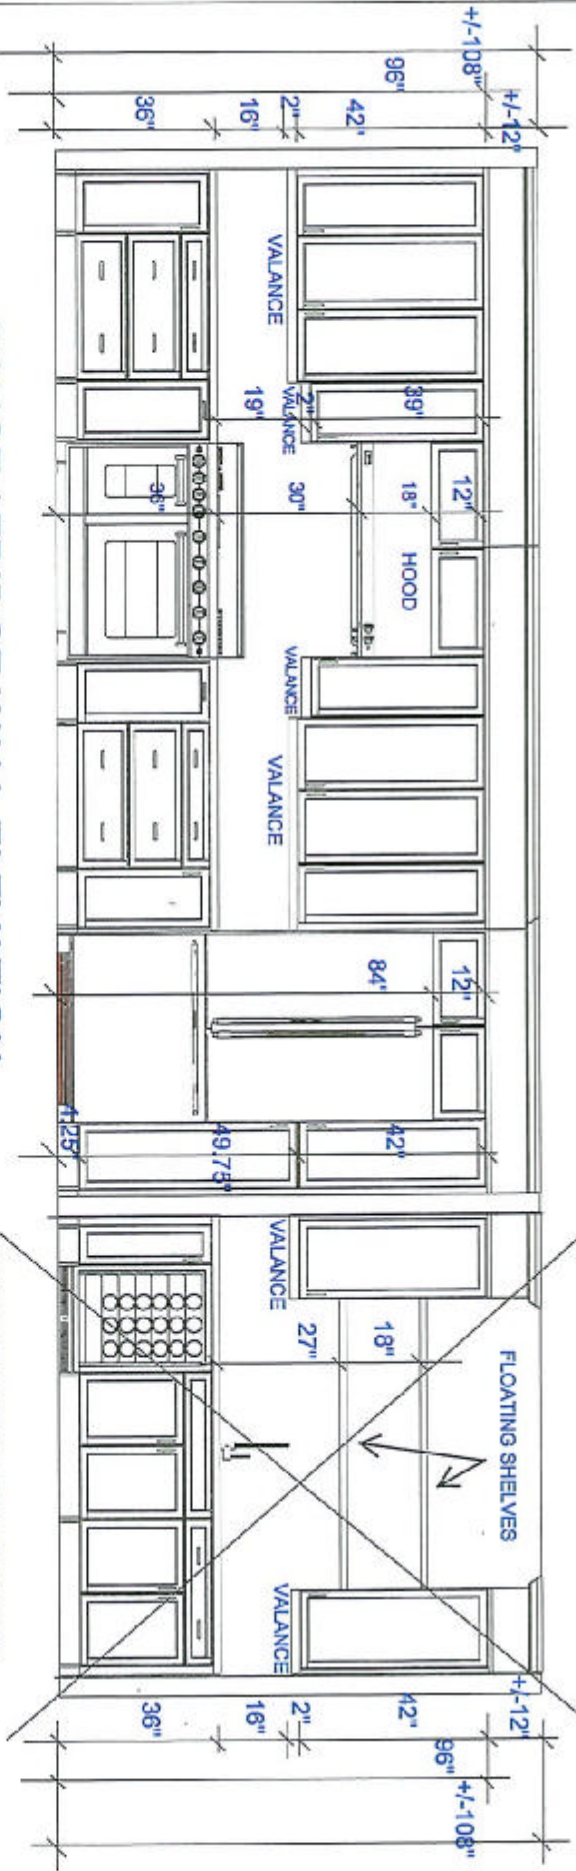

RANGE / FRIDGE WALL ELEVATION

BUTLER'S PANTRY

SEE REVISION - APRIL 25-21

CUSTOMER APPROVAL

I have reviewed these drawings and understand the details of the design and the CARTER KITCHENS specifications.

Signature _____

Date _____

Note: This drawing is an artistic interpretation of the general appearance of the design. It is not meant to be an exact rendition.

Designed: 2021-04-22
Printed: 2021-04-23



SPECTRUM KITCHEN and BATH DESIGN


DCR #47 Diamondview Estates 2 - NEWINGTON -

All

Drawing #: 1

DS
ME

DS
EA

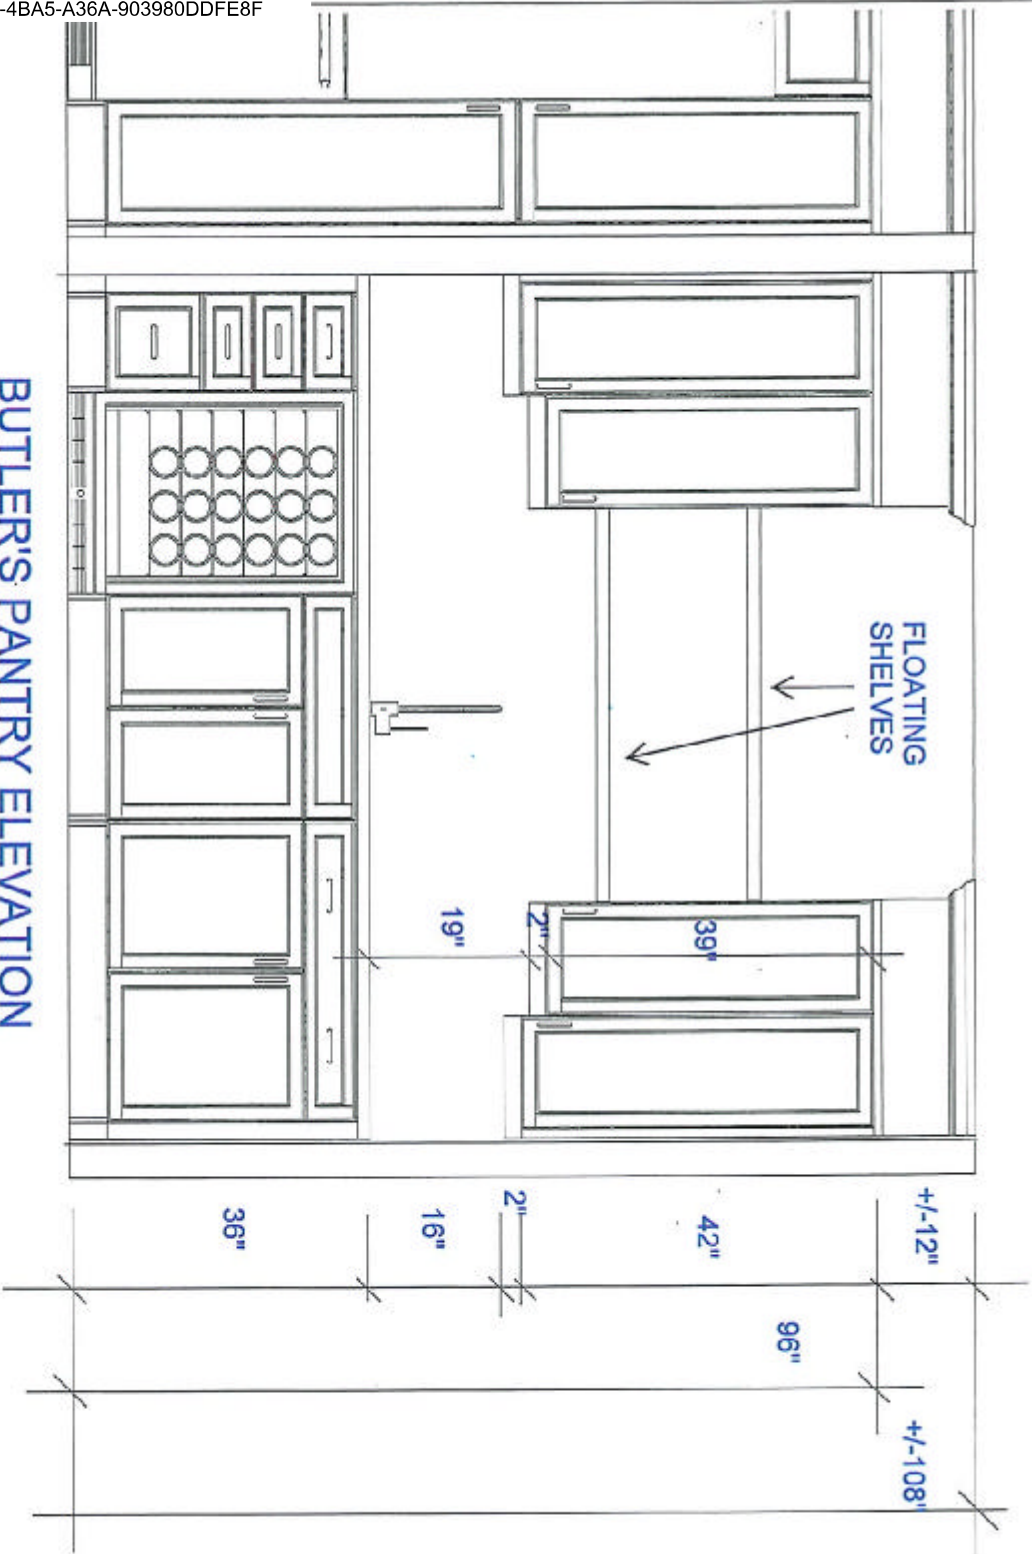

BUTLER'S PANTRY ELEVATION
REVISED: APRIL 25-21

CUSTOMER APPROVAL

I have reviewed these drawings and understand the details of the design and the CARTIER KITCHENS specifications.

Signature _____

Date _____

Note: This drawing is an artistic interpretation of the general appearance of the design. It is not meant to be an exact rendition.



Designed: 2021-04-22
Printed: 2021-04-25

SPECTRUM KITCHEN and BATH
DESIGN
DCR #47 Diamondview Estates 2 - NEWINGTON -

All





Drawing #: 1

DS ME DS EA


DCR PHOENIX HOMES

LOT #47
DIAMONDVIEW ESTATES 2
NEWINGTON
VANITIES
5 BDRM


- CABINETS -
HARDWARE -
STANDARD WHITE INTERIOR
METAL DRAWER BOX
6 PCS - 5/8" KICK - FIN. BOTH ENDS
6 PCS - FLAT MOULDING

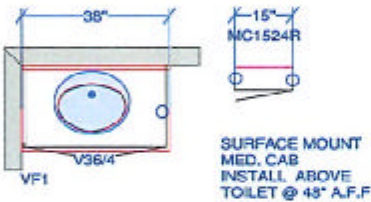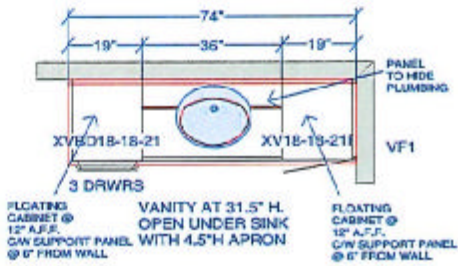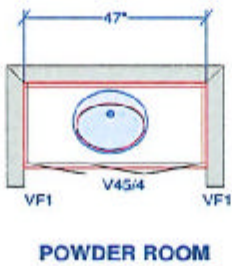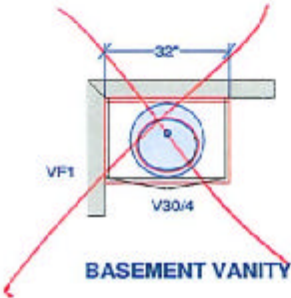

ENSUITE BEDROOM 4

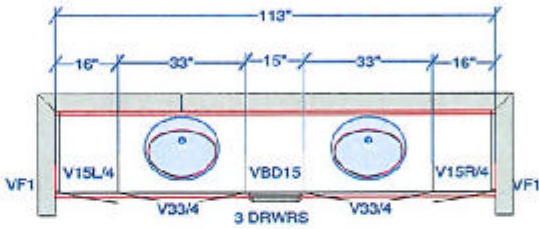

BEDROOM 3 & 5 - JACK & JILL ENSUITE

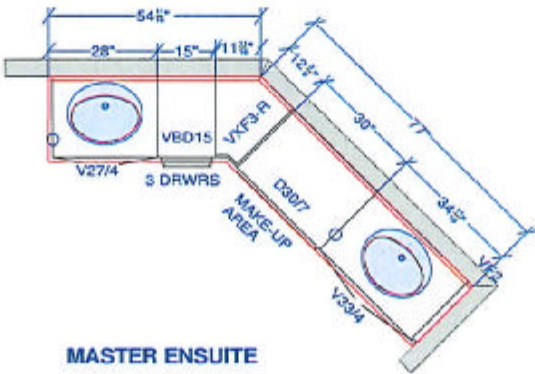

CUSTOMER APPROVAL

I have reviewed these drawings and understand the details of the design and the CARTIER KITCHENS specifications.

Signature _____

Date _____

All dimensions, size designations given are subject to verification on job site and adjustment to fit job conditions.

SPECTRUM KITCHEN and BATH DESIGN

DCR #47 Diamondview Estates 2 - NEWINGTON - VANITIES - 5 Bdrm.kit



This is an original design and must not be released or copied unless applicable fee has been paid or job order placed.

DRAWN BY: LORI DISAVERIO, B.I.D

Designed: 2021-04-23

Printed: 2021-04-23

Drawing #: 1 No Scale.


DS ME DS ED

DS


ME

DS


EA

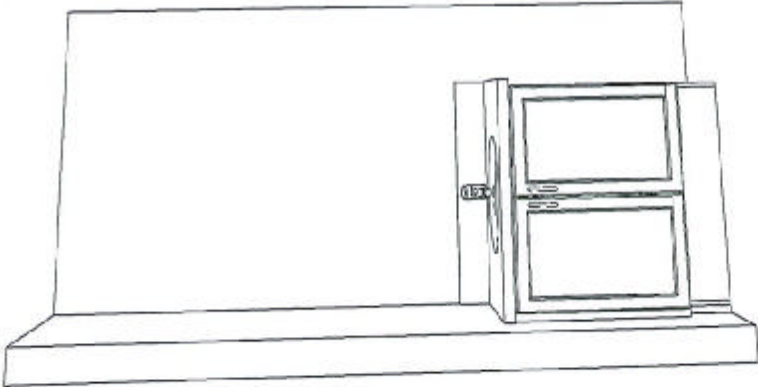

BASEMENT VANITY

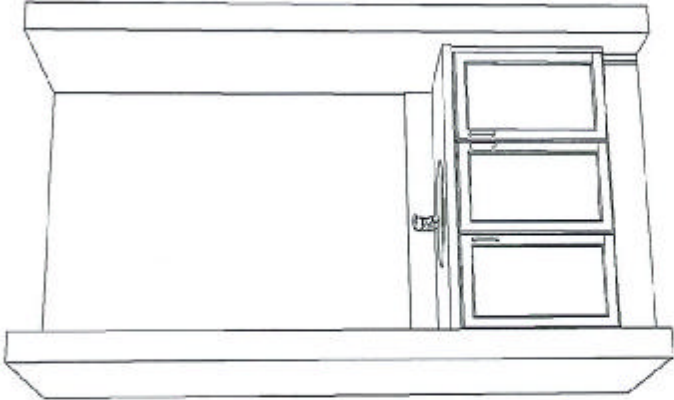

POWDER ROOM
VANITY

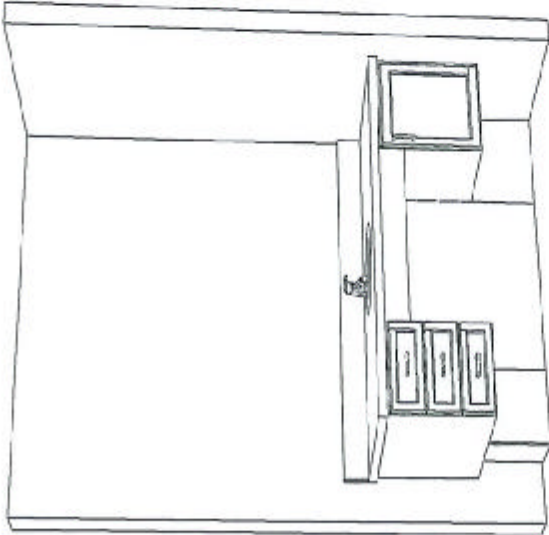

IN-LAW ENSUITE
ACCESSIBLE VANITY

CUSTOMER APPROVAL

I have reviewed these drawings and understand the details of the design and the CARTIER KITCHENS specifications.

Signature _____

Date _____

Note: This drawing is an artistic interpretation of the general appearance of the design. It is not meant to be an exact rendition.

SPECTRUM KITCHEN and BATH DESIGN

DCR #47 Diamondview Estates 2 - NEWINGTON -




Designed: 2021-04-23
Printed: 2021-04-23

All


Drawing #: 1

DS
ME


DS
ED

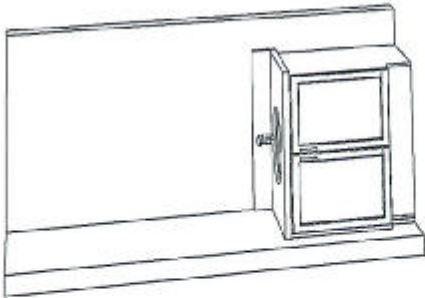

BDRM 4
ENSUITE VANITY

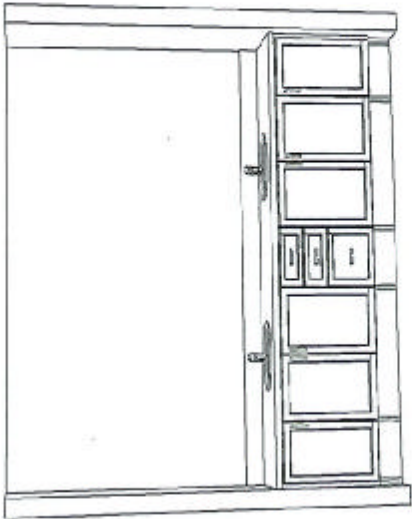

BDRM 3 & 5 -
SHARED VANITY

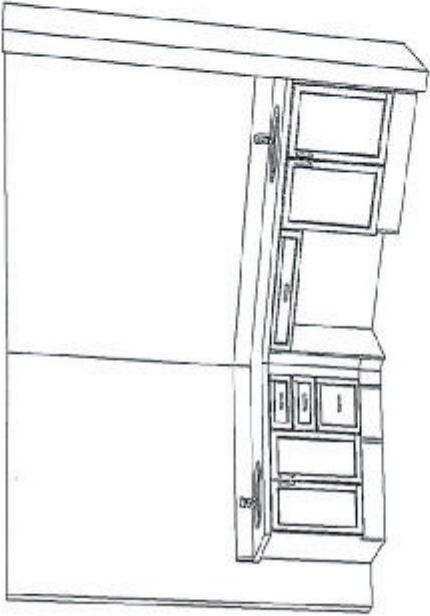

MASTER ENSUITE VANITY

CUSTOMER APPROVAL

I have reviewed these drawings and understand the details of the design and the CARTIER KITCHENS specifications.

Signature: _____

Date: _____

Note: This drawing is an artistic interpretation of the general appearance of the design. It is not meant to be an exact rendition.

SPECTRUM KITCHEN and BATH DESIGN



DCR #47 Diamondview Estates 2 - NEWINGTON -

All

Drawing #: 1


Designed: 2021-04-23
Printed: 2021-04-23

DS

ME

DS

EL

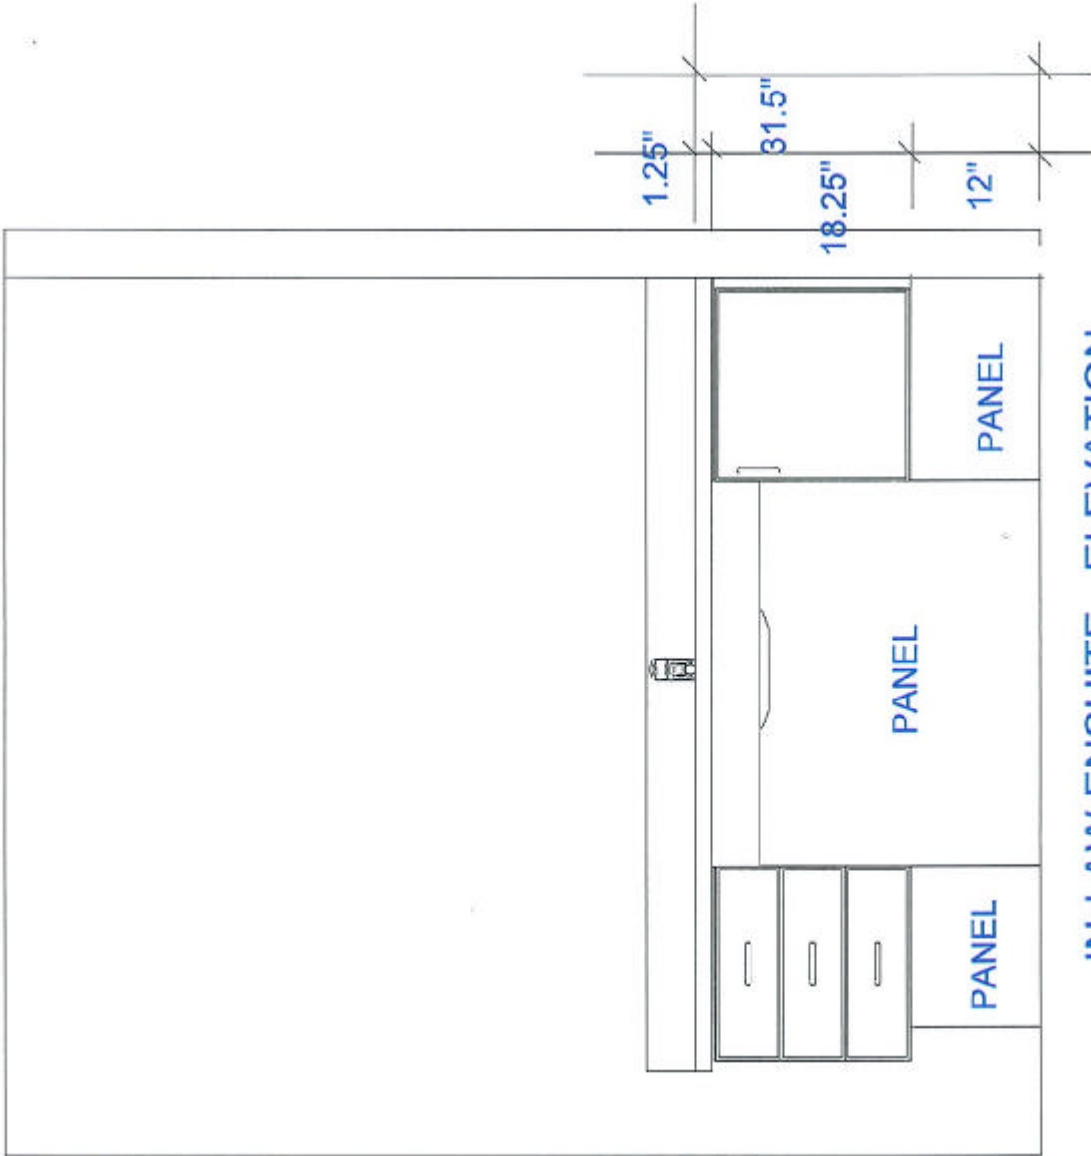

IN-LAW ENSUITE - ELEVATION

CUSTOMER APPROVAL

I have reviewed these drawings and understand the details of the design and the CARTIER KITCHENS specifications.

Signature _____

Date _____

Note: This drawing is an artistic interpretation of the general appearance of the design. It is not meant to be an exact rendition.		Designed: 2021-04-23 Printed: 2021-04-23	
SPECTRUM KITCHEN and BATH DESIGN			
DCR #47 Diamondview Estates 2 - NEWINGTON -		All	Drawing #: 1