




Owner/Applicant
DCR/PHOENIX HOMES
Telephone # 723-9227
Plan # 4M-1617
Project name: PATHWAYS
Civic Address: 209 PINGWI PLACE
House model: STRATHMORE M

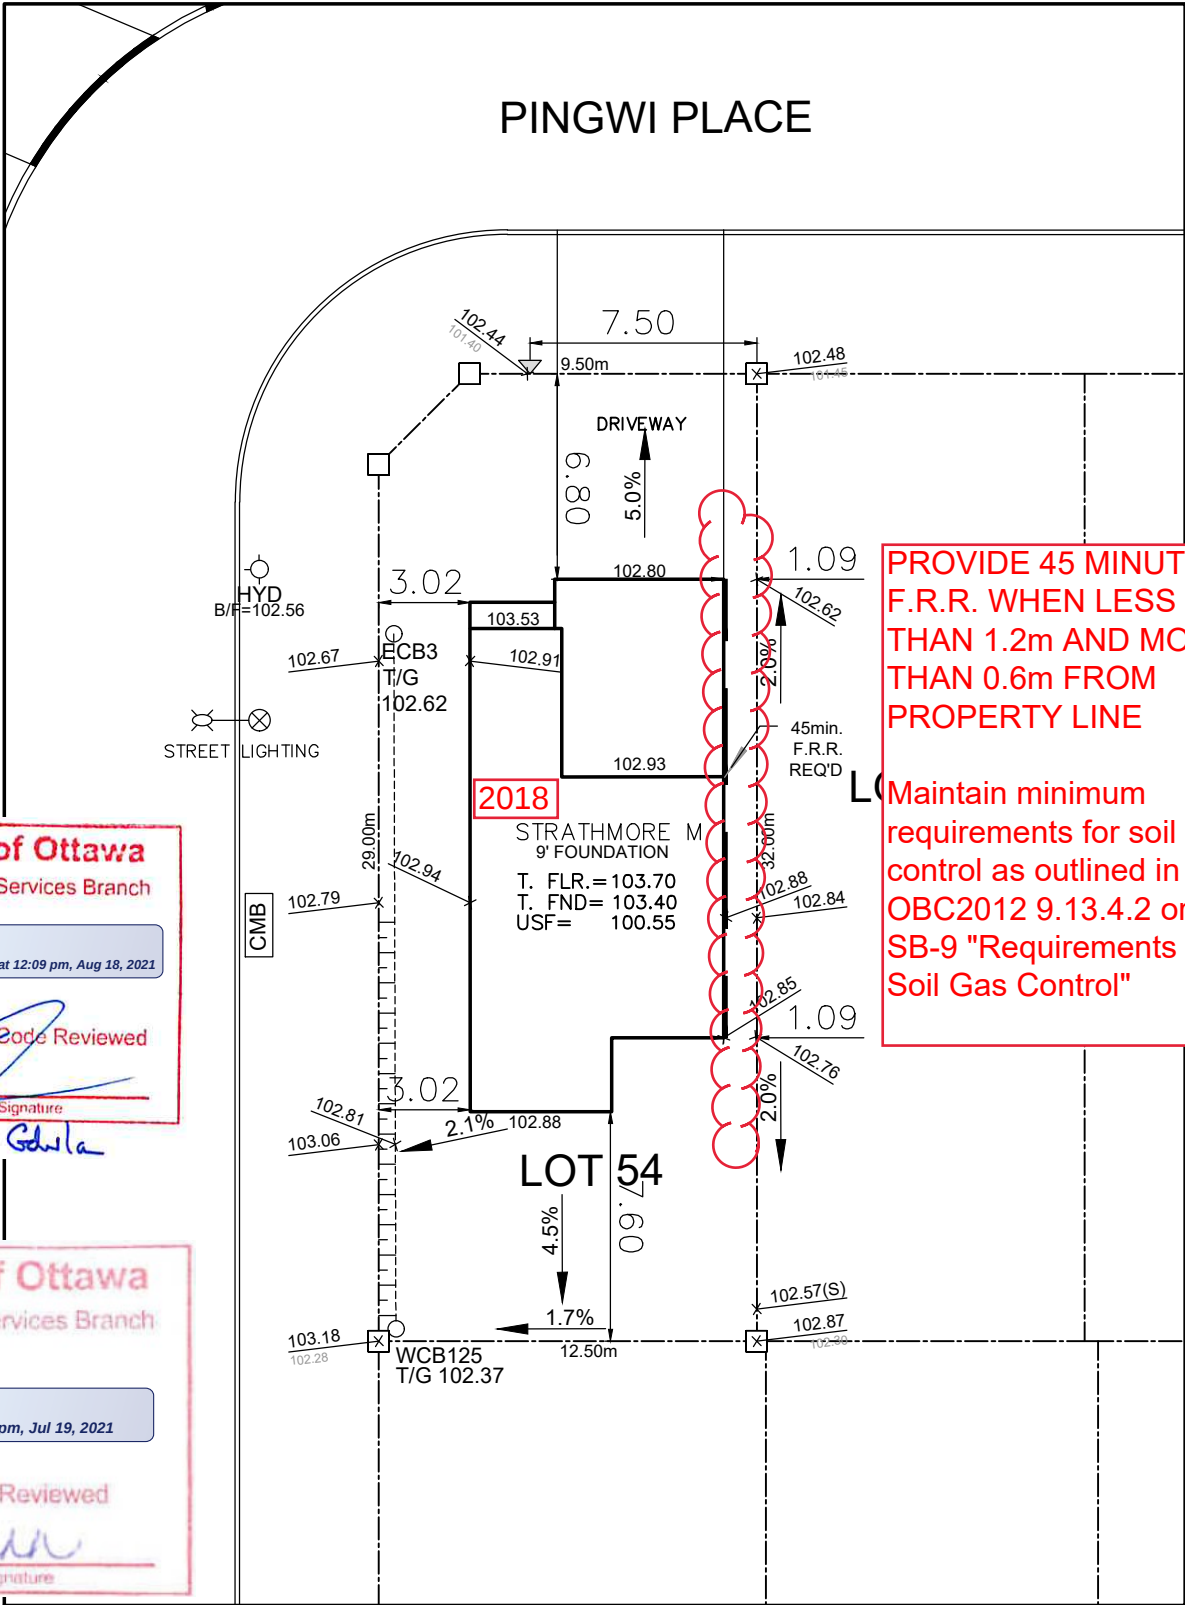

SITE/GRADING PLAN
PATHWAYS

INDIVIDUAL LOT GRADING REVIEW SUMMARY FOR SITED
HOUSE AS COMPARED WITH OVERALL SUBDIVISION PLAN

Bldg. Ht. _____ **m**
Lot coverage _____ **%**
Scale 1:250
Sod Area _____ **m²**
Asphalt Area _____ **m²**

NOTE: THIS PLAN IS NOT A SURVEY PLAN OR SUBDIVISION
PLAN WITHIN THE MEANING OF PLANNING ACT.
THIS PLAN IS FOR REFERENCE ONLY AND IS PRELIMINARY IN NATURE, ALL
DIMENSIONS SHOWN ARE APPROXIMATE. E.O&E.

CHECKED/APPROVED BY: T.L.MAK ENG.