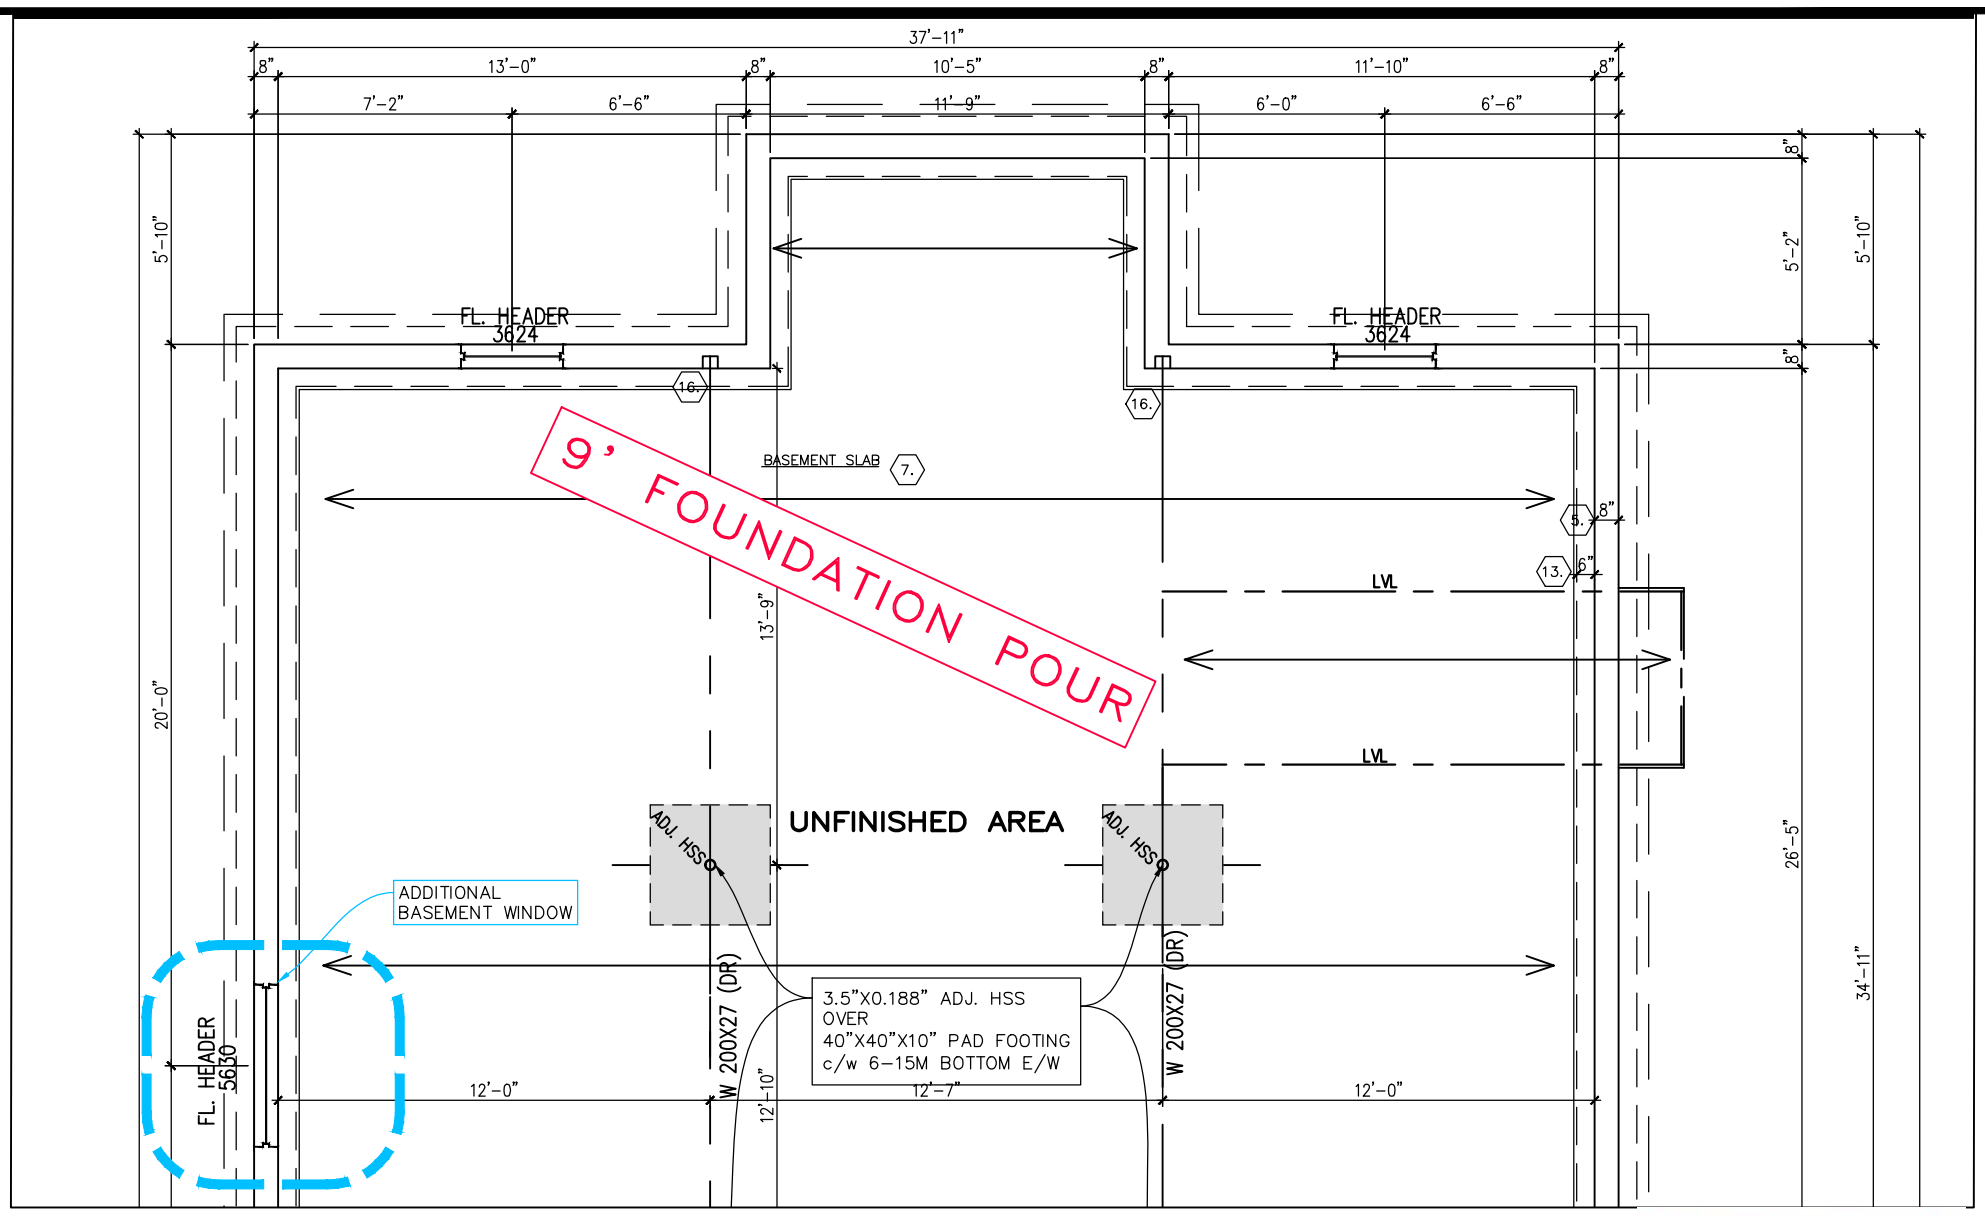

1/1 PARTIAL FOUNDATION PLAN

scale: 3/16"=1'-0"

City of Ottawa
Building Services Branch
REVIEWED
By Nicholas Winn at 9:02 am, Aug 26, 2021
Building Code Reviewed
Signature

REVIEWED FOR MARKED CHANGE ONLY

TO BE READ IN CONJUNCTION WITH MASTER FOOTPRINTED PLANS

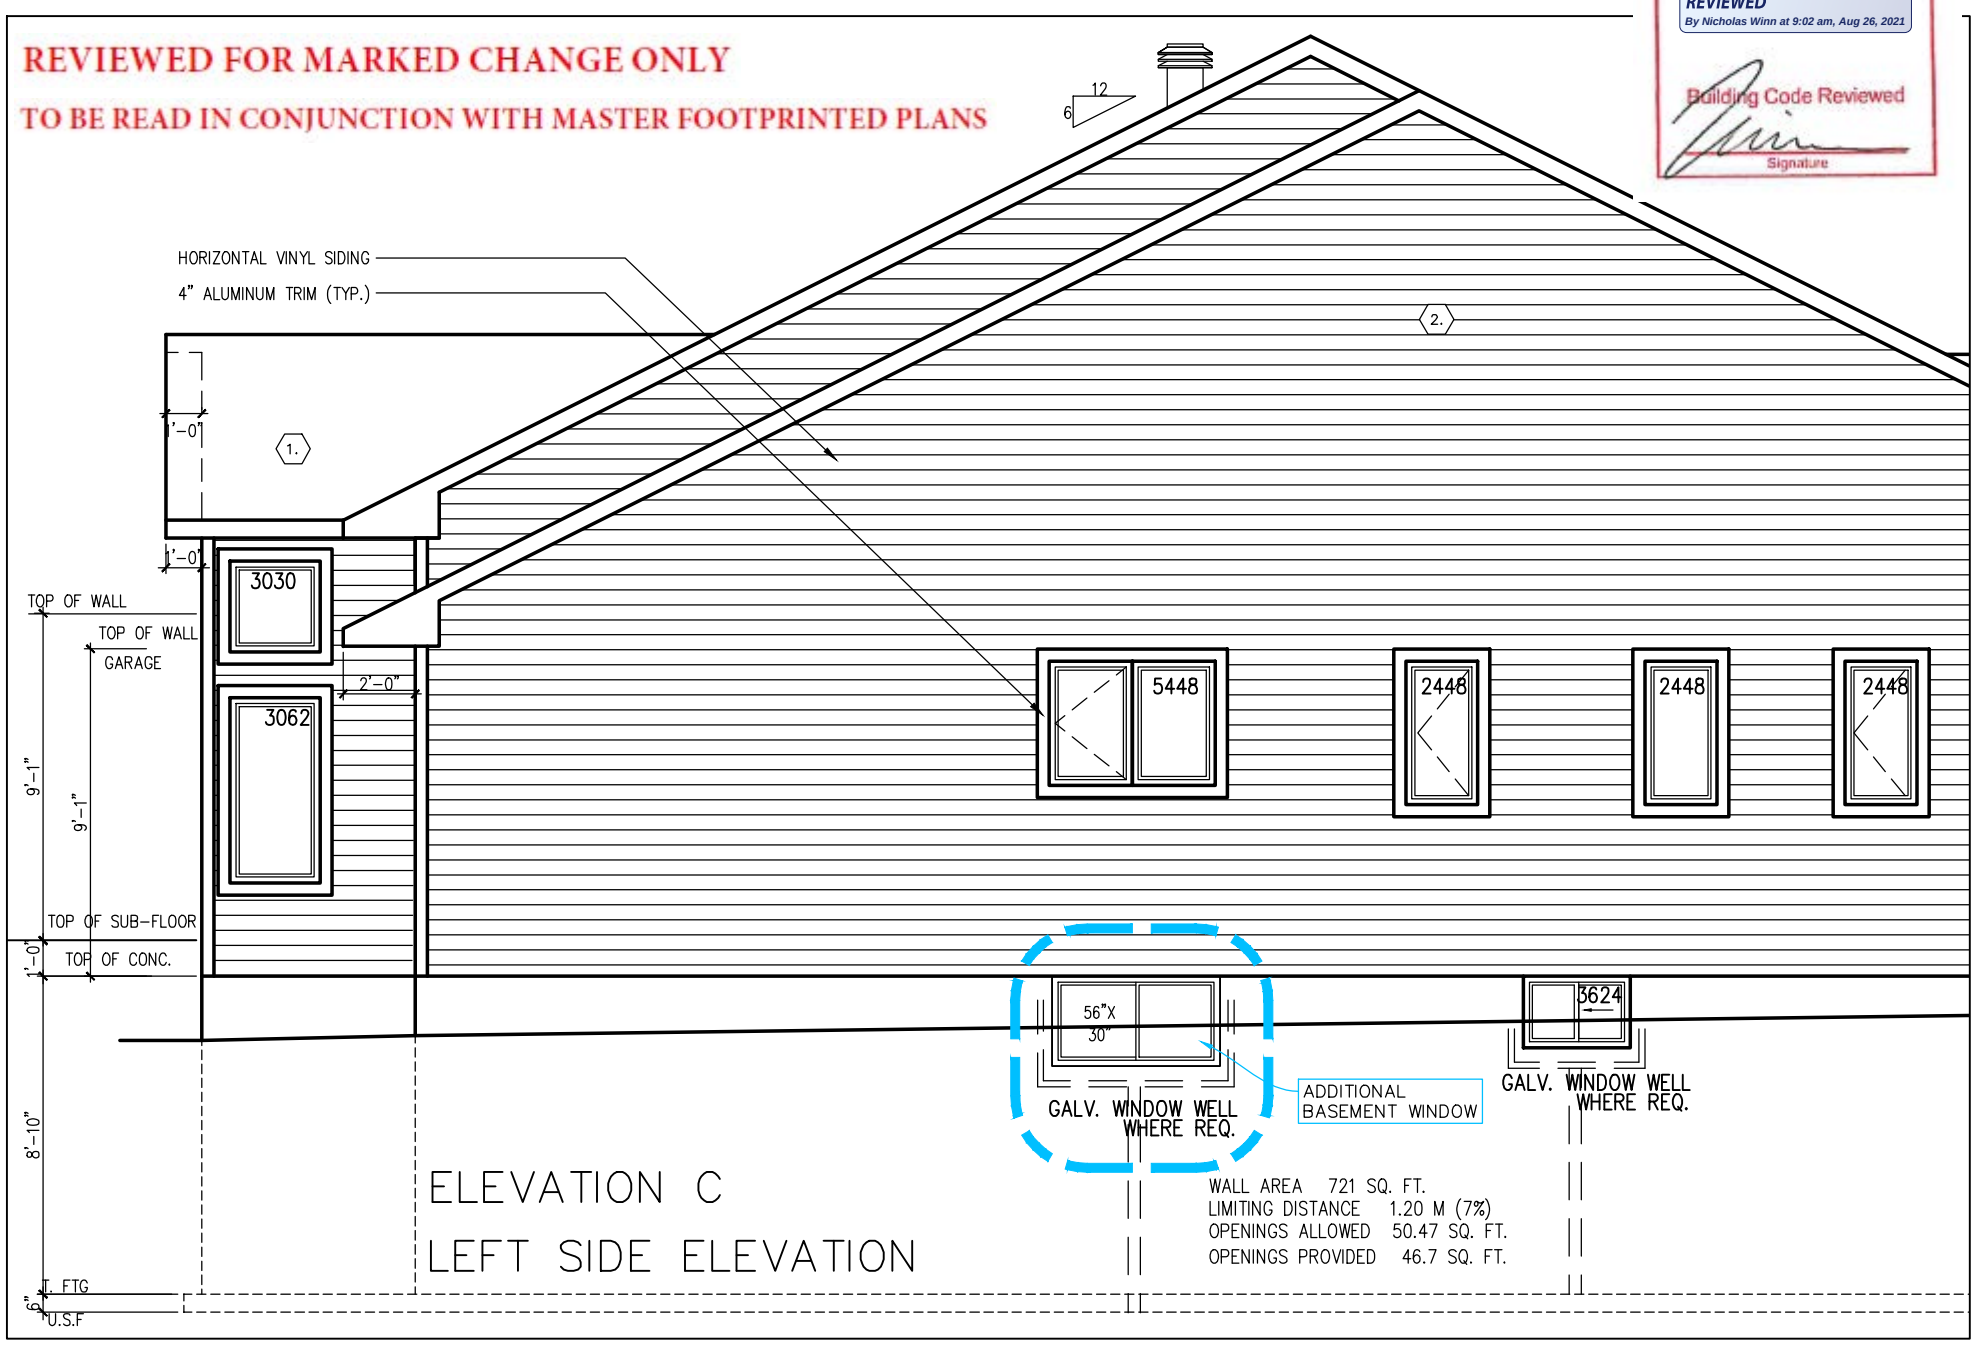

2/1 PARTIAL SIDE ELEVATION

scale: 3/16"=1'-0"

PHOENIX HOMES

SPRINGFIELD – 2018

SITE: DIAMONDVIEW ESTATES

LOT NUMBER: 2-38

CIVIC ADDRESS:
1966 CESSNA PRIVATE

No.	Description	dd/mm/yy	By
1	ADDED BSMT WINDOW & 9' FOUNDATION	10/08/21	CB

REVISIONS

footprint:	B-24
drawn by:	SD
date:	SEP/12
scale:	3/16"=1'-0"
sheet no:	1/1