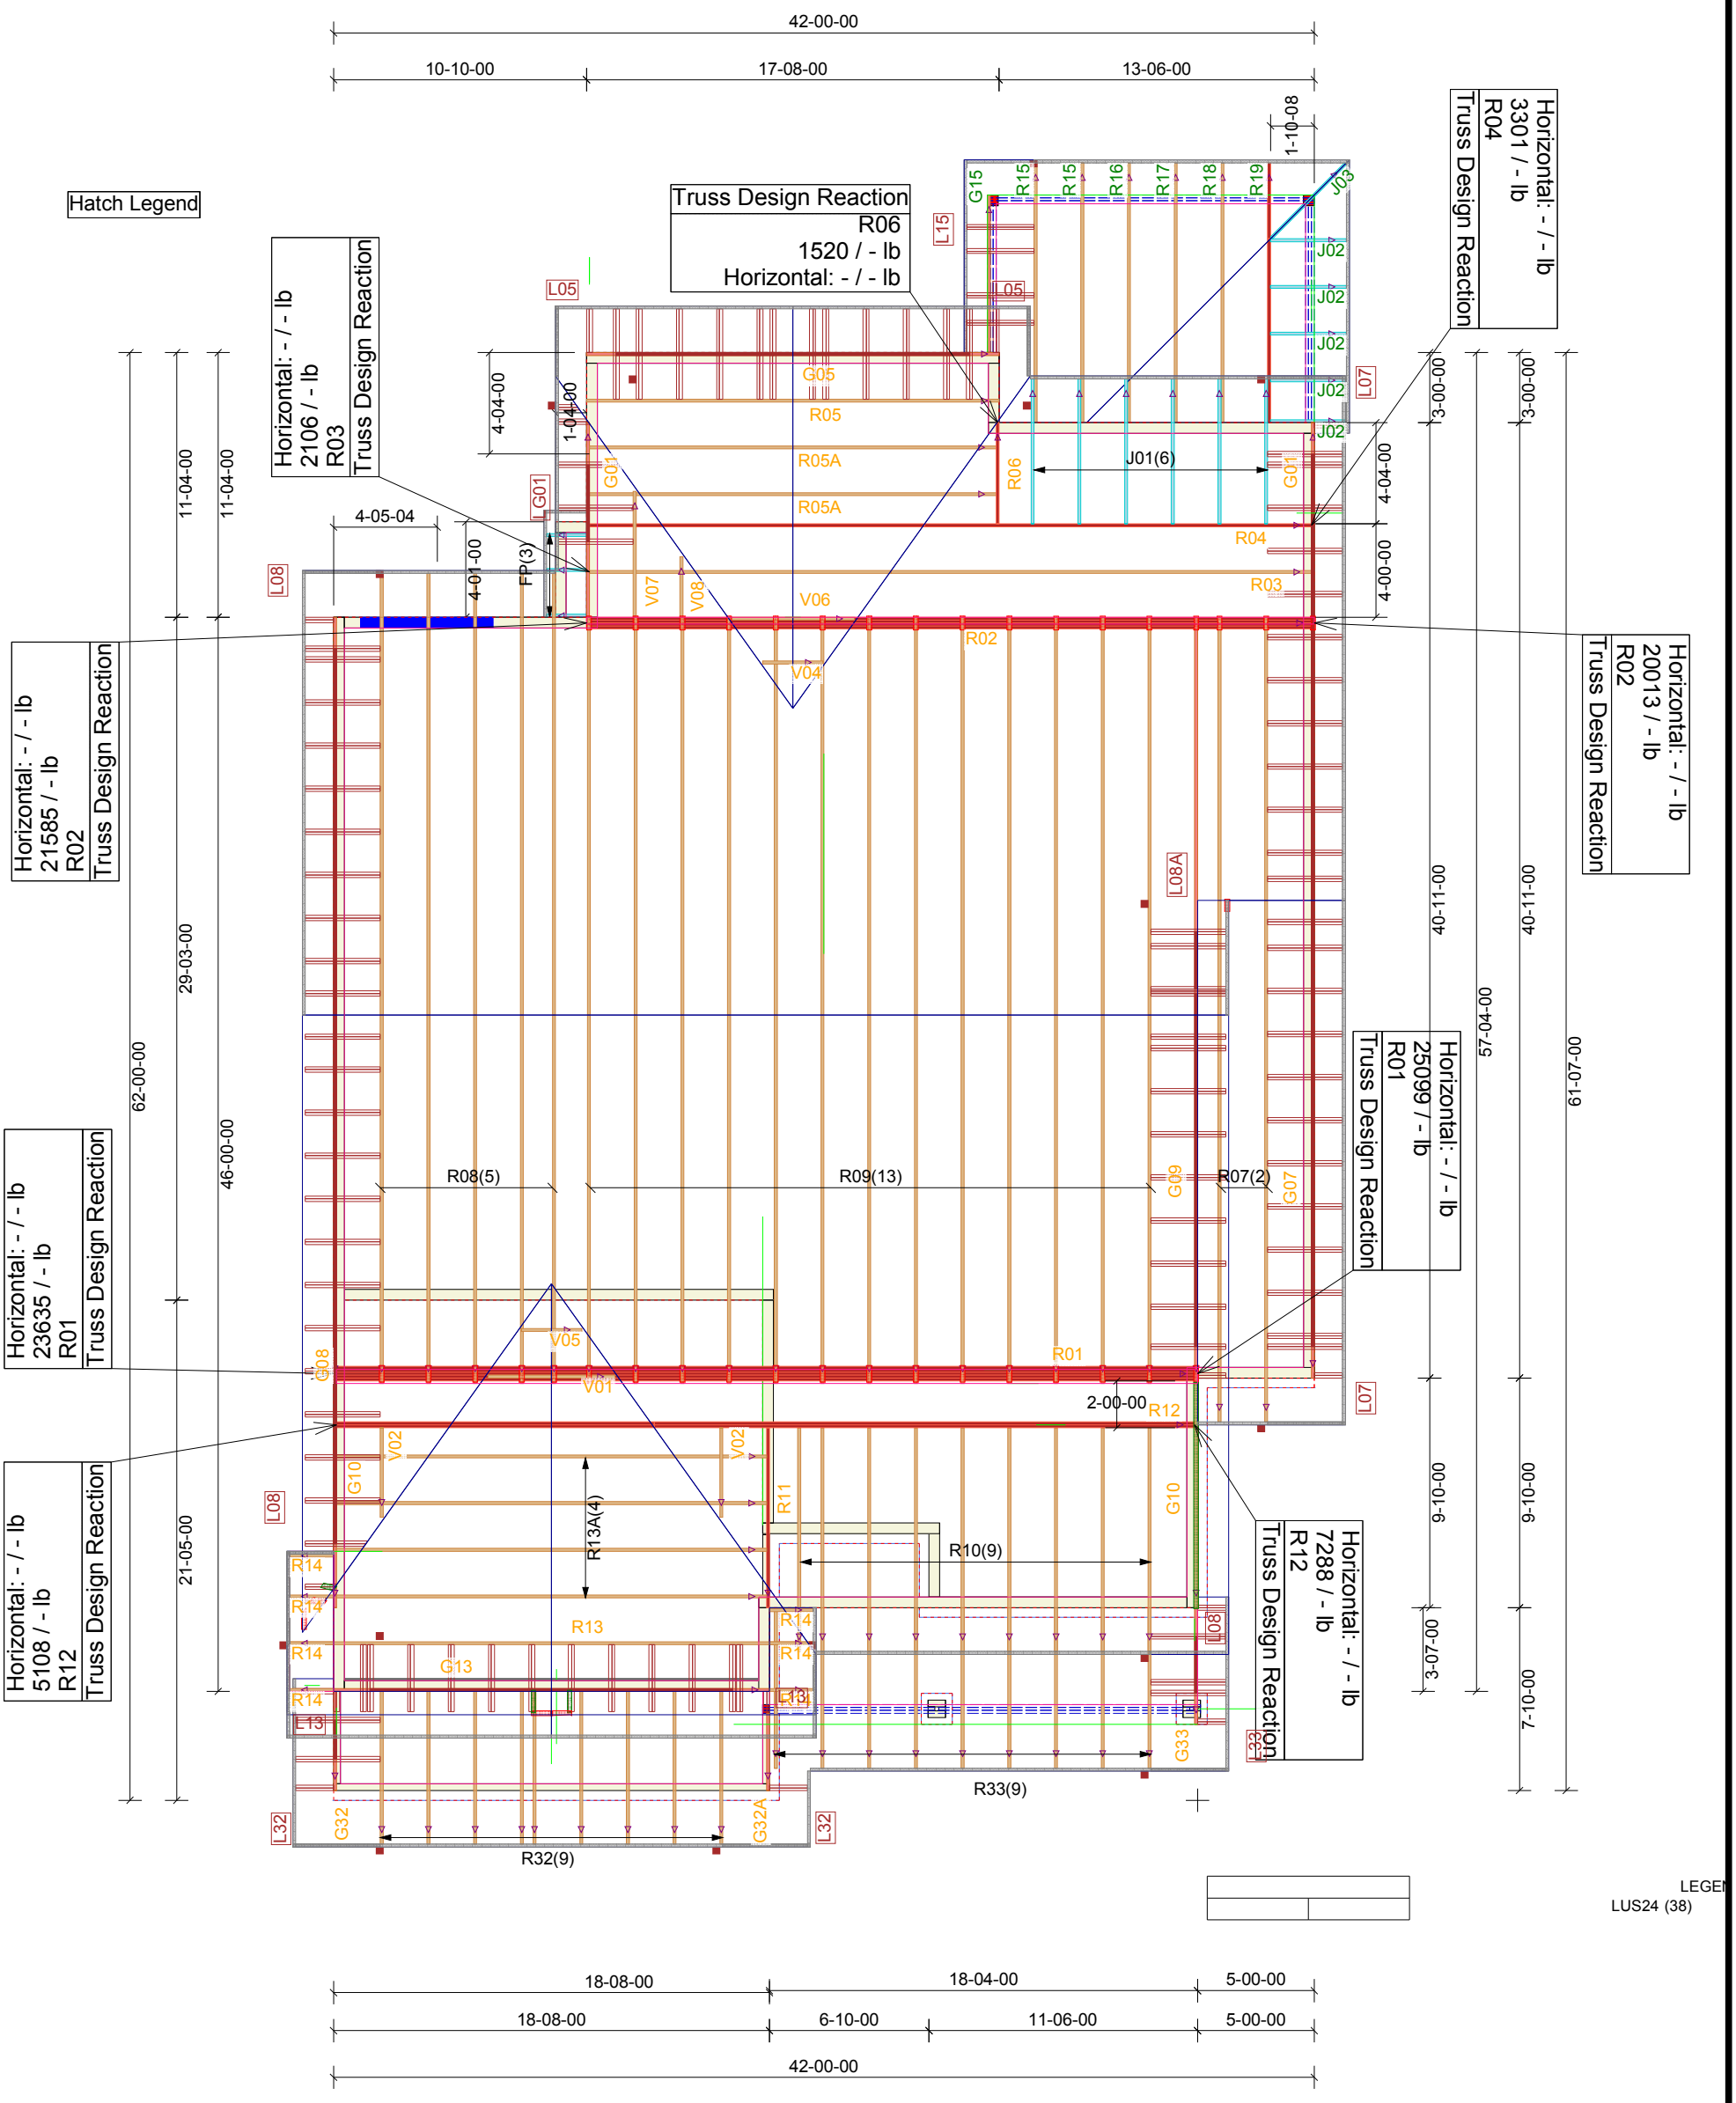

TYPICAL OTTAWA DESIGN LOADS

Member	Load Type	PT 9	PT 4	
Top Chord	Snow	37.1	50	PSF
	Dead	3	5-10	
Bot Chord	Live	0	10	
	Dead	7	7	

TYPICAL SPACING = 24.0 IN C/C

THIS DESIGN COMPLIES WITH:

- PART 4 OR 9 OF OBC 2012 Reg. 332/12 (2019 Amendment)
- CSA 086-09
- CCMC ACCEPTANCE 11996-L, 0319-L, 13270-L
- TPIC 2014

(REFER TO INDIVIDUAL TRUSS DRAWINGS FOR SPECIFIC LOADS & SPACING)

HURRICANE AND SEISMIC TIES:

- ANY TIES SPECIFIED ON THIS LAYOUT FOR UPLIFT OR SEISMIC CONNECTIONS MUST BE REVIEWED AND APPROVED BY THE BUILDING DESIGNER/ ENGINEER, AS STATED IN THE TPIC 2014. THE TRANSFER OF THESE LOADS TO THE ENTIRE STRUCTURE BELOW HAS NOT BEEN ANALYZED.

GRANDOR LUMBER INC.
ALPA LUMBER GROUP

JOB:
PHOENIX HOMES
NEWINGTON D
PNEWD-1 DV2-15

DATE: 06/08/2021

City of Ottawa
Building Services Branch
REVIEWED
By Nicholas Winn at 10:19 am, Sep 01, 2021
Building Code Reviewed
Signature