


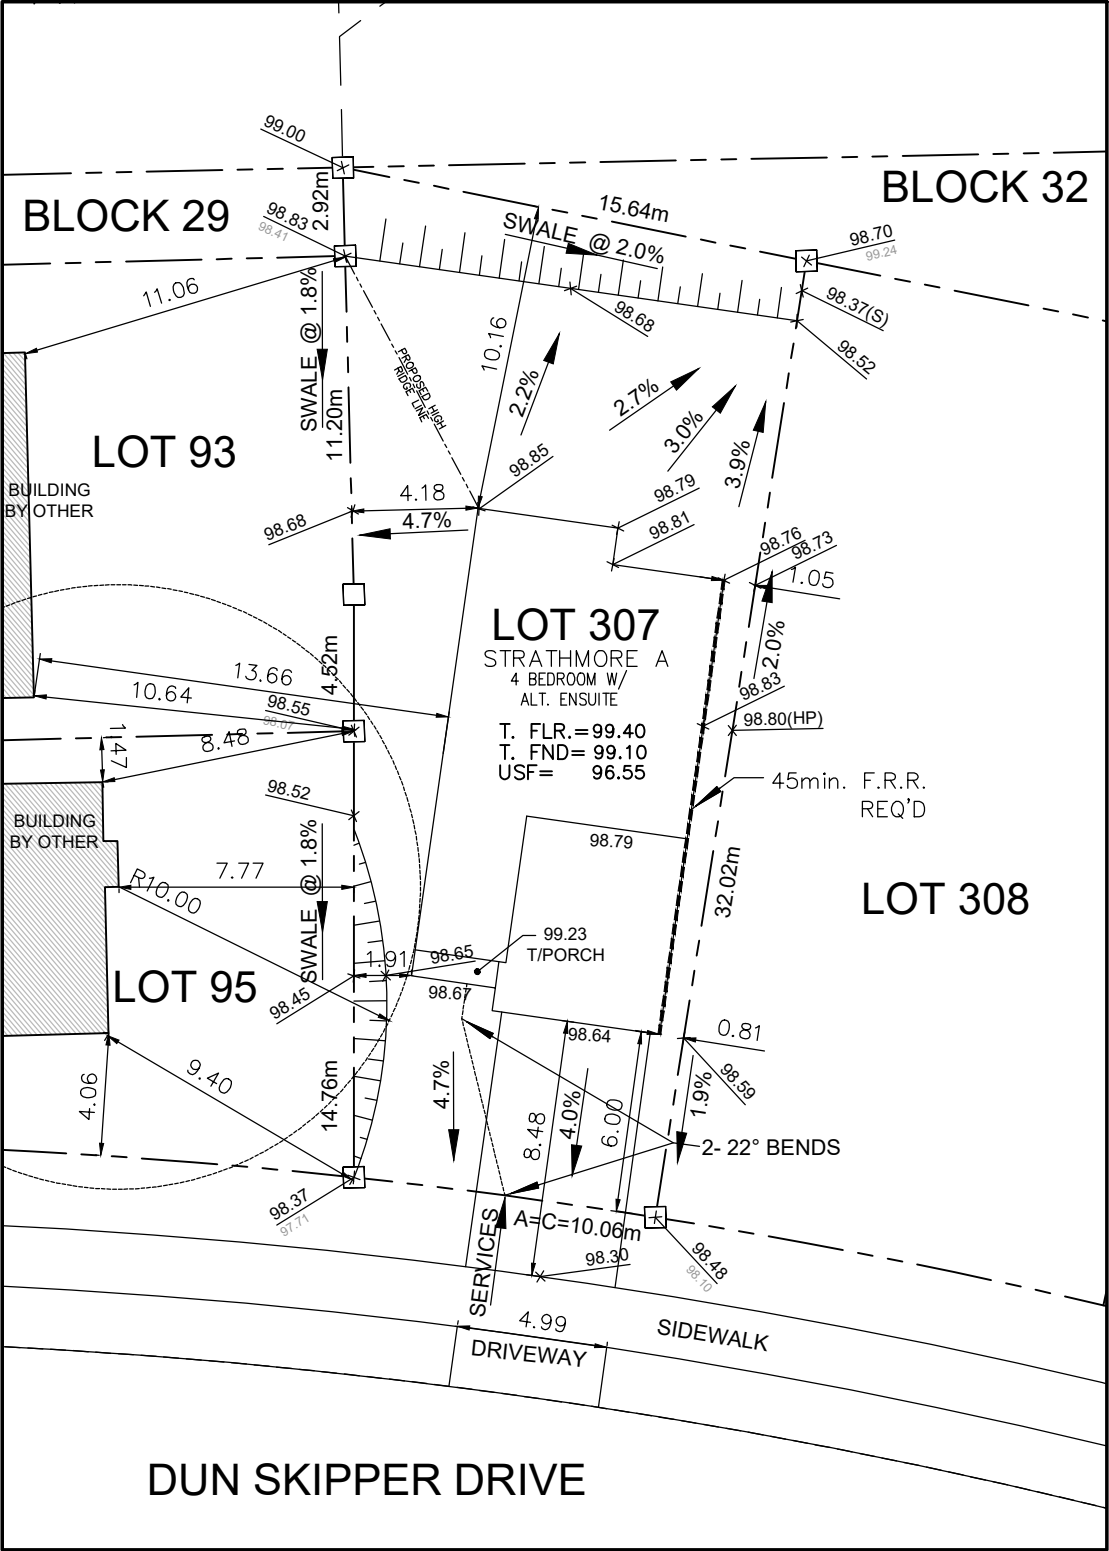

Owner/Applicant DCR/PHOENIX HOMES Telephone # <u>723-9227</u> Plan # <u>4M- 1618</u> Project name: <u>PATHWAYS</u> Civic Address: <u>33 DUN SKIPPER DRIVE</u> House model: <u>STRATHMORE A</u>		 LOT 307 SITE/GRADING PLAN PATHWAYS PHASE 2	
Bldg. Ht. <u> </u> m Lot coverage <u>31.7</u> % Scale <u>1:250</u> Sod Area <u>276</u> m² Asphalt Area <u>50</u> m²		INDIVIDUAL LOT GRADING REVIEW SUMMARY FOR SITED HOUSE AS COMPARED WITH OVERALL SUBDIVISION PLAN	
CHECKED/APPROVED BY: T.L.MAK ENG. SEPT 24/21 REVISD PER CITY COMMENTS OCT 12/21 REVISD GRADES PER T.L.MAK		NOTE: THIS PLAN IS NOT A SURVEY PLAN OR SUBDIVISION PLAN WITHIN THE MEANING OF PLANNING ACT.	