

DCR PHOENIX HOMES

STRANDHERD MEADOWS 5  
PLATINA (512) - LEFT  
KITCHEN

CABINET LINE -  
DOOR STYLE -  
SPECIES -  
COLOUR -

HARDWARE -


KICK: 3-PCS.

STD WHITE INTERIORS

METAL DRAWER BOXES

2 - PCS. 90 DEG. CORNER MOULD.

1 PC - T MOULD

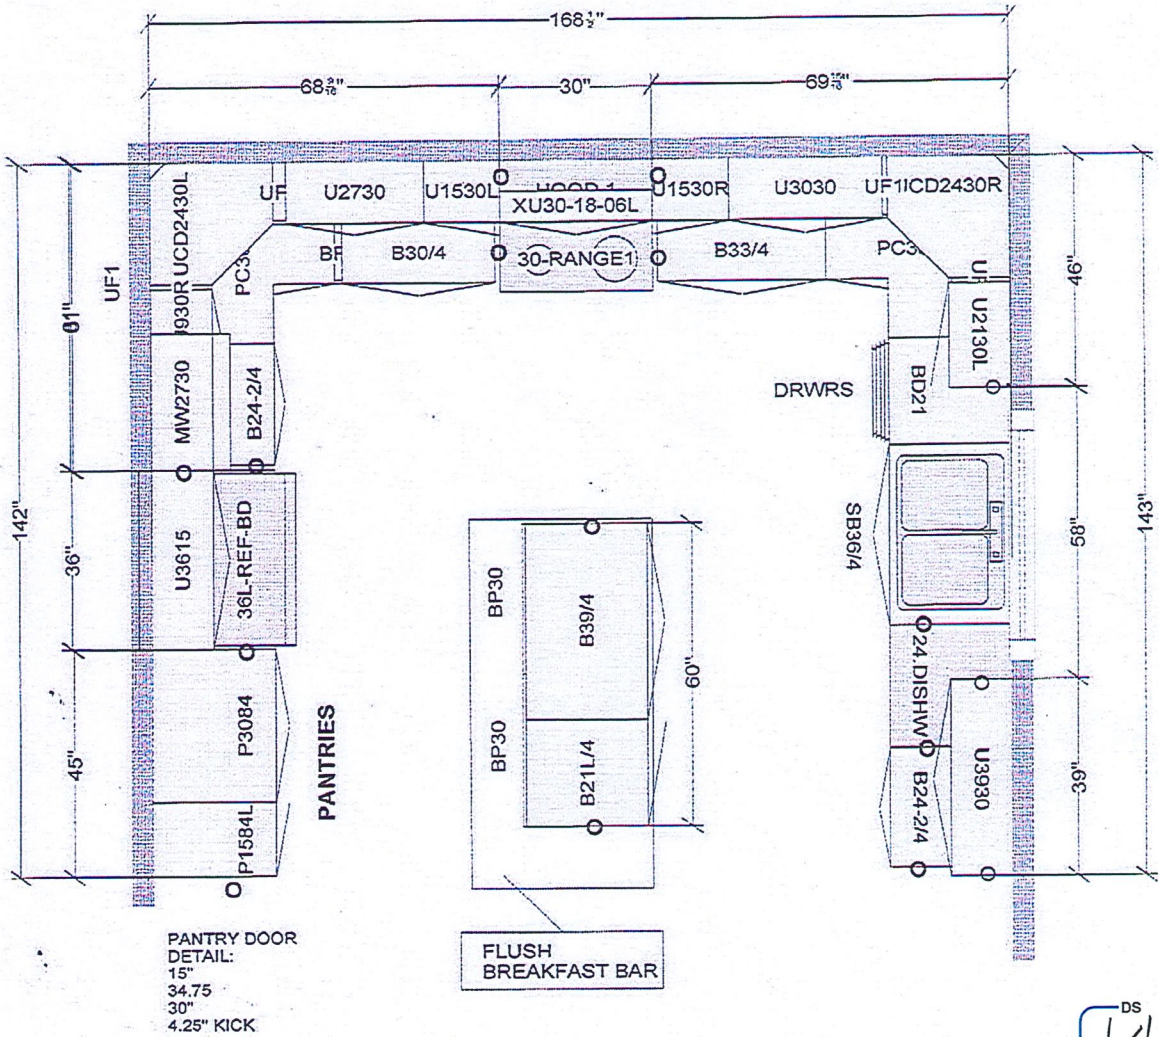

All dimensions, size designations  
given are subject to verification on  
job site and adjustment to fit job  
conditions.

CARTIER KITCHENS OTTAWA

DCR - PLATINA (512) - LEFT



This is an original design and must  
not be released or copied unless  
applicable fee has been paid or job  
order placed.


DRAWN BY: LD  
CARTIER KITCHENS OTTAWA

DS  
K K L M H  
DS

Designed: 11/30/2008  
Printed: 6/26/2011

All

Drawing #: 1

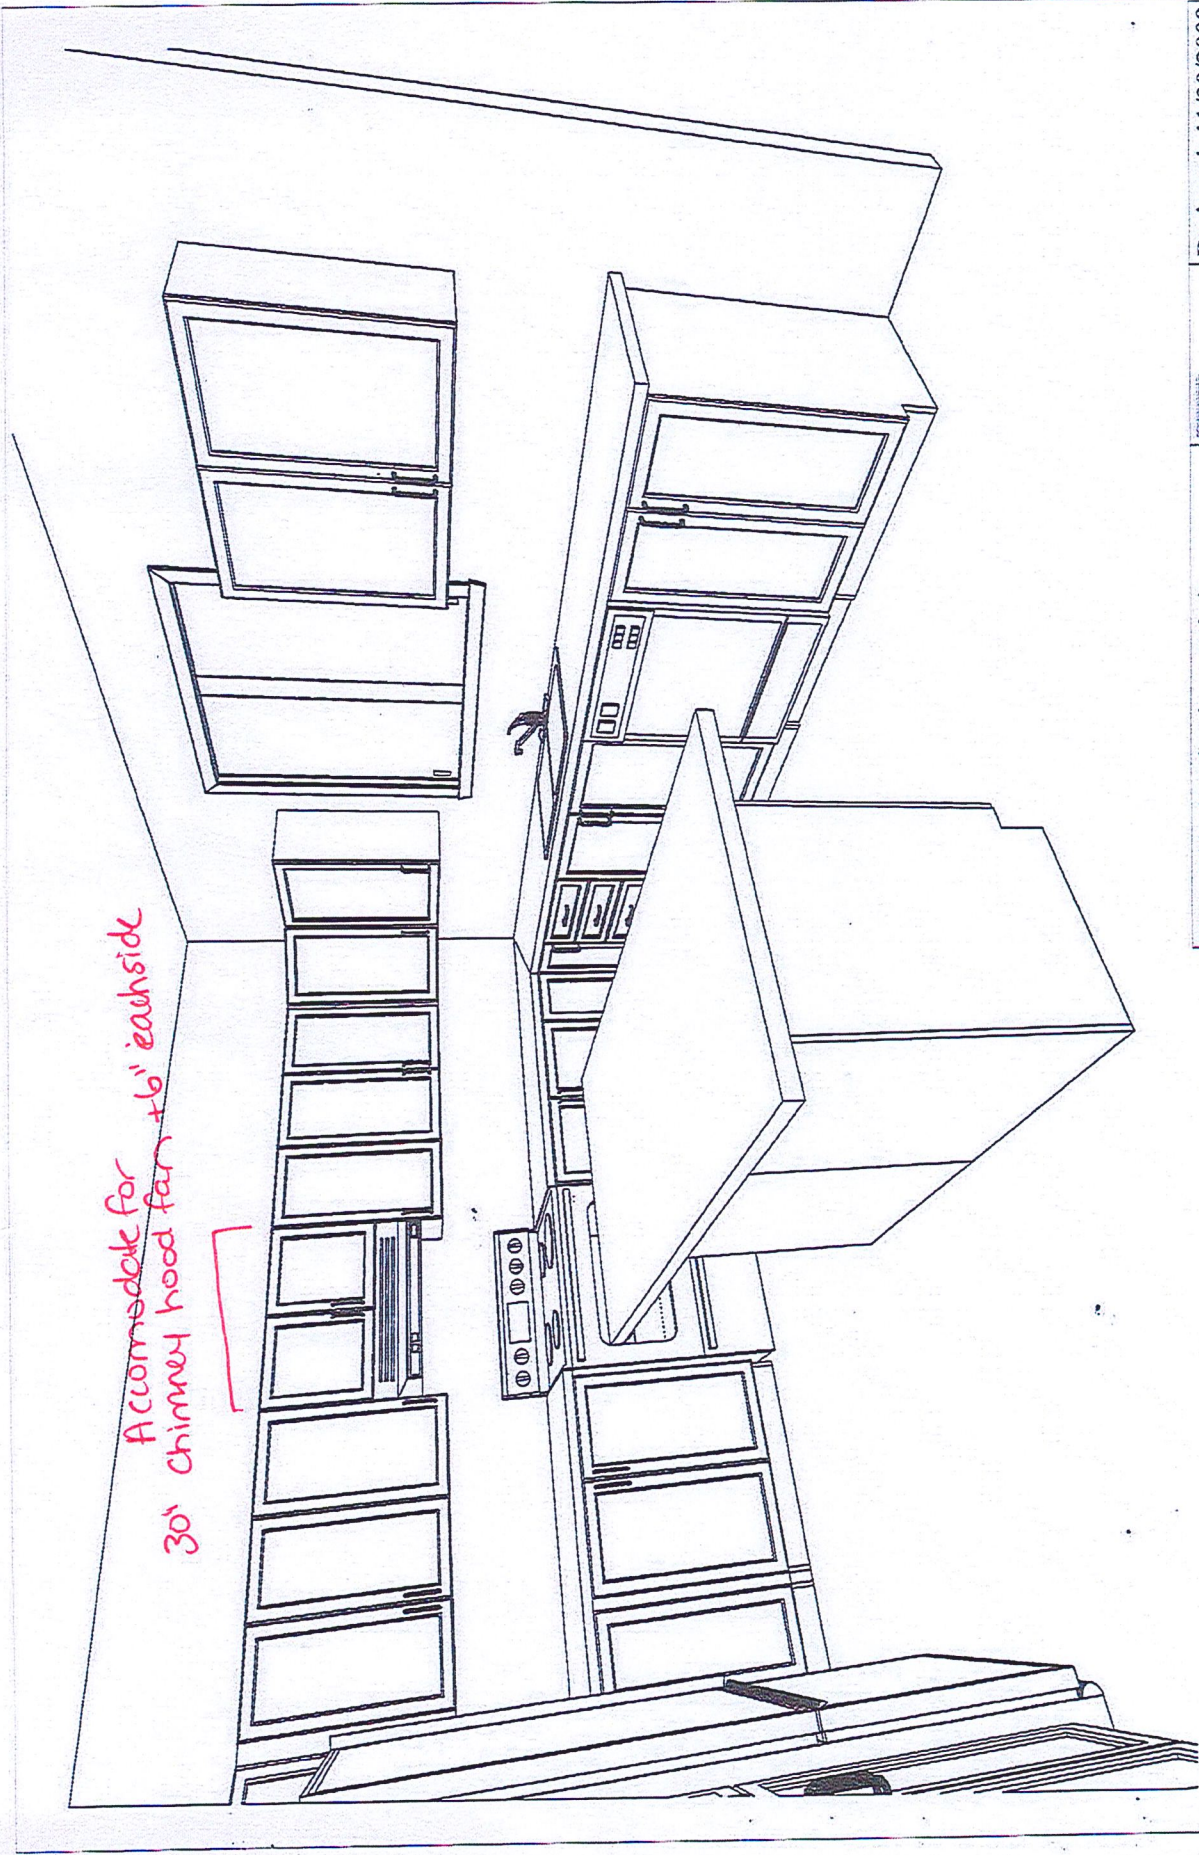

Note: This drawing is an artistic interpretation of the general appearance of the design. It is not meant to be an exact rendition.

DRAWN BY: Lori Di Saverio, B.I.D.  
CARTIER KITCHENS OTTAWA  
DCR - PALTINA (512) - LEFT



Designed: 11/30/2008  
Printed: 6/26/2011


All

Drawing #: 1

DS  
K K Ma  
DS


\* Increase height of uppers to reach 96" (42" uppers installed at 18" above counters)  
\* Fill to ceiling with plain furring panel.

Add MV cabinet  
to island +  
12" drawer below

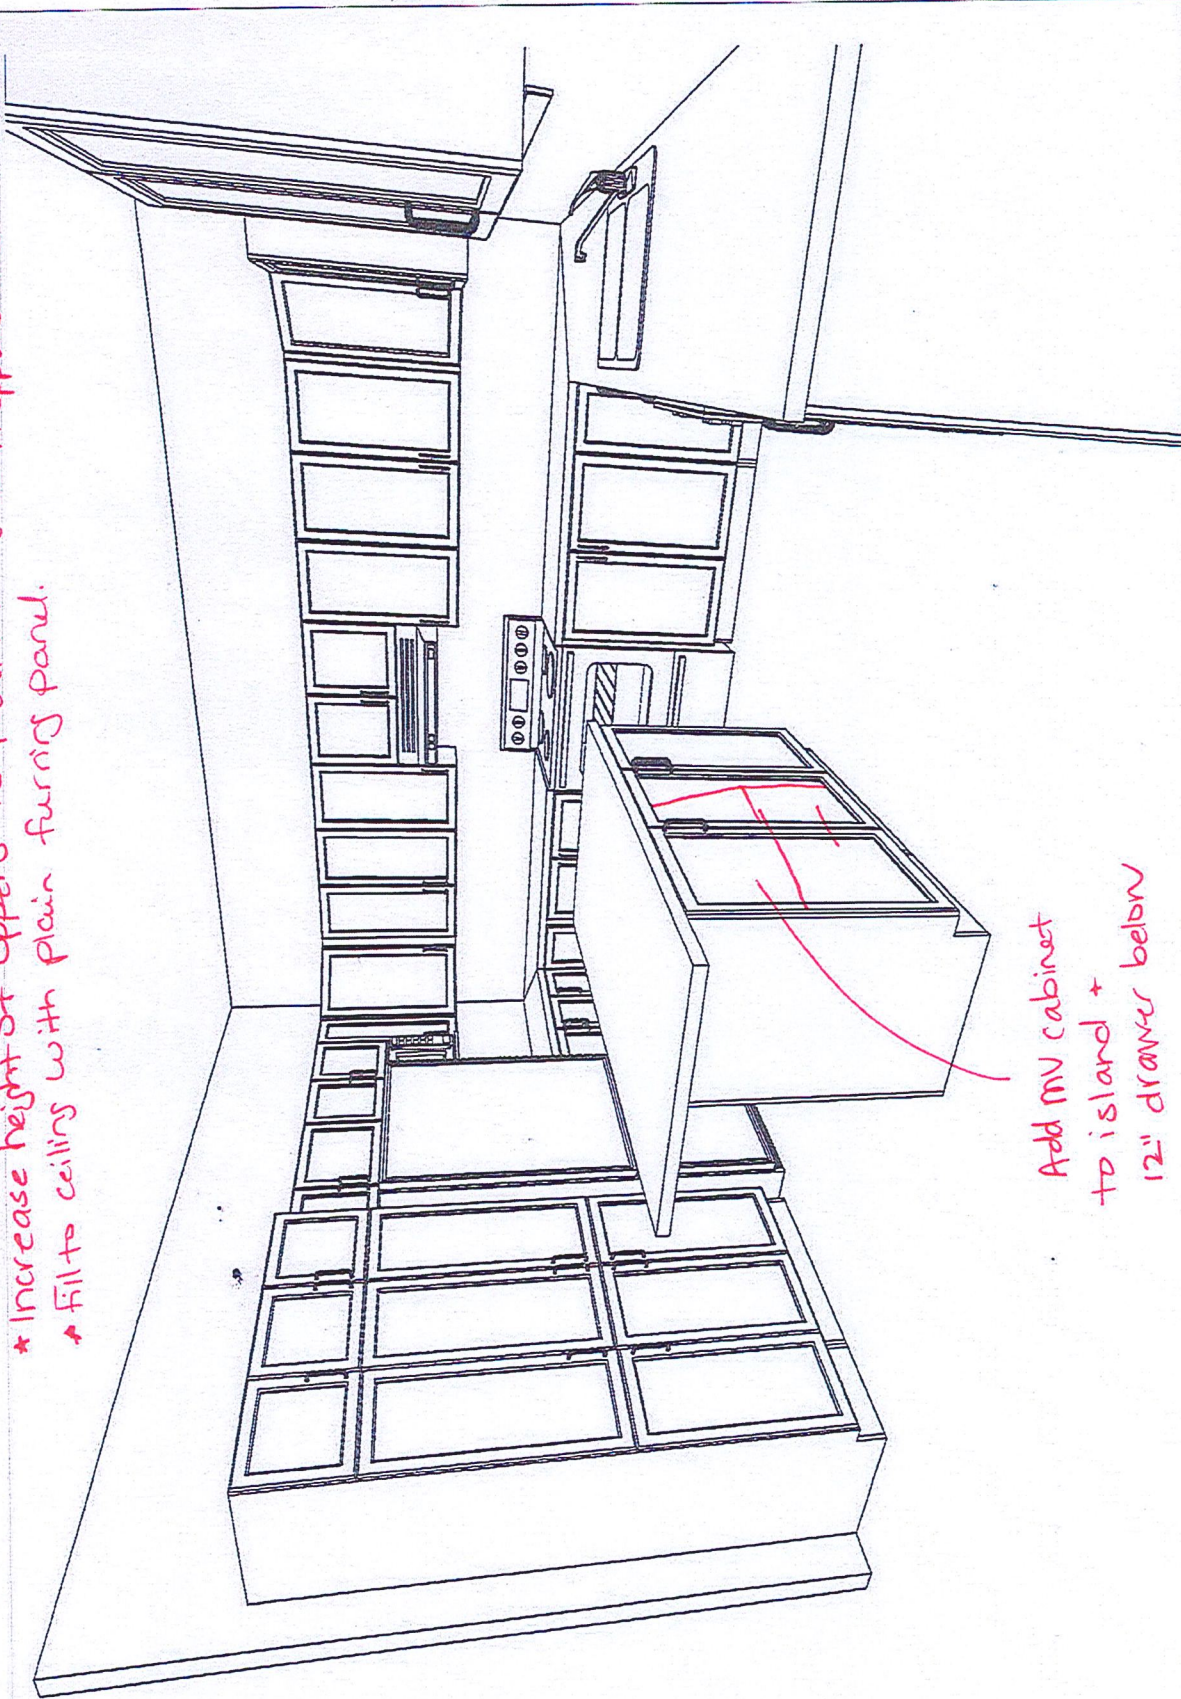

|   |   |     |              |
|---|---|-----|--------------|
| <br><b>2020</b><br>TECHNOLOGIES | Designed: 11/30/2008<br>Printed: 6/26/2011   | All | Drawing #: 1 |
|   | Note: This drawing is an artistic interpretation of the general appearance of the design. It is not meant to be an exact rendition.<br><br>DRAWN BY: Lori Di Saverio, B.I.D.<br>CARTIER KITCHENS OTTAWA<br>DCR - PALTINA (512) - LEFT |     |              |

DS  
KKA  
MA

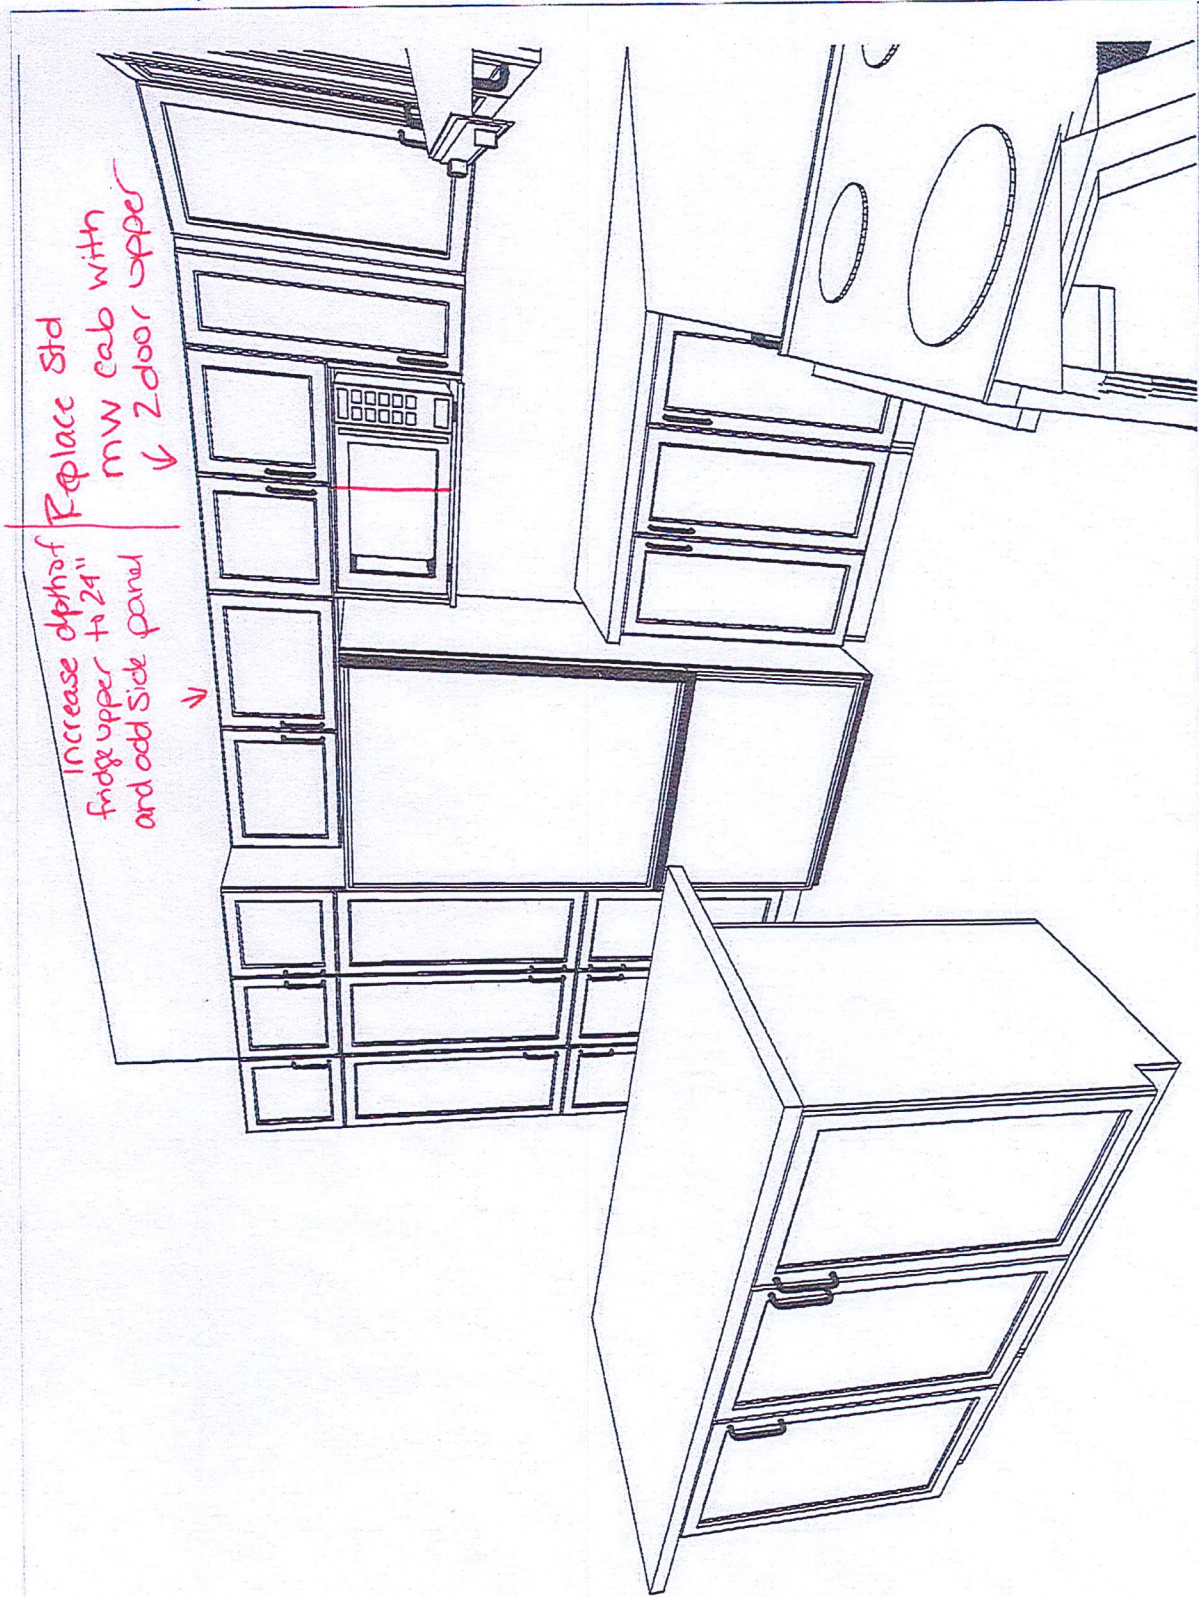

Note: This drawing is an artistic interpretation of the general appearance of the design. It is not meant to be an exact rendition.

DRAWN BY: Lori Di Saverio, B.I.D.  
CARTIER KITCHENS OTTAWA  
DCR - PALTINA (512) - LEFT




Designed: 11/30/2008  
Printed: 6/26/2011

All

Drawing #: 1

DS  
K K Paltina  
DS

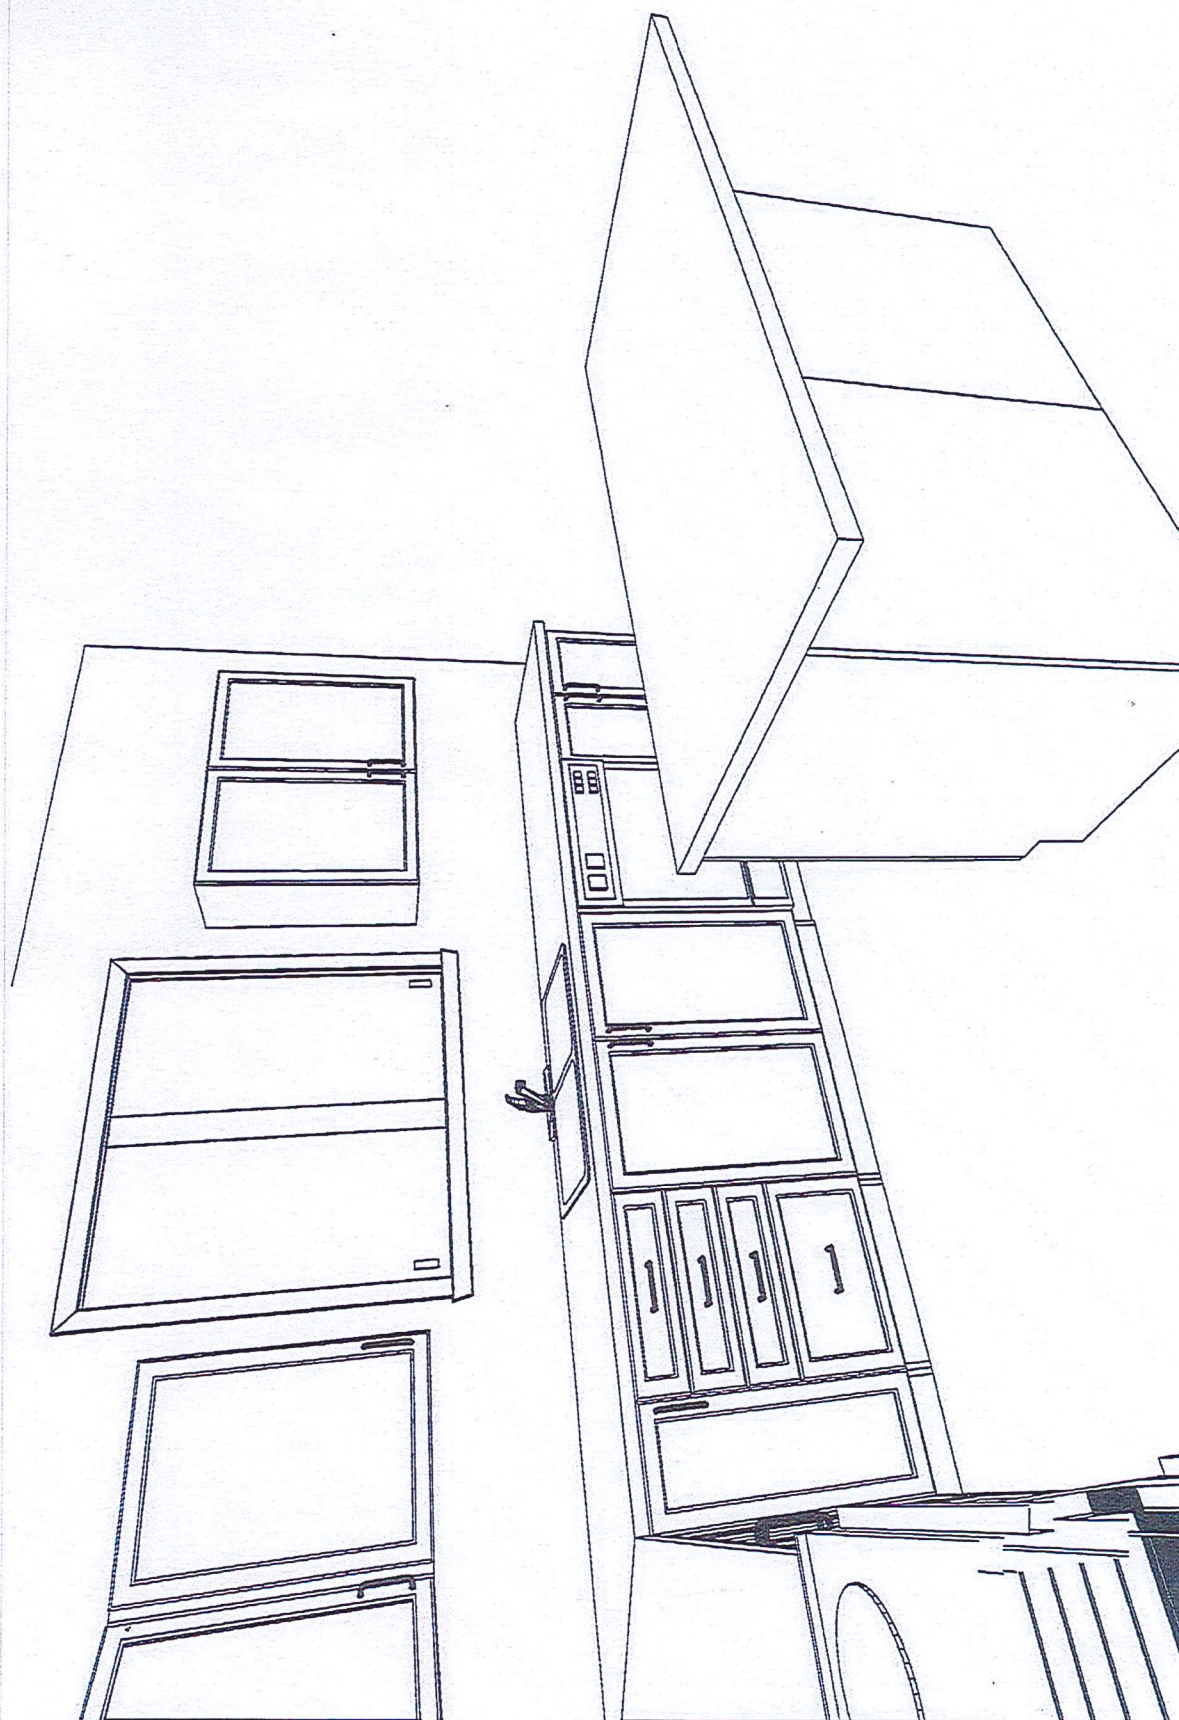

Designed: 11/30/2008  
Printed: 6/26/2011



2020  
TECHNOLOGIES

**Note:** This drawing is an artistic interpretation of the general appearance of the design. It is not meant to be an exact rendition.

DRAWN BY: Lori Di Saverio, B.I.D.  
CARTIER KITCHENS OTTAWA

DCR - PALTINA (512) - LEFT

### III

Drawing #: 1

Handwritten signatures: *DS* (twice)