
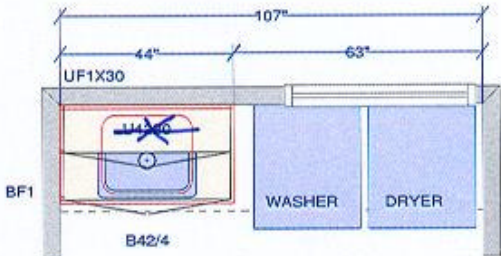
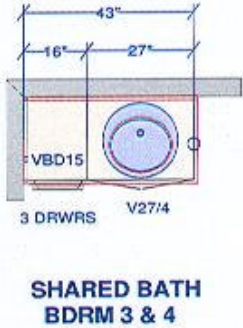
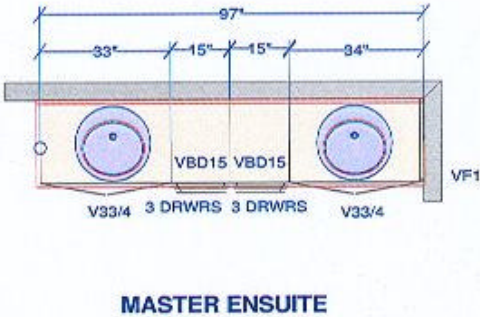
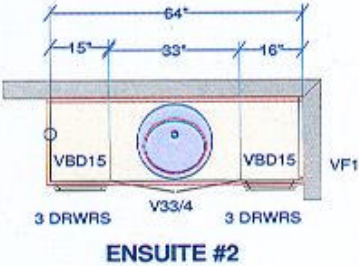


DCR PHOENIX HOMES

LOT #9  
DIAMONDVIEW ESTATES - PHASE 2  
MODEL - ANNAPOLIS (509)  
VANITIES & LAUNDRY

CABINETS -  
HARDWARE -  
STANDARD WHITE INTERIOR  
METAL DRAWER BOX  
5/8" TOE KICK

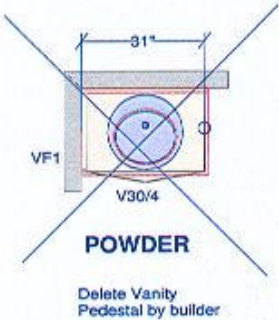

**CUSTOMER APPROVAL**  
I have reviewed these drawings and understand the details of the design and the CARTIER KITCHENS specifications.  
Signature \_\_\_\_\_  
Date \_\_\_\_\_


All dimensions ,size designations given are subject to verification on job site and adjustment to fit job conditions.  
SPECTRUM KITCHEN and BATH DESIGN  
9 DV2 - Vanities, Laundry .kit




This is an original design and must not be released or copied unless applicable fee has been paid or job order placed.  
DRAWN BY: LORI DISAVERIO, B.I.D

Designed: 2021-07-30  
Printed: 2021-07-30


Drawing #: 1 No Scale.

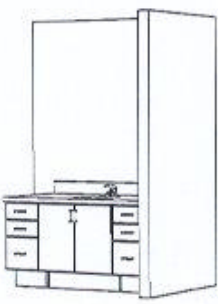


ENSUITE #2

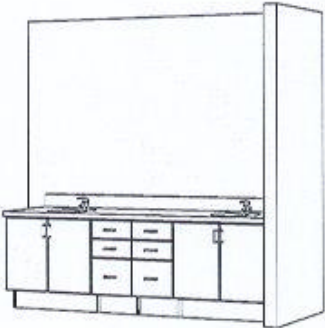

ENSUITE

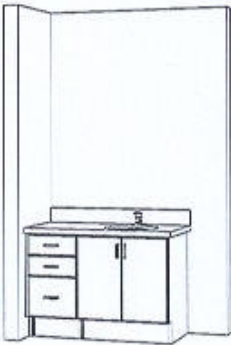

SHARED BATH

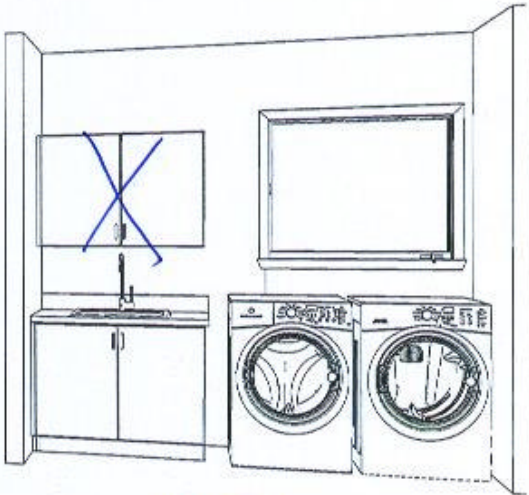

LAUNDRY

**CUSTOMER APPROVAL**

I have reviewed these drawings and understand the details of the design and the CARTIER KITCHENS specifications.

Signature \_\_\_\_\_

Date \_\_\_\_\_

Note: This drawing is an artistic interpretation of the general appearance of the design. It is not meant to be an exact rendition.

SPECTRUM KITCHEN and BATH DESIGN

9 DV2 - Vanities, Laundry .kit



Designed: 2021-07-30  
Printed: 2021-07-30

All

Drawing #: 1