

DCR PHOENIX HOMES**MODEL - RUTHERFORD (517)****ALTERNATE KITCHEN****MOUNTING HEIGHT - 84**

LINE-

HARDWARE -

STANDARD WHITE INTERIOR

METAL DRAWER BOX

4 PCS - 5/8" KICK - FIN. BOTH ENDS



2 PCS - LOOSE FILLER - 6 x 96

1 PCS - 90 DEG. CORNER MOULD


1 PCS - T-MOULD

5 PCS - FLAT MOULD

*Delete upper above range and 3" on each side to accommodate for chimney hood fan

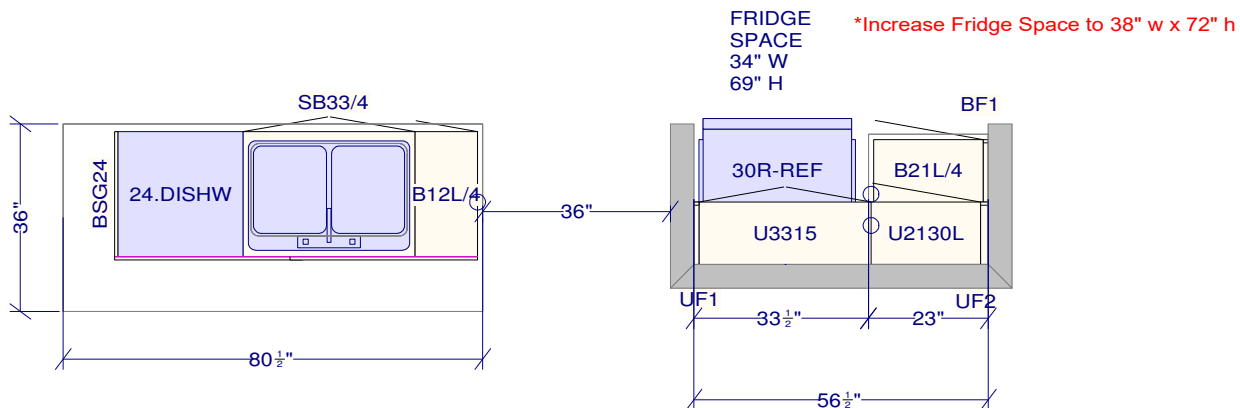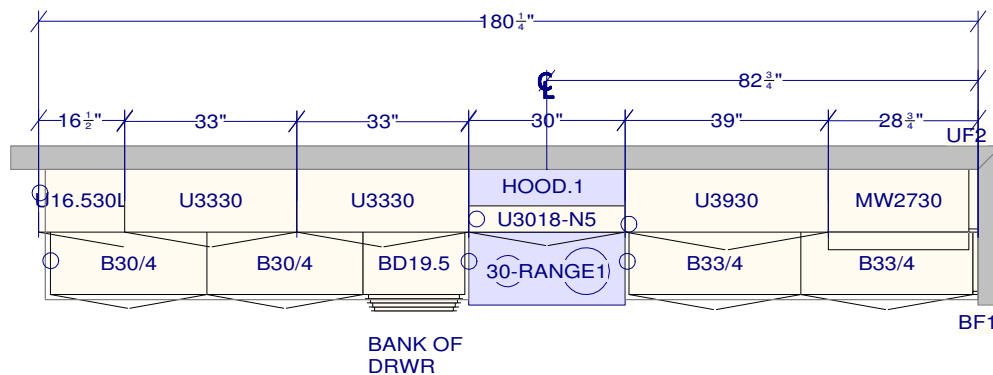

*Increase Fridge Space to 38" w x 72" h

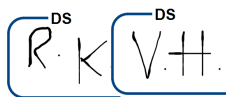

All dimensions, size designations given are subject to verification on job site and adjustment to fit job conditions.



Spectrum Kitchen Bath Design
430 Hazeldean Rd. Unit 2
P:613-521-6966
F:613 521-1617
Drawn by: Mirian

Designed: 4/19/2016
Printed: 4/19/2016




DCR PHOENIX 517 RUTHERFORD ALT
3D KITCHEN VIEW #1



Note: This drawing is an artistic interpretation of the general appearance of the design. It is not meant to be an exact rendition.




Designed: 4/19/2016
Printed: 4/19/2016

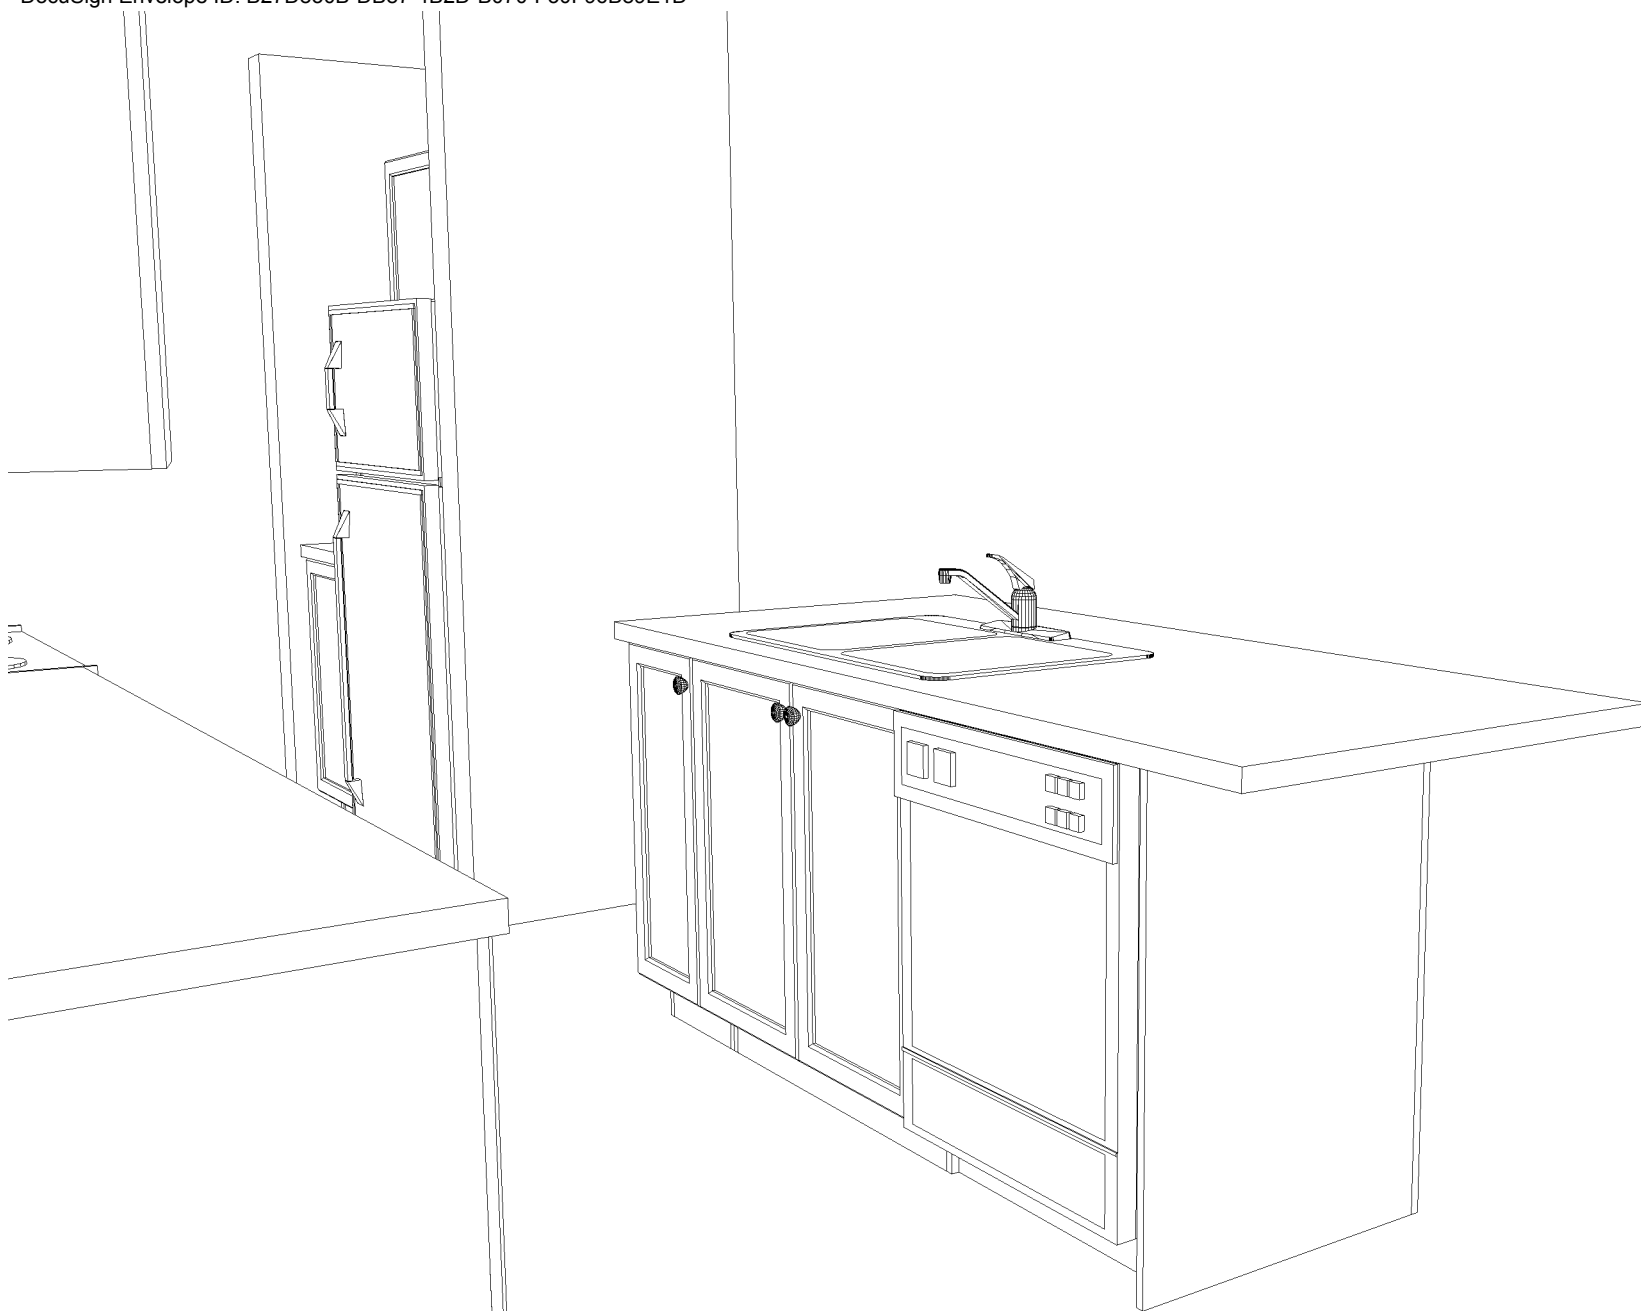

DCR PHOENIX 517 RUTHERFORD ALT

3D KITCHEN VIEW #2

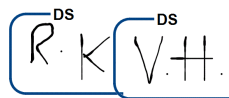

Note: This drawing is an artistic interpretation of the general appearance of the design. It is not meant to be an exact rendition.

2020
TECHNOLOGIES




Designed: 4/19/2016
Printed: 4/19/2016

517 Rutherford ALT

All

Drawing #: 1

*Delete upper above range and 3" on each side to accommodate for chimney hood fan

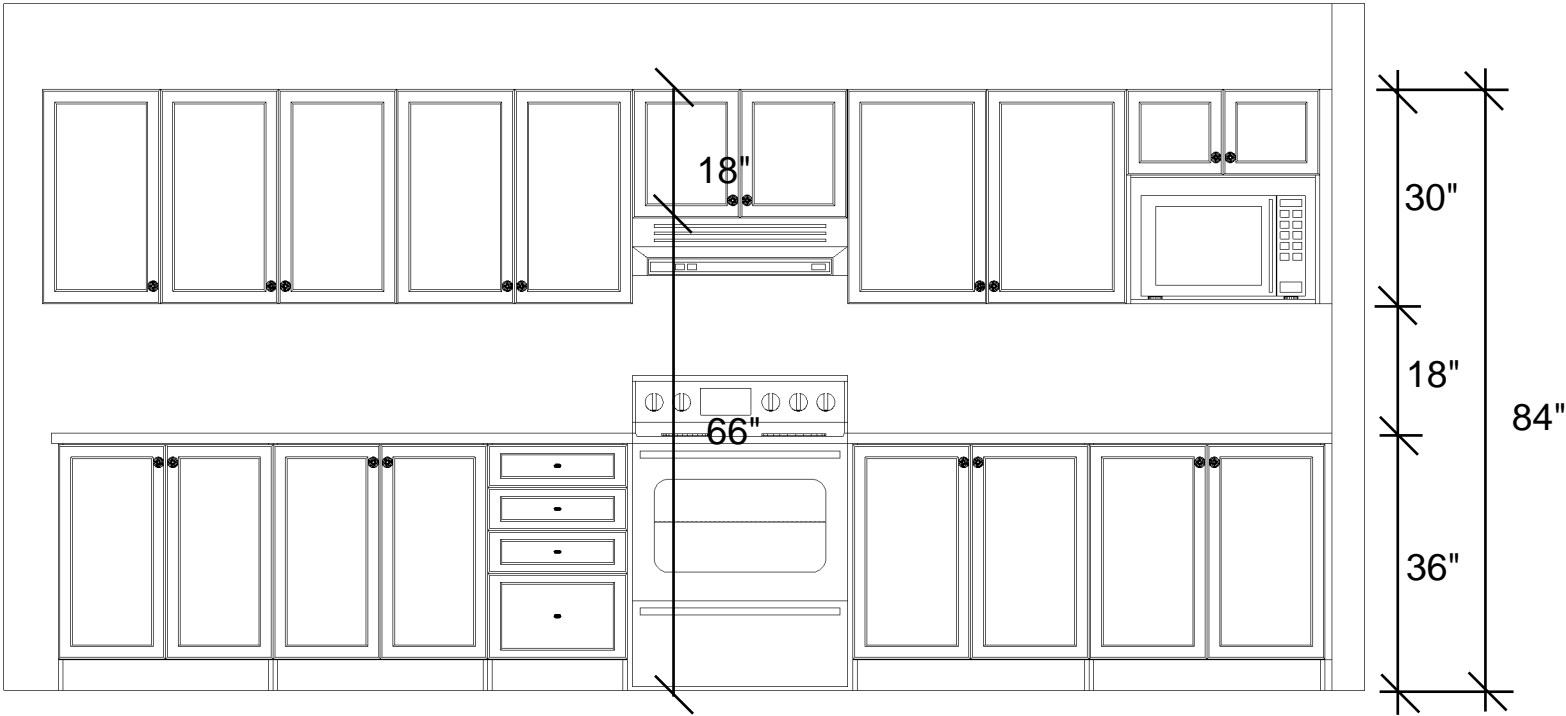

DCR PHOENIX 517 RUTHERFORD ALT

STOVE WALL ELEVATION

DS
R.K. V.H.


Note: This drawing is an artistic interpretation of the general appearance of the design. It is not meant to be an exact rendition.

2020
TECHNOLOGIES

SPECTRUM
KITCHEN & BATH DESIGN

Designed: 4/19/2016
Printed: 4/19/2016

*Increase Fridge Opening to 38" w by 72" h

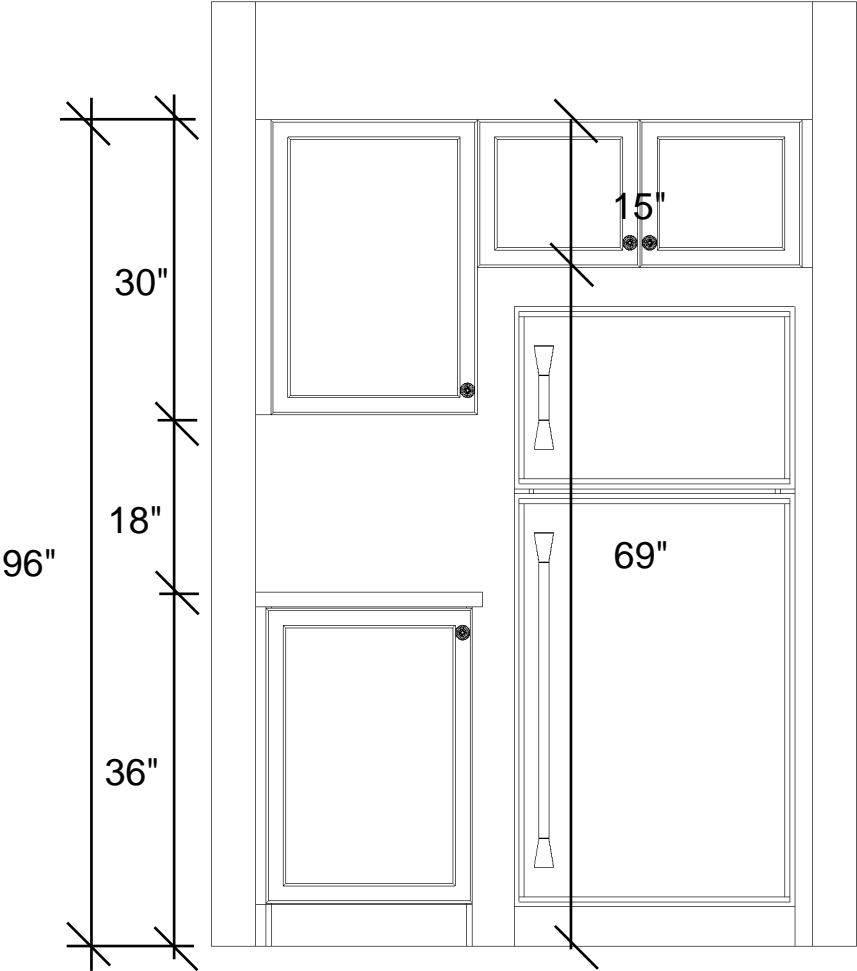


DCR PHOENIX 517 RUTHERFORD ALT
FRIDGE WALL ELEVATION

DS
R.K. V.H.

Note: This drawing is an artistic interpretation of the general appearance of the design. It is not meant to be an exact rendition.



Designed: 4/19/2016
Printed: 4/19/2016

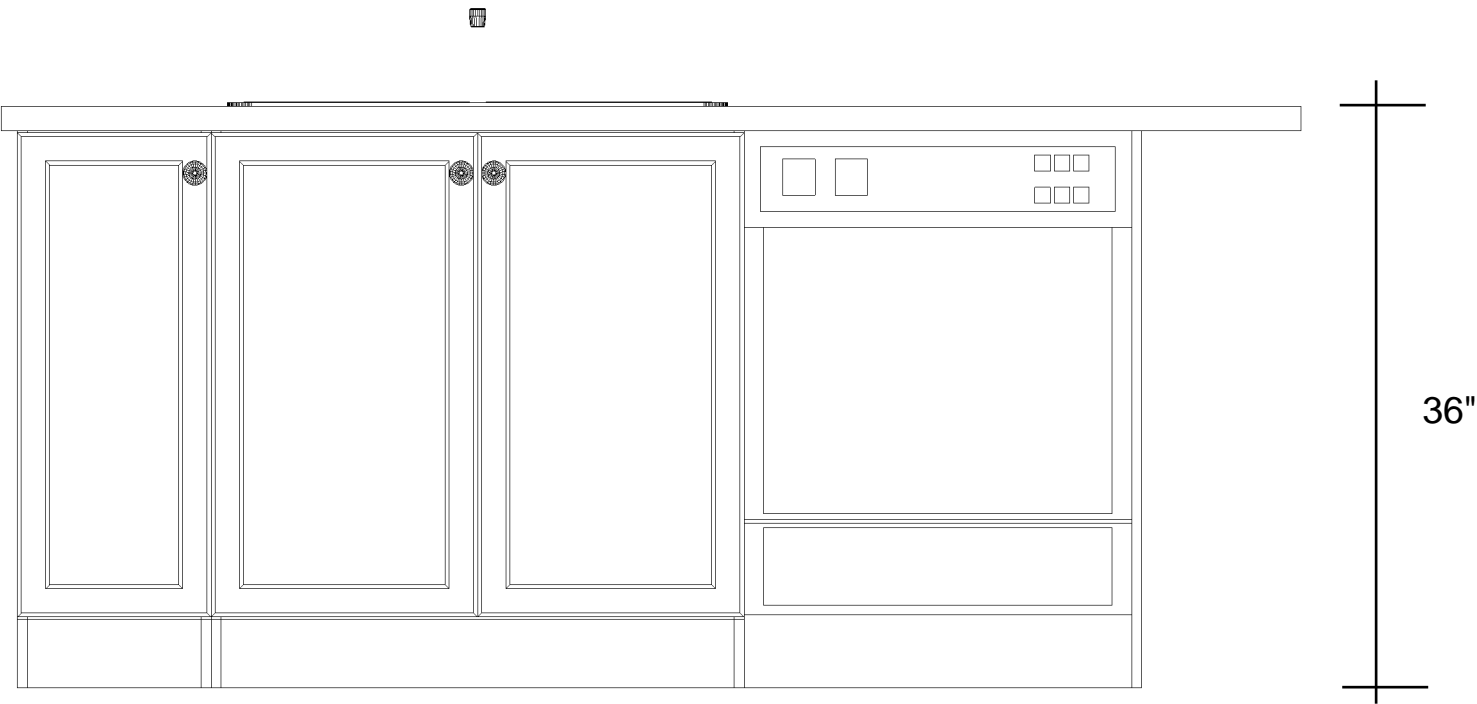

DCR PHOENIX 517 RUTHERFORD ALT

ISLAND ELEVATION

DS
R.K. V.H.
DS

Note: This drawing is an artistic interpretation of the general appearance of the design. It is not meant to be an exact rendition.

2020
TECHNOLOGIES



Designed: 4/19/2016
Printed: 4/19/2016