


DCR PHOENIX HOMES

LOT #3-149  
WHITE TAIL RIDGE 3  
MODEL TYPE: BIRCHWOOD (LOFT)

KITCHEN


REVISED: JAN 20-22

NOTE:  
ISLAND DELETED  
ALL UPPER CABINETS DELETED

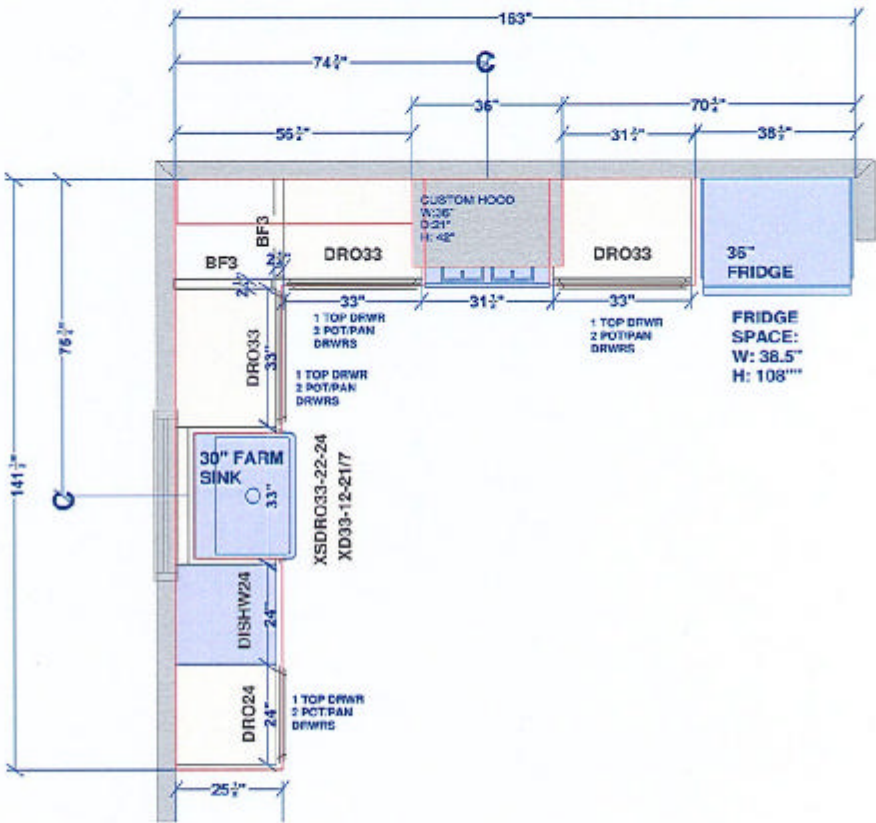

|   |                                                                                     |   |                                             |
|---|-------------------------------------------------------------------------------------|---|---------------------------------------------|
| All dimensions, size designations given are subject to verification on job site and adjustment to fit job conditions. |  | This is an original design and must not be released or copied unless applicable fee has been paid or job order placed. | Designed: 2022-01-20<br>Printed: 2022-01-20 |
| DCR - White Tail Ridge 3 LOT# 3-149 Kitchen REVISED.kit                                                               | All                                                                                 | Drawing #: 1 No Scale.                                                                                                 |                                             |

DS  
AL PS

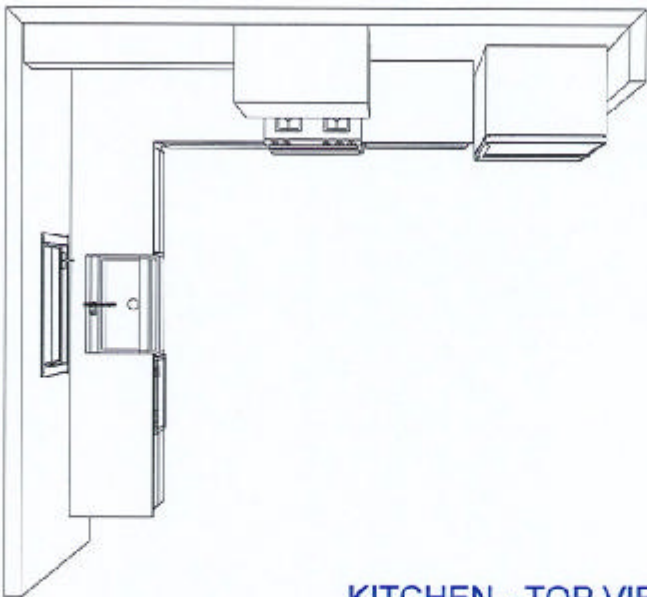

KITCHEN - TOP VIEW

REVISED: JAN 20-22

|   |
|---|
| <p><b>CUSTOMER APPROVAL</b></p> <p>I have reviewed these drawings and understand the details of the design and the CARTIER KITCHENS specifications.</p> <p>Signature: _____</p> <p>Date: _____</p> |
|---|

|   |                                                                                       |                                                        |
|---|---------------------------------------------------------------------------------------|--------------------------------------------------------|
| <p>Note: This drawing is an artistic interpretation of the general appearance of the design. It is not meant to be an exact rendition.</p> |  | <p>Designed: 2022-01-20</p> <p>Printed: 2022-01-20</p> |
|   |                                                                                       |                                                        |
| <p>DCR - White Tail Ridge 3 LOT# 3-149 Kitchen</p>                                                                                         |                                                                                       | <p>All</p>                                             |
|   |                                                                                       | <p>Drawing #: 1</p>                                    |

DS


AL

DS

PS

\* FOR REFERENCE OF ELECTRICAL PLUGS  
ONLY \*

(PURCHASERS INSTALLING SHELVES AFTER CLOSE)

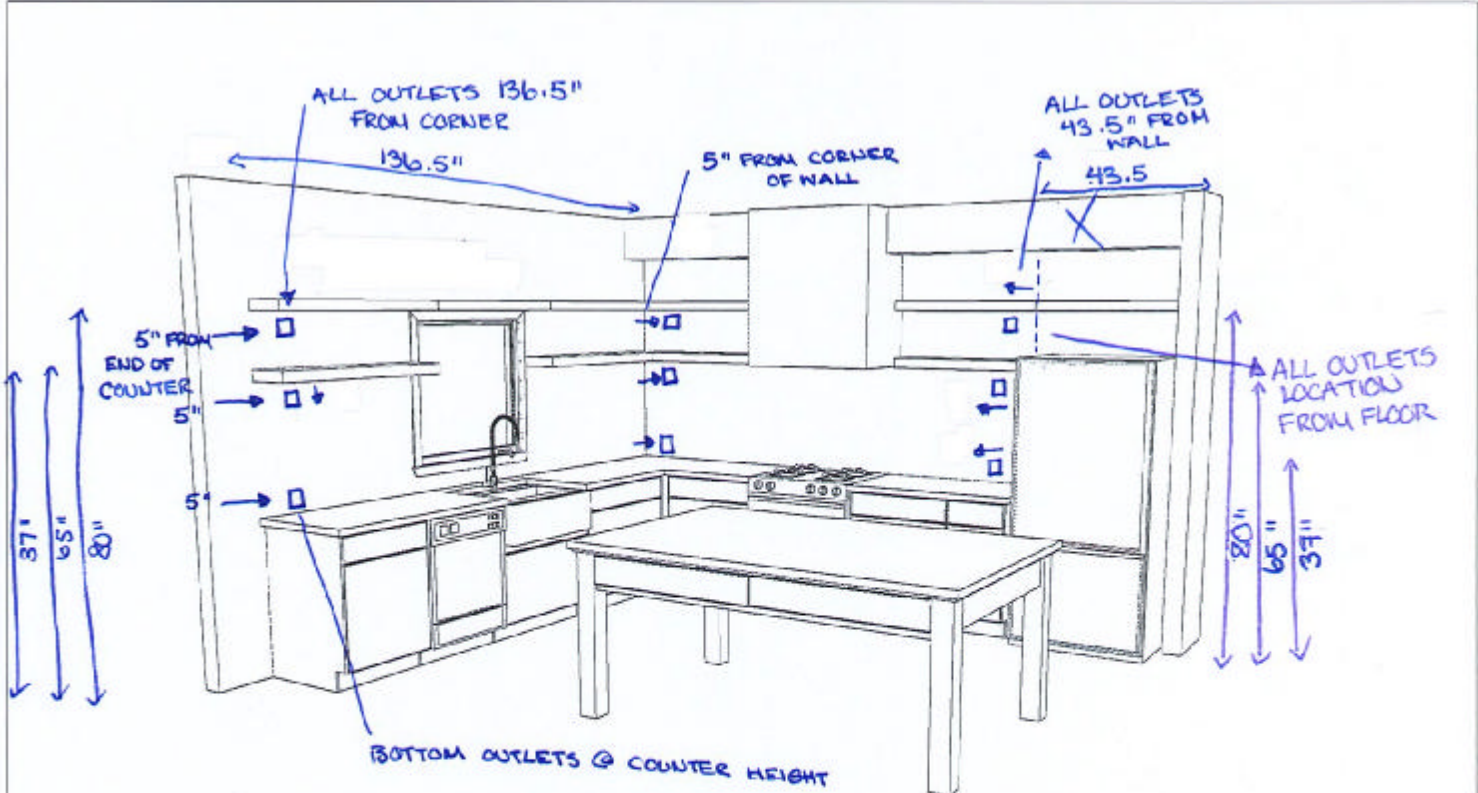

KITCHEN - 3D VIEW #1

**CUSTOMER APPROVAL**

I have reviewed these drawings and understand the details of the design and the CARTIER KITCHENS specifications.

Signature \_\_\_\_\_

Date \_\_\_\_\_

Note: This drawing is an artistic interpretation of the general appearance of the design. It is not meant to be an exact rendition.



Designed: 2022-01-11  
Printed: 2022-01-14

DCR - White Tail Ridge 3 LOT# 3-149 Kitchen.kit


All

Drawing #: 1

DS  
AL

DS  
PS

\* FOR REFERENCE FOR SHELVES & ELECTRICAL  
PLUGS \*

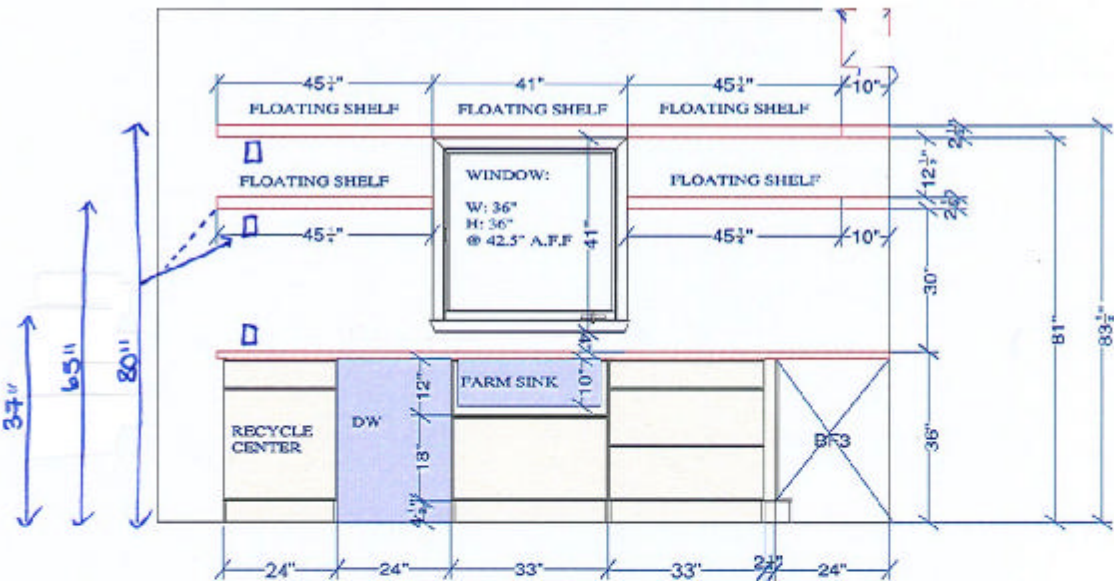

SINK WALL ELEVATION

CUSTOMER APPROVAL

I have reviewed these drawings and understand the details of the design and the CANTER KITCHENS specifications.

Signature: \_\_\_\_\_

Date: \_\_\_\_\_


All dimensions, size designations given are subject to verification on job site and adjustment to fit job conditions.




This is an original design and must not be released or copied unless applicable fee has been paid or job order placed.

Designed: 2022-01-11  
Printed: 2022-01-14

\* FOR REFERENCE FOR SHELVES + ELECTRICAL  
PIUGS \*

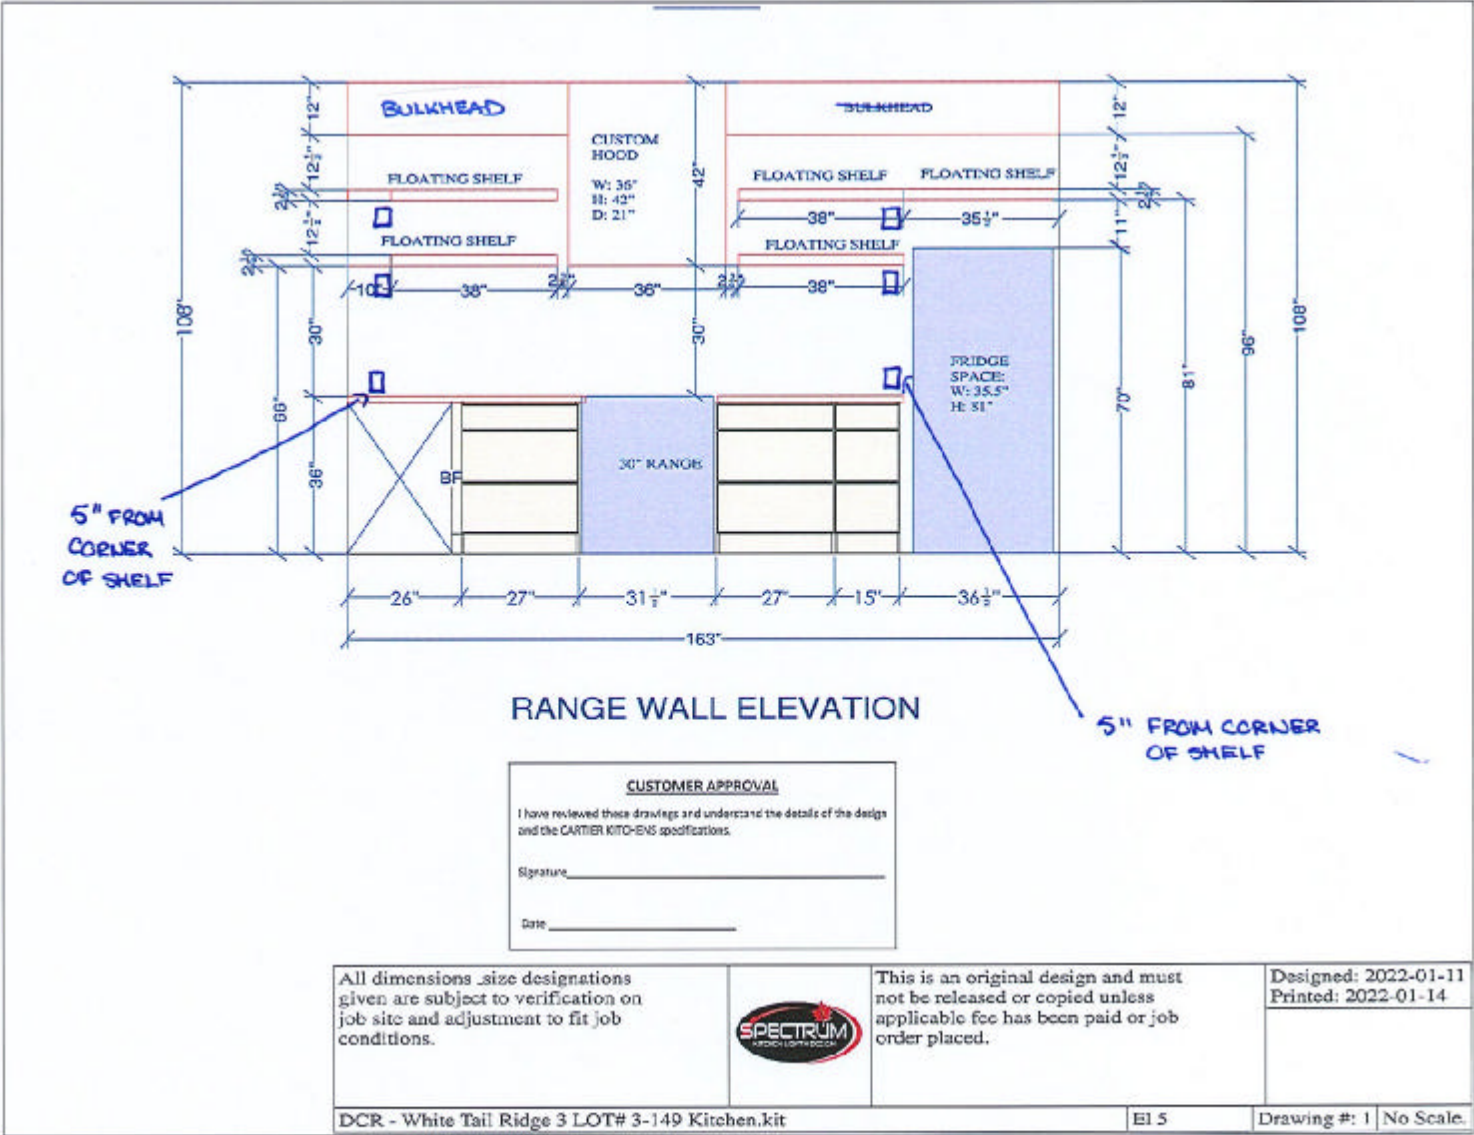

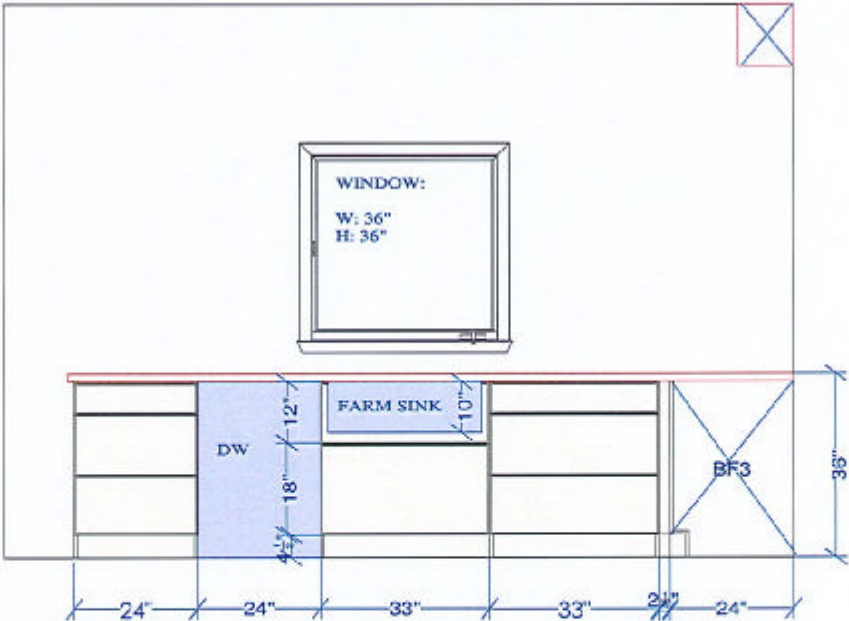

**CUSTOMER APPROVAL**

I have reviewed these drawings and understand the details of the design and the CARTIER ETC-ENS specifications.

Signature \_\_\_\_\_

Date \_\_\_\_\_

**SINK WALL ELEVATION**  
**REVISED: JAN 20-22**

All dimensions, size designations given are subject to verification on job site and adjustment to fit job conditions.



This is an original design and must not be released or copied unless applicable fee has been paid or job order placed.


Designed: 2022-01-20  
Printed: 2022-01-20

DCR - White Tail Ridge 3 LOT# 3-149 Kitchen REVISED.kit

EI 4

Drawing #: 1 No Scale.

DS  
AL PS

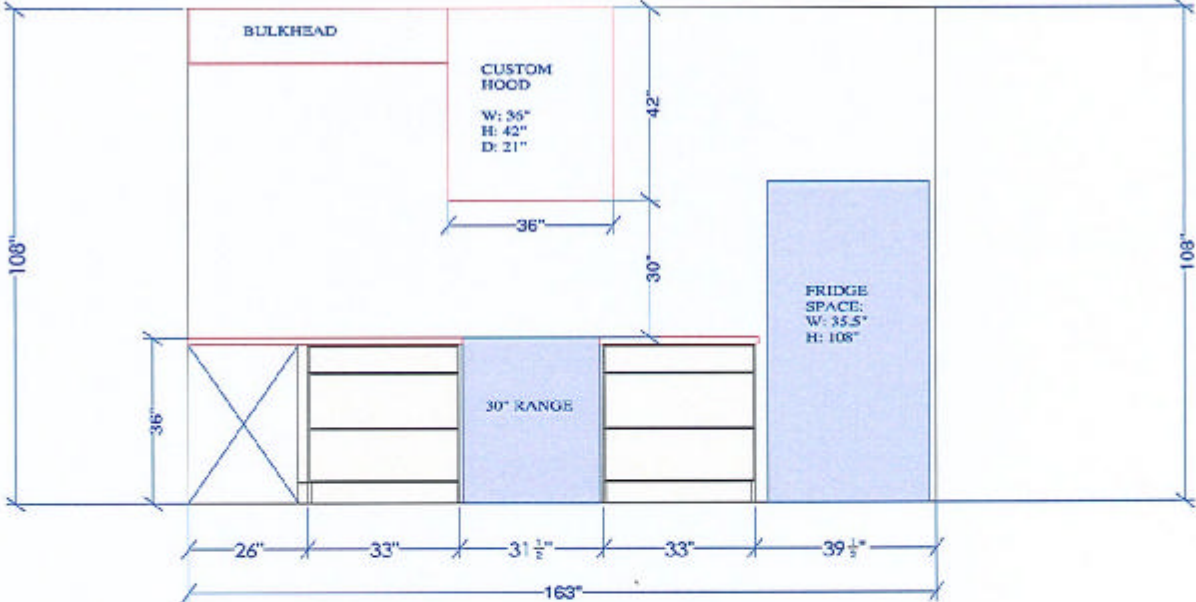

RANGE WALL ELEVATION

REVISED: JAN 20-22


CUSTOMER APPROVAL

I have reviewed these drawings and understand the details of the design and the CARTER KITCHING specifications.

Signature \_\_\_\_\_

Date \_\_\_\_\_

|   |                                                                                     |   |                                                         |                             |
|---|-------------------------------------------------------------------------------------|---|---------------------------------------------------------|-----------------------------|
| All dimensions, size designations given are subject to verification on job site and adjustment to fit job conditions. |  | This is an original design and must not be released or copied unless applicable fee has been paid or job order placed. | Designed: 2022-01-20<br>Printed: 2022-01-20             |                             |
|   |                                                                                     |   | DCR - White Tail Ridge 3 LOT# 3-149 Kitchen REVISED.kit | El 5 Drawing #: 1 No Scale. |

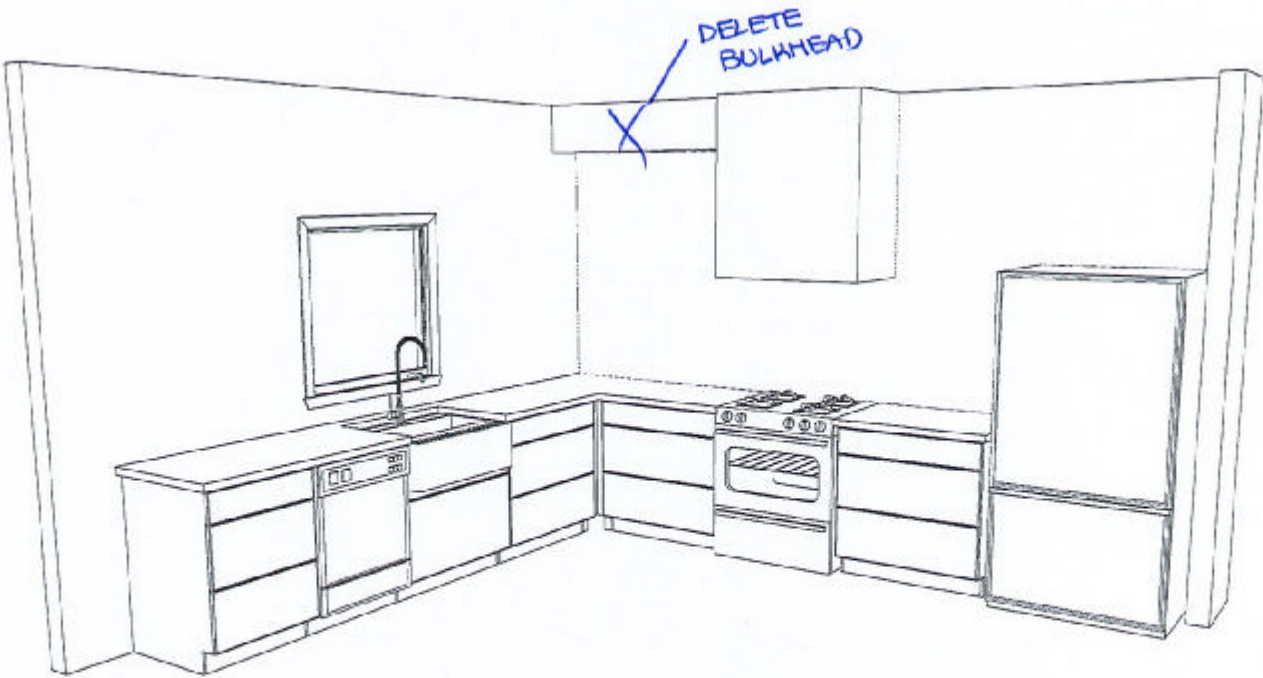

**KITCHEN - 3D VIEW #1**

REVISED: JAN 20-22

**CUSTOMER APPROVAL**

I have reviewed these drawings and understand the details of the design and the CARTIER KITCHENS specifications.

Signature: \_\_\_\_\_

Date: \_\_\_\_\_

Note: This drawing is an artistic interpretation of the general appearance of the design. It is not meant to be an exact rendition.



Designed: 2022-01-20  
Printed: 2022-01-20

DCR - White Tail Ridge 3 LOT# 3-149 Kitchen

All

Drawing #: 1

DS

AL

DS

PS