




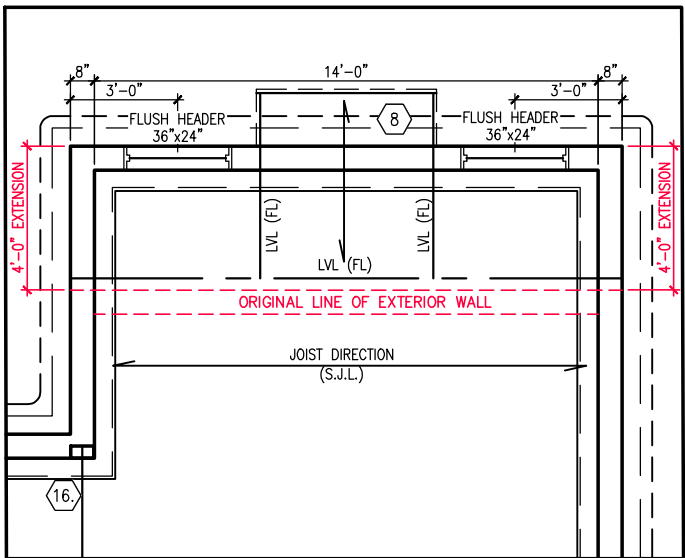


PARTIAL FOUNDATION PLAN W/
48" EXTENSION OPTION

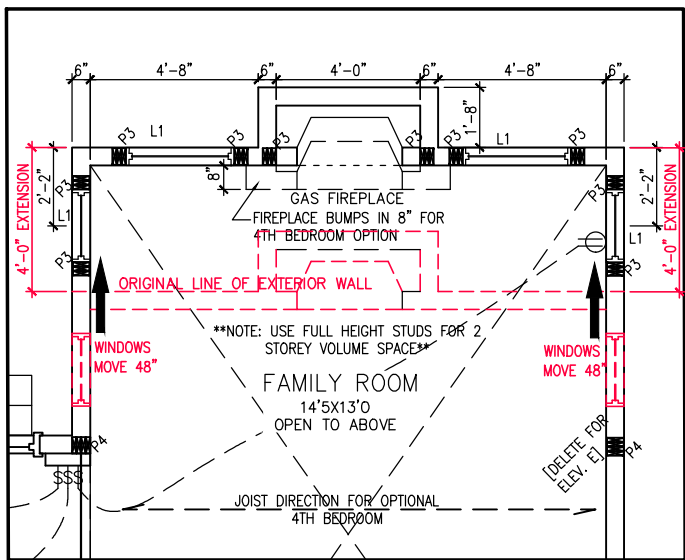


PARTIAL GROUND FLOOR PLAN
W/ 48" EXTENSION OPTION

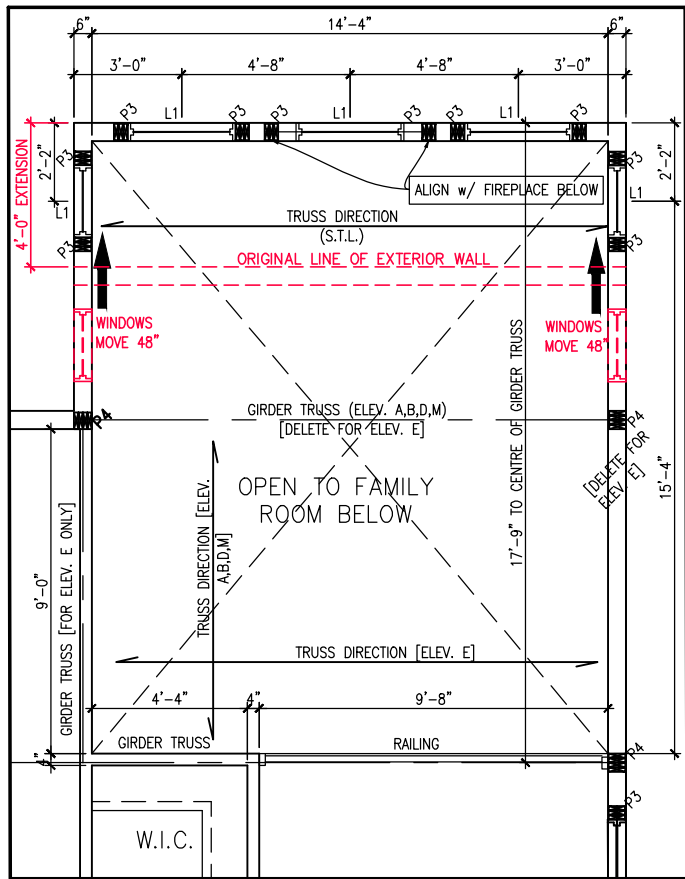

PARTIAL SECOND FLOOR PLAN
W/ 48" EXTENSION OPTION

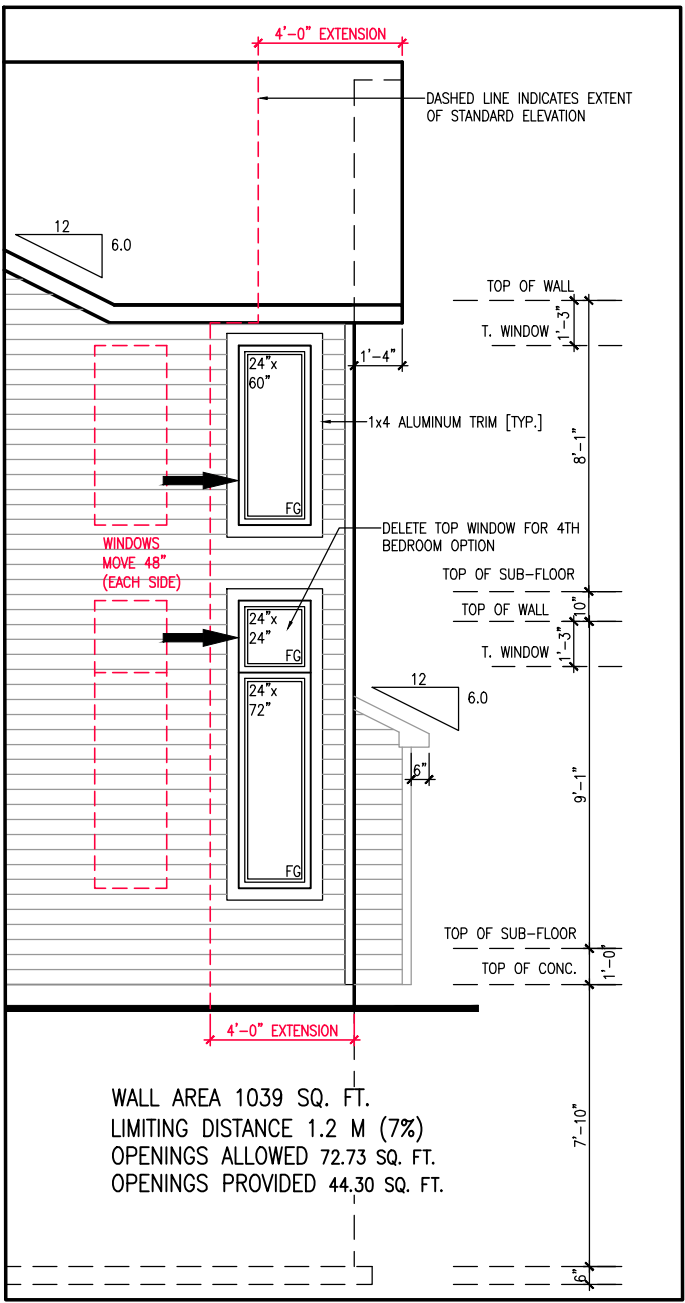

PARTIAL RIGHT SIDE ELEVATION (TYP)

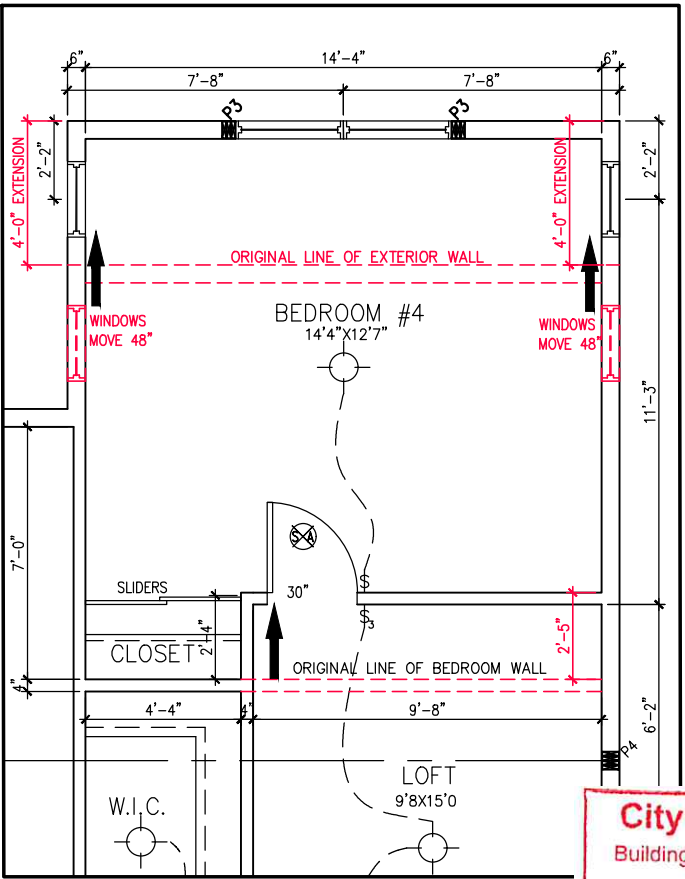

PARTIAL SECOND FLOOR PLAN
OPTIONAL 4TH BEDROOM OPTIO

FAMILY ROOM EXTENSION OPTION – ADDS 61 SQ. FT. TO 3 BEDROOM MODEL
– ADDS 122 SQ. FT. TO 4 BEDROOM MODEL

City of Ottawa
Building Services Branch

REVIEWED
By Steve Gdula at 11:07 am, Nov 24, 2021

Building Code Reviewed
Signature
Steve Gdula

****NOTE****
ALL WINDOW LINTELS TO BE 2-2X10
W/ P2 POSTS ON EACH SIDE U.N.O.

TO BE USED WITH ALL ELEVATIONS



35-10 STRATHMORE/2019

OPTIONAL 48" FAMILY ROOM EXTENSION

INCLUDES 48" EXTENSION TO FOUNDATION,
GROUND FLOOR AND SECOND FLOOR

8	OPTIONAL 48" EXTENSION	05/07/21	SP
7	2020 DRAWING UPDATE	10/07/20	LM
No.	Description	dd/mm/yy	By
REVISIONS			

footprint:	35-10
drawn by:	SP
date:	FEB 12/16
scale:	3/16"=1'-0"
sheet no:	D.C.L.-193
	OPT.1