

KITCHEN WITH ADDITIONAL ISLAND
- TOP VIEW

CUSTOMER APPROVAL

I have reviewed these drawings and understand the details of the design and the CARTIER KITCHENS specifications.

Signature _____

Date _____

Note: This drawing is an artistic interpretation of the general appearance of the design. It is not meant to be an exact rendition.



Designed: 2021-12-10
Printed: 2022-01-10

DCR #223 Pathways - Kitchen.kit

All

Drawing #: 1

DS SL DS U



ADDITIONAL ISLAND - BREAKFAST AREA
- 3D VIEW #1


<p>CUSTOMER APPROVAL</p> <p>I have reviewed these drawings and understand the details of the design and the CARTER KITCHENS specifications.</p> <p>Signature _____</p> <p>Date _____</p>

Note: This drawing is an artistic interpretation of the general appearance of the design. It is not meant to be an exact rendition.



Designed: 2021-12-10
Printed: 2022-01-10

DS SL DS U

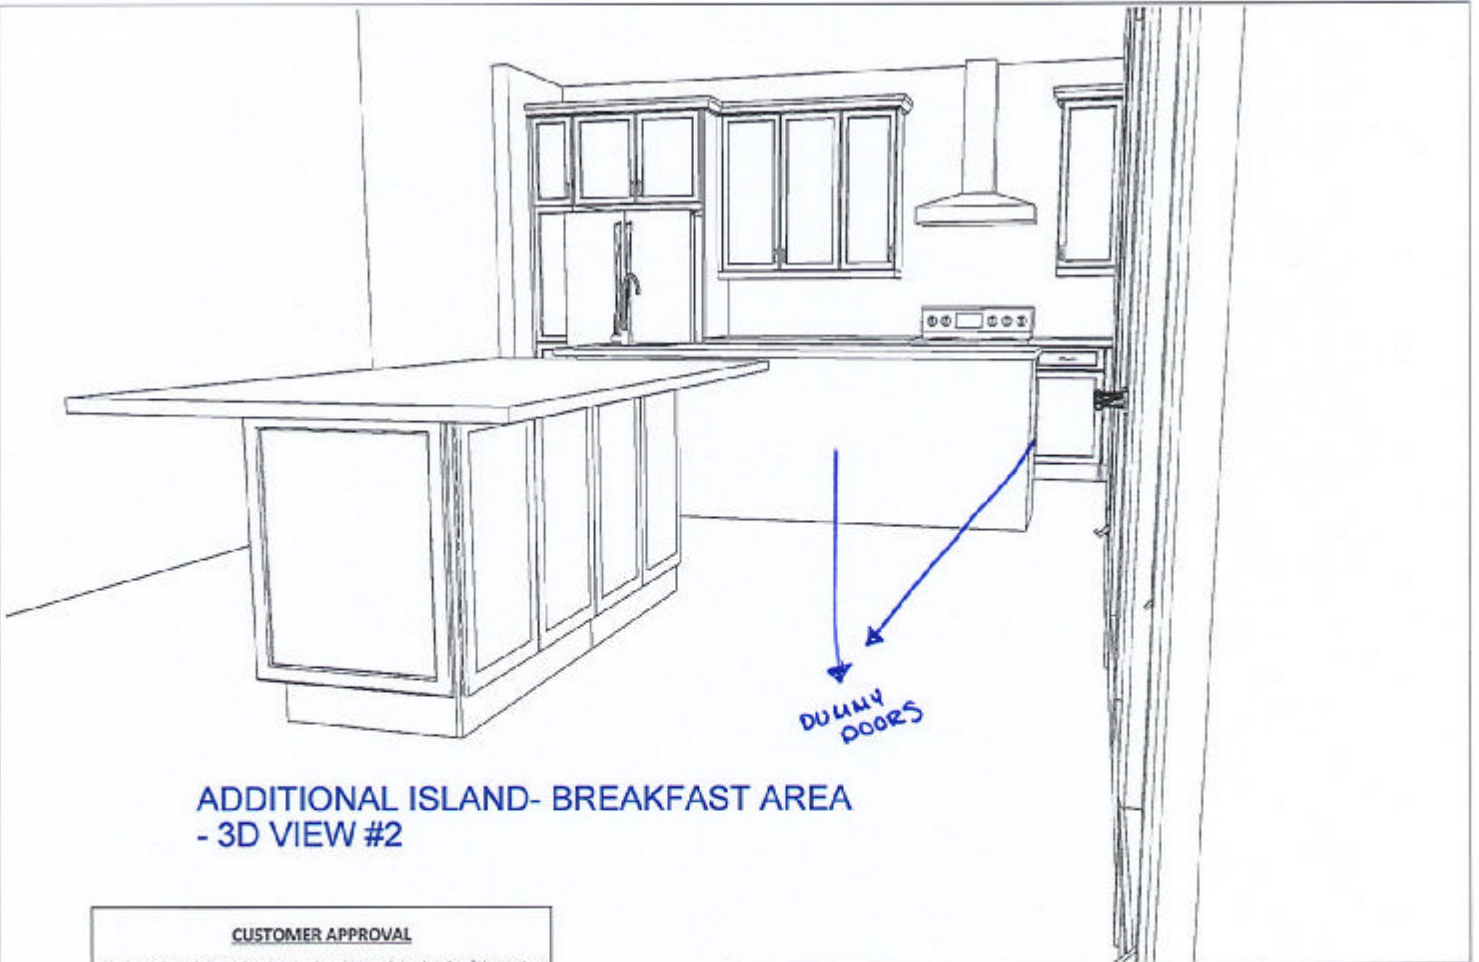

**ADDITIONAL ISLAND- BREAKFAST AREA
- 3D VIEW #2**


CUSTOMER APPROVAL

I have reviewed these drawings and understand the details of the design and the CARTIER KITCHENS specifications.

Signature _____

Date _____

Note: This drawing is an artistic interpretation of the general appearance of the design. It is not meant to be an exact rendition.



Designed: 2021-12-10
Printed: 2022-01-10

DCR #223 Pathways - Kitchen.kit

All

Drawing #: 1

DS

sl

DS

u