

DCR PHOENIX HOMES


LOT #70
DIAMONDVIEW ESTATES 1

NEWINGTON
OPTIONAL CHEF'S KITCHEN
GARAGE RIGHT
MOUNTING HEIGHT: 96

42" H. UPPERS @ 18" ABOVE COUNTER
FILL TO CEILING WITH
1" SQUARE MOULDING,
FURRING PANEL &
CEILING CROWN

- CABINETS -
HARDWARE -
STANDARD WHITE INTERIOR
METAL DRAWER BOX
4 PCS - 5/8" KICK - FIN. BOTH ENDS
2 PCS - 90 DEG. CORNER MOULD
1 PCS - T-MOULD
5 PCS - FLAT MOULDING

REVISED: FEB 16-22

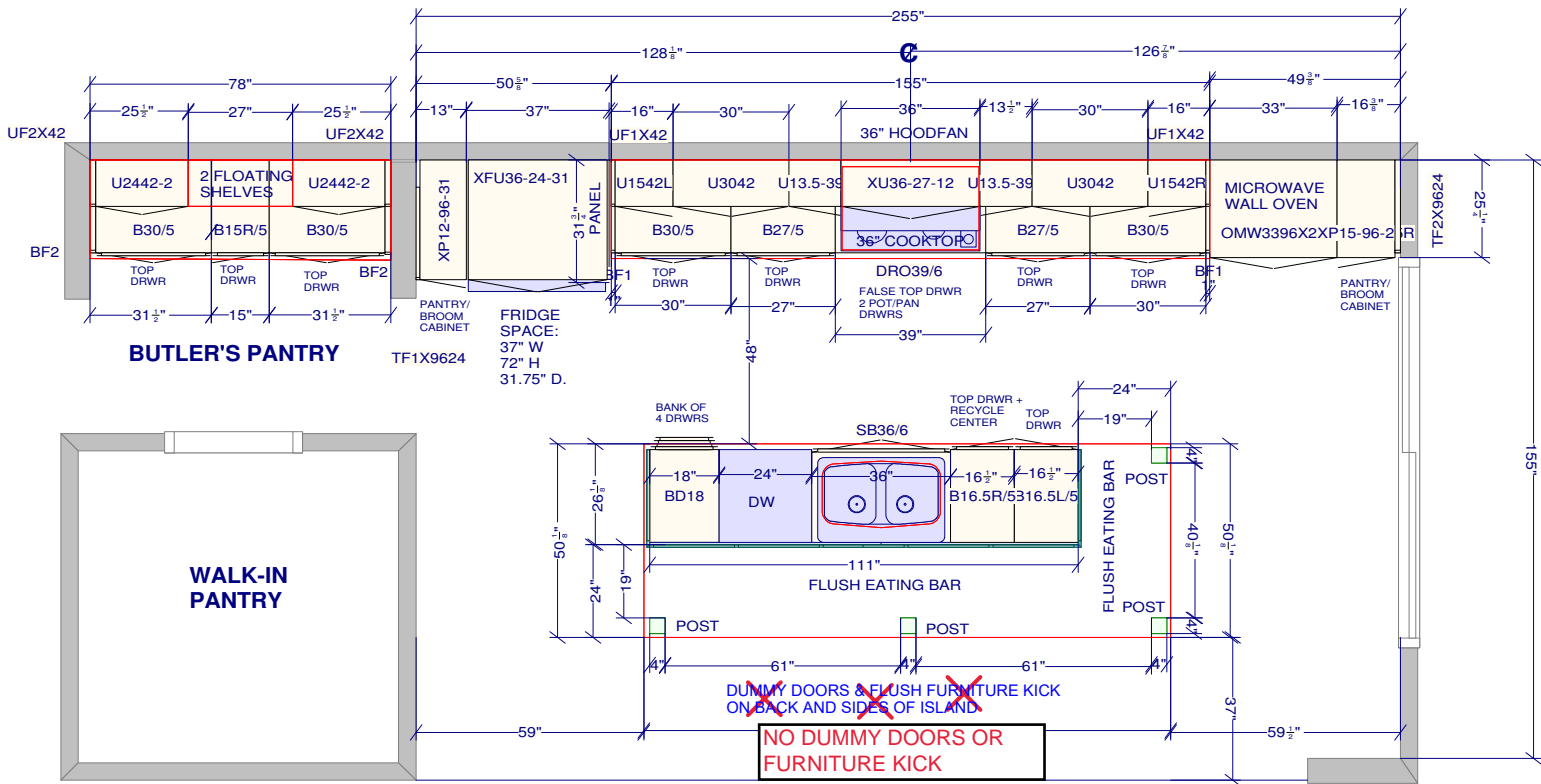


ISLAND - INCREASE HEIGHT OF CABINETS BY APPROX. 1 7/8" TO APPROX. 36 3/8"H (37 5/8"H. WITH COUNTERTOP); CABINETS TO BE INSTALLED ON 3 x 5/8" THICK MATERIAL; KICK PLATE, FLUSH FURNITURE KICK & SUPPPRT POSTS TO BE INCREASED IN HEIGHT TO SUIT

CUSTOMER APPROVAL
DS DS
I have reviewed these drawings and understand the details of the design and the CARTIER KITCHEN specifications.
Signature _____
Date 6/29/2022 | 1:46 PM EDT

All dimensions size designations given are subject to verification on job site and adjustment to fit job conditions.		This is an original design and must not be released or copied unless applicable fee has been paid or job order placed.	Designed: 2022-02-02 Printed: 2022-02-16
DCR #70 Diamondview 1 - Newington Chef's .kit	All	Drawing #: 1	No Scale.

1" SQUARE MOULDING + FURRING PANEL + CEILING CROWN

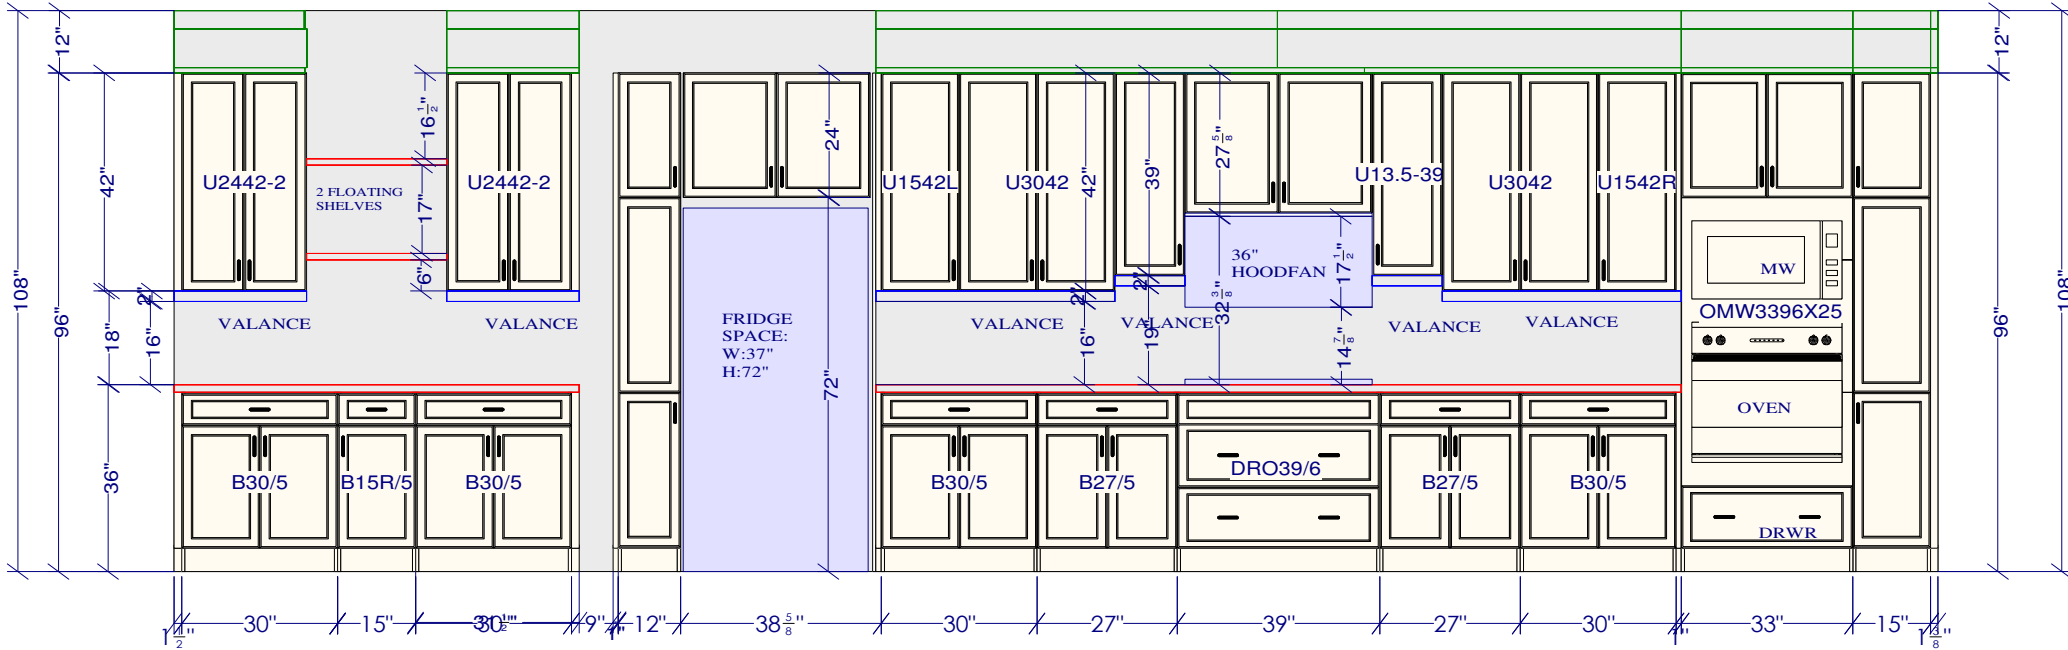

BUTLER'S PANTRY

FRIDGE, COOKTOP, OVEN WALL ELEVATION

CUSTOMER APPROVAL


Signature _____

Date 6/29/2022 | 1:46 PM EDT


REVISED: FEB 16-22

All dimensions and size designations given are subject to verification on job site and adjustment to fit job conditions.



This is an original design and must not be released or copied unless applicable fee has been paid or job order placed.

Designed: 2022-02-02
Printed: 2022-02-16

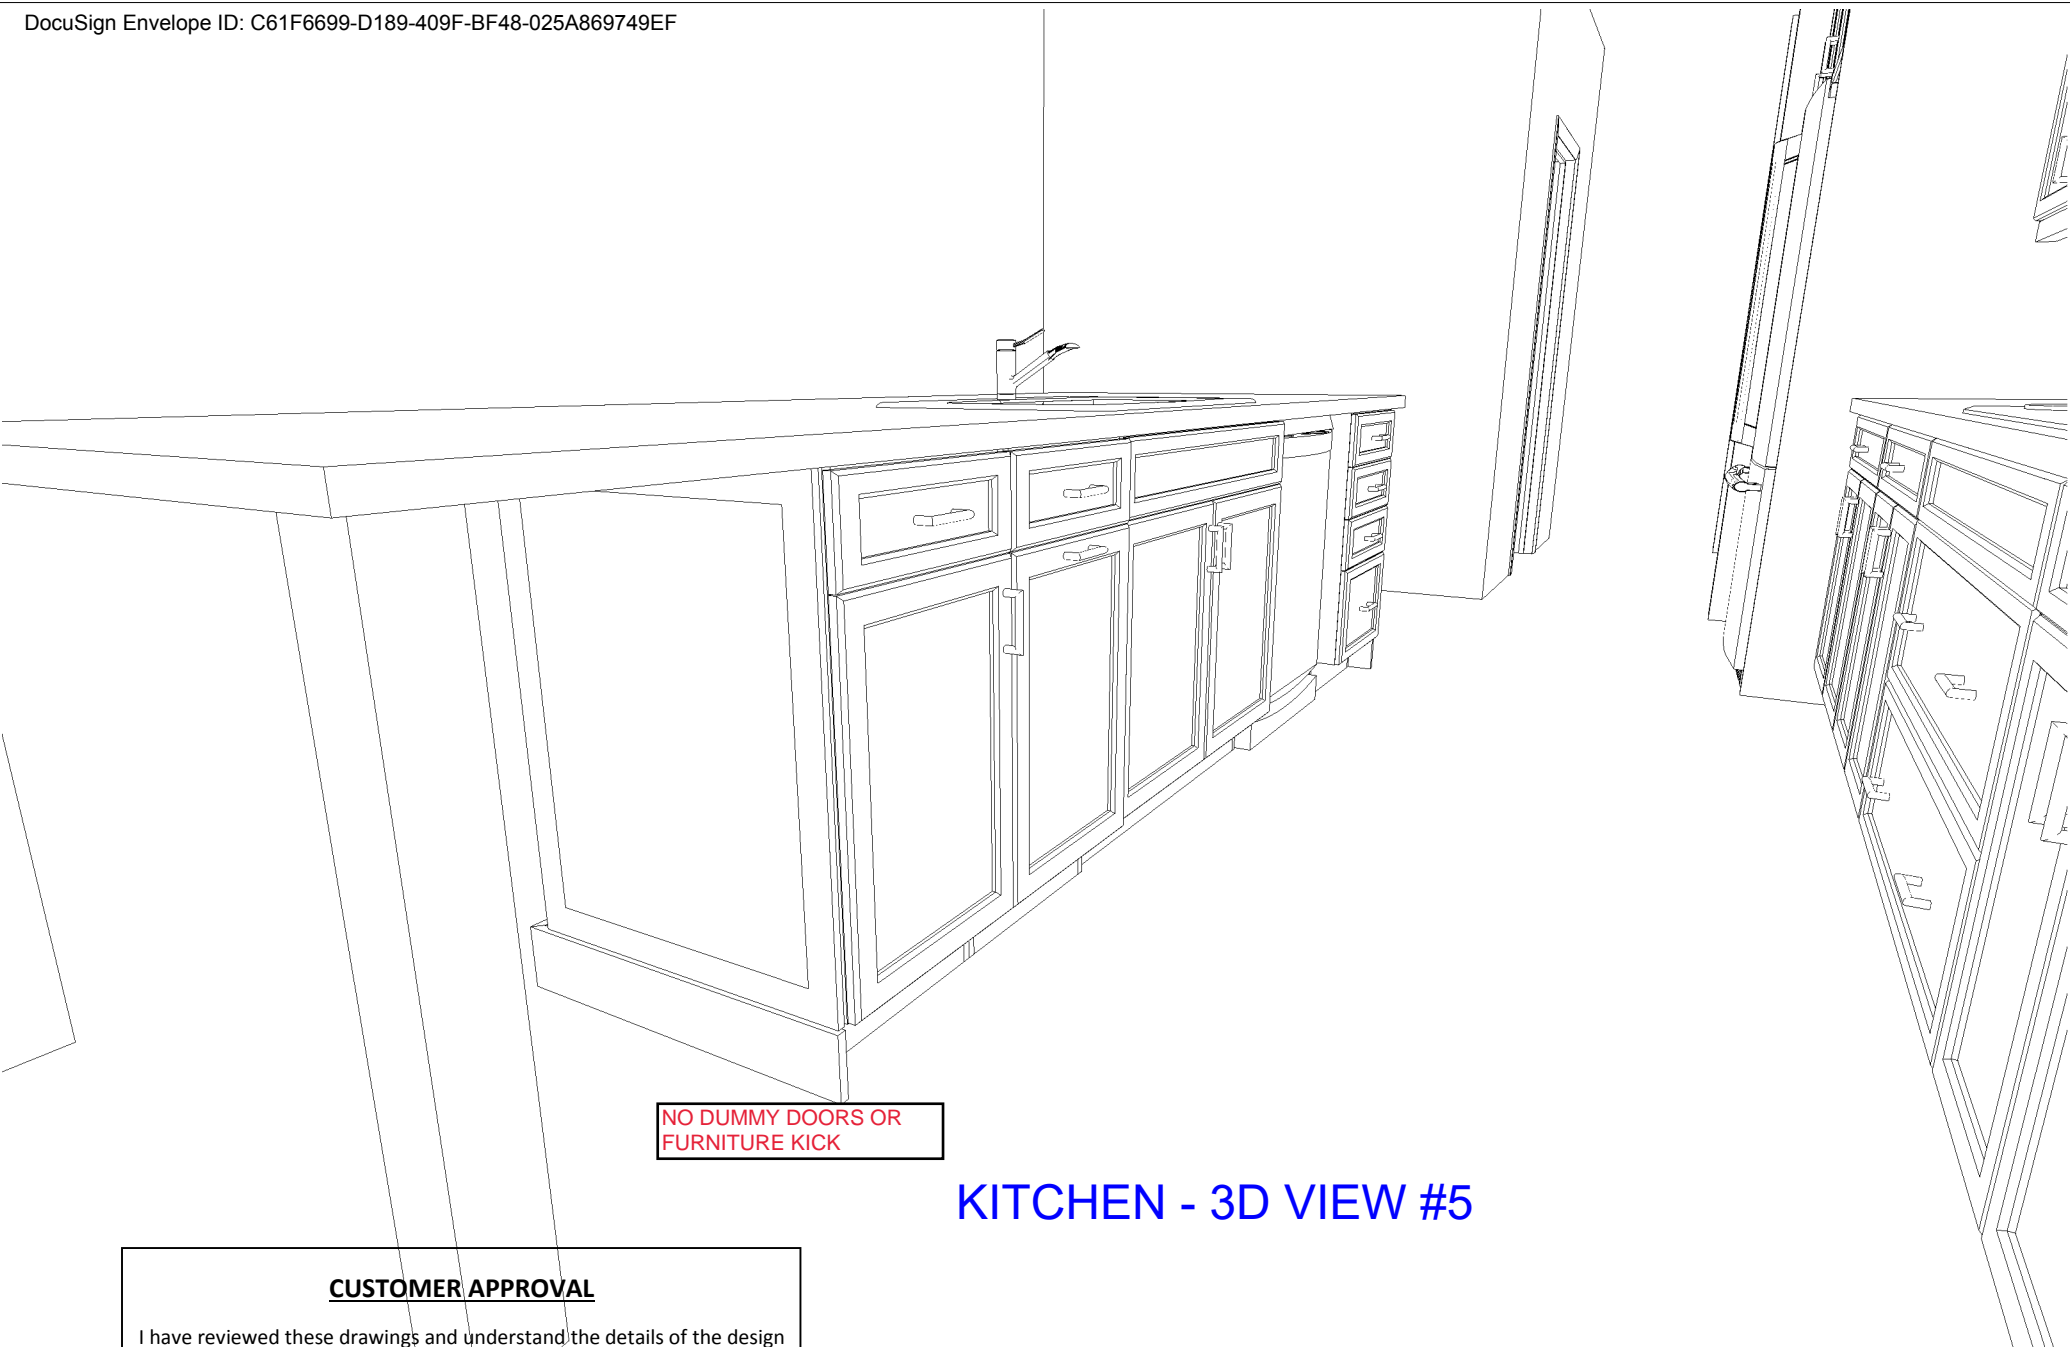
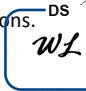


NO DUMMY DOORS OR
FURNITURE KICK

KITCHEN - 3D VIEW #5

CUSTOMER APPROVAL

I have reviewed these drawings and understand the details of the design and the CARTIER KITCHENS specifications.


Signature  

Date 6/29/2022 | 1:46 PM EDT

Note: This drawing is an artistic interpretation of the general appearance of the design. It is not meant to be an exact rendition.



Designed: 2022-02-02
Printed: 2022-02-17

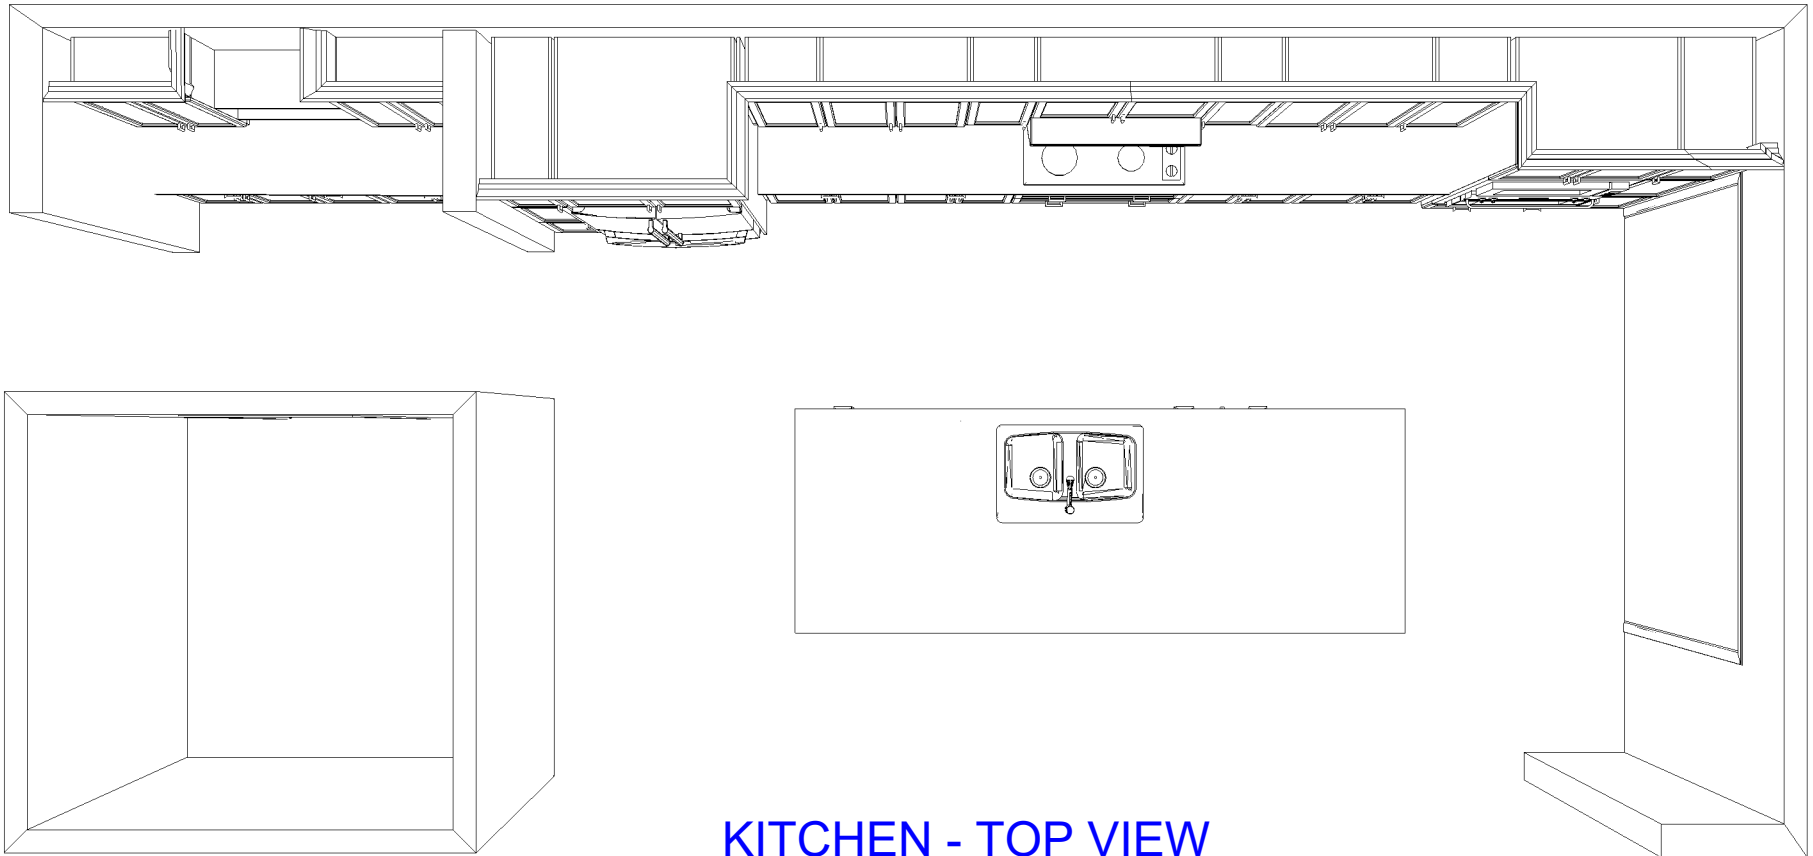

KITCHEN - TOP VIEW

REVISED: FEB 16-22

CUSTOMER APPROVAL

I have reviewed these drawings and understand the details of the design and the CARTIER KITCHENS specifications.

Signature _____


6/29/2022 | 1:46 PM EDT

Date _____

Note: This drawing is an artistic interpretation of the general appearance of the design. It is not meant to be an exact rendition.



Designed: 2022-02-02
Printed: 2022-02-16

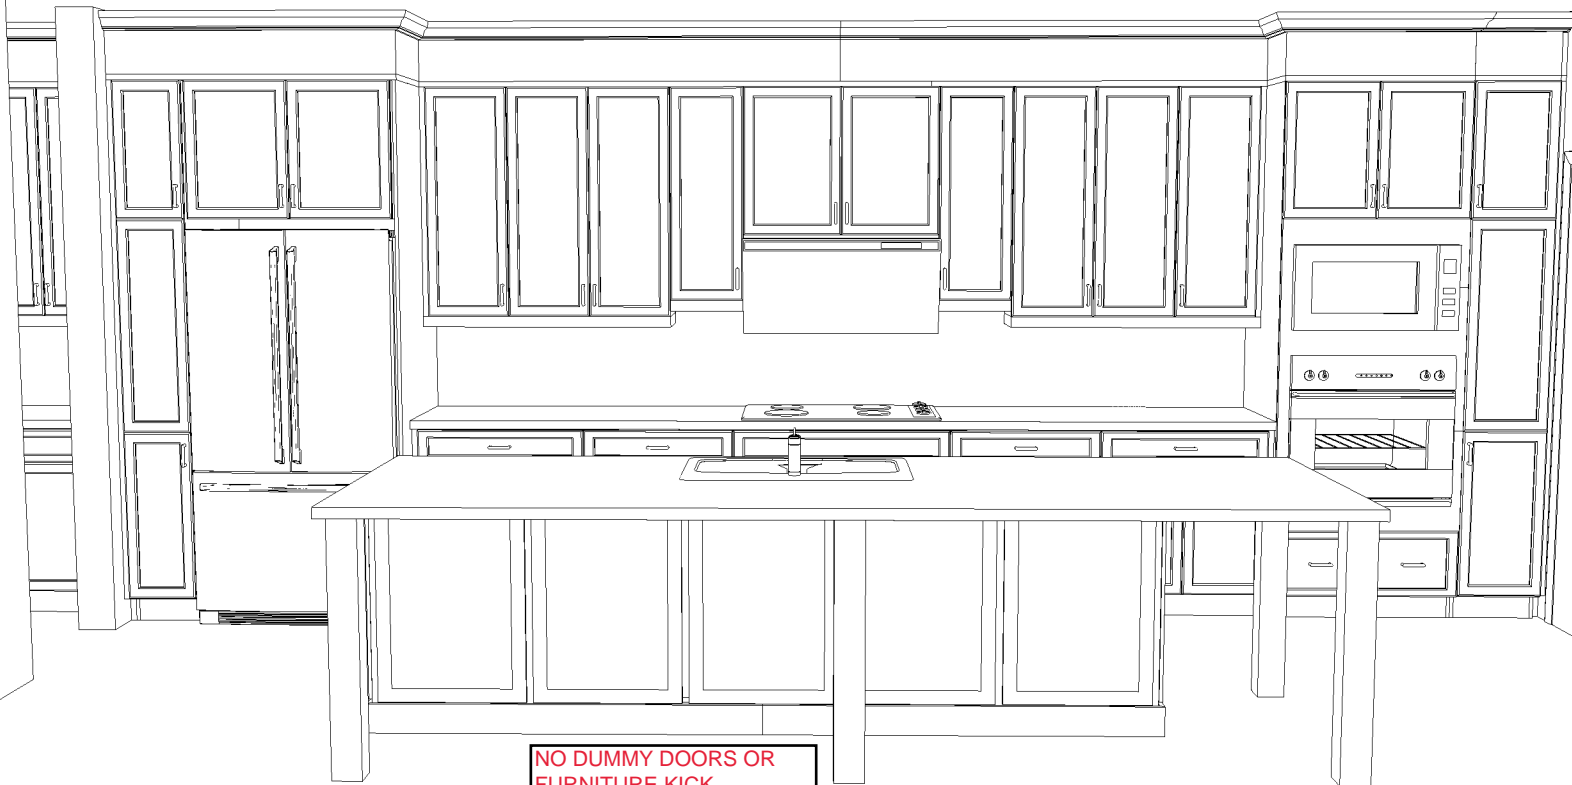

KITCHEN - 3D VIEW #1

REVISED: FEB 16-22

CUSTOMER APPROVAL

I have reviewed these drawings and understand the details of the design and the CARTIER KITCHENS specifications.


Signature _____

Date 6/29/2022 | 1:46 PM EDT

Note: This drawing is an artistic interpretation of the general appearance of the design. It is not meant to be an exact rendition.



Designed: 2022-02-02
Printed: 2022-02-16

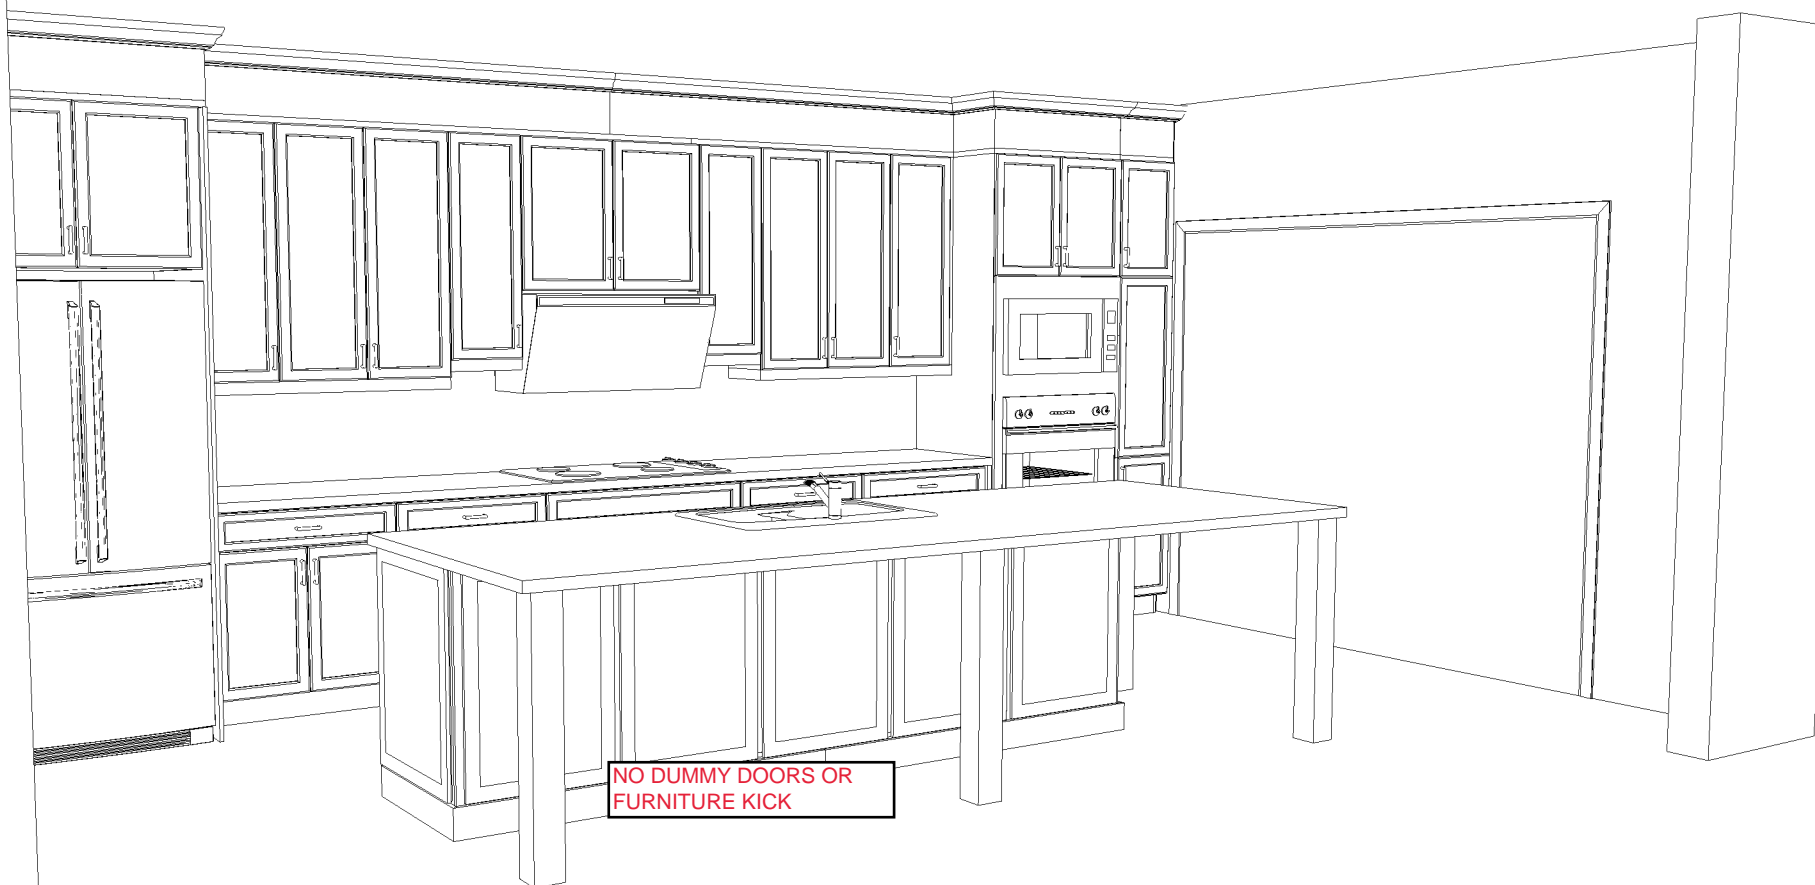

KITCHEN - 3D VIEW #2

REVISED: FEB 16-22

CUSTOMER APPROVAL

I have reviewed these drawings and understand the details of the design and the CARTIER KITCHENS specifications.


Signature _____

Date 6/29/2022 | 1:46 PM EDT

Note: This drawing is an artistic interpretation of the general appearance of the design. It is not meant to be an exact rendition.



Designed: 2022-02-02
Printed: 2022-02-16

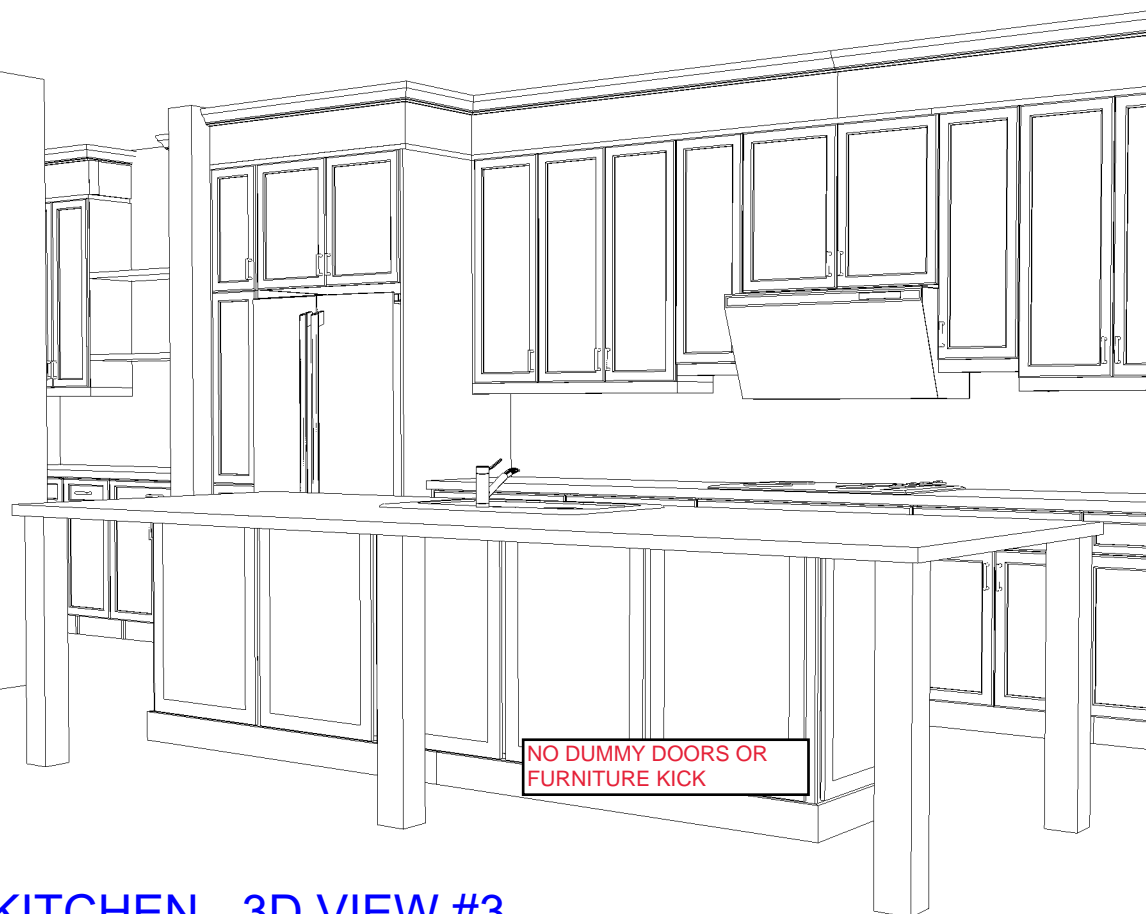

KITCHEN - 3D VIEW #3

REVISED: FEB 16-22

CUSTOMER APPROVAL

I have reviewed these drawings and understand the details of the design and the CARTIER KITCHENS specifications.


Signature _____

Date _____

Note: This drawing is an artistic interpretation of the general appearance of the design. It is not meant to be an exact rendition.



Designed: 2022-02-02
Printed: 2022-02-16

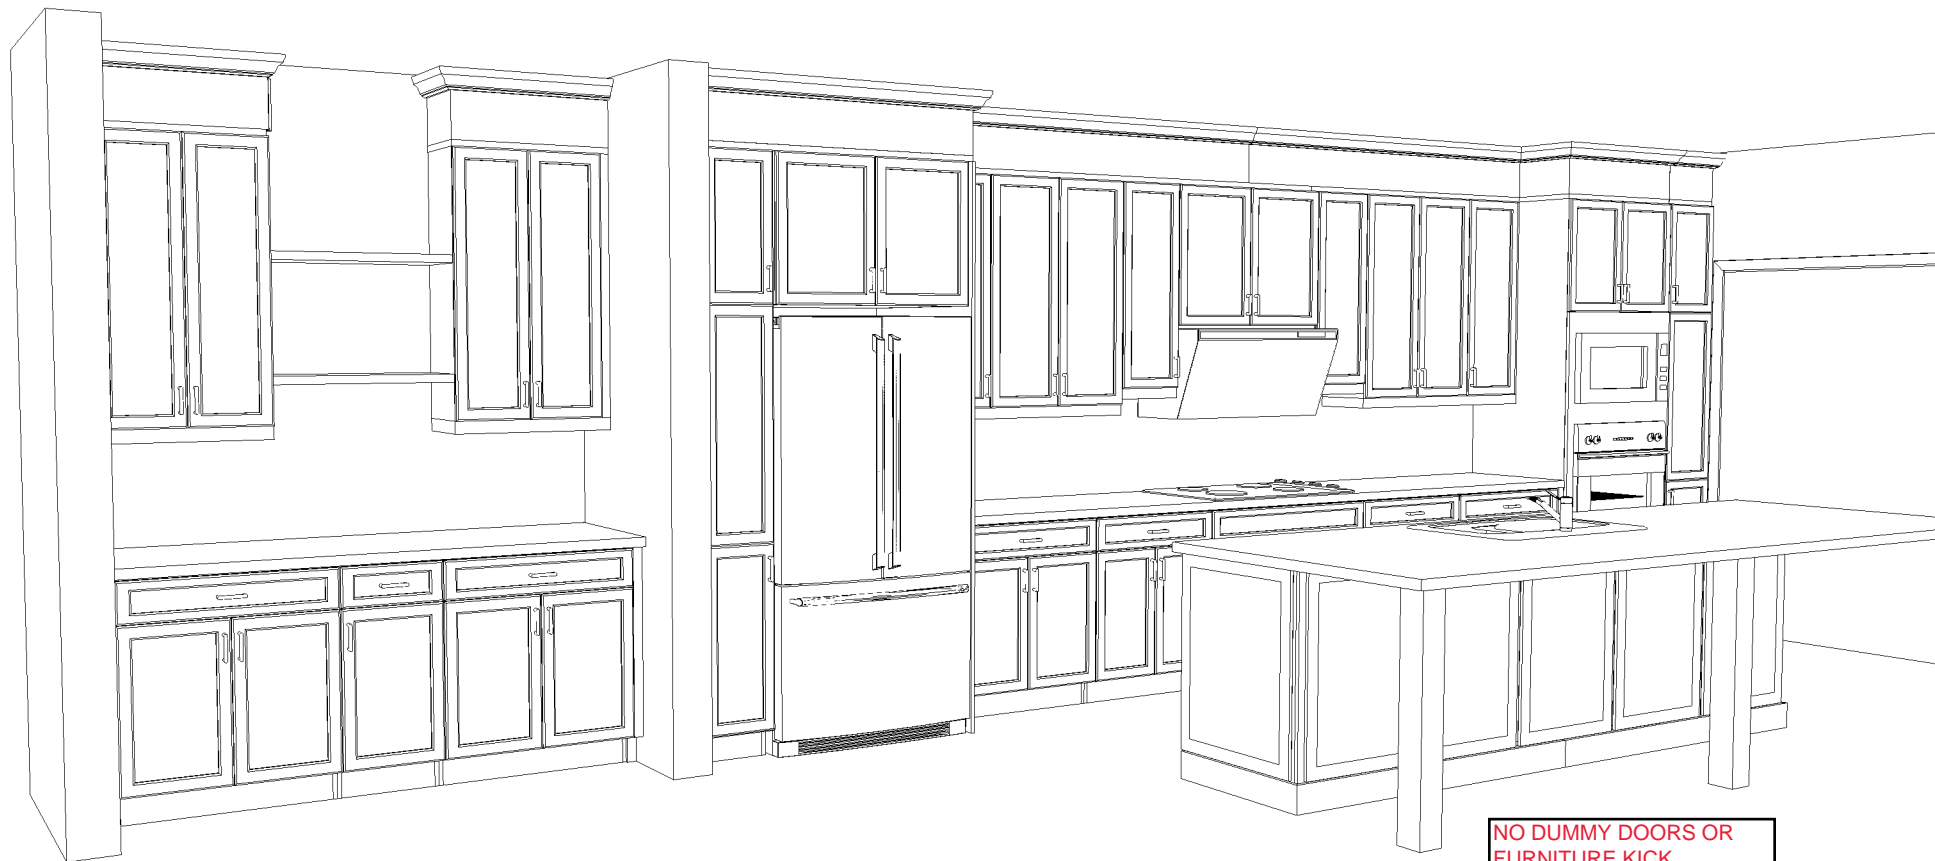

KITCHEN - 3D VIEW #4

REVISED: FEB 16-22

CUSTOMER APPROVAL

I have reviewed these drawings and understand the details of the design and the CARTIER KITCHENS specifications.

Signature _____

Date 6/29/2022 | 1:46 PM EDT

Note: This drawing is an artistic interpretation of the general appearance of the design. It is not meant to be an exact rendition.



Designed: 2022-02-02
Printed: 2022-02-16