


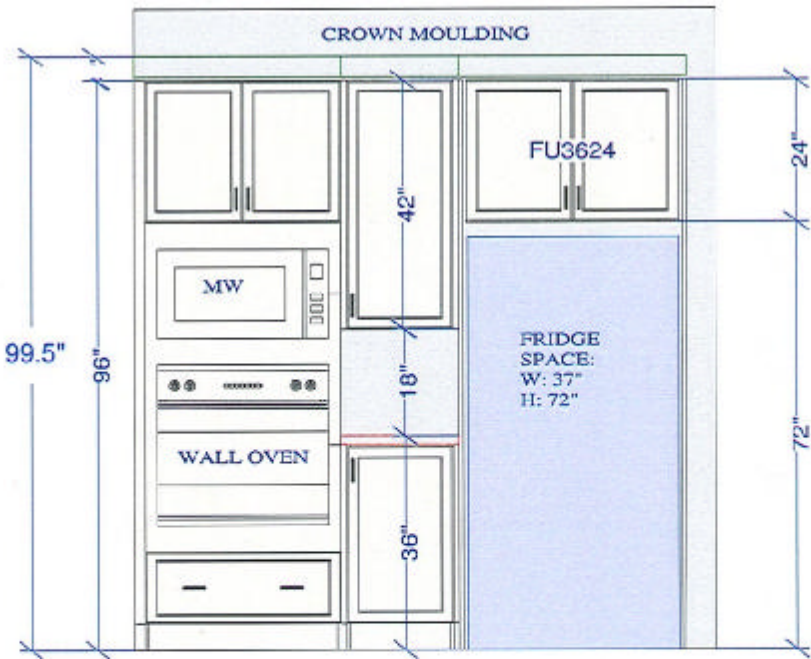

CUSTOMER APPROVAL


Signature _____

Date _____


OVEN / FRIDGE WALL ELEVATION


All dimensions, size designations given are subject to verification on job site and adjustment to fit job conditions.



This is an original design and must not be released or copied unless applicable fee has been paid or job order placed.


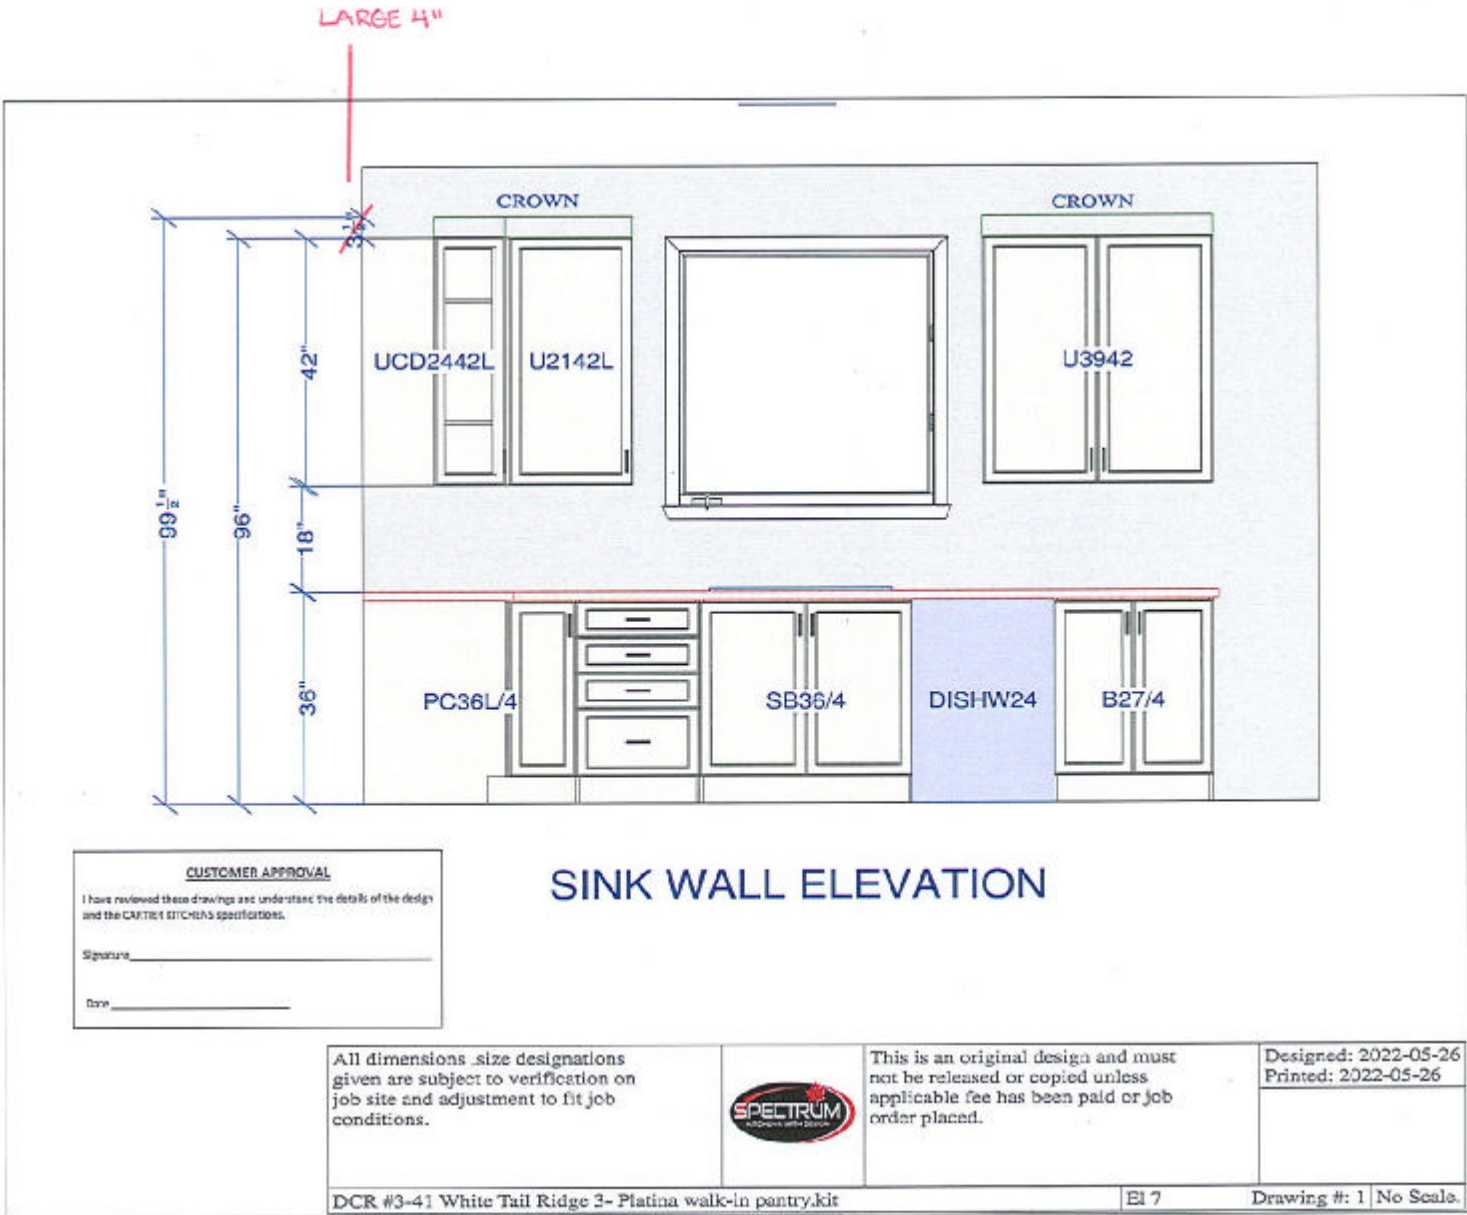

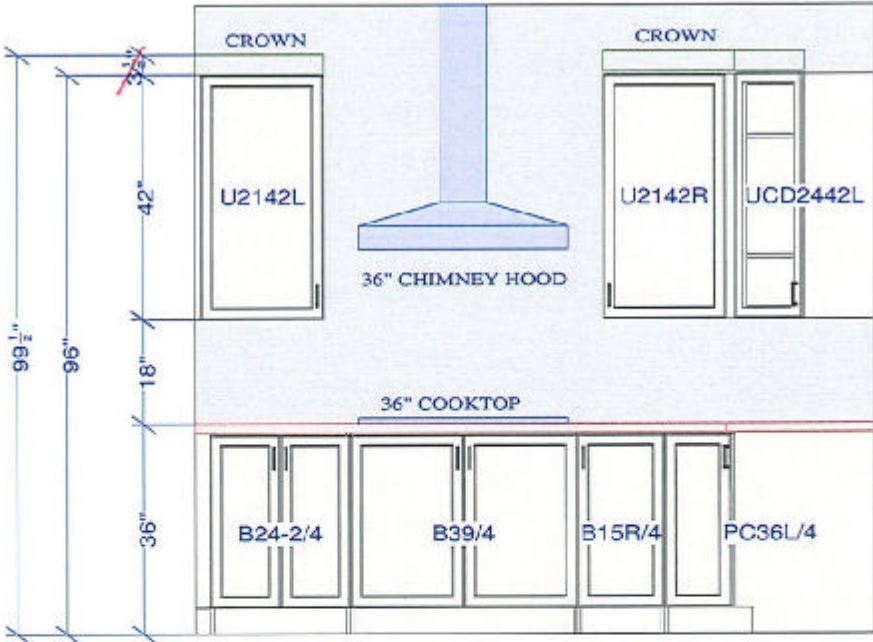

CUSTOMER APPROVAL
I have reviewed these drawings and understand the details of the design and the CARTIER KITCHENS specifications.

Signature _____

Date _____


COOKTOP WALL ELEVATION

All dimensions, size designations given are subject to verification on job site and adjustment to fit job conditions.



This is an original design and must not be released or copied unless applicable fee has been paid or job order placed.

Designed: 2022-05-26
Printed: 2022-05-26

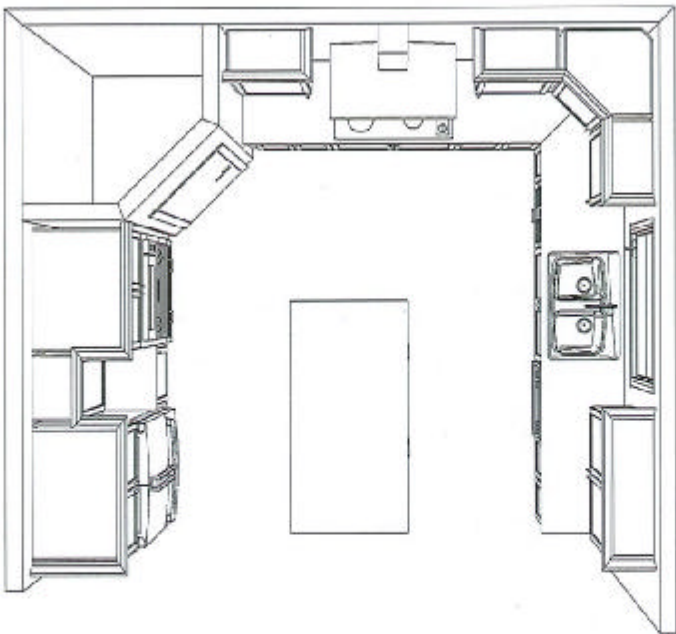

KITCHEN - TOP VIEW

CUSTOMER APPROVAL

I have reviewed these drawings and understand the details of the design and the CARTIER KITCHENS specifications.

Signature _____

Date _____

Note: This drawing is an artistic interpretation of the general appearance of the design. It is not meant to be an exact rendition.



Designed: 2022-05-26
Printed: 2022-05-26

DCR #3-41 White Tail Ridge 3- Platina walk-in

All

Drawing #: 1



KITCHEN - 3D VIEW #1

CUSTOMER APPROVAL	
I have reviewed these drawings and understand the details of the design and the CARTER KITCHENS specifications.	
Signature _____	
Date _____	

Note: This drawing is an artistic interpretation of the general appearance of the design. It is not meant to be an exact rendition.		Designed: 2022-05-26
		Printed: 2022-05-26
DCR #3-41 White Tail Ridge 3- Platina walk-in	All	Drawing #: 1



KITCHEN - 3D VIEW #2

CUSTOMER APPROVAL I have reviewed these drawings and understand the details of the design and the CARTIER KITCHENS specifications. Signature _____ Date _____
--

Note: This drawing is an artistic interpretation of the general appearance of the design. It is not meant to be an exact rendition.		Designed: 2022-05-26 Printed: 2022-05-26
		DCR #3-41 White Tail Ridge 3- Platina walk-in All Drawing #: 1



KITCHEN - 3D VIEW #3

CUSTOMER APPROVAL

I have reviewed these drawings and understand the details of the design and the CARTIER KITCHENS specifications.

Signature _____

Date _____

Note: This drawing is an artistic interpretation of the general appearance of the design. It is not meant to be an exact rendition.		Designed: 2022-05-26
		Printed: 2022-05-26
DCR #3-41 White Tail Ridge 3- Platina walk-in		Drawing #: 1