

CUSTOMER APPROVAL

I have reviewed these drawings and understand the details of the design and the CARTIER KITCHENS specifications.

Signature _____

Date _____

DCR PHOENIX HOMES

LOT #265

PATHWAYS 2

MODEL: MIRAPOSA PLUS (GARAGERIGHT)

KITCHEN & VANITIES

GROUND FLOOR KITCHEN

MOUNTING HEIGHT : 96"


42" H. UPPERS @ A8" ABOVE COUNTER

LIGHT VALANCE


CROWN MOULDING

CABINETS -
HARDWARE -
STANDARD WHITE INTERIORS
METAL DRAWER BOX
4 - 5/8" TOEKICK FINISHED BOTH ENDS
1PCS - 90 DEG. CORNER MOULD
1PCS - T MOULD
8 PCS - FLAT MOULDINGS


Add (2) glass doors

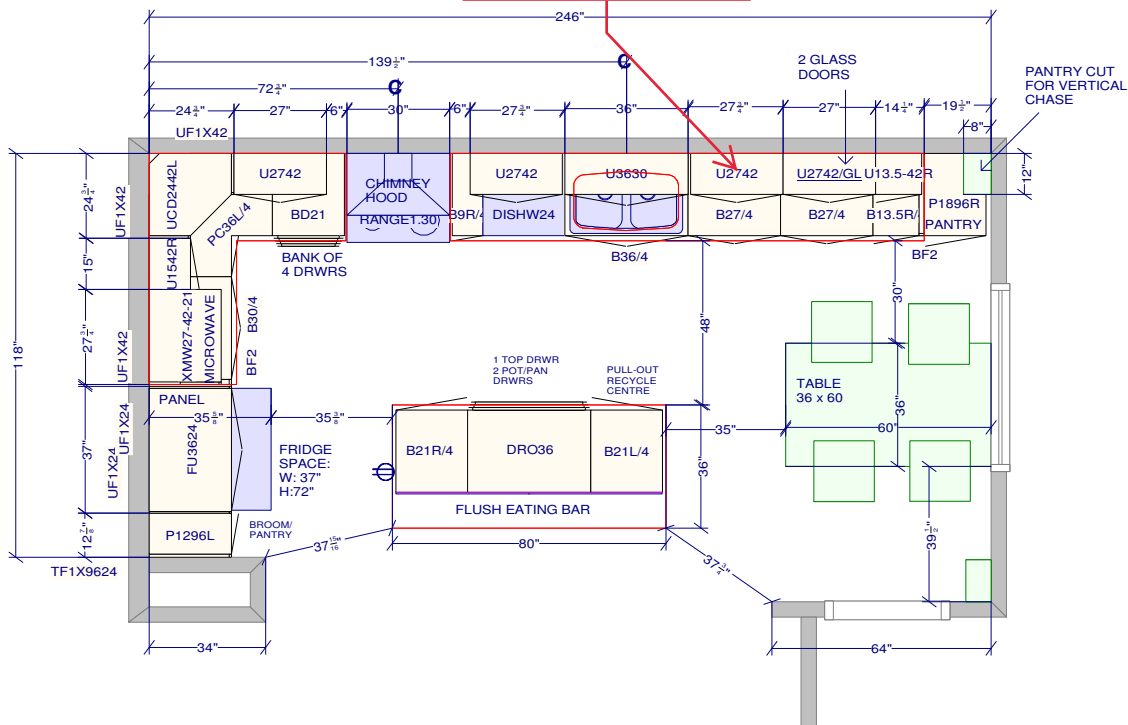


VANITIES

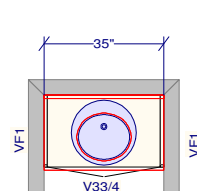

POWDER ROOM

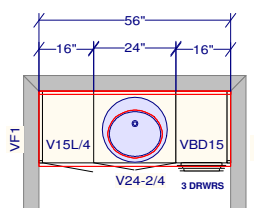

MAIN BATH

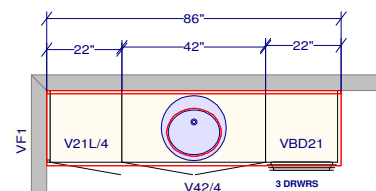

MASTER ENSUITE

Increase height to 36"H

-DS

M

DS


MB

All dimensions _size designations given are subject to verification on job site and adjustment to fit job conditions.



This is an original design and must not be released or copied unless applicable fee has been paid or job order placed.

Designed: 2022-01-17 Printed: 2022-01-17

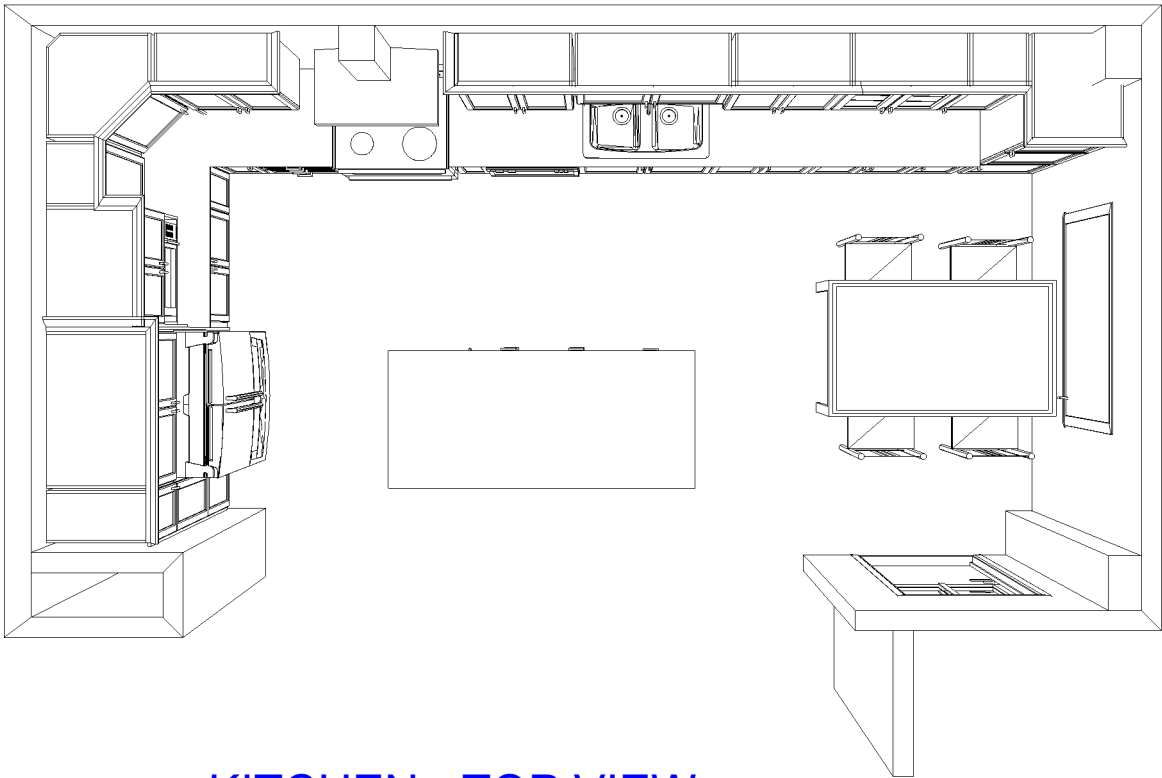

KITCHEN - TOP VIEW


DS

DS

M

MB

Signature_____

Date _____

Note: This drawing is an artistic interpretation of the general appearance of the design. It is not meant to be an exact rendition.



Designed: 2022-01-17
Printed: 2022-01-17



KITCHEN - 3D VIEW #1

CUSTOMER APPROVAL

I have reviewed these drawings and understand the details of the design and the CARTIER KITCHENS specifications.

Signature _____


Date _____

ds
M MB

Note: This drawing is an artistic interpretation of the general appearance of the design. It is not meant to be an exact rendition.



Designed: 2022-01-17
Printed: 2022-01-17

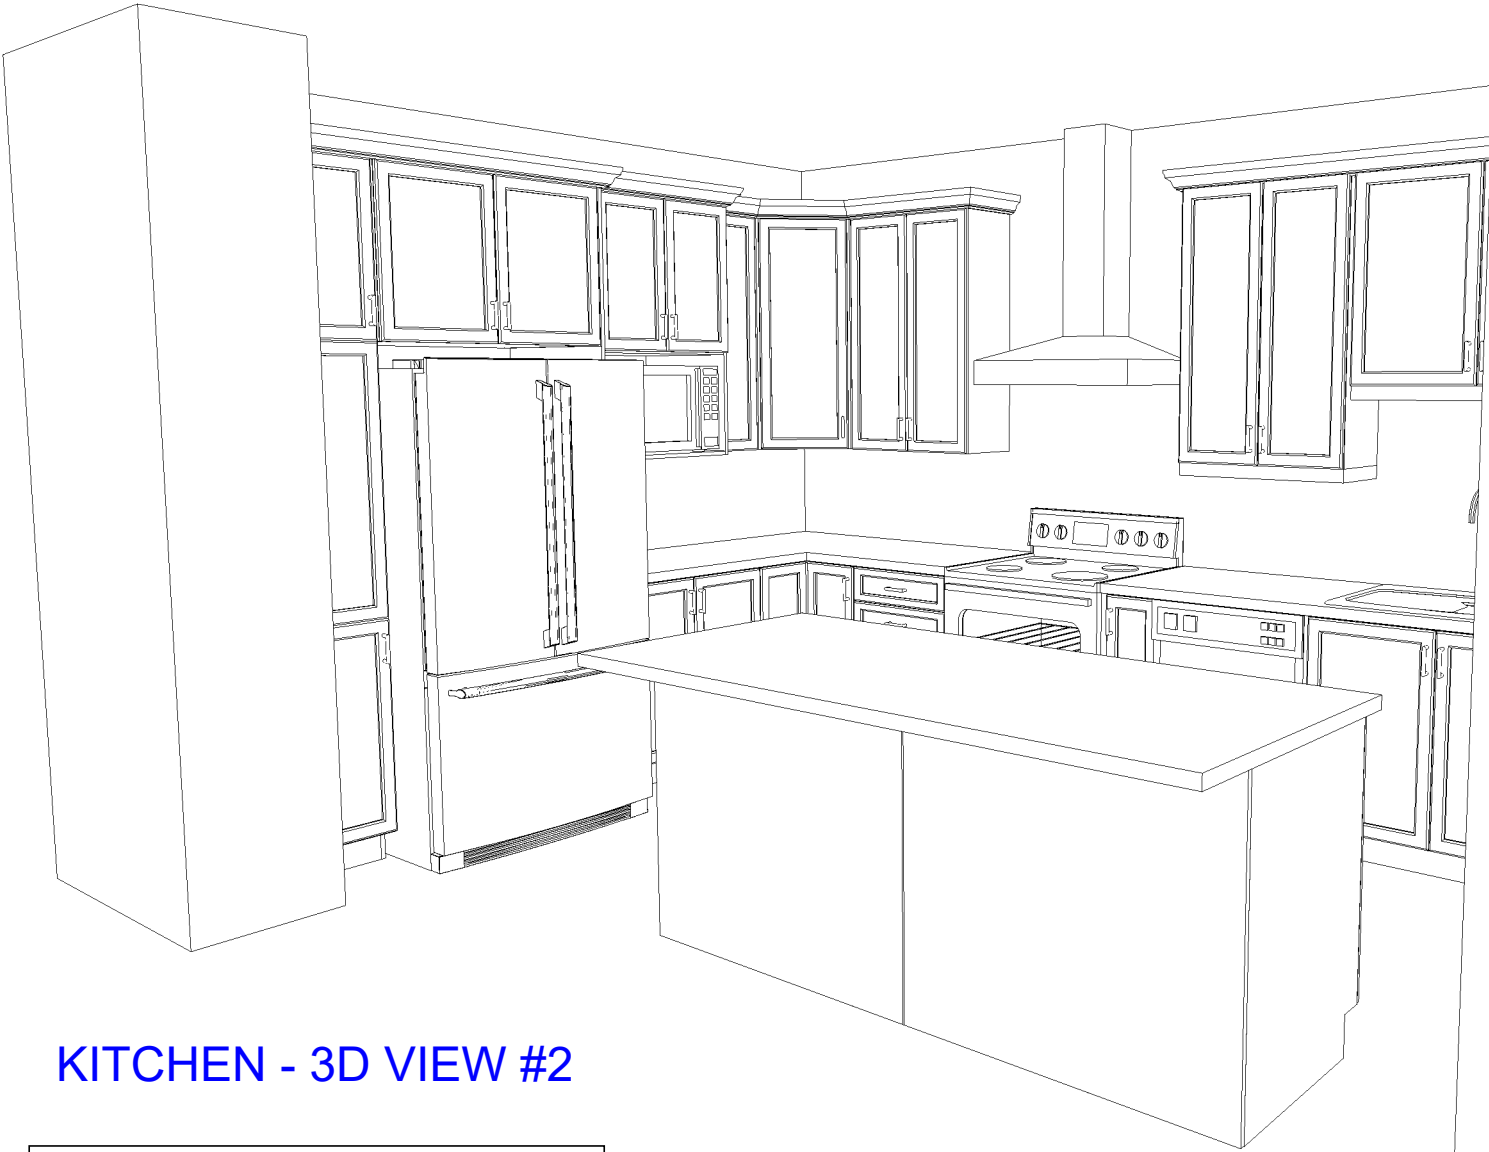

KITCHEN - 3D VIEW #2

CUSTOMER APPROVAL

I have reviewed these drawings and understand the details of the design and the CARTIER KITCHENS specifications.

Signature MB

Date _____

Note: This drawing is an artistic interpretation of the general appearance of the design. It is not meant to be an exact rendition.



Designed: 2022-01-17
Printed: 2022-01-17

I have reviewed these drawings and understand the details of the design and the CARTIER KITCHENS specifications.

Signature _____

Date _____


KITCHEN - 3D VIEW #3



Note: This drawing is an artistic interpretation of the general appearance of the design. It is not meant to be an exact rendition.



Designed: 2022-01-17
Printed: 2022-01-17

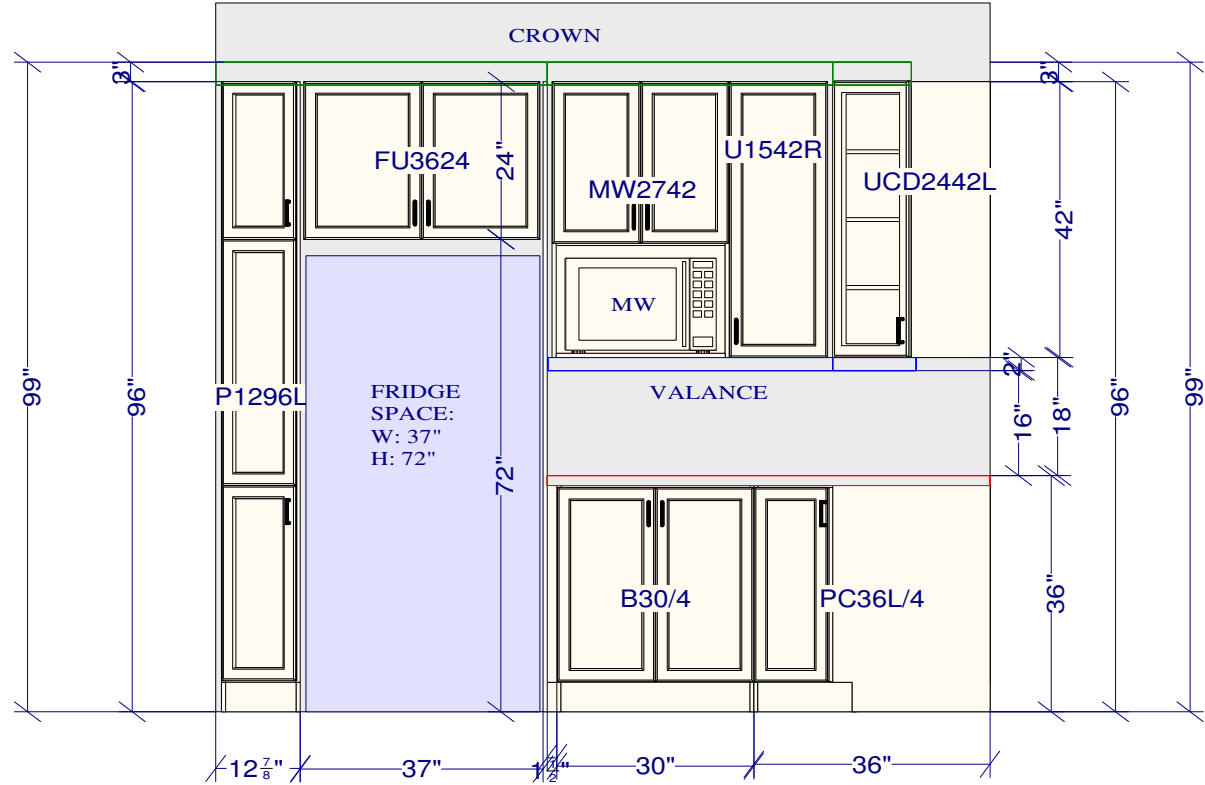

FRIDGE WALL ELEVATION


CUSTOMER APPROVAL

I have reviewed these drawings and understand the details of the design and the CARTIER KITCHENS specifications.

Signature

Date

All dimensions _size designations given are subject to verification on job site and adjustment to fit job conditions.		This is an original design and must not be released or copied unless applicable fee has been paid or job order placed.	Designed: 2022-01-17 Printed: 2022-01-17	
DCR #265 Pathways 2 - MIRAPOSA (RIGHT)- Kitchen _vanities.kit		El 2	Drawing #: 1	No Scale.

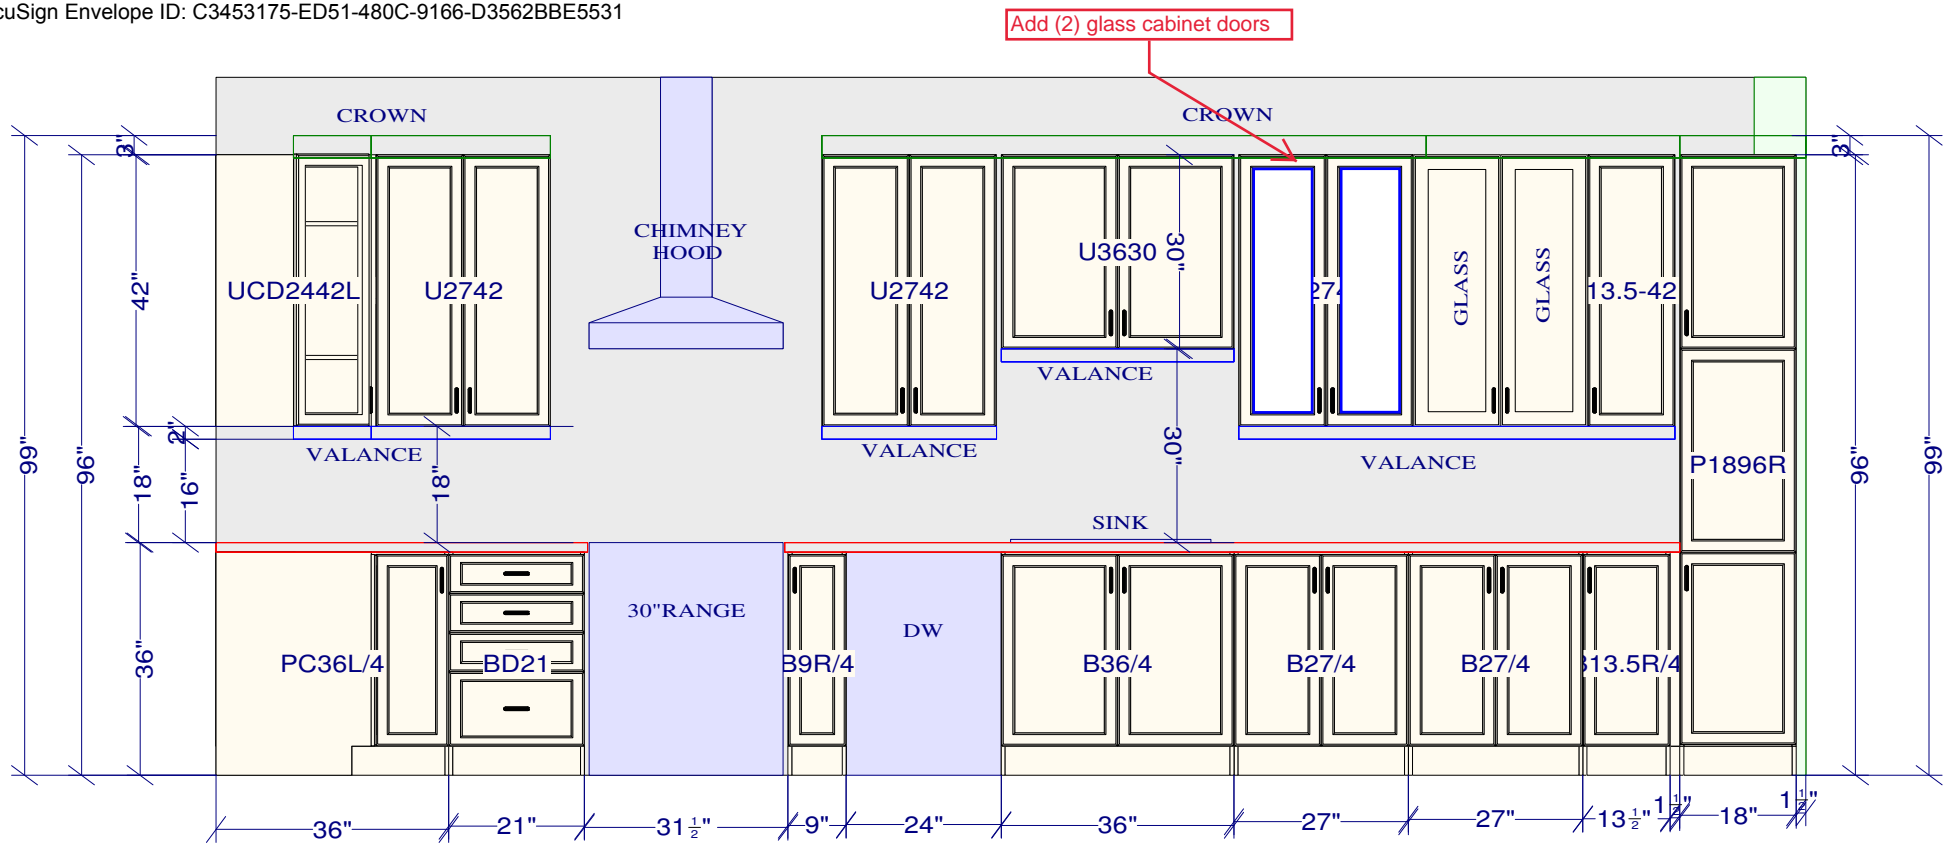

RANGE / SINK WALL ELEVATION

CUSTOMER APPROVAL

I have reviewed these drawings and understand the details of the design and the CARTIER KITCHENS specifications.

Signature _____

Date _____


All dimensions and size designations given are subject to verification on job site and adjustment to fit job conditions.




This is an original design and must not be released or copied unless applicable fee has been paid or job order placed.

Designed: 2022-01-17
Printed: 2022-01-17


VANITIES

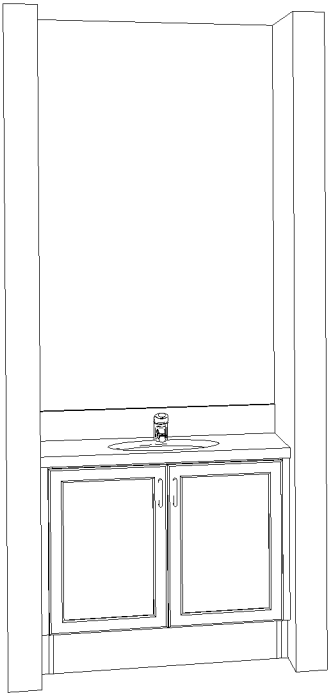

POWDER ROOM

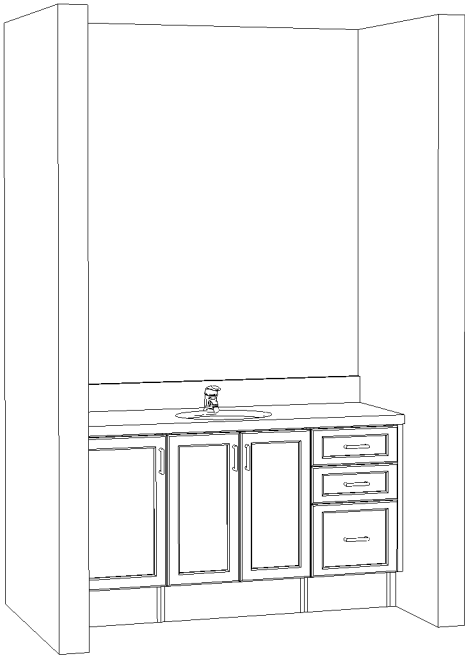

MAIN BATH

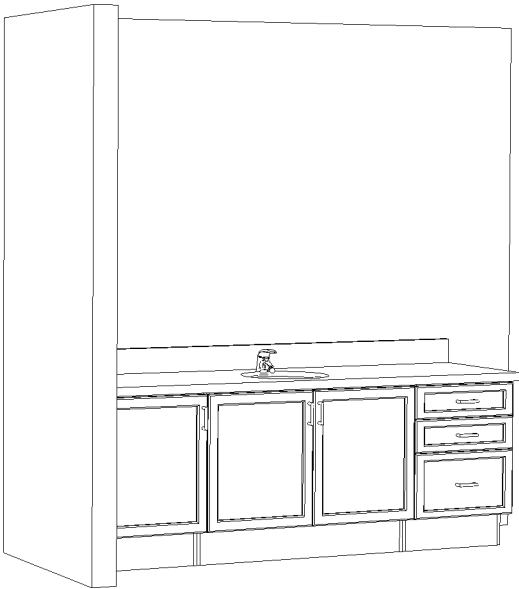

ENSUITE

Increase height to 36"H

CUSTOMER APPROVAL

I have reviewed these drawings and understand the details of the design and the CARTIER KITCHENS specifications.

Signature _____

Date _____

Note: This drawing is an artistic interpretation of the general appearance of the design. It is not meant to be an exact rendition.



Designed: 2022-01-17
Printed: 2022-01-17

MODEL: 35-32 MIRAPOSA



BASEMENT APARTMENT

KITCHEN & VANITIES

- LINE -
- HARDWARE -
- STANDARD WHITE INTERIORS
- METAL DRAWER BOX
- 4 - 5/8" TOEKICK FINISHED BOTH ENDS
- 3- LOOSE FILLER , 3X96
- 1PCS - 90 DEG. CORNER MOULD
- 1PCS - T MOULD
- 8 PCS - FLAT MOULDINGS

KITCHEN

MOUNTING HT: 84

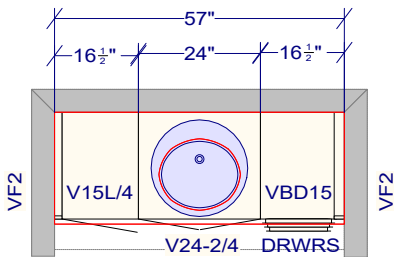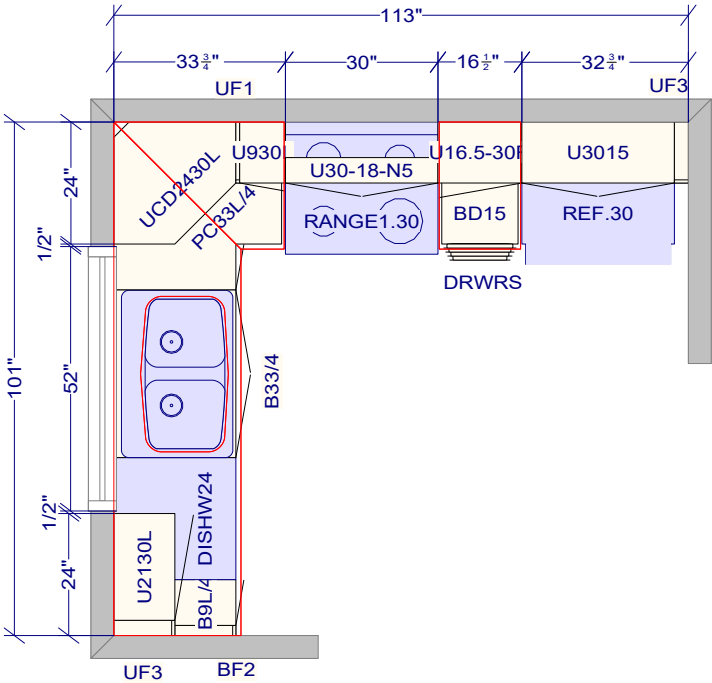


BSMT APT VANITY


DS

M

DS

MB

All dimensions _size designations given are subject to verification on job site and adjustment to fit job conditions.		This is an original design and must not be released or copied unless applicable fee has been paid or job order placed.	Designed: 2018-07-11 Printed: 2018-07-11		
MIRAPOSA - Bsmt Apt			All	Drawing #: 1	No Scale.

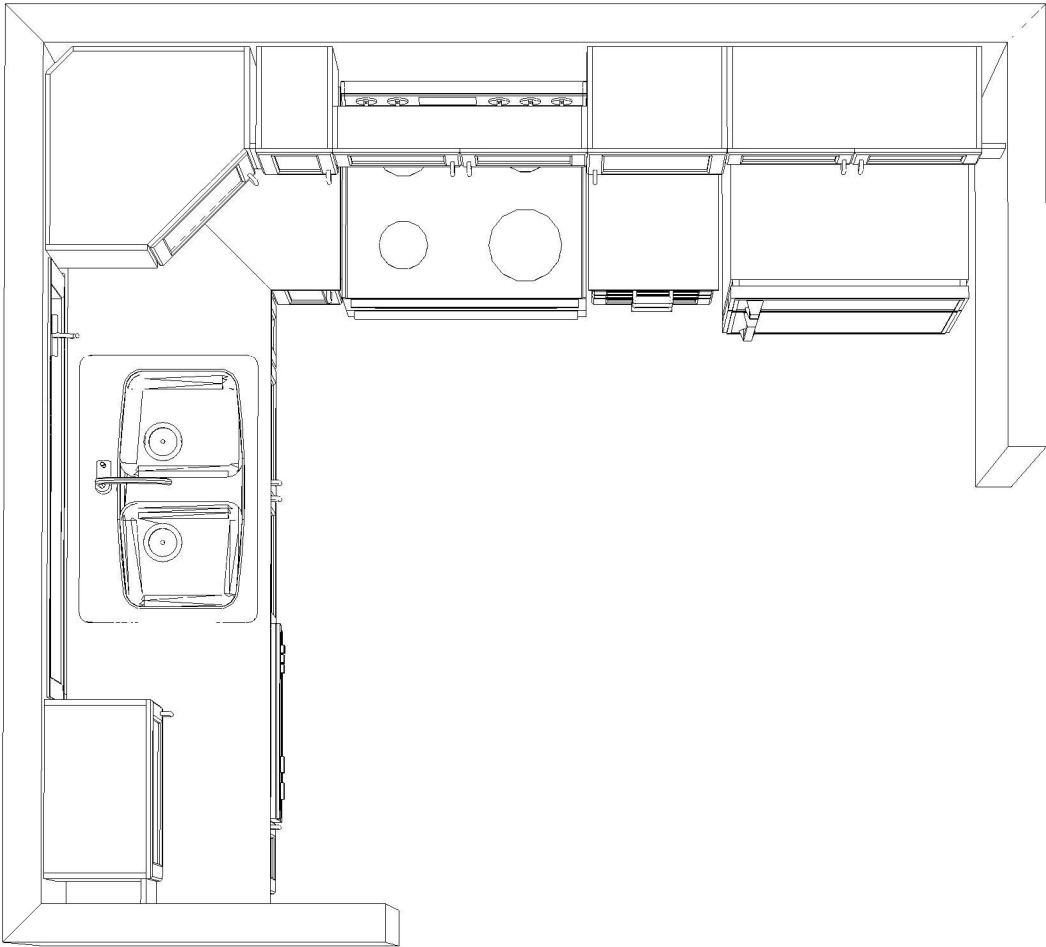

BASEMENT KITCHEN - TOP VIEW
35- 32 MIRAPOSA

CUSTOMER APPROVAL

DS

DS

DS

DS

I have reviewed these drawings and understand the details of the design and the Cartier Kitchen Applications


Signature _____

Date _____

Note: This drawing is an artistic interpretation of the general appearance of the design. It is not meant to be an exact rendition.



Designed: 2018-07-11
Printed: 2018-07-12

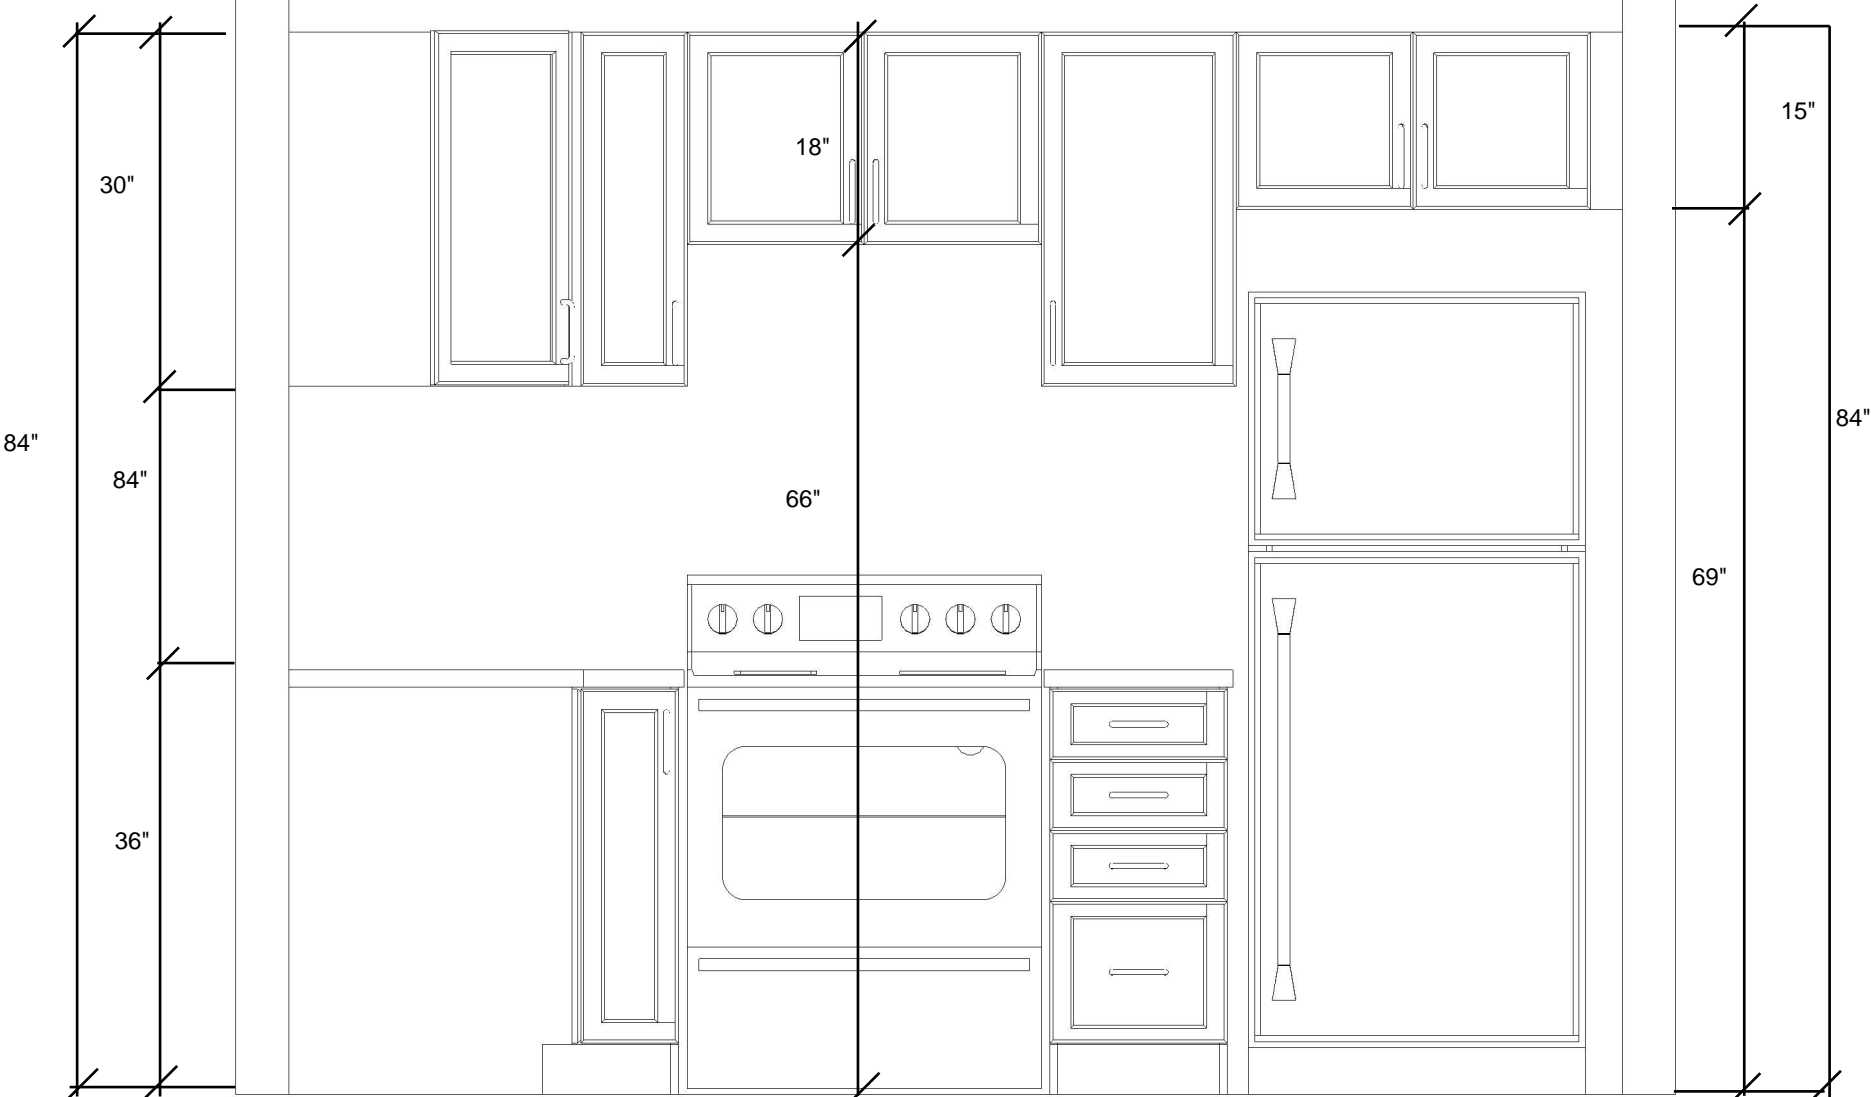

BASEMENT KITCHEN - RANGE / FRIDGE WALL ELEVATION
35- 32 MIRAPOSA

CUSTOMER APPROVALS

I have reviewed these drawings and understand the details of the design and the Cartier Kitchen's specifications


Signature _____

Date _____

Note: This drawing is an artistic interpretation of the general appearance of the design. It is not meant to be an exact rendition.



Designed: 2018-07-11
Printed: 2018-07-11

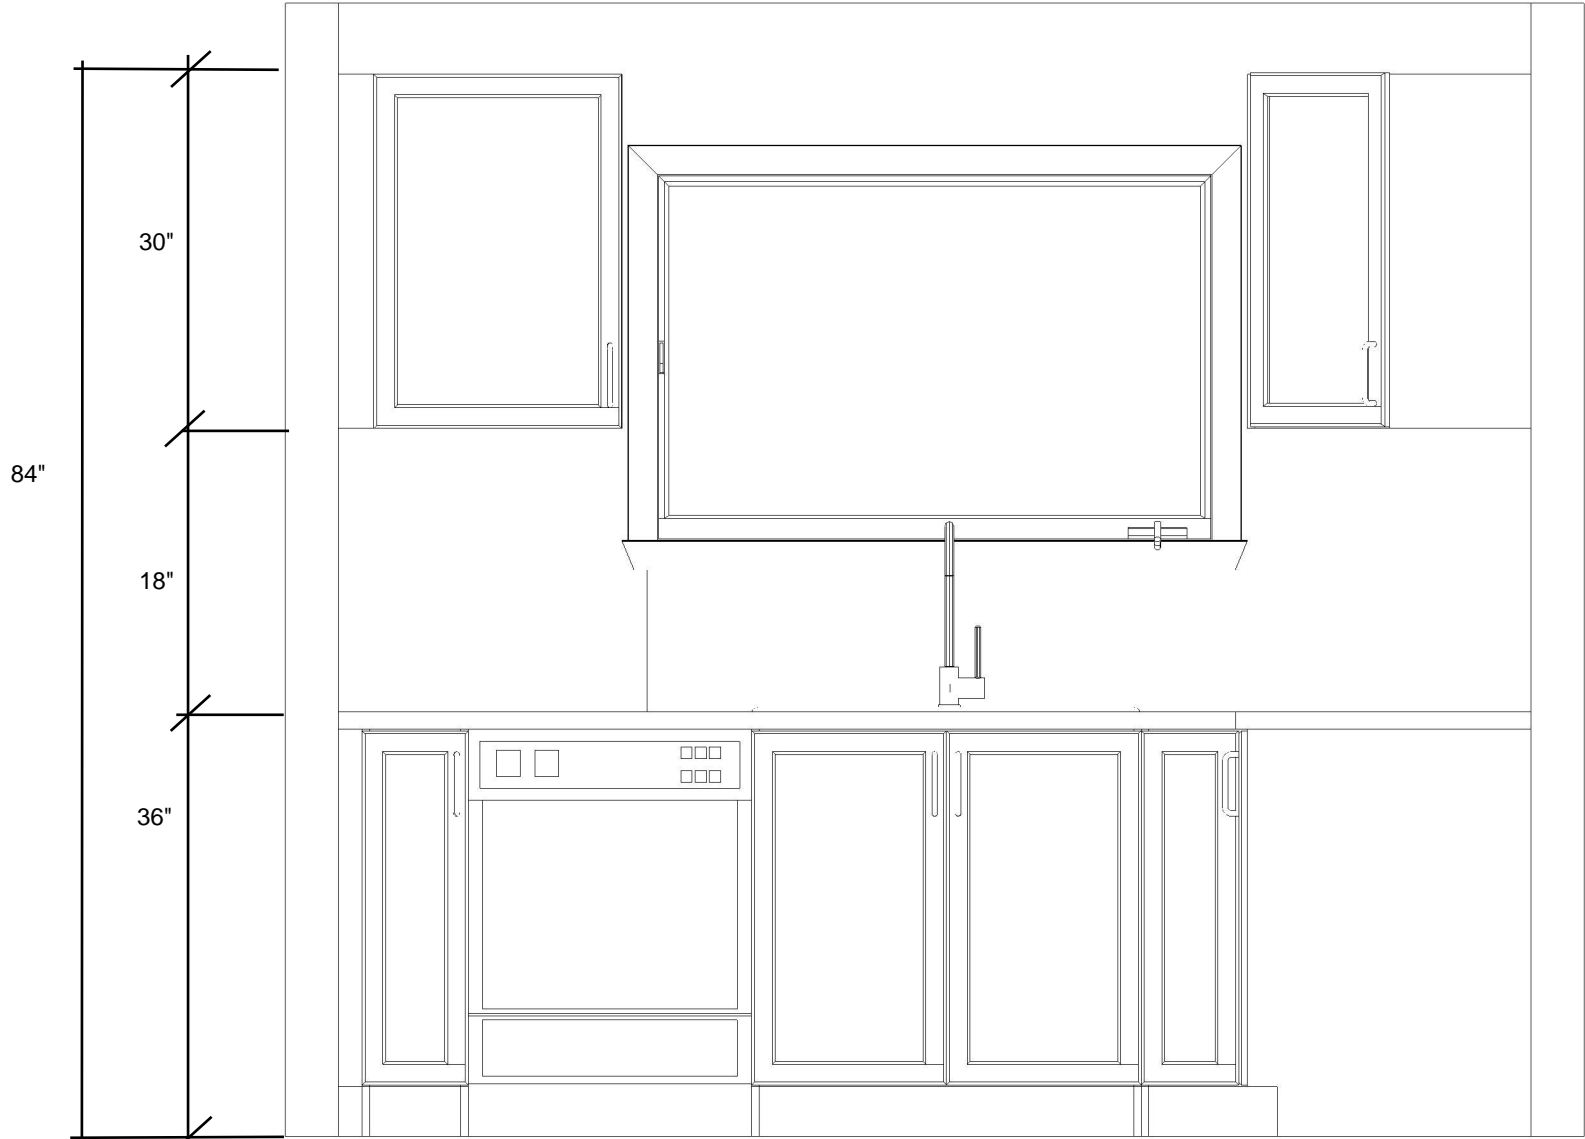

BASEMENT KITCHEN - SINK WALL ELEVATION
35- 32 MIRAPOSA

CUSTOMER APPROVAL

I have reviewed these drawings and understand the details of the design and the Cartier Kitchen's specifications


Signature _____

Date _____

Note: This drawing is an artistic interpretation of the general appearance of the design. It is not meant to be an exact rendition.



Designed: 2018-07-11
Printed: 2018-07-11

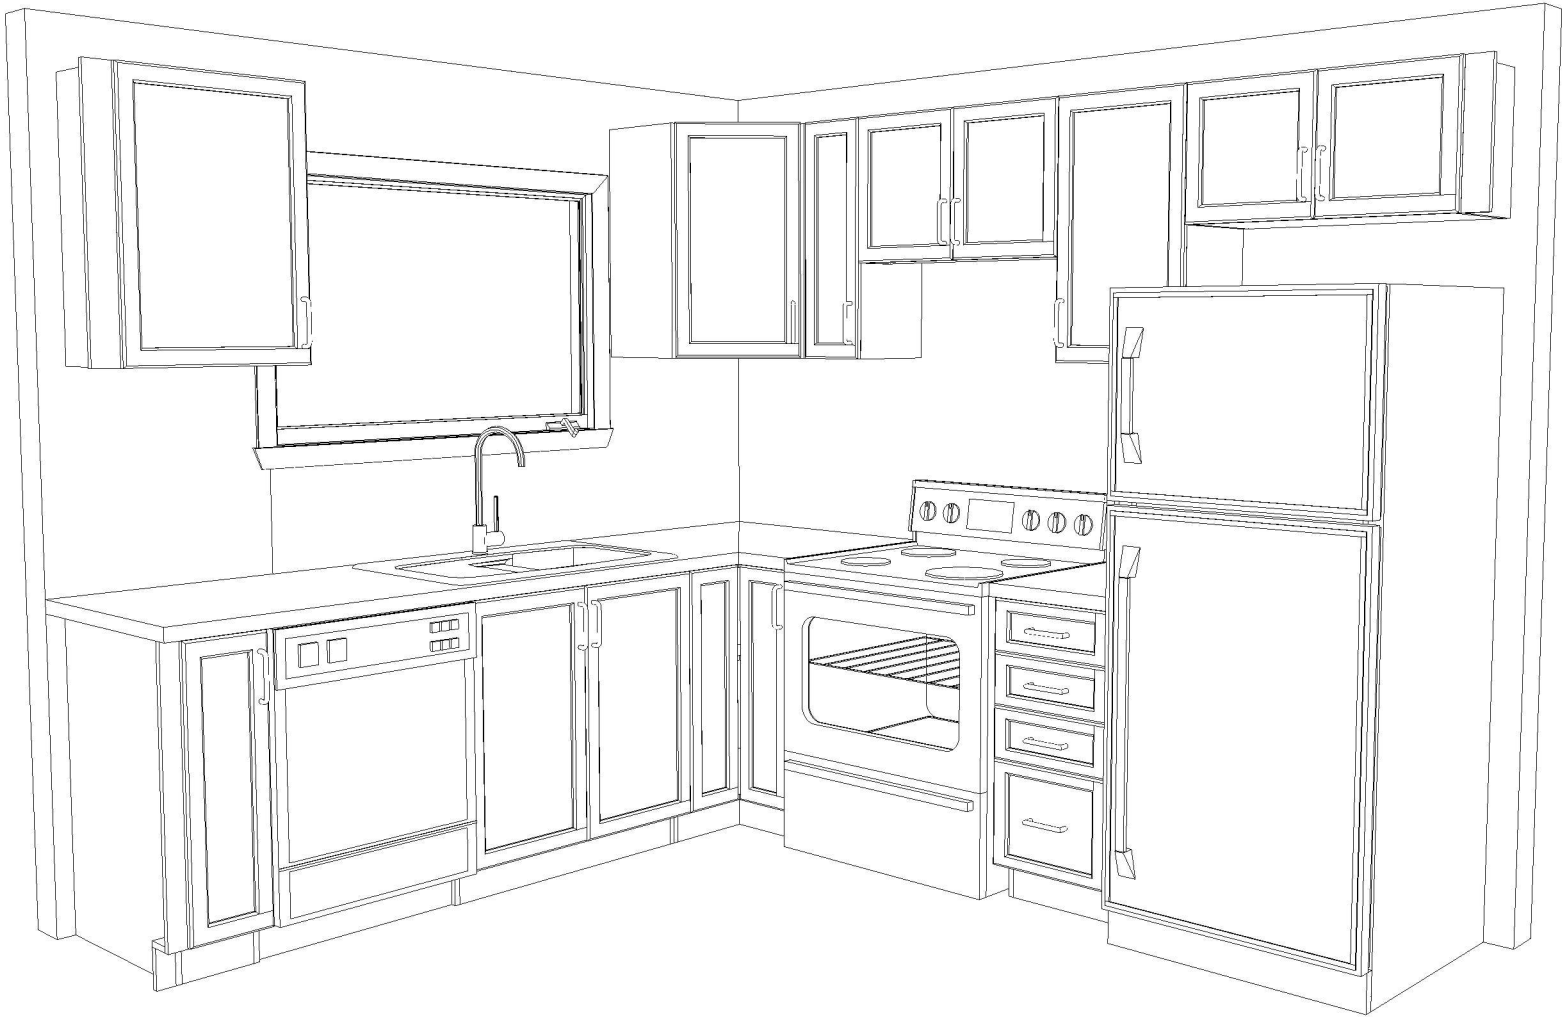

BASEMENT KITCHEN - 3D VIEW 1
35- 32 MIRAPOSA

CUSTOMER APPROVES

I have reviewed these drawings and understand the details of the design and the Cartier Kitchens specifications


Signature _____

Date _____

Note: This drawing is an artistic interpretation of the general appearance of the design. It is not meant to be an exact rendition.



Designed: 2018-07-11
Printed: 2018-07-11

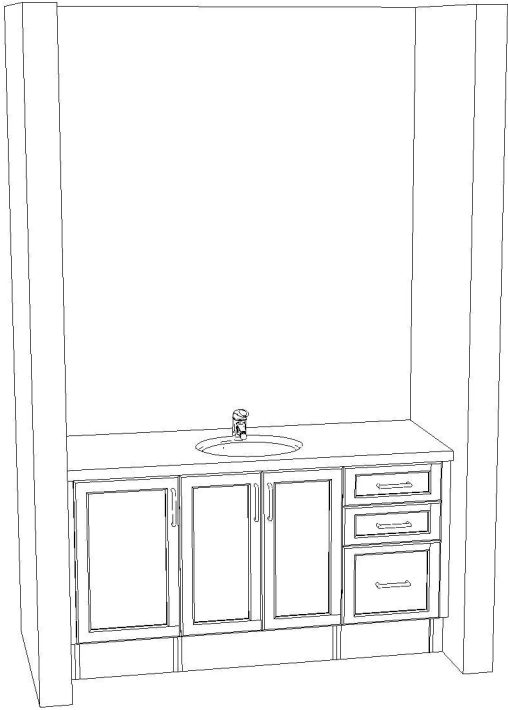

BASEMENT- VANITY 3D VIEW
35- 32 MIRAPOSA

CUSTOMER APPROVAL

I have reviewed these drawings and understand the details of the design and the Carrier Kitchens specifications

Signature _____

Date _____

Note: This drawing is an artistic interpretation of the general appearance of the design. It is not meant to be an exact rendition.



Designed: 2018-07-11
Printed: 2018-07-12