


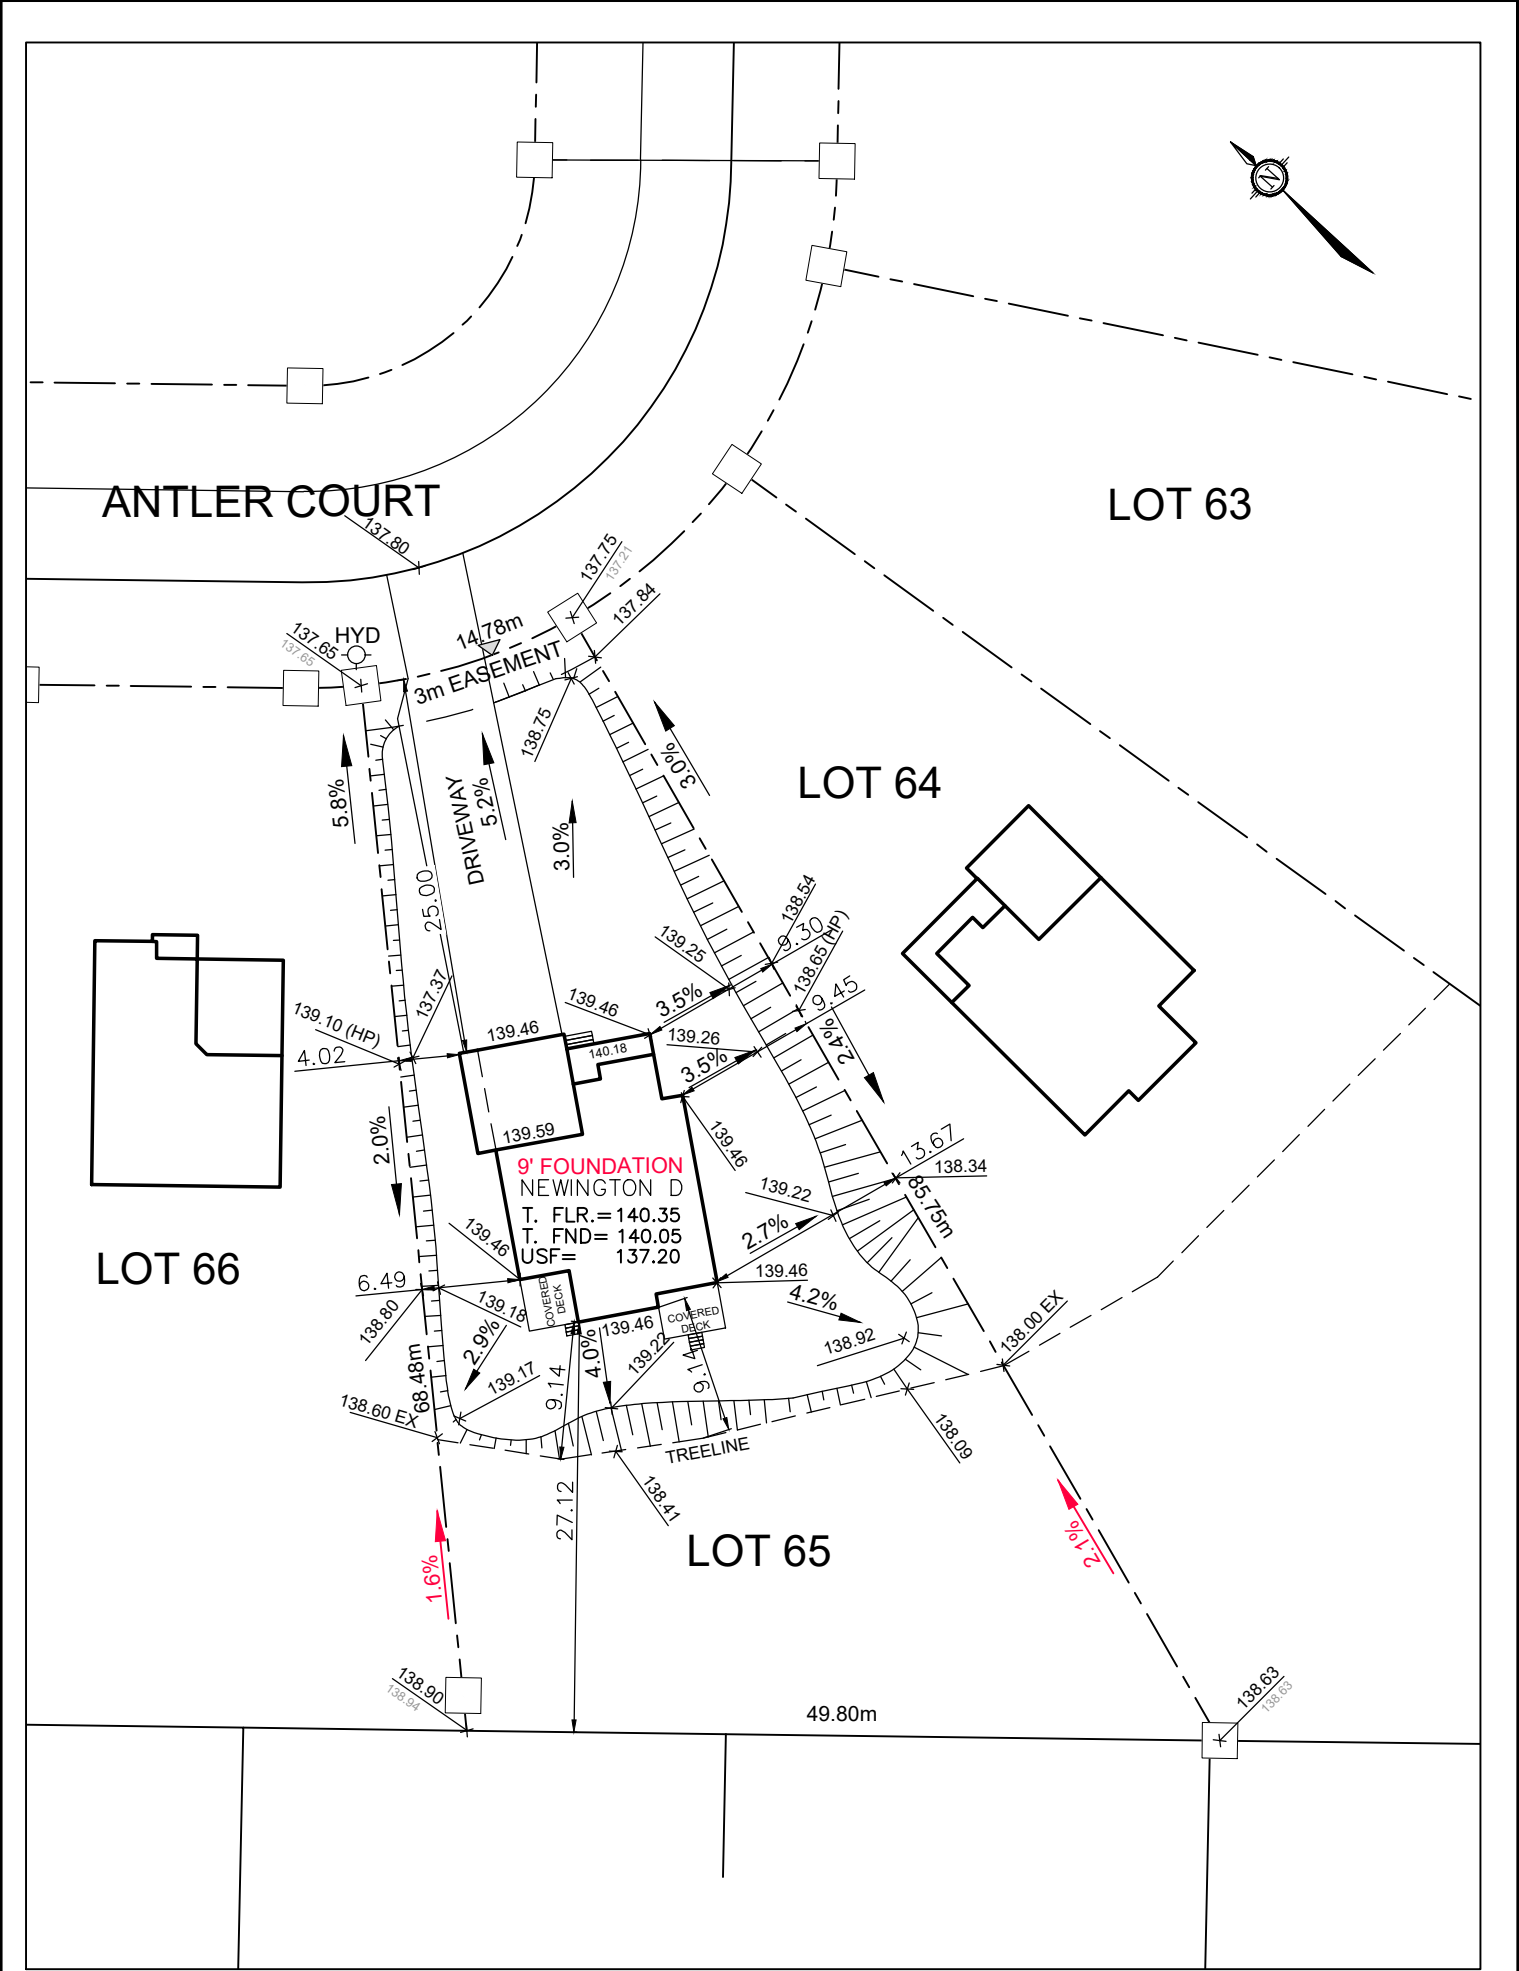

Owner/Applicant DCR/PHOENIX HOMES Telephone # 723-9227 Plan # 27M- 47 Project name: WHITE TAIL RIDGE Civic Address: 360 ANTLER COURT House model: NEWINGTON D		 LOT 65 SITE/GRADING PLAN WHITE TAIL RIDGE PH.II
Bldg. Ht. _____ m Lot coverage 9.5 % Scale 1:500 Sod Area 2070.27 m² Asphalt Area 126.81 m²		INDIVIDUAL LOT GRADING REVIEW SUMMARY FOR SITED HOUSE AS COMPARED WITH OVERALL SUBDIVISION PLAN
CHECKED/APPROVED BY: T.L.MAK ENG. REVISED JUL 19/22 REVISED AUG 30/22 REVISED SEP 23/22 REVISED OCT 03/22		NOTE: THIS PLAN IS NOT A SURVEY PLAN OR SUBDIVISION PLAN WITHIN THE MEANING OF PLANNING ACT. THIS PLAN IS FOR REFERENCE ONLY AND IS PRELIMINARY IN NATURE, ALL DIMENSIONS SHOWN ARE APPROXIMATE. E,O&E.