


DCR PHOENIX HOMES

STRANDHERD MEADOWS 5
PLATINA (512) - LEFT
KITCHEN

- CABINET LINE -
- DOOR STYLE -
- SPECIES -
- COLOUR -
- HARDWARE -
- KICK: 3-PCS.
- STD WHITE INTERIORS
- METAL DRAWER BOXES
- 2 - PCS. 90 DEG. CORNER MOULD.
- 1 PC - T MOULD

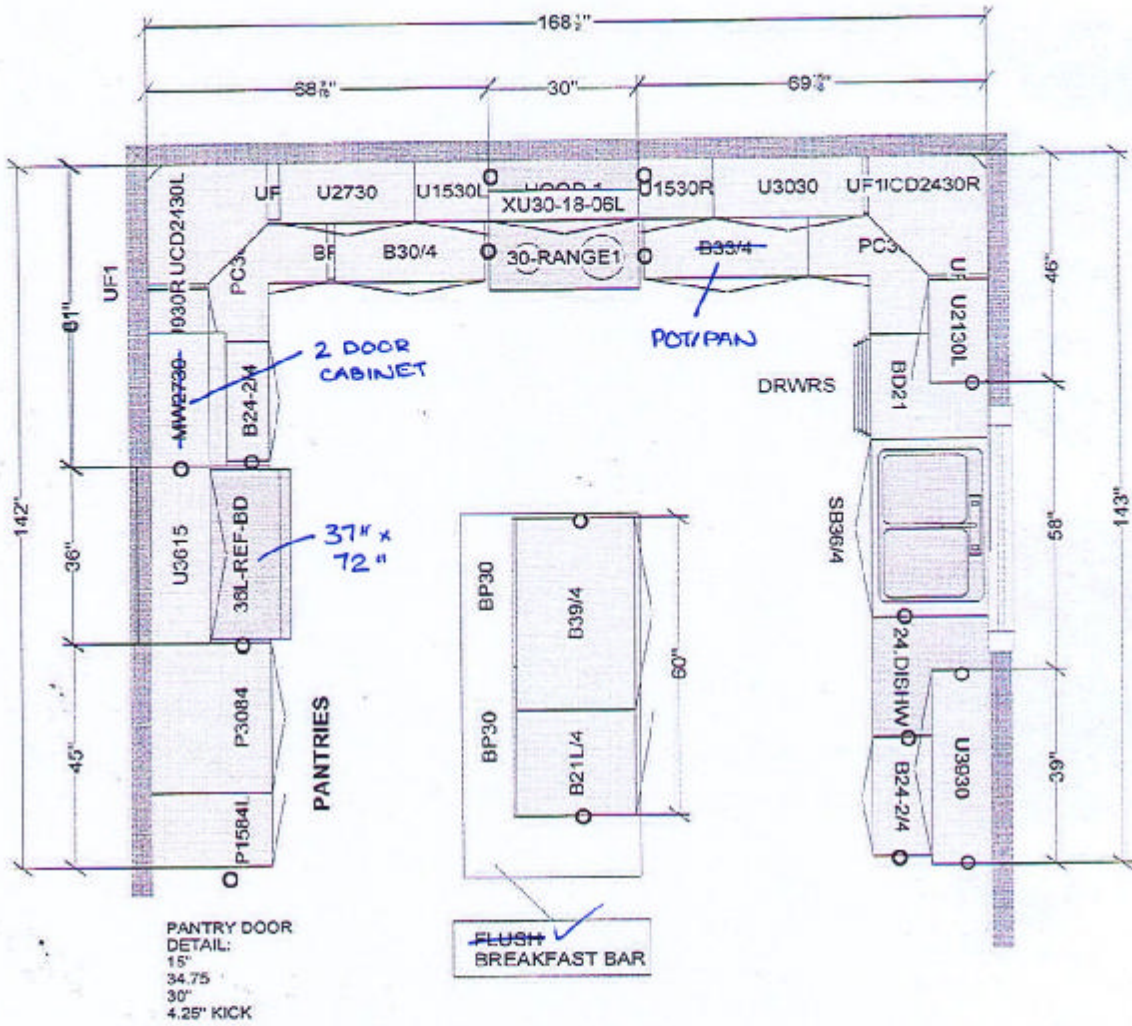

All dimensions, size designations given are subject to verification on job site and adjustment to fit job conditions.

CARTIER KITCHENS OTTAWA

DCR - PLATINA (512) - LEFT



This is an original design and must not be released or copied unless applicable fee has been paid or job order placed.

DRAWN BY: LD
CARTIER KITCHENS OTTAWA


Designed: 11/30/2008
Printed: 6/26/2011

All

Drawing #: 1

DS
RH

DS
EH

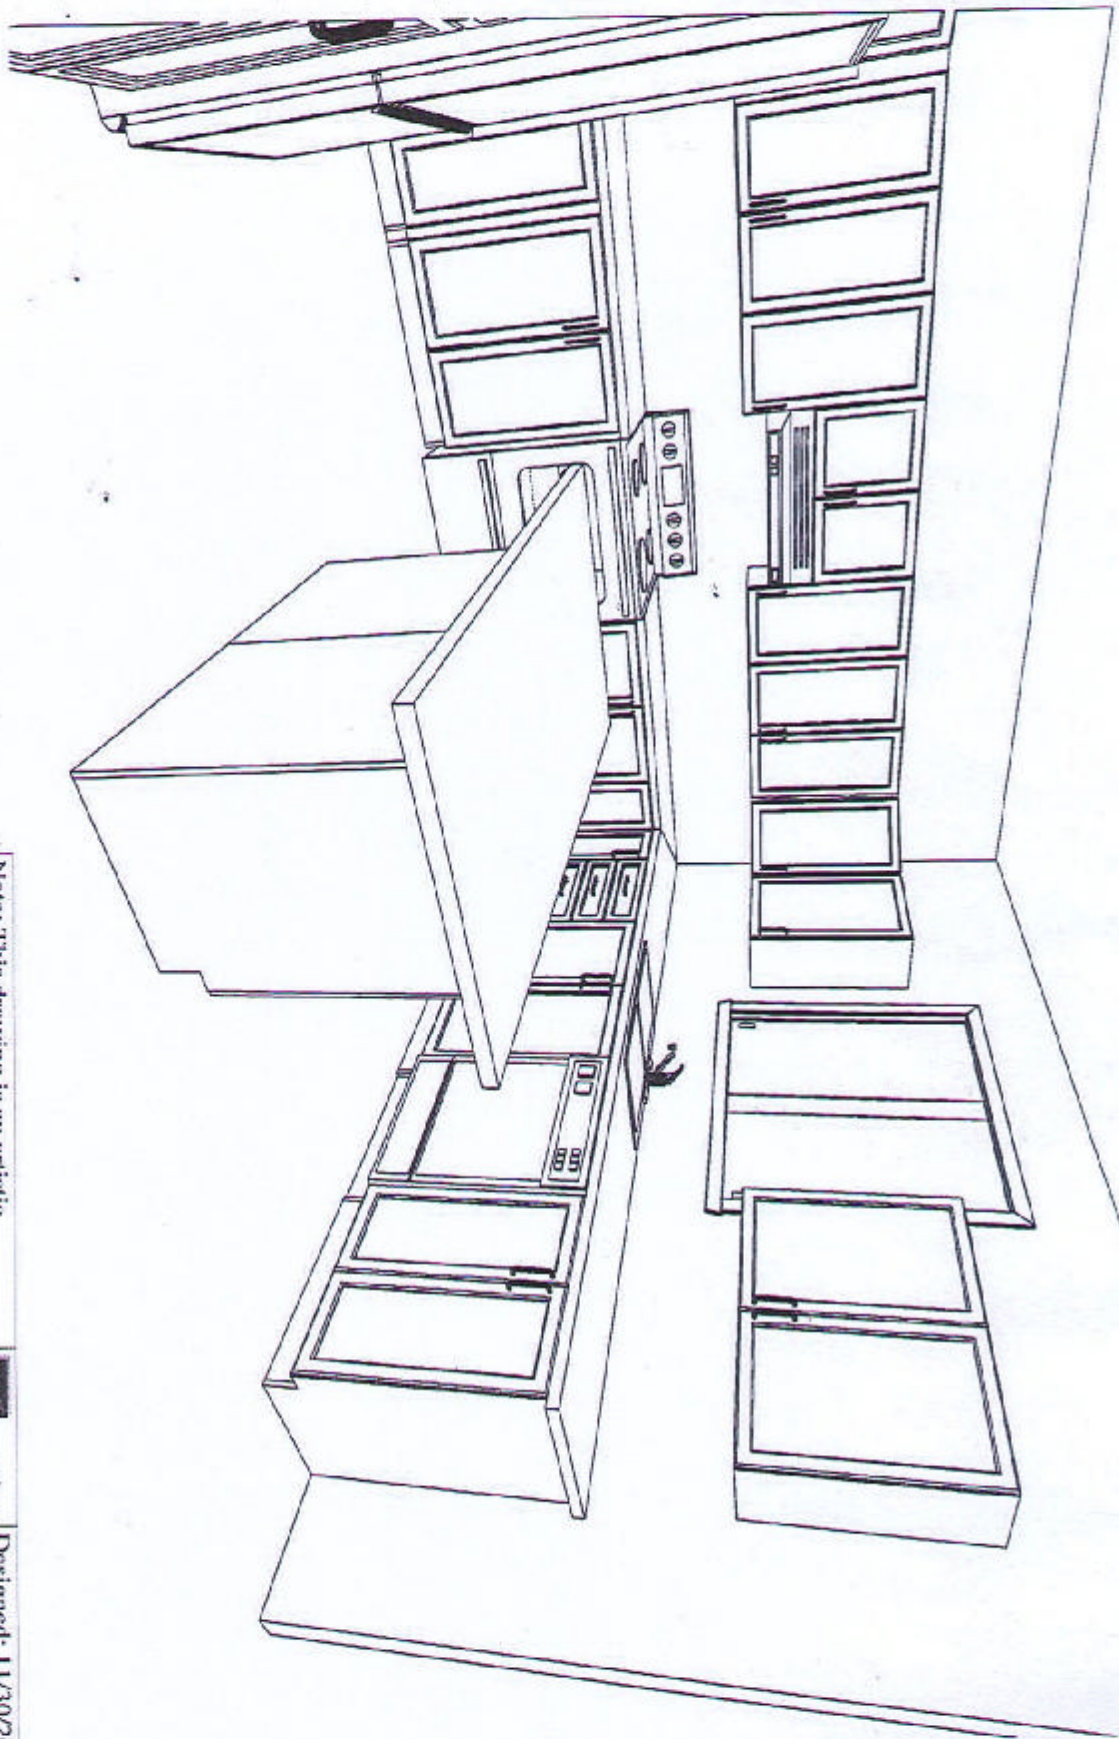

Note: This drawing is an artistic interpretation of the general appearance of the design. It is not meant to be an exact rendition.

DRAWN BY: Lori Di Saverio, B.I.D.
CARTIER KITCHENS OTTAWA
DCR - PALTINA (512) - LEFT




Designed: 11/30/2008
Printed: 6/26/2011

All

Drawing #: 1

DS
RH

DS
EH

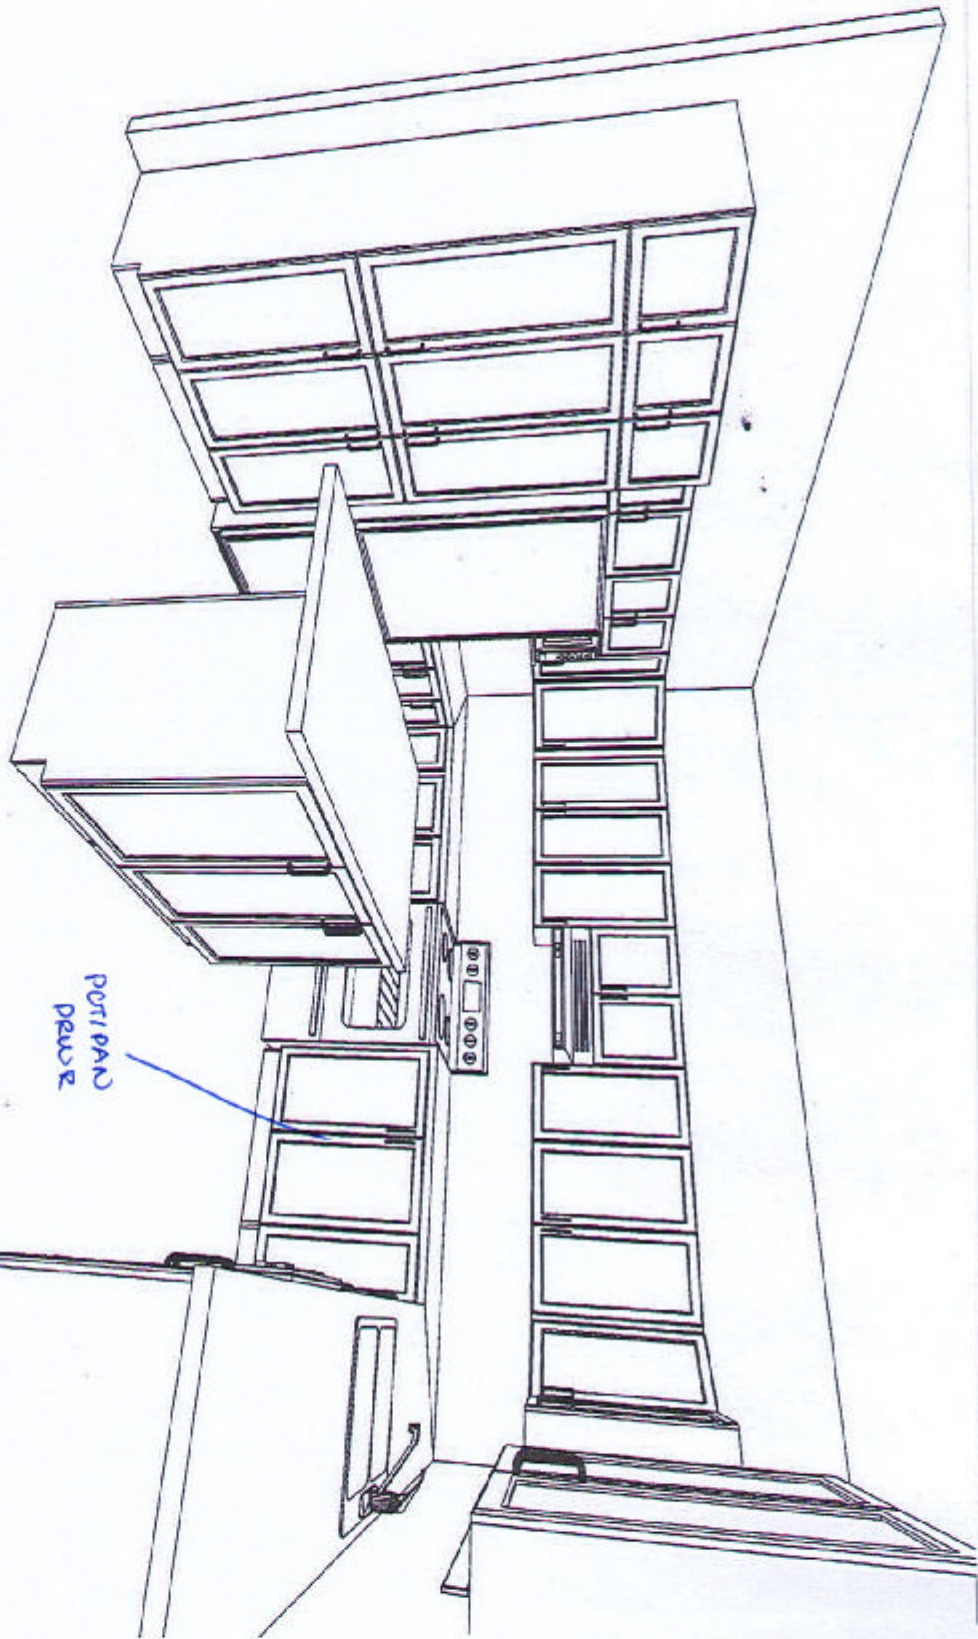


Note: This drawing is an artistic interpretation of the general appearance of the design. It is not meant to be an exact rendition.

DRAWN BY: Lori Di Saverio, B.I.D.
CARTIER KITCHENS OTTAWA

DCR - PALTINA (512) - LEFT



TECHNOLOGIES

Designed: 11/30/2008
Printed: 6/26/2011

All


Drawing #: 1


DS

RH

DS

EH

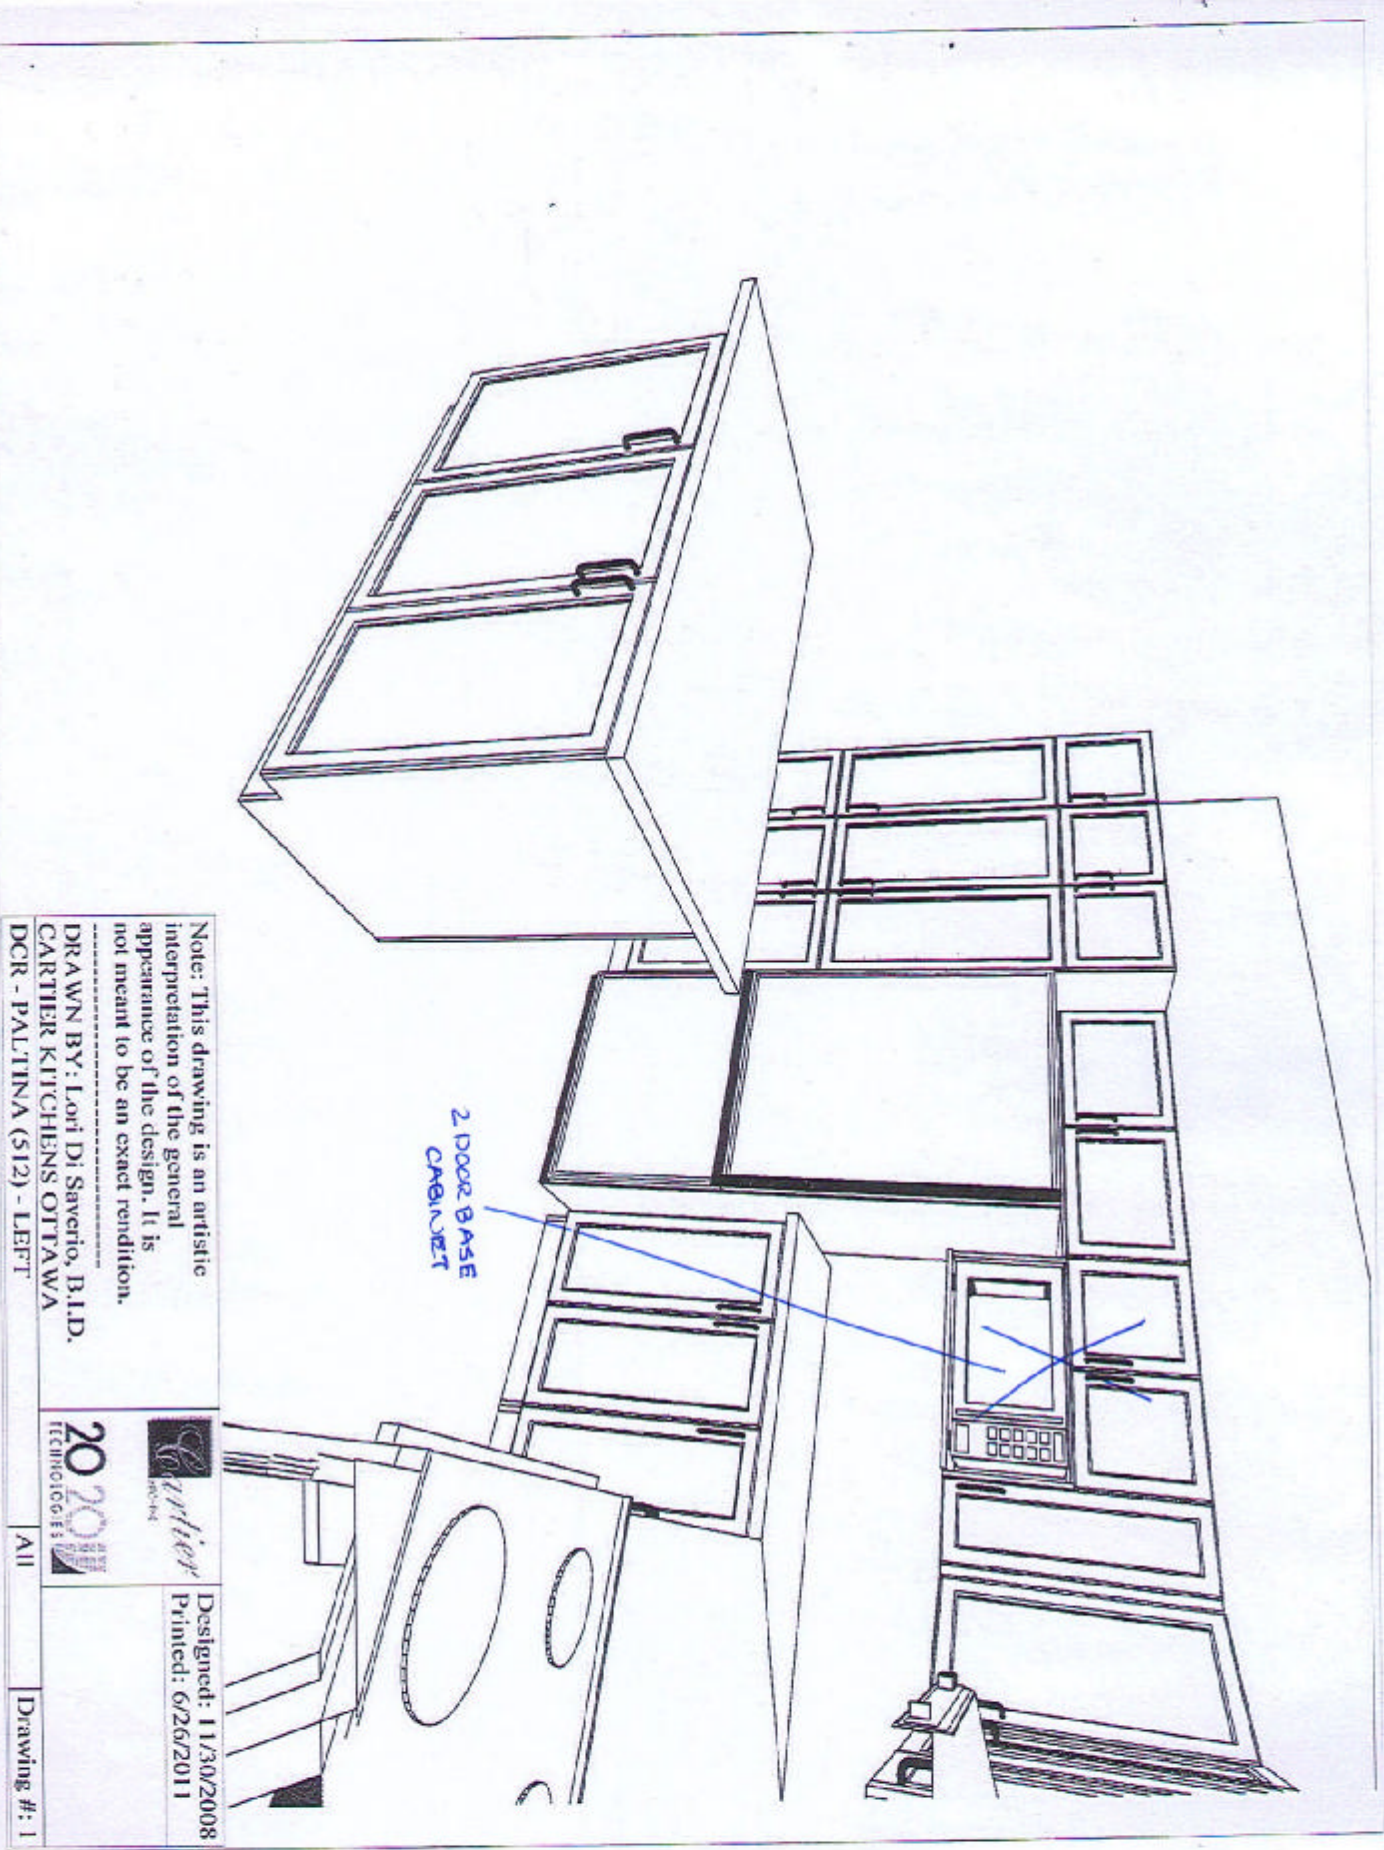

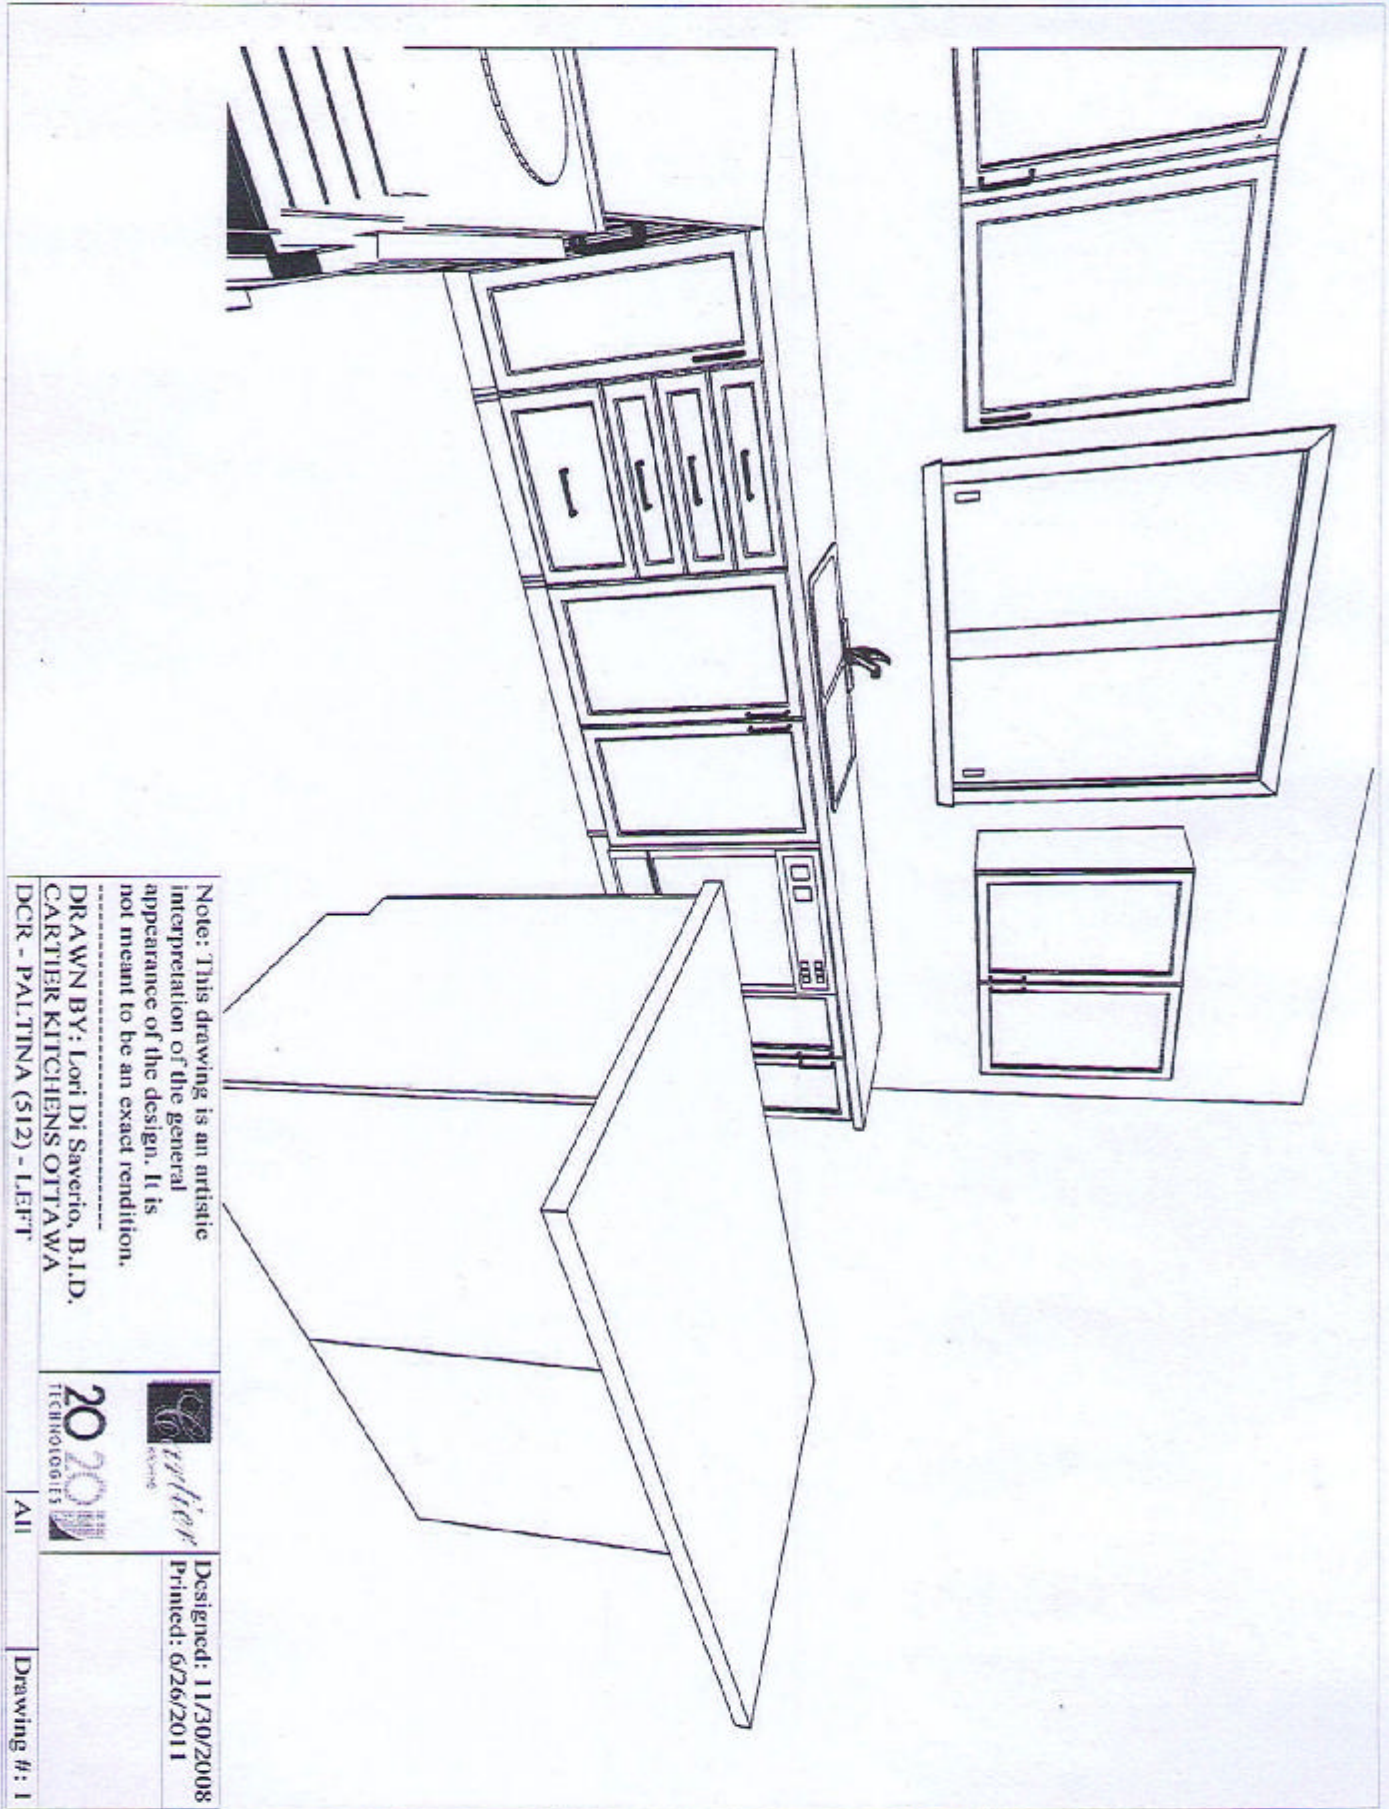

Note: This drawing is an artistic interpretation of the general appearance of the design. It is not meant to be an exact rendition.

DRAWN BY: Lori Di Saverio, B.I.D.
CARTIER KITCHENS OTTAWA
DCR - PALTINA (512) - LEFT



2020
TECHNOLOGIES

Designed: 11/30/2008
Printed: 6/26/2011

All

Drawing #: 1


DS
RH

DS
EH


DCR PHOENIX HOMES

PLATINA (512)
VANITIES


LINE -
HARDWARE -
STD WHITE INTERIORS
METAL DRWR BOX
5/8" KICK

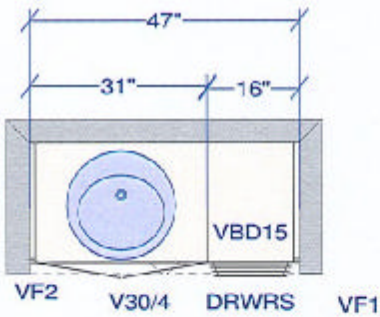

2ND. ENSUITE

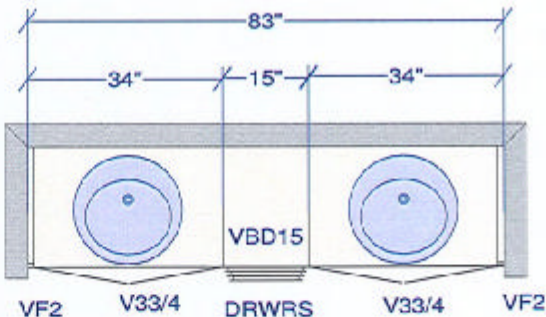

MAIN (SHARED BATH)

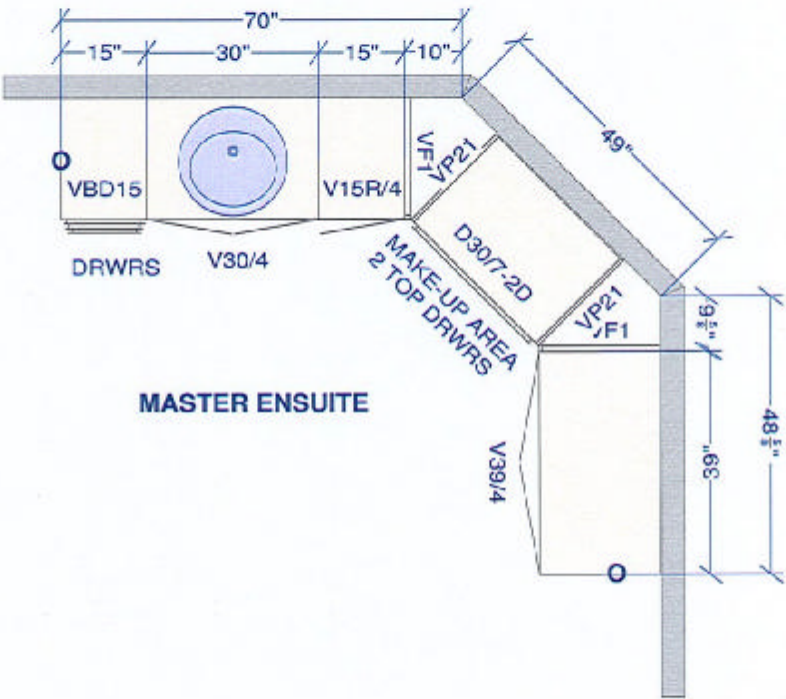

MASTER ENSUITE

All dimensions and size designations given are subject to verification on job site and adjustment to fit job conditions.

SPECTRUM KITCHEN and BATH DESIGN



This is an original design and must not be released or copied unless applicable fee has been paid or job order placed.

DRAWN BY: LORI DISAVERIO, B.I.D

Designed: 2017-01-10
Printed: 2017-02-27

DCR PHOENIX - PLATINA (512) VANITIES.kit

All

Drawing #: 1 No Scale.

DS
RH

DS
EH