


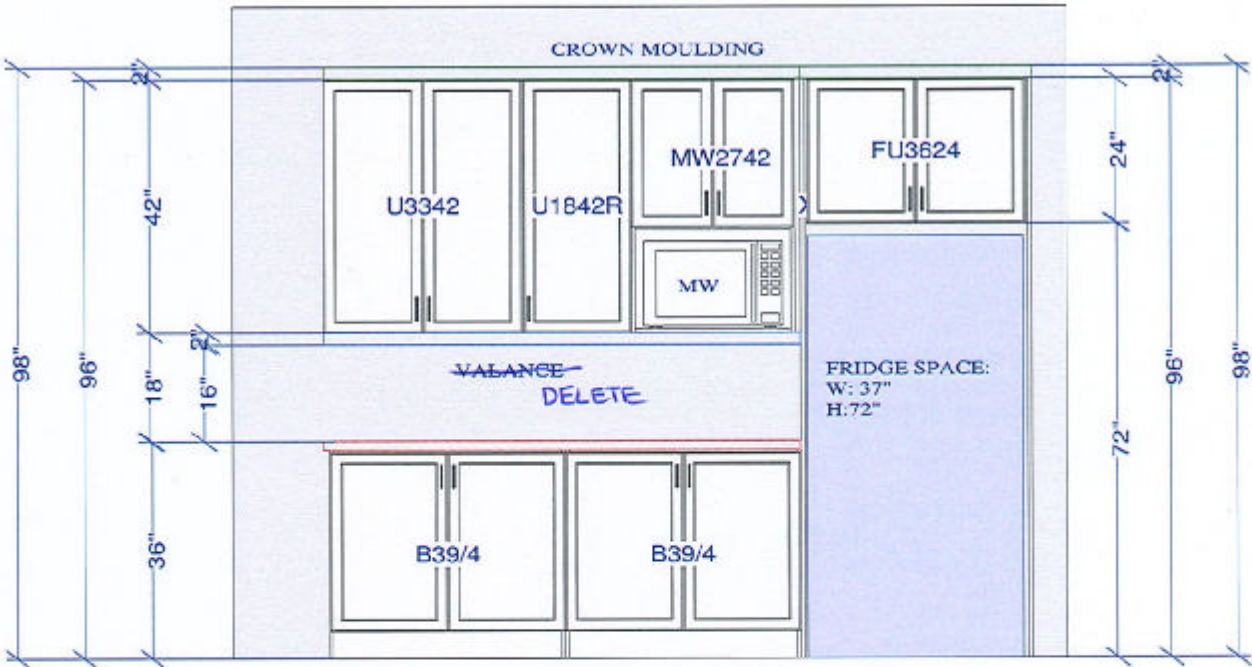

FRIDGE WALL ELEVATION

CUSTOMER APPROVAL
I have reviewed these drawings and understand the details of the design and the CARTIER KITCHENS specifications.
Signature: _____
Date: _____


All dimensions and size designations given are subject to verification on job site and adjustment to fit job conditions.



This is an original design and must not be released or copied unless applicable fee has been paid or job order placed.

Designed: 2022-05-23
Printed: 2022-05-23

DS DS
ET IT

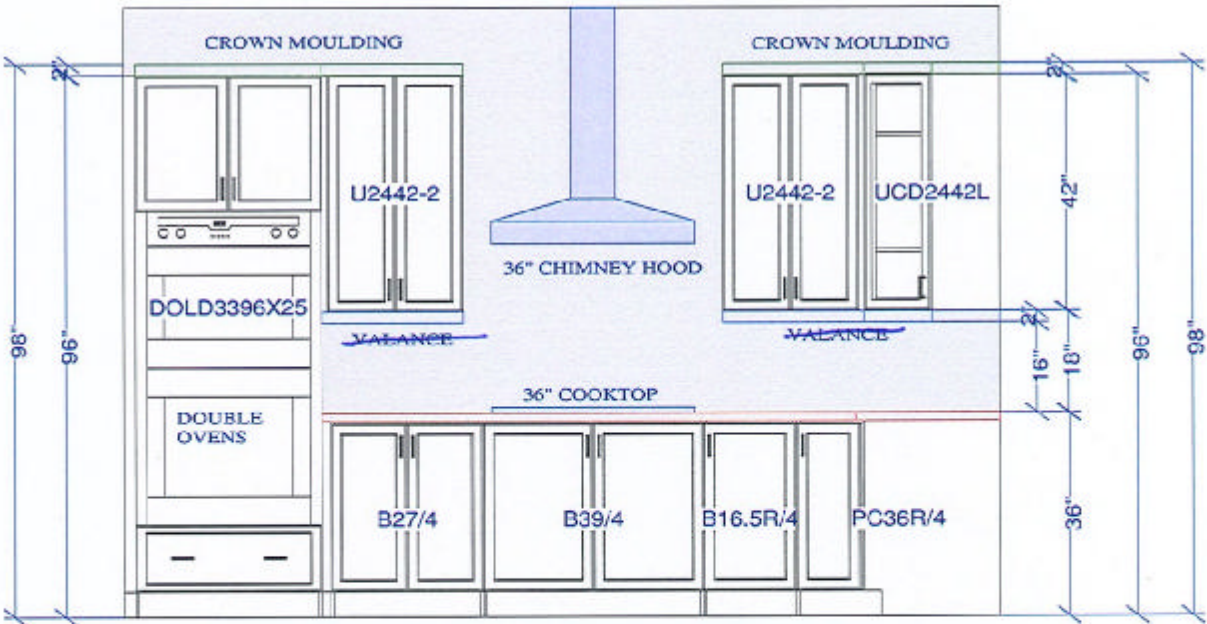

OVEN / COOKTOP WALL ELEVATION

CUSTOMER APPROVAL


Signature: _____

Date: _____

All dimensions and size designations given are subject to verification on job site and adjustment to fit job conditions.




This is an original design and must not be released or copied unless applicable fee has been paid or job order placed.

Designed: 2022-05-23
Printed: 2022-05-23

DS
ET

DS
AT

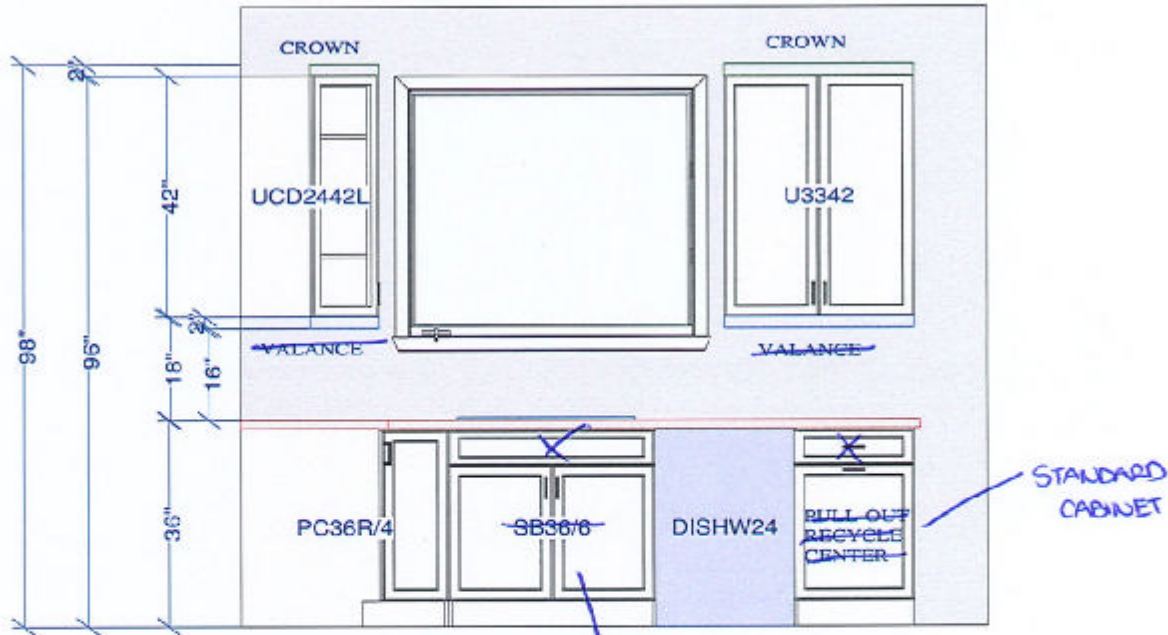

SINK WALL ELEVATION

CUSTOMER APPROVAL
I have reviewed these drawings and understand the details of the design and the CARTER KITCHENS specifications.
Signature _____
Date _____


All dimensions and size designations given are subject to verification on job site and adjustment to fit job conditions.



This is an original design and must not be released or copied unless applicable fee has been paid or job order placed.

Designed: 2022-05-23
Printed: 2022-05-23

DS
ET
DS
AT

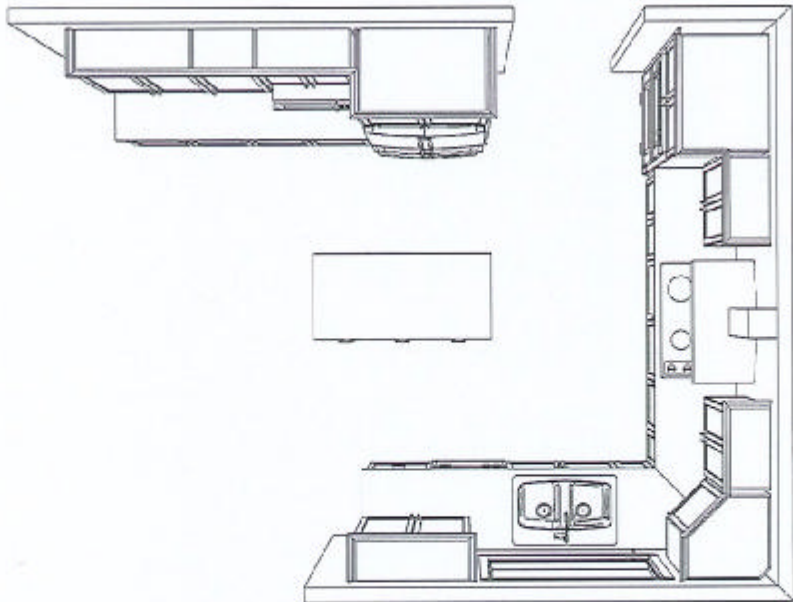

KITCHEN - TOP VIEW

CUSTOMER APPROVAL

I have reviewed these drawings and understand the details of the design and the CARTIER KITCHENS specifications.

Signature _____

Date _____


Note: This drawing is an artistic interpretation of the general appearance of the design. It is not meant to be an exact rendition.		Designed: 2022-05-23
		Printed: 2022-05-23
DCR #3-158 White Tail Ridge 3 - Kitchen.kit	All	Drawing #: 1

DS

et

DS

at

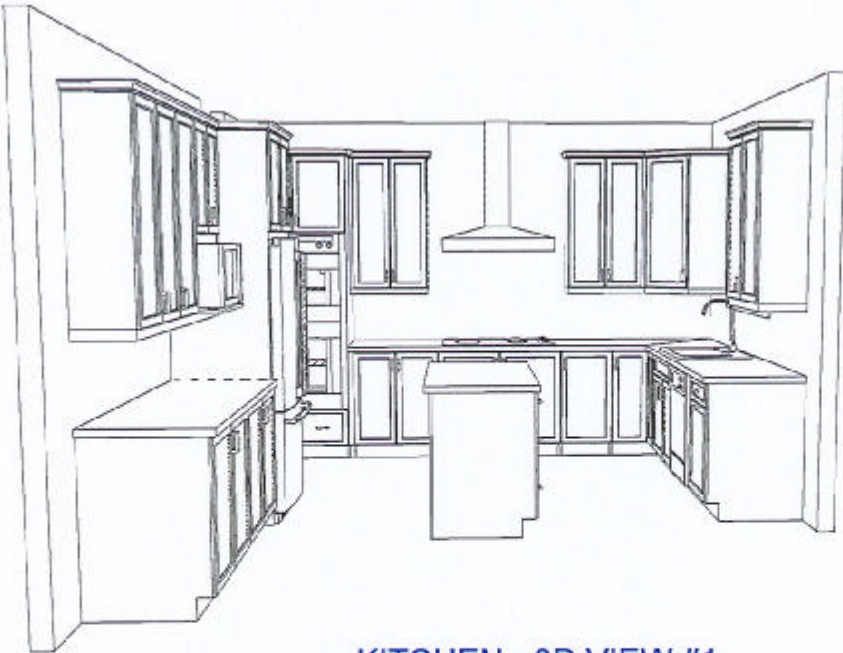

KITCHEN - 3D VIEW #1

CUSTOMER APPROVAL

I have reviewed these drawings and understand the details of the design and the CARTIER KITCHENS specifications.

Signature _____

Date _____

Note: This drawing is an artistic interpretation of the general appearance of the design. It is not meant to be an exact rendition.




Designed: 2022-05-23
Printed: 2022-05-23

DCR #3-158 White Tail Ridge 3 - Kitchen.kit

All

Drawing #: 1

DS DS
ET AT

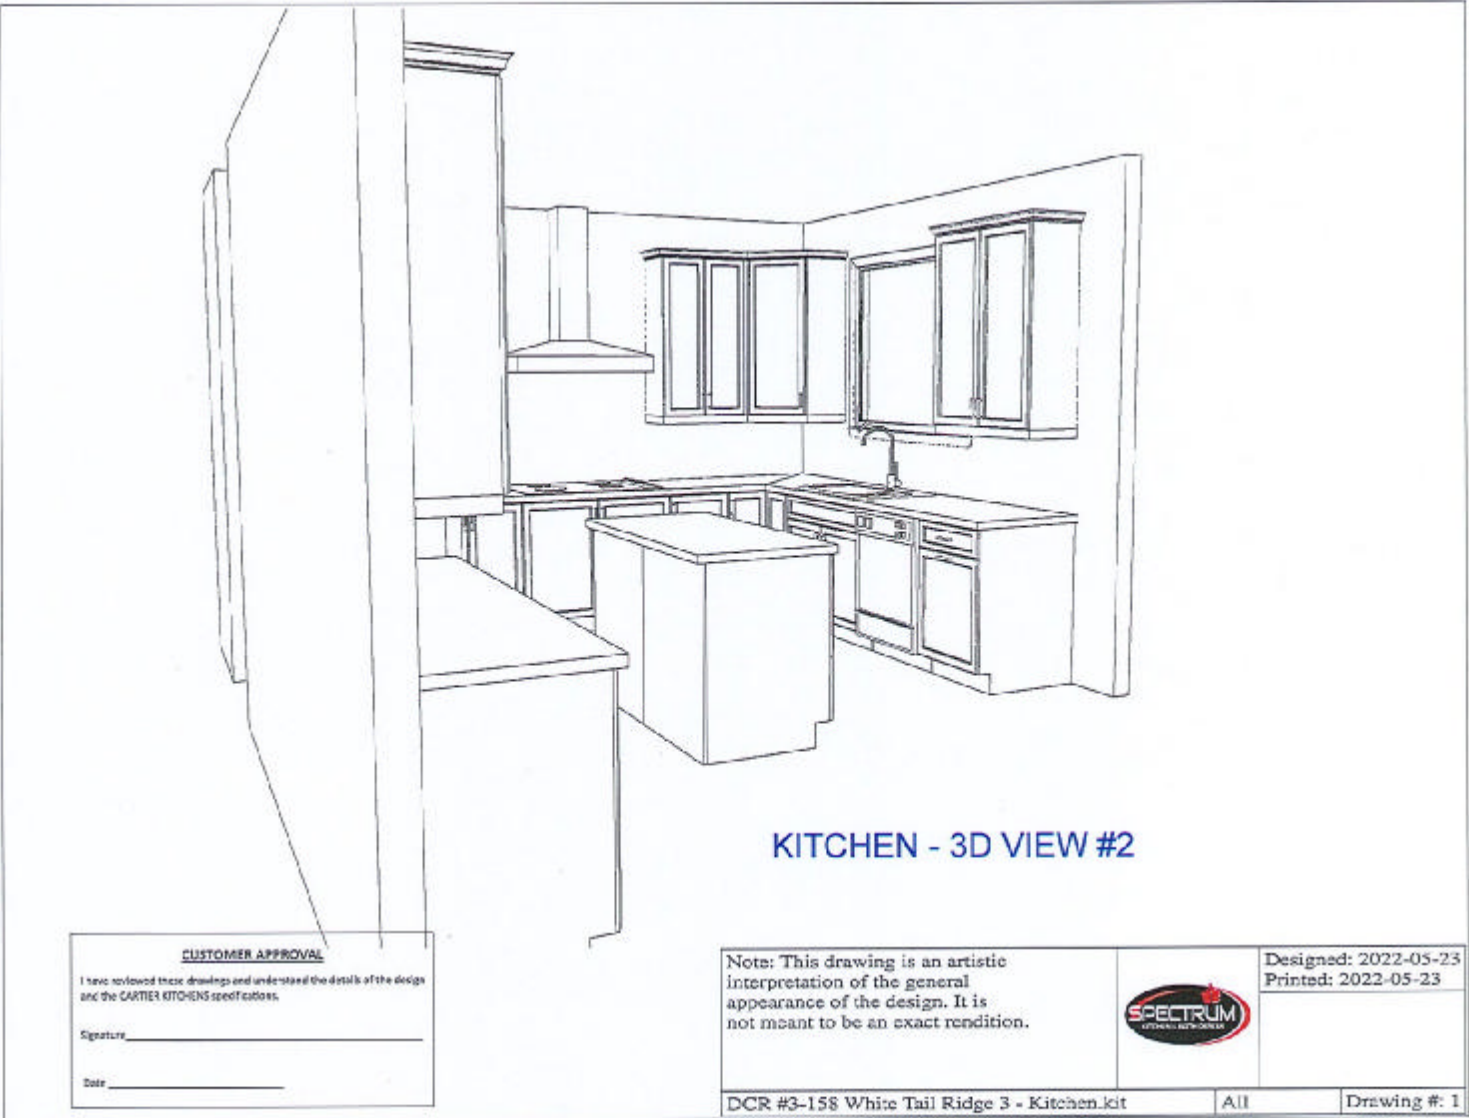

KITCHEN - 3D VIEW #2

CUSTOMER APPROVAL	
I have reviewed these drawings and understand the details of the design and the CARTIER KITCHENS specifications.	
Signature _____	
Date _____	


Note: This drawing is an artistic interpretation of the general appearance of the design. It is not meant to be an exact rendition.		Designed: 2022-05-23
		Printed: 2022-05-23
DCR #3-158 White Tail Ridge 3 - Kitchen.kit	All	Drawing #: 1

DS

et

DS

lt

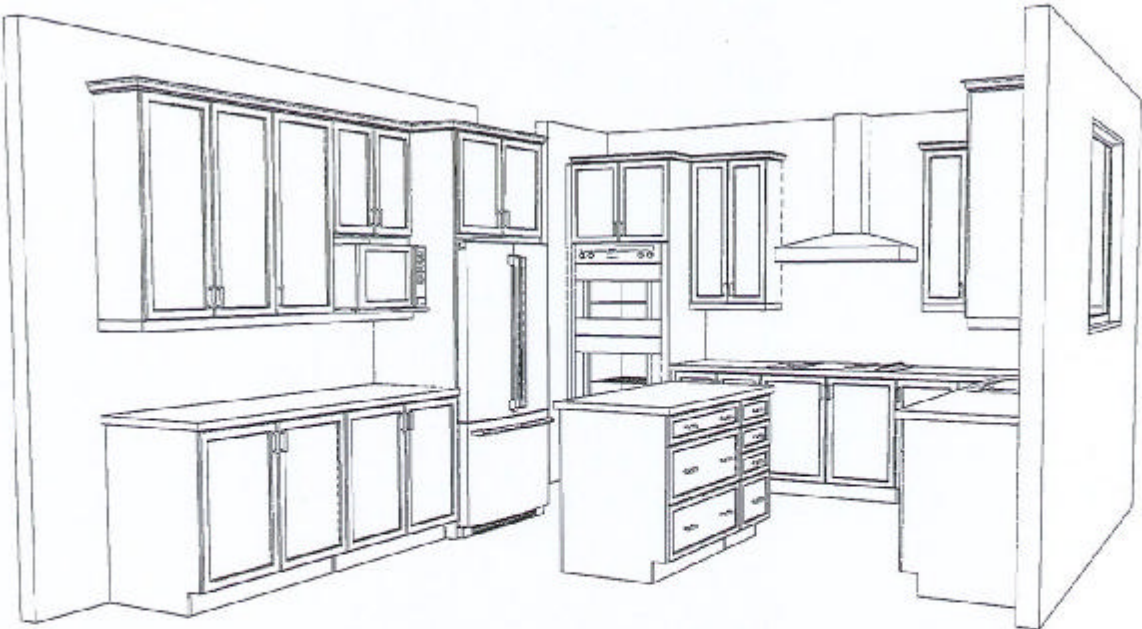

KITCHEN - 3D VIEW #3

CUSTOMER APPROVAL	
I have reviewed these drawings and understand the details of the design and the CARTIER KITCHENS specifications.	
Signature _____	
Date _____	

Note: This drawing is an artistic interpretation of the general appearance of the design. It is not meant to be an exact rendition.		Digned: 2022-05-23
		Printed: 2022-05-23
DCR #3-158 White Tail Ridge 3 - Kitchen.kit	All	Drawing #: 1

DS

et

DS

lt