

CONSTRUCTION NOTES

ALL CONSTRUCTION TO ADHERE TO THESE PLANS AND SPEC'S AND TO CONFORM TO THE ONTARIO BUILDING CODE AND ALL OTHER APPLICABLE CODES AND AUTHORITIES HAVING JURISDICTION. THESE REQUIREMENTS ARE TO BE TAKEN AS MINIMUM SPECIFICATIONS. ONT. REG. 332/12

1. **ROOF CONSTRUCTION**  
NO.210 (10.25kg/m2) ASPHALT SHINGLES, 11.1mm (7/16") ASPENITE SHEATHING WITH "H" CLIPS. APPROVED WOOD TRUSSES @ 600mm (24") O.C. MAX. APPROVED EAVES PROTECTION TO EXTEND 900mm (3'-0") FROM EDGE OF ROOF AND MIN. 300mm (12") BEYOND INNER FACE OF EXTERIOR WALL. (EAVES PROTECTION NOT REQ'D. FOR ROOF 8:12 OR GREATER) 38x89 (2"x4") TRUSS BRACING @ 1830mm (6'-0") O.C. AT BOTTOM CHORD. PREFIN. ALUM. EAVESTROUGH, FASCIA, RWL & VENTED SOFFIT. ATTIC VENTILATION 1:300 OF INSULATED CEILING AREA WITH 25% AT EAVES. AND 25% AT RIDGE (OBC 9.19.1.2)

2. **FRAME WALL CONSTRUCTION (2"x6")**  
SIDING AS PER ELEVATION, APPROVED AIR BARRIER 11.1mm (7/16") EXTERIOR TYPE SHEATHING, 38x140 (2"x6") STUDS @ 400mm (16") O.C., RSI 3.87 (R22) INSULATION AND APPROVED VAPOUR BARRIER AND APPROVED CONT. AIR BARRIER, 13mm (1/2") INT. DRYWALL FINISH. SIDING TO BE MIN. 200mm (8") ABOVE FIN. GRADE

2A. **FRAME WALL CONSTRUCTION (2"x4")**  
SIDING AS PER ELEVATION, APPROVED AIR BARRIER RSI 0.9 (R5) EXTERIOR RIGID INSULATION BOARD 38x89 (2"x4") STUDS @ 400mm (16") O.C., WITH APPROVED DIAGONAL WALL BRACING, RSI 3.35 (R19) INSULATION AND APPROVED VAPOUR BARRIER AND APPROVED CONT. AIR BARRIER, 13mm (1/2") INT. DRYWALL FINISH. SIDING TO BE MIN. 200mm (8") ABOVE FIN. GRADE

3. **BRICK VENEER CONSTRUCTION (2"x6")**  
90mm (4") FACE BRICK 25mm (1") AIR SPACE, 22x180x0.76mm (7/8"x7"x0.03") GALV. METAL TIES @ 400mm (16") O.C. HORIZONTAL 600mm (24") O.C. VERTICAL. APPROVED AIR BARRIER 11.1mm (7/16") EXTERIOR TYPE SHEATHING, 38x140 (2"x6") STUDS @ 400mm (16") O.C., RSI 3.87 (R22) INSULATION AND APPROVED VAPOUR BARRIER WITH APPROVED CONTIN. AIR BARRIER. 13mm (1/2") INT. DRYWALL FINISH. PROVIDE WEEP HOLES @ 800mm (32") O.C. BOTTOM COURSE AND OVER OPENINGS. PROVIDE THRU-WALL FLASHING UP MIN. 150mm (6") BEHIND BUILDING PAPER. BRICK TO BE MIN. 150mm (6") ABOVE FINISH GRADE.

3A. **BRICK VENEER CONSTRUCTION (2"x4")** 90mm (4") FACE BRICK 25mm (1") AIR SPACE, 22x180x0.76mm (7/8"x7"x0.03") GALV. METAL TIES @ 400mm (16") O.C. HORIZONTAL 600mm (24") O.C. VERTICAL. APPROVED AIR BARRIER RSI 0.9 (R5) EXT. RIGID INSUL. BD., 38x89 (2"x4") STUDS @ 400mm (16") O.C. WITH APPROVED DIAGONAL WALL BRACING, RSI 3.35(R19) INSULATION AND APPROVED VAPOUR BARRIER WITH APPROVED CONT. AIR BARRIER, 13mm (1/2") INT. DRYWALL FINISH. PROVIDE WEEP HOLES @ 800mm (32") O.C. BOTTOM COURSE AND OVER OPENINGS. PROVIDE THRU-WALL FLASHING UP MIN. 150mm (6") BEHIND BUILDING PAPER. BRICK TO BE MIN. 150MM(6") ABOVE FINISH GRADE.

4. **INTERIOR STUD PARTITIONS** FOR BEARING PARTITIONS 38x89 (2"x4") @ 400mm (16") O.C. FOR 2 STOREYS AND 300mm (12") O.C. FOR 3 STOREYS, NON-BEARING PARTITIONS 38x89 (2"x4") @ 600mm (24") O.C. PROVIDE 38x89 (2"x4") BOTTOM PLATE AND 2/38x89 (2/2"x4") TOP PLATE. 13mm (1/2") INT. DRYWALL BOTH SIDES OF STUDS, PROVIDE 38x140 (2"x6") STUDS/PLATES WHERE NOTED.

5. **FOUNDATION WALL/FOOTINGS: -SEE OBC 9.15.3, 9.15.4** 200mm (8") POURED CONC. FDTN. WALL 20MPa (c/w 2-15M REBAR TOP & BOTTOM) WITH BITUMENOUS DAMPPROOFING AND OPT. DRAINAGE LAYER. DRAINAGE LAYER REQ. WHEN BASEMENT INSUL. EXTENDS 900 (2'-11") BELOW FIN. GRADE. MAXIMUM POUR HEIGHT 2390 (7'-10") ON 500x155 (20"x6") CONTINUOUS KEYED CONC. FTG. BRACE FDTN. WALL PRIOR TO BACKFILLING. ALL FOOTINGS SHALL REST ON NATURAL UNDISTURBED SOIL OR COMPACTED ENGINEERED FILL, WITH MIN. BEARING CAPACITY OF 100kPa OR GREATER. IF SOIL BEARING DOES NOT MEET MIN. CAPACITY, ENGINEERED FOOTINGS ARE REQUIRED. MAX. FLOOR LIVE LOAD OF 2.4kpa(50psf) PER FLOOR, AND MAX. LENGTH OF SUPPORTED JOISTS IS 4.9m (16'-1"). REFER TO SOILS REPORT FOR SOILS CONDITIONS AND BEARING CAPACITY.

6. 100mm (4") DIA. WEEP TILE 150mm (6") CRUSHED STONE OVER AND AROUND WEEPING TILES.

7. **BASEMENT SLAB** OBC. 9.3.1.6.(1)(b) & 9.16.4.5.(1) 80mm (3")MIN. 25MPa (3600psi) CONC. SLAB ON 100mm (4") COARSE GRANULAR FILL, OR 15MPa. (2200psi) CONC. WITH DAMPPROOFING BELOW SLAB.

8. **EXPOSED FLOOR TO EXTERIOR** PROVIDE RSI 5.46 (R31) INSULATION, APPROVED VAPOUR BARRIER AND CONTINUOUS AIR BARRIER, FINISHED SOFFIT.

9. OBC. 12.3.2.1 & 12.3.3.7 **ATTIC INSULATION** RSI 8.81 (R60) BLOWN IN ROOF INSULATION AND APPROVED VAPOUR BARRIER, 13mm (1/2") INT. DRYWALL FINISH OR APPROVED EQUAL.

10. **STAIRS, STEPS, HANDRAILS -OBC. 9.8.-**  
-9.8.2.1(1) STAIR WIDTH MEASURED BETWEEN WALL FACES OR GUARDS SHALL BE NOT LESS THAN 900mm (35 1/8")  
-9.8.2.2(3) CLEAR HEIGHT OVER STAIRS SHALL NOT BE LESS THAN 1950mm (76 3/4")  
-9.8.4 STEP DIMENSIONS (TABLE 9.8.4.1)  

| STAIR COMPONENT | MINIMUM         | MAXIMUM        |
|-----------------|-----------------|----------------|
| RISE            | 125mm (4 1/8")  | 200mm (7 7/8") |
| RUN             | 255mm (10 1/8") | 355mm (14")    |

  
-9.8.4.4 UNIFORMITY & TOLERANCES FOR RISERS & TREADS  
-BETWEEN ADJACENT TREADS & LANDINGS = 5mm  
-BETWEEN TALLEST & SHORTEST RISER IN FLIGHT=10mm  
-9.8.4.6(1)(b) MAX. NOSING 25mm (1")  
-9.8.7.5(1)(b) CLEARANCE BETWEEN HANDRAIL AND SURFACE BEHIND IT TO BE MIN. 50mm (1 1/8")  
-9.8.7.6(1) HANDRAILS SHALL NOT PROJECT MORE THAN 100mm (3 1/8") INTO REQUIRED WIDTH OF STAIR <SEE 9.8.2.1(1)>

11. **GUARDS -OBC. 9.8.8.3.-**  
(1) EXT. GUARDS HEIGHT: =1070mm (42 5/8") MIN.  
(2) INT. GUARDS HEIGHT: =900mm (35 1/8") MIN.  
(1) STAIR LANDING GUARDS: =1070mm (42 5/8") MIN.  
-9.8.8.5(1) MAX. OPENINGS THROUGH GUARDS =100mm (3 1/8")

12. 38x89 (2"x4") SILL PLATE WITH 13mm (1/2") DIA. ANCHOR BOLTS 200mm (8") LONG, EMBEDDED MIN. 100mm (4") INTO CONC. @ 2400mm (7'-10") O.C. USE NON-SHRINK GROUT TO LEVEL SILL PLATE WHEN REQUIRED. (SEE OBC. 9.23.7)

13. -R12 (3 3/4") CONTINUOUS BATT INSULATION. 2"x4" STUD WALL PLACED 3/4" AWAY FROM WALL. FILL STUD CAVITY WITH R10 BATT INSULATION. APPROVED VB TO 8" ABOVE FLOOR LEVEL.  
OR  
-APPROVED BLANKET INSULATION (R20) MECHANICALLY SECURED TO CONCRETE FOUNDATION WALL WITH 100mm HILTI PINS (COMES WITH PLASTIC WASHER)

DAMPPROOF WITH BUILDING PAPER BETWEEN THE FOUNDATION WALL AND INSULATION UP TO GRADE LEVEL.

(SEE DETAIL ON "SB-12 DETAILS" PAGE)

14. **BEARING STUD PARTITION**  
38x89 (2"x4") STUDS @ 400mm (16") O.C. 38x89 (2"x4") SILL PLATE ON DAMPPROOFING MATERIAL, 13mm (1/2") DIA. ANCHOR BOLTS 200mm (8") LONG, EMBEDDED MIN. 100mm (4") INTO CONC. @ 2400mm (7'-10") O.C. 100mm (4") HIGH CONC. CURB ON 350x155 (14"x6") CONC. FOOTING. ADD HORIZ. BLOCKING AT MID-HEIGHT IF WALL IS UNFINISHED.

15. **STEEL BASEMENT COLUMN (SEE O.B.C. 9.17.3.1, 9.17.3.4)**  
75mm (3") DIA. ADJUSTABLE STL. COL. CONFORMING TO CAN/CGSB-7.2M, AND WITH 150x150x9.5 (6"x6"x3/8") STL. PLATE TOP & BOTTOM. 910x910x300 (36"x36"x12") CONC. FOOTING ON UNDISTURBED SOIL OR ENGINEERED FILL CAPABLE OF SUSTAINING A PRESSURE OF 100 Kpa. MINIMUM AND AS PER SOILS REPORT.

15A. **STEEL BASEMENT COLUMN (SEE O.B.C. 9.17.3.1, 9.17.3.4)**  
3"x3"x(188) NON-ADJUSTABLE STL. COL. WITH 150x150x9.5 (6"x6"x3/8") STL. TOP & BOTTOM PLATE ON 910x910x300 (36"x36"x12"). CONC. FOOTING ON UNDISTURBED SOIL OR ENGINEERED FILL CAPABLE OF SUSTAINING A PRESSURE OF 100 Kpa. MIN. AND AS PER SOILS REPORT.

15B. **STEEL COLUMN (SEE OBC. 9.17.3.1, 9.17.3.4)** 3"x3"x(188) NON-ADJUSTABLE STL. COL. TO BE ON 150x150x9.5 (6"x6"x3/8") STEEL TOP PLATE, & BOTTOM PLATE. BASE PLATE 120x250x12.5 (4 1/2"x10"x1/2") WITH 2-12mm DIA. x 300mm LONG x50mm HOOK ANCHORS (2-1/2"x12"x2") FIELD WELD COL. TO BASE PLATE.

15C. **STEEL COLUMN (SEE OBC. 9.17.3.1, 9.17.3.4)** 90mm(3-1/2") DIA.x4.78mm(188) NON-ADJUSTABLE STL. COL. TO BE ON 150x150x9.5 (6"x6"x3/8") STEEL TOP PLATE, & BOTTOM PLATE. BASE PLATE 120x250x12.5 (4 1/2"x10"x1/2") WITH 2-12mm DIA. x 300mm LONG x50mm HOOK ANCHORS (2-1/2"x12"x2") FIELD WELD COL. TO BASE PLATE.

16. BEAM POCKET OR 300x150 (12"x6") POURED CONC. NIB WALLS. MIN. BEARING 90mm (3-1/2")

17. 19x64 (1"x3") CONTINUOUS WD. STRAPPING BOTH SIDES OF STEEL BEAM.

18. **GARAGE SLAB:** 100mm (4") 32MPa (4640psi) CONC. SLAB WITH 5-8% AIR ENTRAINMENT ON OPT. 100 (4") COARSE GRANULAR FILL WITH COMPACTED SUB-BASE OR COMPACTED NATIVE FILL SLOPE TO FRONT AT 1% MIN.

19. 13mm (1/2") GYPSUM BD. ON WALL AND CEILING BETWEEN HOUSE AND GARAGE, RSI 3.87 (R22) IN WALLS, RSI 5.46 (R31) IN CEILING. PROVIDE APPROVED AIR BARRIER. TAPE AND SEAL ALL JOINTS AIR TIGHT.

20. DOOR AND FRAME GASPROOFED. DOOR EQUIPPED WITH SELF CLOSING DEVICE AND WEATHERSTRIPPING. PER OBC 9.10.13.15

21. WOOD STEP, C/W HANDRAIL & LANDING IF MORE THAN 3 RISERS, MAX.RISE 200mm (7-7/8") MIN.TREAD 250mm (9-1/2") SEE OBC 9.8.9.2, 9.8.9.3 & 9.8.10

22. CAPPED DRYER EXHAUST VENTED TO EXTERIOR. (USE 100mm(4") DIA. SMOOTH WALL VENT PIPE) OBC 6.2.3.8.(7)

23. ATTIC ACCESS HATCH 545x610 (21.5"x24") WITH A MIN. AREA OF 3.44 SF WITH WEATHERSTRIPPING RSI 7.0 (R40) RIGID INSUL. BACKING OBC 9.19.2

24. **FIREPLACE CHIMNEYS -OBC. 9.21.-** TOP OF FIREPLACE CHIMNEY SHALL BE 915mm (3'-0") ABOVE THE HIGHEST POINT AT WHICH IT COMES IN CONTACT WITH THE ROOF AND 610mm (2'-0") ABOVE THE ROOF SURFACE WITHIN A HORIZ. DISTANCE OF 3050mm (10'-0") FROM THE CHIMNEY.

25. LINEN CLOSET, 4 SHELVES MIN. 350mm (14") DEEP.

26. MECHANICAL EXHAUST FAN, VENTED TO EXTERIOR, TO PROVIDE AT LEAST ONE AIR CHANGE PER HOUR.

27. **STEEL BEARING PLATE FOR MASONRY WALLS** 280x280x16 (11"x11"x5/8") STL. PLATE FOR STL BEAMS AND 280x280x12 (11"x11"x1/2") STL. PLATE FOR WOOD BEAMS BEARING ON CONC. BLOCK PARTYWALL, ANCHORED WITH 2-19mm (3/4") x 200mm (8") LONG GALV. ANCHORS WITHIN SOLID BLOCK COURSE. LEVEL WITH NON-SHRINK GROUT.

OR

**SOLID WOOD BEARING FOR WOOD STUD WALLS** SOLID BEARING TO BE AT LEAST AS WIDE AS THE SUPPORTED MEMBER. SOLID WOOD BEARING COMPRISED OF BUILT-UP WOOD STUDS TO BE CONSTRUCTED IN ACCORDANCE WITH OBC. 9.17.4.2 (2).

28. U.L.C. RATED CLASS "B" VENT 610mm (2'-6") ABOVE THE POINT IN CONTACT WITH THE ROOF FOR SLOPES UP TO 9/12, REFER TO THE ONTARIO GAS UTILIZATION CODE.

29. 3-38x140 (3-2"x6") BUILT-UP-POST ON METAL BASE SHOE ANCHORED TO CONC. WITH 12.7 DIA. BOLT, 610x610x254 (24"x24"x10") CONC. FTG. OBC 9.17.4

30. STEP FOOTINGS: MIN. HORIZ. STEP = 600mm (23-5/8"). MAX. VERT. STEP = 600mm (23-5/8") FOR FIRM SOILS.

31. PORCH SLAB/STEPS: 130 mm (5") MIN. CONC. 32 MPa SLAB AIR ENTRAINMENT MIN. 5 TO 8% AT 28 DAYS, 10 M BARS @ 250 O/C EACH WAY 10M DOWELS @400 (16") O.C. 2-15m IN THICKENED AREA FROM WALL TO SLAB ALL SIDES (SEE DETAIL)

32. DIRECT VENT FURNACE TERMINAL MIN. 900mm (36") FROM A GAS REGULATOR. MIN. 300mm (12") ABOVE FIN. GRADE, FROM ALL OPENINGS, EXHAUST AND INTAKE VENTS. HRV INTAKE TO BE A MIN. OF 1830mm (6'-0") FROM ALL EXHAUST TERMINALS. REFER TO GAS UTILIZATION CODE.

33. DIRECT VENT GAS FIREPLACE. VENT TO BE A MINIMUM 300mm (12") FROM ANY OPENING AND ABOVE FIN. GRADE. REFER TO GAS UTILIZATION CODE.

34. **SUBFLOOR, JOIST STRAPPING AND BRIDGING** -19mm (3/4") T & G SUBFLOOR ON WOOD FLOOR JOISTS. FOR CERAMIC TILE APPLICATION (\* SEE OBC 9.30.6.1 \*) 6mm (1/4") PANEL TYPE UNDERLAY UNDER RESILIENT & PARQUET FLOORING. (-\* SEE OBC 9.30.2 \*) ALL JOISTS TO BE BRIDGED WITH 38x38 (2"x2") CROSS BRACING OR SOLID BLOCKING @ 2100mm (6'-11") O.C. MAX. ALL JOISTS TO BE STRAPPED WITH 19x64 (1"x3") @ 2100mm (6'-11") O.C. UNLESS A PANEL TYPE CEILING FINISH IS APPLIED. (SEE OBC 9.23.9.4)

35. **EXPOSED BUILDING FACE -OBC. 9.10.14.5-** EXTERIOR WALLS TO HAVE A FIRE RESISTANCE RATING OF NOT LESS THAN 45 min. WHERE LIMITING DISTANCE IS LESS THAN 1.2M (3'-11"). WHERE THE LIMITING DISTANCE IS LESS THAN 600mm (1'-11") THE EXPOSING FACE SHALL BE CLAD IN NON-COMBUSTIBLE MATERIAL.

RESERVED

36. THE FDTN. WALL SHALL NOT BE REDUCED TO LESS THAN 90mm (3 5/8") THICK TO A MAX. DEPTH OF 350mm (13 3/4") AND SHALL BE TIED TO THE FACING MATERIAL WITH METAL TIES SPACED 200mm (8") O.C. VERTICALLY AND 900mm (36") O.C. HORIZONTALLY. FILL SPACE BETWEEN WALL AND FACING SOLID WITH MORTAR. (SEE OBC 9.15.4.7)

38. **CONVENTIONAL ROOF FRAMING** 38x140 (2"x6") RAFTERS @ 400mm (16"O.C.), FOR MAX. 11'-7" SPAN. 38x184 (2"x8") RIDGE BOARD. 38x89 (2"x4") COLLAR TIES AT MIDSPANS. CEILING JOISTS TO BE 38x89 (2"x4") @ 400mm (16") O.C. FOR MAX. 2830mm (9'-3") SPAN & 38x140 (2"x6") @ 400mm (16") O.C. FOR MAX. 4450mm (14'-7") SPAN. RAFTERS FOR BUILT-UP ROOF TO BE 38x89 (2"x4") @ 600mm (24") O.C. WITH A 38x89 (2"x4") CENTRE POST TO THE TRUSS BELOW, Laterally BRACED AT 1800mm (6'-0") O.C. VERTICALLY.

39. **TWO STOREY VOLUME SPACES**  
FOR HIGH WALL UP TO 18'-0": CONSTRUCTION: 2"x6" SPACING AS INDICATED BLOCKING: 3 ROWS @ 4'-6" O/C ± SHEATHING: 7/16" ASPENITE NAILING: 2" STAPLES BET. 4" AND 6" O/C ALONG STUDS

STUD SPACING WITH VARIOUS FINISHES:  
1. SIDING-METAL OR VINYL- 2"x6" @12" O/C  
2. STUCCO -2"x6" @16" O/C  
3. BRICK TO 4'-0" -2"x6" @16" O/C  
4. BRICK FULL HEIGHT -2-2"x6" @12" O/C

40. TYPICAL 1 HOUR RATED PARTYWALL. REFER TO DETAILS FOR TYPE AND SPECIFICATIONS.

WINDOWS:

1. **MINIMUM BEDROOM WINDOW -OBC. 9.9.10.** AT LEAST ONE BEDROOM WINDOW ON A GIVEN FLOOR IS TO HAVE MIN. 0.35m2 UNOBSTRUCTED GLAZED OR OPENABLE AREA WITH MIN. CLEAR WIDTH OF 380 mm (1'-3").
2. **WINDOW GUARDS -OBC. 9.8.8.1.** A GUARD IS REQUIRED WHERE THE TOP OF THE WINDOW SILL IS LOCATED LESS THAN 480mm (1'-7") ABOVE FIN. FLOOR AND THE DISTANCE FROM THE FIN. FLOOR TO THE ADJACENT GRADE IS GREATER THAN 1800mm (5'-11")
3. ALL WINDOWS TO COMPLY WITH THERMAL RESISTANCE REQUIREMENTS STATED IN OBC 12.3.2.6. AND SB12 PRESCRIPTIVE COMPLIANCE PACKAGE, AND OBC 9.5, 9.6, 9.7

GENERAL

1. MECHANICAL VENTILATION IS REQUIRED TO PROVIDE 0.3 AIR CHANGES PER HOUR AVERAGED OVER 24 HOURS. SEE MECHANICAL DRAWINGS.
2. ALL DOWNSPOUTS TO DRAIN AWAY FROM THE BUILDINGAS PER OBC 9.26.18.2 AND MUN. STANDARDS.
3. ALL WINDOW WELLS TO DRAIN TO FOOTING LEVEL PER OBC 9.14.6.3 CHECK WITH LOCAL AUTHORITY.
4. PROVIDE STUD WALL REINFORCEMENT FOR FUTURE GRAB BARS IN BATHROOMS. REINF. OF STUD WALLS SHALL BE INSTALLED ADJACENT TO WATER CLOSETS AND SHOWER OR BATHTUB IN MAIN BATHROOM, SEE OBC 9.5.2.3., 3.8.3.8.(1)(d) & 3.8.3.13.(1)(f).

LUMBER:

1. ALL LUMBER SHALL BE SPRUCE No.2 GRADE, UNLESS NOTED OTHERWISE.
2. STUDS SHALL BE STUD GRADE SPRUCE, UNLESS NOTED OTHERWISE.
3. LUMBER EXPOSED TO THE EXTERIOR TO BE SPRUCE No.2 GRADE PRESSURE TREATED OR CEDAR, UNLESS NOTED OTHERWISE.
4. ALL LAMINATED VENEER LUMBER (L.V.L.) BEAMS, GIRDER TRUSSES, AND METAL HANGER CONNECTIONS SUPPORTING ROOF FRAMING TO BE DESIGNED & CERTIFIED BY TRUSS MANUF.
5. LVL BEAMS SHALL BE 2.0E WS MICRO-LAM LVL (Fb=2800psi.MIN.) OR EQUIVALENT. NAIL EACH PLY OF LVL WITH 89mm (3 1/2") LONG COMMON WIRE NAILS @ 300mm (12") O.C. STAGGERED IN 2 ROWS FOR 184, 240 & 300mm (7 1/4",9 1/2", 11 7/8") DEPTHS AND STAGGERED IN 3 ROWS FOR GREATER DEPTHS AND FOR 4 PLY MEMBERS ADD 13mm (1/2") DIA. GALVANIZED BOLTS BOLTED AT MID-DEPTH OF BEAM @ 915mm (3'-0") O.C.
6. PROVIDE TOP MOUNT BEAM HANGERS TYPE "SCL" MANUFACTURED BY MGA CONNECTOR LTD. Tel. (905) 642-3175 OR EQUAL FOR ALL LVL BEAM TO BEAM CONNECTIONS UNLESS OTHERWISE NOTED.
7. JOIST HANGERS: PROVIDE METAL HANGERS FOR ALL JOISTS AND BUILT-UP WOOD MEMBERS INTERSECTING FLUSH BUILT-UP WOOD MEMBERS.
8. WOOD FRAMING NOT TREATED WITH A WOOD PRESERVATIVE, IN CONTACT WITH CONCRETE, SHALL BE SEPARATED FROM THE CONCRETE BY AT LEAST 2 mil. POLYETHYLENE FILM, No. 50 (45lbs.) ROLL ROOFING OR OTHER DAMPPROOFING MATERIAL, EXCEPT WHERE THE WOOD MEMBER IS ST LEAST 150mm (6") ABOVE THE GROUND.

STEEL:

1. STRUCTURAL STEEL SHALL CONFORM TO CAN/CSA-G40-21 GRADE 300W. HOLLOW STRUCTURAL SECTIONS SHALL CONFORM TO CAN/CSA-G40-21 GRADE 350W CLASS "H".
2. REINFORCING STEEL SHALL CONFORM TO CSA-G30-18M GRADE 400R.

WOOD LINTELS AND BUILT-UP WOOD BEAMS

L1 2/38 x 184 (2/2" x 8") SPR.#2  
B1 3/38 x 184 (3/2" x 8") SPR.#2  
B2 4/38 x 184 (4/2" x 8") SPR.#2

L3 2/38 x 235 (2/2" x 10") SPR.#2  
B3 3/38 x 235 (3/2" x 10") SPR.#2  
B4 4/38 x 235 (4/2" x 10") SPR.#2

L5 2/38 x 286 (2/2" x 12") SPR.#2  
B5 3/38 x 286 (3/2" x 12") SPR.#2  
B6 4/38 x 286 (4/2" x 12") SPR.#2

LAMINATED VENEER LUMBER (LVL) BEAMS

LVL1 2-1 3/4"x7 1/4" (2-45x184)  
LVL2 3-1 3/4"x7 1/4" (3-45x184)  
LVL3 4-1 3/4"x7 1/4" (4-45x184)  
LVL4 2-1 3/4"x9 1/2" (2-45x240)  
LVL5 3-1 3/4"x9 1/2" (3-45x240)  
LVL6 2-1 3/4"x11 7/8" (2-45x300)  
LVL7 3-1 3/4"x11 7/8" (3-45x300)

41. **STRIP FOOTING SUPPORTING EXTERIOR WALLS**  
-SEE OBC 9.15.3.  
-ASSUMING MASONRY VENEER CONSTRUCTION, MAX. FLOOR LIVE LOAD OF 2.4kPa. (50psf.) PER FLOOR, AND MAX. LENGTH OF SUPPORTED FLOOR JOISTS IS 4.9m (16'-1"). THE STRIP FOOTING SIZE IS AS FOLLOWS:  
2 STOREY ( STANDARD ) 500x155 (20"x6")  
2 STOREY ( WALK-OUT BASEMENT ) 545x175 (22"x7") (UNLESS OTHERWISE NOTED ON PLAN)

42. **EXTERIOR WALLS FOR WALK-OUT CONDITIONS** THE EXTERIOR BASEMENT STUD WALL TO BE 38x140 (2"x6") STUDS @ 16" o.c. OR 38x89 (2"x4") STUDS @ 12"o.c.

43. **FLASHING FOR EXT. WALL OPENINGS (O.B.C.9.27.3.8.(3))**

44. **SUMP PITS (WHERE REQ'D) SEE O.B.C. 9.14.5.2**  
-MUST BE SEALED AS PER 9.25.3.3.(16)

IT IS THE CONTRACTOR'S RESPONSABILITY TO ENSURE THAT ALL CONSTRUCTION CONFORMS TO THE REQUIREMENTS OF THE OBC. NOTATIONS MADE ON THESE DRAWINGS ARE FOR YOUR INFORMATION AND ASSISTANCE ONLY AND DO NOT NECESSARILY COMMENT ON ALL AREAS OF CONSTRUCTION.

LEGEND

|  |                                 |   |
|--|---------------------------------|---|
|  | M.C.                            | MEDICINE CABINET   |
|  | DOUBLE VOLUME WALL              | SEE NOTE 39.   |
|  | SOLID WOOD BEARING              | P2 - 2 MEMBER BUILT-UP STUD<br>P3 - 3 MEMBER BUILT-UP STUD<br>P4 - 4 MEMBER BUILT-UP STUD<br>P5 - 5 MEMBER BUILT-UP STUD |
|  | EXHAUST VENT                    |   |
|  | DUPLEX OUTLET (12" HIGH)        |   |
|  | WEATHERPROOF DUPLEX OUTLET      |   |
|  | HEAVY DUTY OUTLET               |   |
|  | POT LIGHT                       |   |
|  | LIGHT FIXTURE (CEILING MOUNTED) |   |
|  | LIGHT FIXTURE (WALL MOUNTED)    |   |
|  | SWITCH                          |   |
|  | SWITCH (3-WAY)                  |   |
|  | FLOOR DRAIN                     |   |
|  | HOSE BIB                        |   |
|  | DOUBLE JOIST                    |   |
|  | LVL                             | LAMINATED VENEER LUMBER                                                                                                  |
|  | POINT LOAD FROM ABOVE           |   |
|  | P.T.                            | PRESSURE TREATED LUMBER                                                                                                  |
|  | G.T.                            | GIRDER TRUSS BY ROOF TRUSS MANUF.                                                                                        |
|  | F.A.                            | FLAT ARCH   |
|  | C.A.                            | CURVED ARCH   |

NOTE: SOLID BEARING TO BE AS WIDE AS SUPPORTED MEMBER. SOLID BEARING TO BE A MINIMUM OF P2 (ONE CONTINUOUS STUD AND ONE JACK STUD, UNLESS OTHERWISE NOTED ON PLAN.)

**SMOKE ALARM -OBC 9.10.19.**  
PROVIDE 1 PER FLOOR, NEAR THE STAIRS CONNECTING THE FLOOR LEVEL. ONE PER SLEEPING ROOM, INCLUDING HALLWAYS BE CONNECTED TO AN ELECTRICAL CIRCUIT AND INTERCONNECTED TO ACTIVATE ALL ALARMS WHEN ONE ALARM SOUNDS.  
-9.10.19.1(2) REQUIRED SMOKE ALARMS TO HAVE A VISUAL COMPONENT

**CARBON MONOXIDE ALARM (OBC 9.33.4)**  
WHERE A FUEL-BURNING APPLIANCE IS INSTALLED IN A DWELLING UNIT, A CARBON MONOXIDE ALARM CONFORMING TO CAN/CSA-6.19, CSA 6.19 OR UL2034 SHALL BE INSTALLED ADJACENT TO EACH SLEEPING AREA. CARBON MONOXIDE ALARM(S) SHALL BE PERMANENTLY WIRED SO THAT ITS ACTIVATION WILL ACTIVATE ALL CARBON MONOXIDE ALARMS AND BE EQUIPPED WITH AN ALARM THAT IS AUDIBLE WITHIN BEDROOMS WHEN THE INTERVENING DOORS ARE CLOSED.

**SOIL GAS CONTROL (OBC 9.13.1. & 9.13.4, & SB9)** PROVIDE CONSTRUCTION TO PREVENT LEAKAGE OF SOIL GAS INTO THE BUILDING WHERE REQUIRED. (SEE ALSO O.B.C. 9.1.1.7.(1))

CONTRACTOR MUST VERIFY ALL DIMENSIONS ON THE JOB AND REPORT ANY DISCREPANCY TO THE BUILDER BEFORE PROCEEDING WITH THE WORK. DO NOT SCALE DRAWINGS. USE DIMENSIONS PROVIDED. ALL DRAWINGS TO BE USED FOR CONSTRUCTION ONLY AFTER BUILDING PERMIT HAS BEEN ISSUED.

517-RUTHERFORD-2015

SITE: WHITE TAIL RIDGE PH3

LOT NUMBER:

CIVIC ADDRESS:

308 ANTLER COURT

52

|           |                                   |          |    |
|-----------|-----------------------------------|----------|----|
|           |                                   |          |    |
| 9         | FINAL BLACKLINES                  | 05/08/22 | CB |
| 8         | ISSUED FOR LAYOUTS                | 13/06/22 | SP |
| 7         | BEP BLACKLINES                    | 18/05/22 | KE |
| 6         | TUB CHANGED TO MAAX EXHIBIT 60X32 | 09/02/21 | CB |
| 5         | UPDATE BASEMENT WINDOWS           | 01/09/19 | SP |
| No.       | Description                       | dd/mm/yy | By |
| REVISIONS |                                   |          |    |

footprint: 517

designed by: TL

drawn by: SP

date: NOV/15

scale: 3/16"=1'-0"

D.C.L.-193

sheet

title: A0

1 of 9

CONTRACTOR MUST VERIFY ALL DIMENSIONS ON THE JOB AND REPORT ANY DISCREPANCY TO DCR/PHOENIX BEFORE PROCEEDING WITH THE WORK. ALL DRAWINGS AND SPECIFICATIONS ARE INSTRUMENTS OF SERVICE AND THE PROPERTY OF THE DCR/PHOENIX WHICH MUST BE RETURNED AT THE COMPLETION OF THE WORK. ALL DRAWINGS TO BE USED FOR CONSTRUCTION ONLY AFTER BUILDING PERMIT HAS BEEN ISSUED. DO NOT SCALE DRAWINGS, USE DIMENSIONS PROVIDED.


**\*\*NOTE\*\***  
ALL WINDOW LINTELS TO BE 2-2X10  
W/ P2 POSTS ON EACH SIDE U.N.O.

**BASEMENT AIR BARRIER**  
SUMP PUMP LIDS, JOINTS AT INTERSECTIONS & ALL PENETRATIONS  
OF SLAB MUST BE SEALED TO PREVENT AIR LEAKAGE

PROVIDE A MIN.  
42% EFFICIENT  
DRAIN WATER  
HEAT RECOVERY  
UNIT  
CONNECTED TO  
ALL SHOWERS  
(OR AT LEAST 2  
SHOWERS WHEN  
MORE THAN 1  
UNIT IS  
INSTALLED)

TRACE ALL POINT  
LOADS THROUGH  
FLOOR SYSTEM TO  
SOLID BEARING BELOW

SRP400 R10 [2 3/8" THICK SHEETS]  
EXTEND 48" BEYOND FOOTING EXTERIOR  
EXTEND 24" BEYOND FOOTING INTERIOR

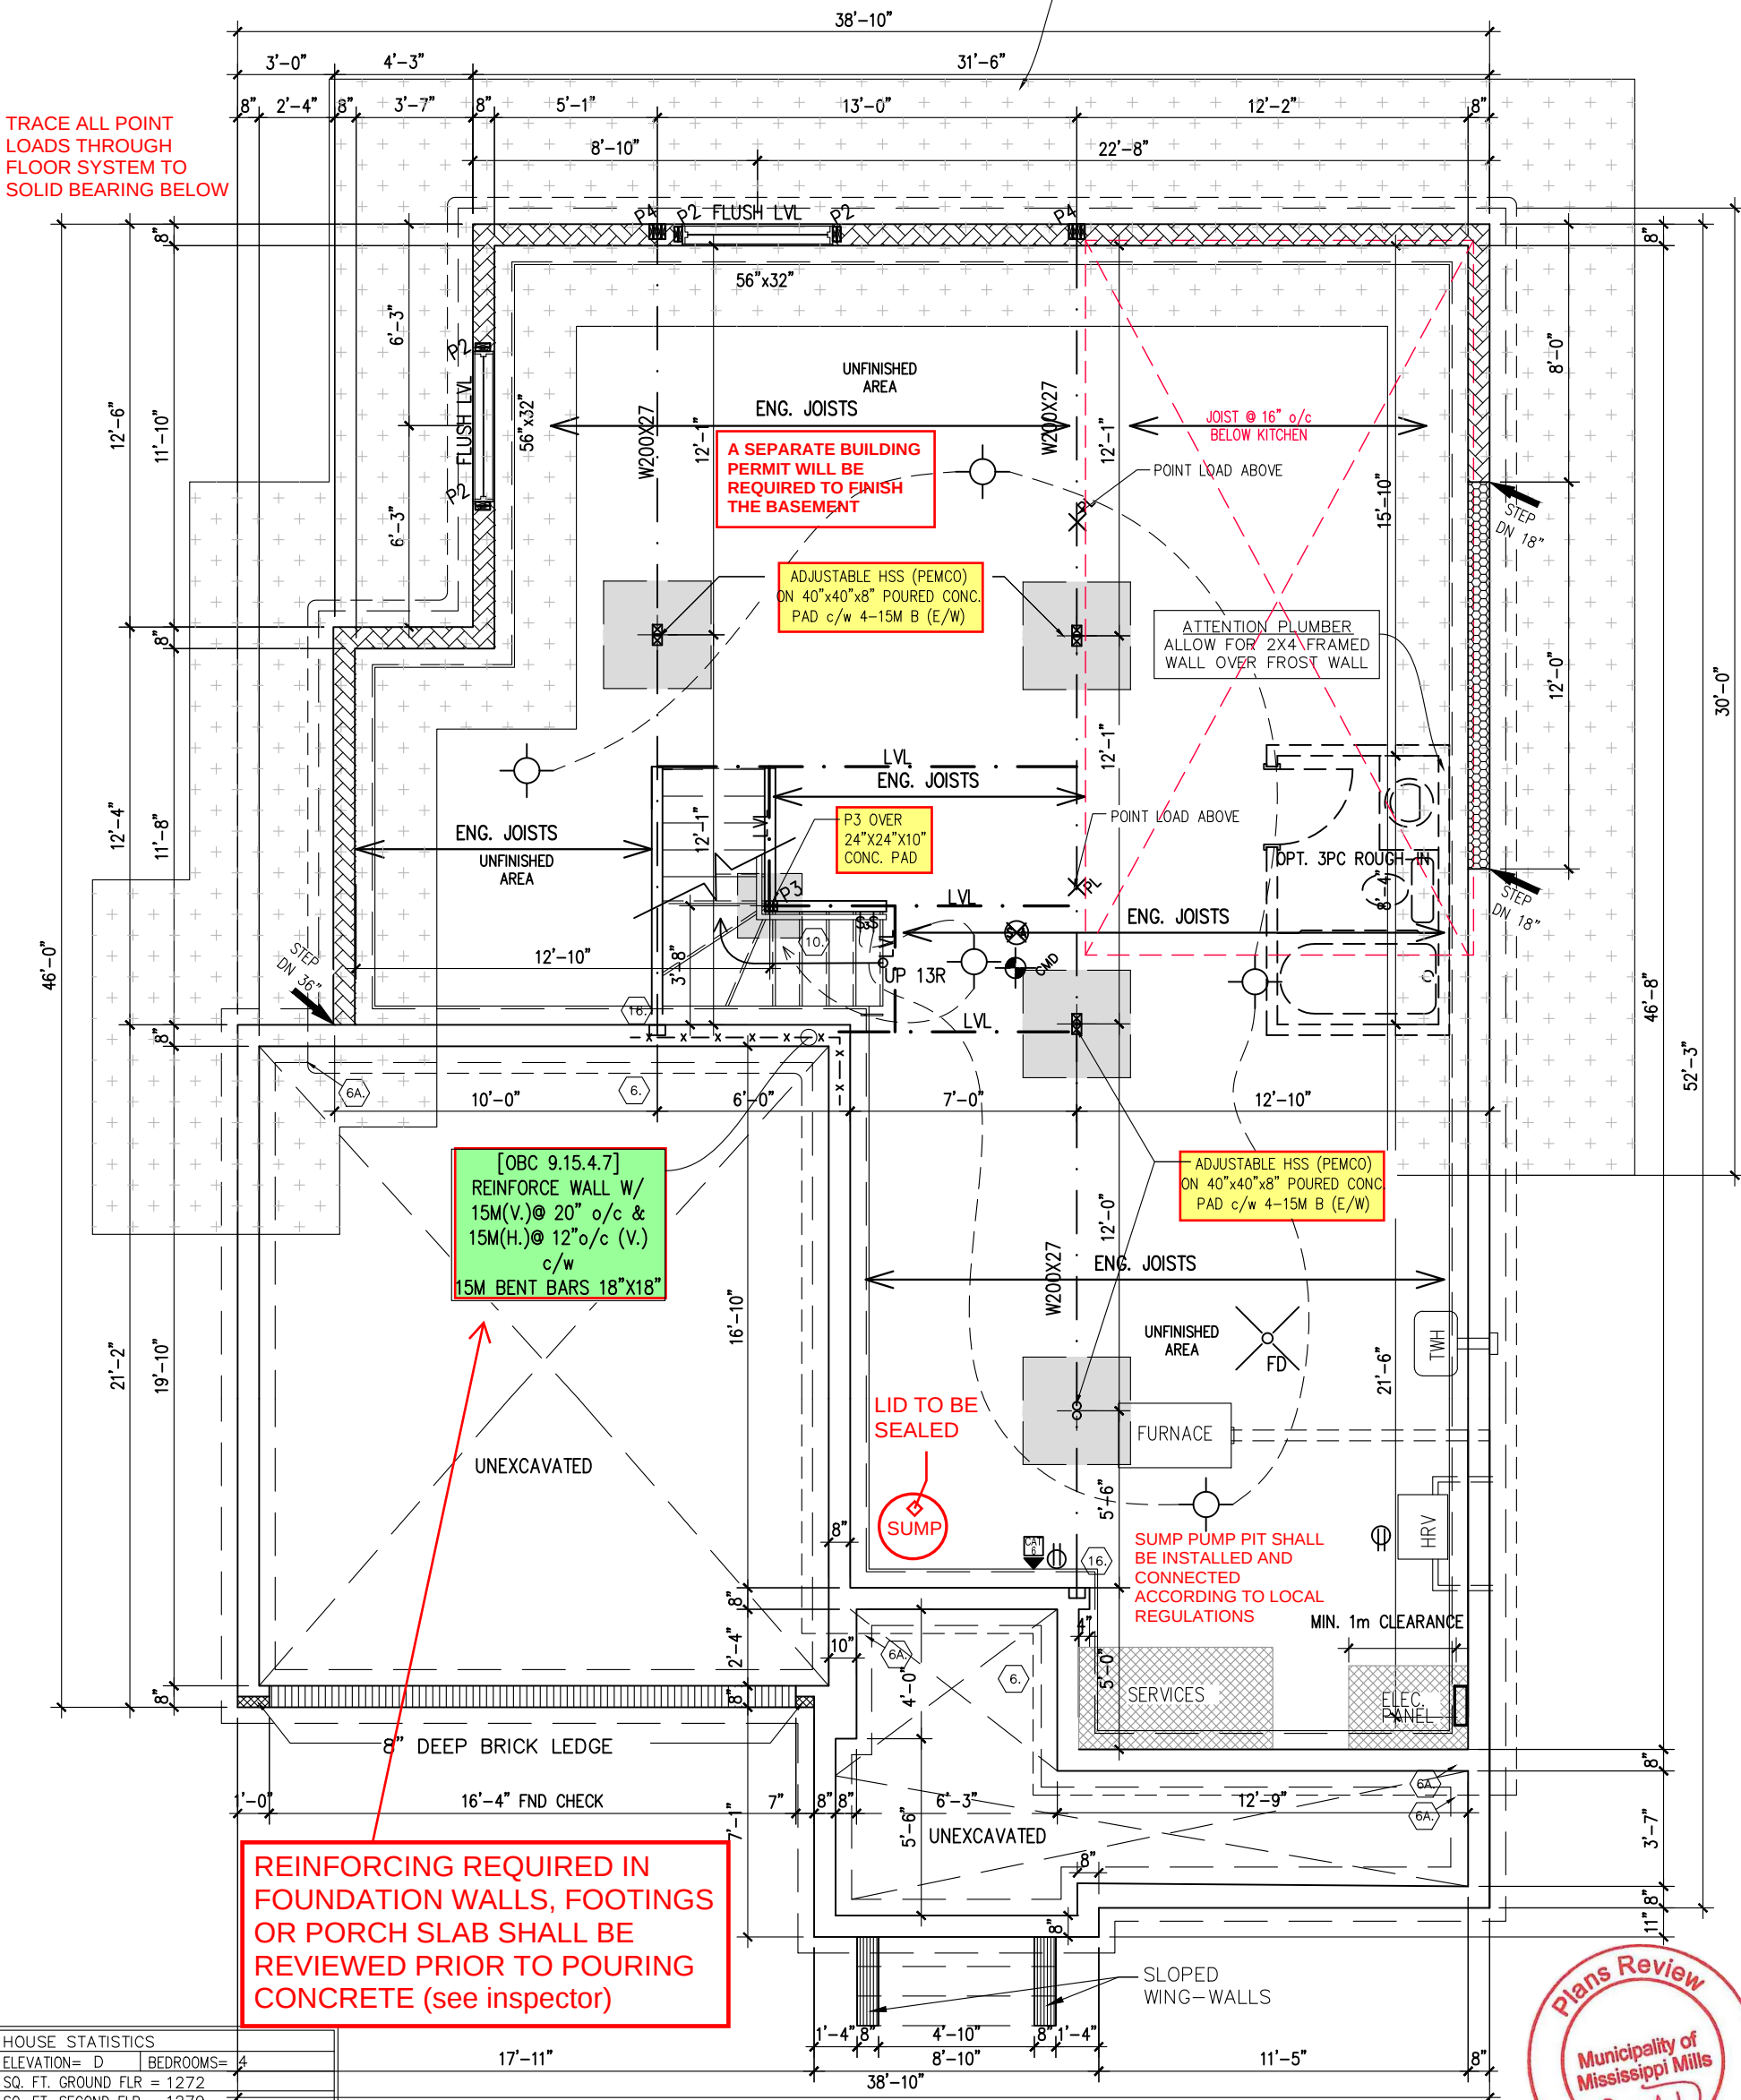

| HOUSE STATISTICS              |             |
|-------------------------------|-------------|
| ELEVATION= D                  | BEDROOMS= 4 |
| SQ. FT. GROUND FLR = 1272     |             |
| SQ. FT. SECOND FLR = 1279     |             |
| TOTAL = 2551                  |             |
| SQ. FT. BASEMENT = UNFINISHED |             |
| SQ. FT. FRONT PORCH = 139     |             |
| SQ. FT. DECK = 0              |             |

## FOUNDATION PLAN ELEVATION D



2022-11-07



517-RUTHERFORD-2015

SITE: WHITE TAIL RIDGE PH3

LOT NUMBER:

52

CIVIC ADDRESS:  
308 ANTLER COURT

| No.       | Description                       | dd/mm/yy | By |
|-----------|-----------------------------------|----------|----|
| 9         | FINAL BLACKLINES                  | 05/08/22 | CB |
| 8         | ISSUED FOR LAYOUTS                | 13/06/22 | SP |
| 7         | BEP BLACKLINES                    | 18/05/22 | KE |
| 6         | TUB CHANGED TO MAAX EXHIBIT 60X32 | 09/02/21 | CB |
| 5         | UPDATE BASEMENT WINDOWS           | 01/09/19 | SP |
| REVISIONS |                                   |          |    |

footprint: 517

designed by: TL

drawn by: SP

date: NOV/15

scale: 3/16"=1'-0"

D.C.L.-193

sheet


A1

2 of

9

CONTRACTOR MUST VERIFY ALL DIMENSIONS ON THE JOB AND REPORT ANY DISCREPANCY TO DCR/PHOENIX BEFORE PROCEEDING WITH THE WORK.  
ALL DRAWINGS AND SPECIFICATIONS ARE INSTRUMENTS OF SERVICE AND THE PROPERTY OF THE DCR/PHOENIX WHICH MUST BE RETURNED AT THE COMPLETION OF THE WORK.  
ALL DRAWINGS TO BE USED FOR CONSTRUCTION ONLY AFTER BUILDING PERMIT HAS BEEN ISSUED.  
DO NOT SCALE DRAWINGS, USE DIMENSIONS PROVIDED.

**\*\*NOTE\*\***  
ALL WINDOW LINTELS TO BE 2-2X10  
W/ P2 POSTS ON EACH SIDE U.N.O.

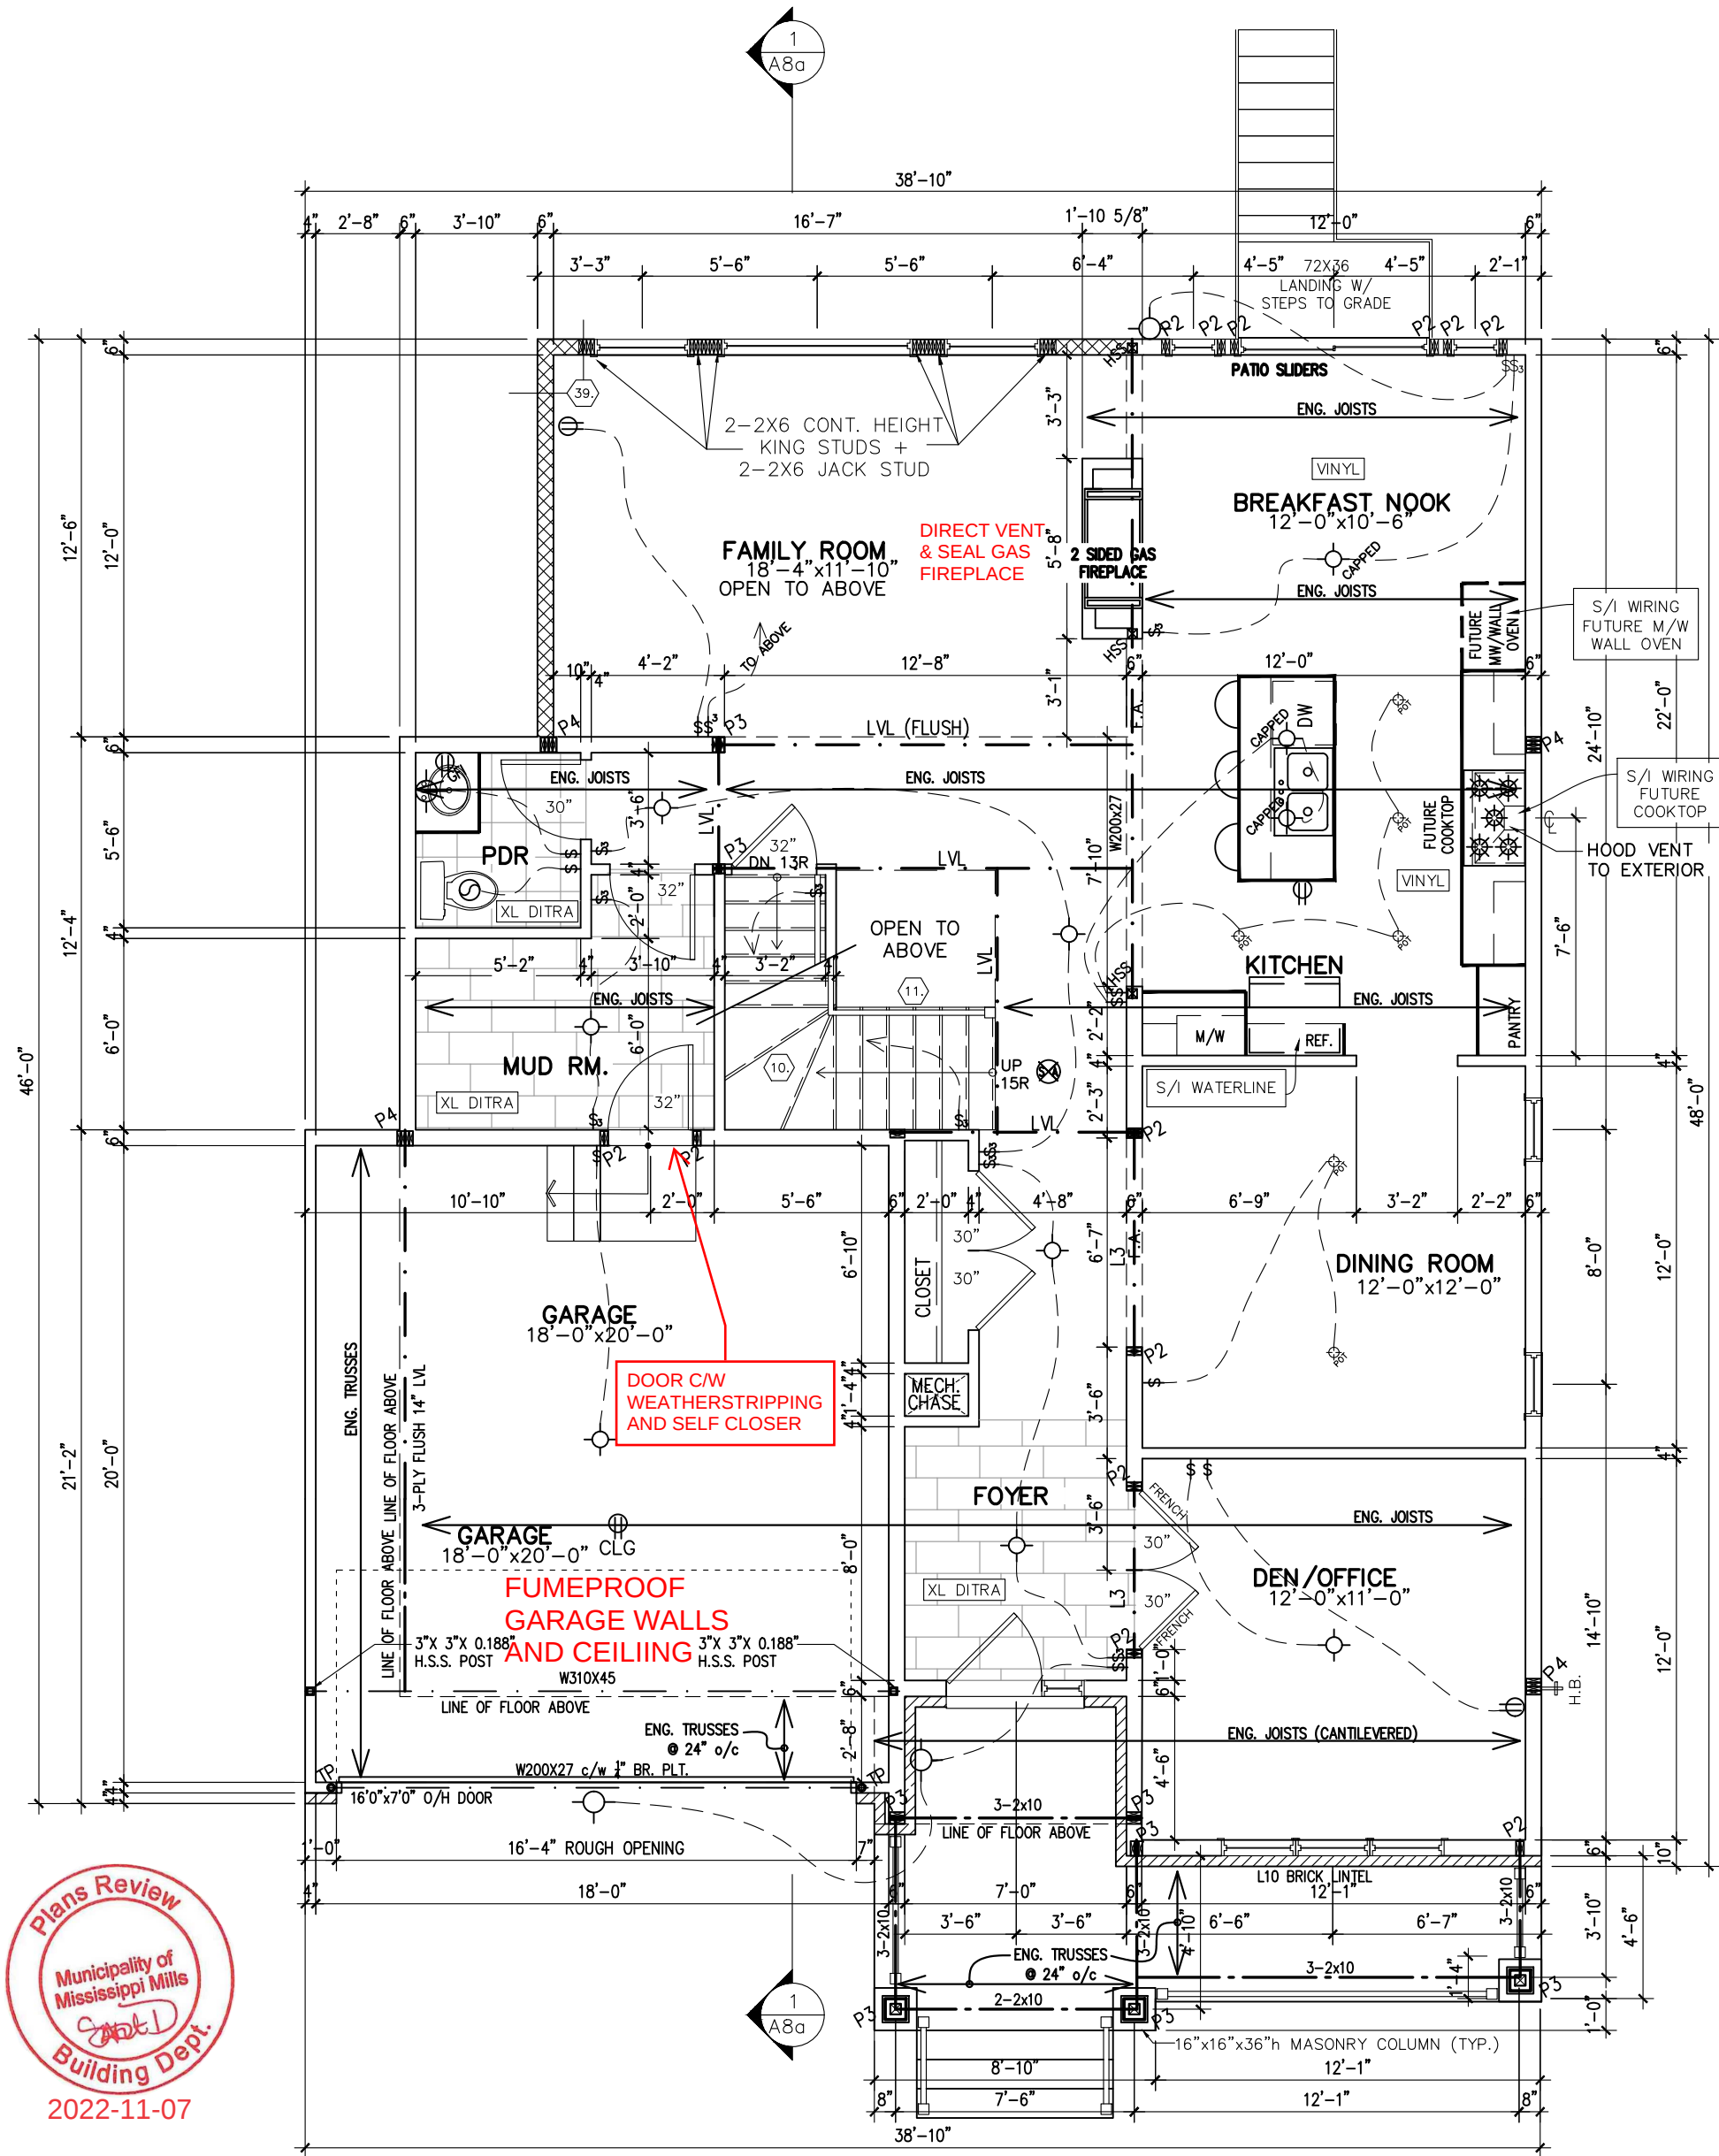

GROUND FLOOR PLAN  
ELEVATION D

**FLAT CEILINGS THROUGHOUT  
NO STIPPLE**



517-RUTHERFORD-2015

SITE: WHITE TAIL RIDGE PH3

LOT NUMBER: 52

CIVIC ADDRESS: 308 ANTLER COURT

|           |                                   |          |    |
|-----------|-----------------------------------|----------|----|
| 9         | FINAL BLACKLINES                  | 05/08/22 | CB |
| 8         | ISSUED FOR LAYOUTS                | 13/06/22 | SP |
| 7         | BEP BLACKLINES                    | 18/05/22 | KE |
| 6         | TUB CHANGED TO MAAX EXHIBIT 60X32 | 09/02/21 | CB |
| 5         | UPDATE BASEMENT WINDOWS           | 01/09/19 | SP |
| No.       | Description                       | dd/mm/yy | By |
| REVISIONS |                                   |          |    |

footprint: 517

designed by: TL

drawn by: SP

date: NOV/15

scale: 3/16"=1'-0"

D.C.L.-193 sheet


sheet title: A2

3 of 9

CONTRACTOR MUST VERIFY ALL DIMENSIONS ON THE JOB AND REPORT ANY DISCREPANCY TO DCR/PHOENIX BEFORE PROCEEDING WITH THE WORK.  
ALL DRAWINGS AND SPECIFICATIONS ARE INSTRUMENTS OF SERVICE AND THE PROPERTY OF THE DCR/PHOENIX WHICH MUST BE RETURNED AT THE COMPLETION OF THE WORK.  
ALL DRAWINGS TO BE USED FOR CONSTRUCTION ONLY AFTER BUILDING PERMIT HAS BEEN ISSUED.  
DO NOT SCALE DRAWINGS, USE DIMENSIONS PROVIDED.


**\*\*NOTE\*\***  
ALL WINDOW LINTELS TO BE 2-2X10 W/ P2 POSTS ON EACH SIDE U.N.O.

A SMOKE ALARM SHALL BE INSTALLED ON EACH FLOOR LEVEL AND WITHIN EACH SLEEPING ROOM. ALL SMOKE ALARMS SHALL BE INTERCONNECTED. EACH DEVICE SHALL HAVE A VISUAL SIGNALING COMPONENT IN ADDITION TO THE TEMPORAL PATTERN IN CONFORMANCE WITH 18.5.3 OF NFPA 72.

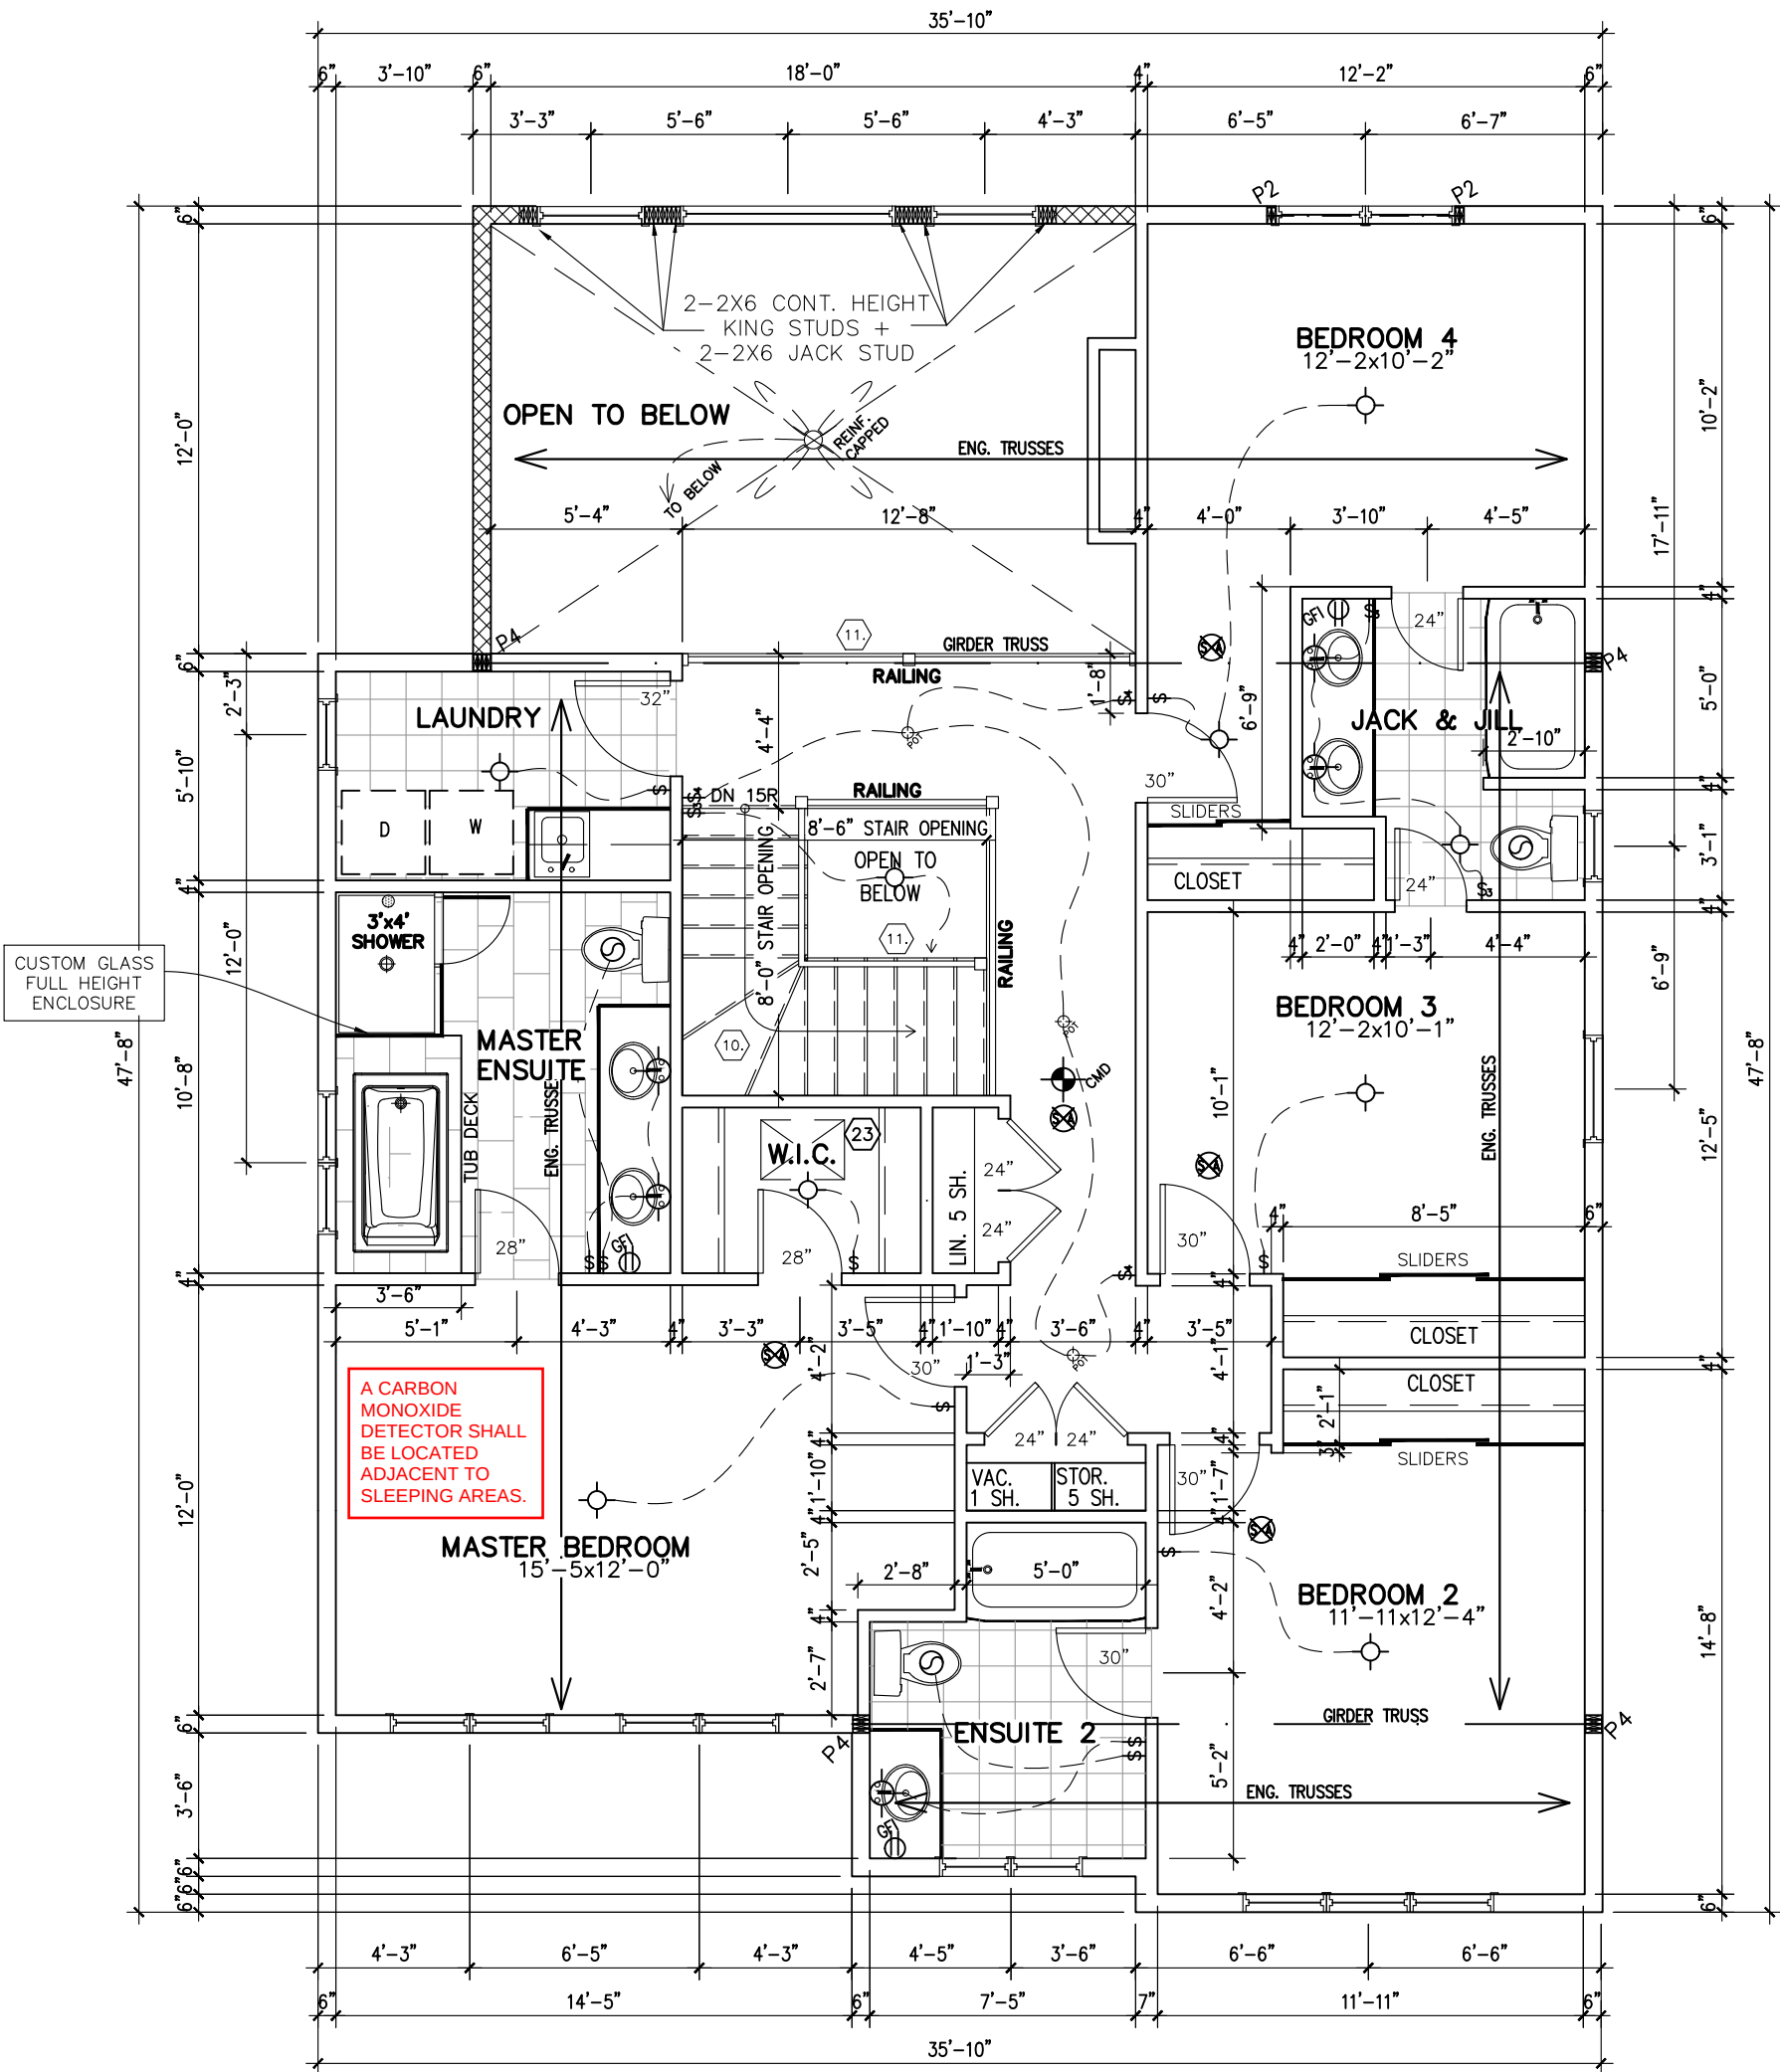

**FLAT CEILINGS THROUGHOUT  
NO STIPPLE**

SECOND FLOOR PLAN  
ELEVATION D

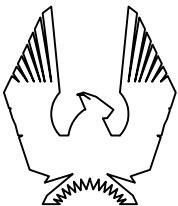

PHOENIX HOMES

517-RUTHERFORD-2015

SITE: WHITE TAIL RIDGE PH3

LOT NUMBER:

52

CIVIC ADDRESS:  
308 ANTLER COURT

|           |                                    |          |    |
|-----------|------------------------------------|----------|----|
| 9         | FINAL BLACKLINES                   | 05/08/22 | CB |
| 8         | ISSUED FOR LAYOUTS                 | 13/06/22 | SP |
| 7         | BEP BLACKLINES                     | 18/05/22 | KE |
| 6         | TUB CHANGED TO MAA X EXHIBIT 60X32 | 09/02/21 | CB |
| 5         | UPDATE BASEMENT WINDOWS            | 01/09/19 | SP |
| No.       | Description                        | dd/mm/yy | By |
| REVISIONS |                                    |          |    |

footprint: 517

designed by: TL

drawn by: SP

date: NOV/15

scale: 3/16"=1'-0"

D.C.L.-193 sheet

sheet title: A3

4 of

9



2022-11-07  
FRONT ELEVATION D



517-RUTHERFORD-2015

SITE: WHITE TAIL RIDGE PH3

LOT NUMBER: 52

CIVIC ADDRESS:  
308 ANTLER COURT

|           |                                   |          |    |
|-----------|-----------------------------------|----------|----|
| 9         | FINAL BLACKLINES                  | 05/08/22 | CB |
| 8         | ISSUED FOR LAYOUTS                | 13/06/22 | SP |
| 7         | BEP BLACKLINES                    | 18/05/22 | KE |
| 6         | TUB CHANGED TO MAAX EXHIBIT 60X32 | 09/02/21 | CB |
| 5         | UPDATE BASEMENT WINDOWS           | 01/09/19 | SP |
| No.       | Description                       | dd/mm/yy | By |
| REVISIONS |                                   |          |    |

footprint: 517

designed by: TL

drawn by: SP

date: NOV/15


scale: 3/16"=1'-0"

D.C.L.-193 sheet

sheet title: A4d

5 of 9

1/300 ROOF VENTILATION REQUIRED

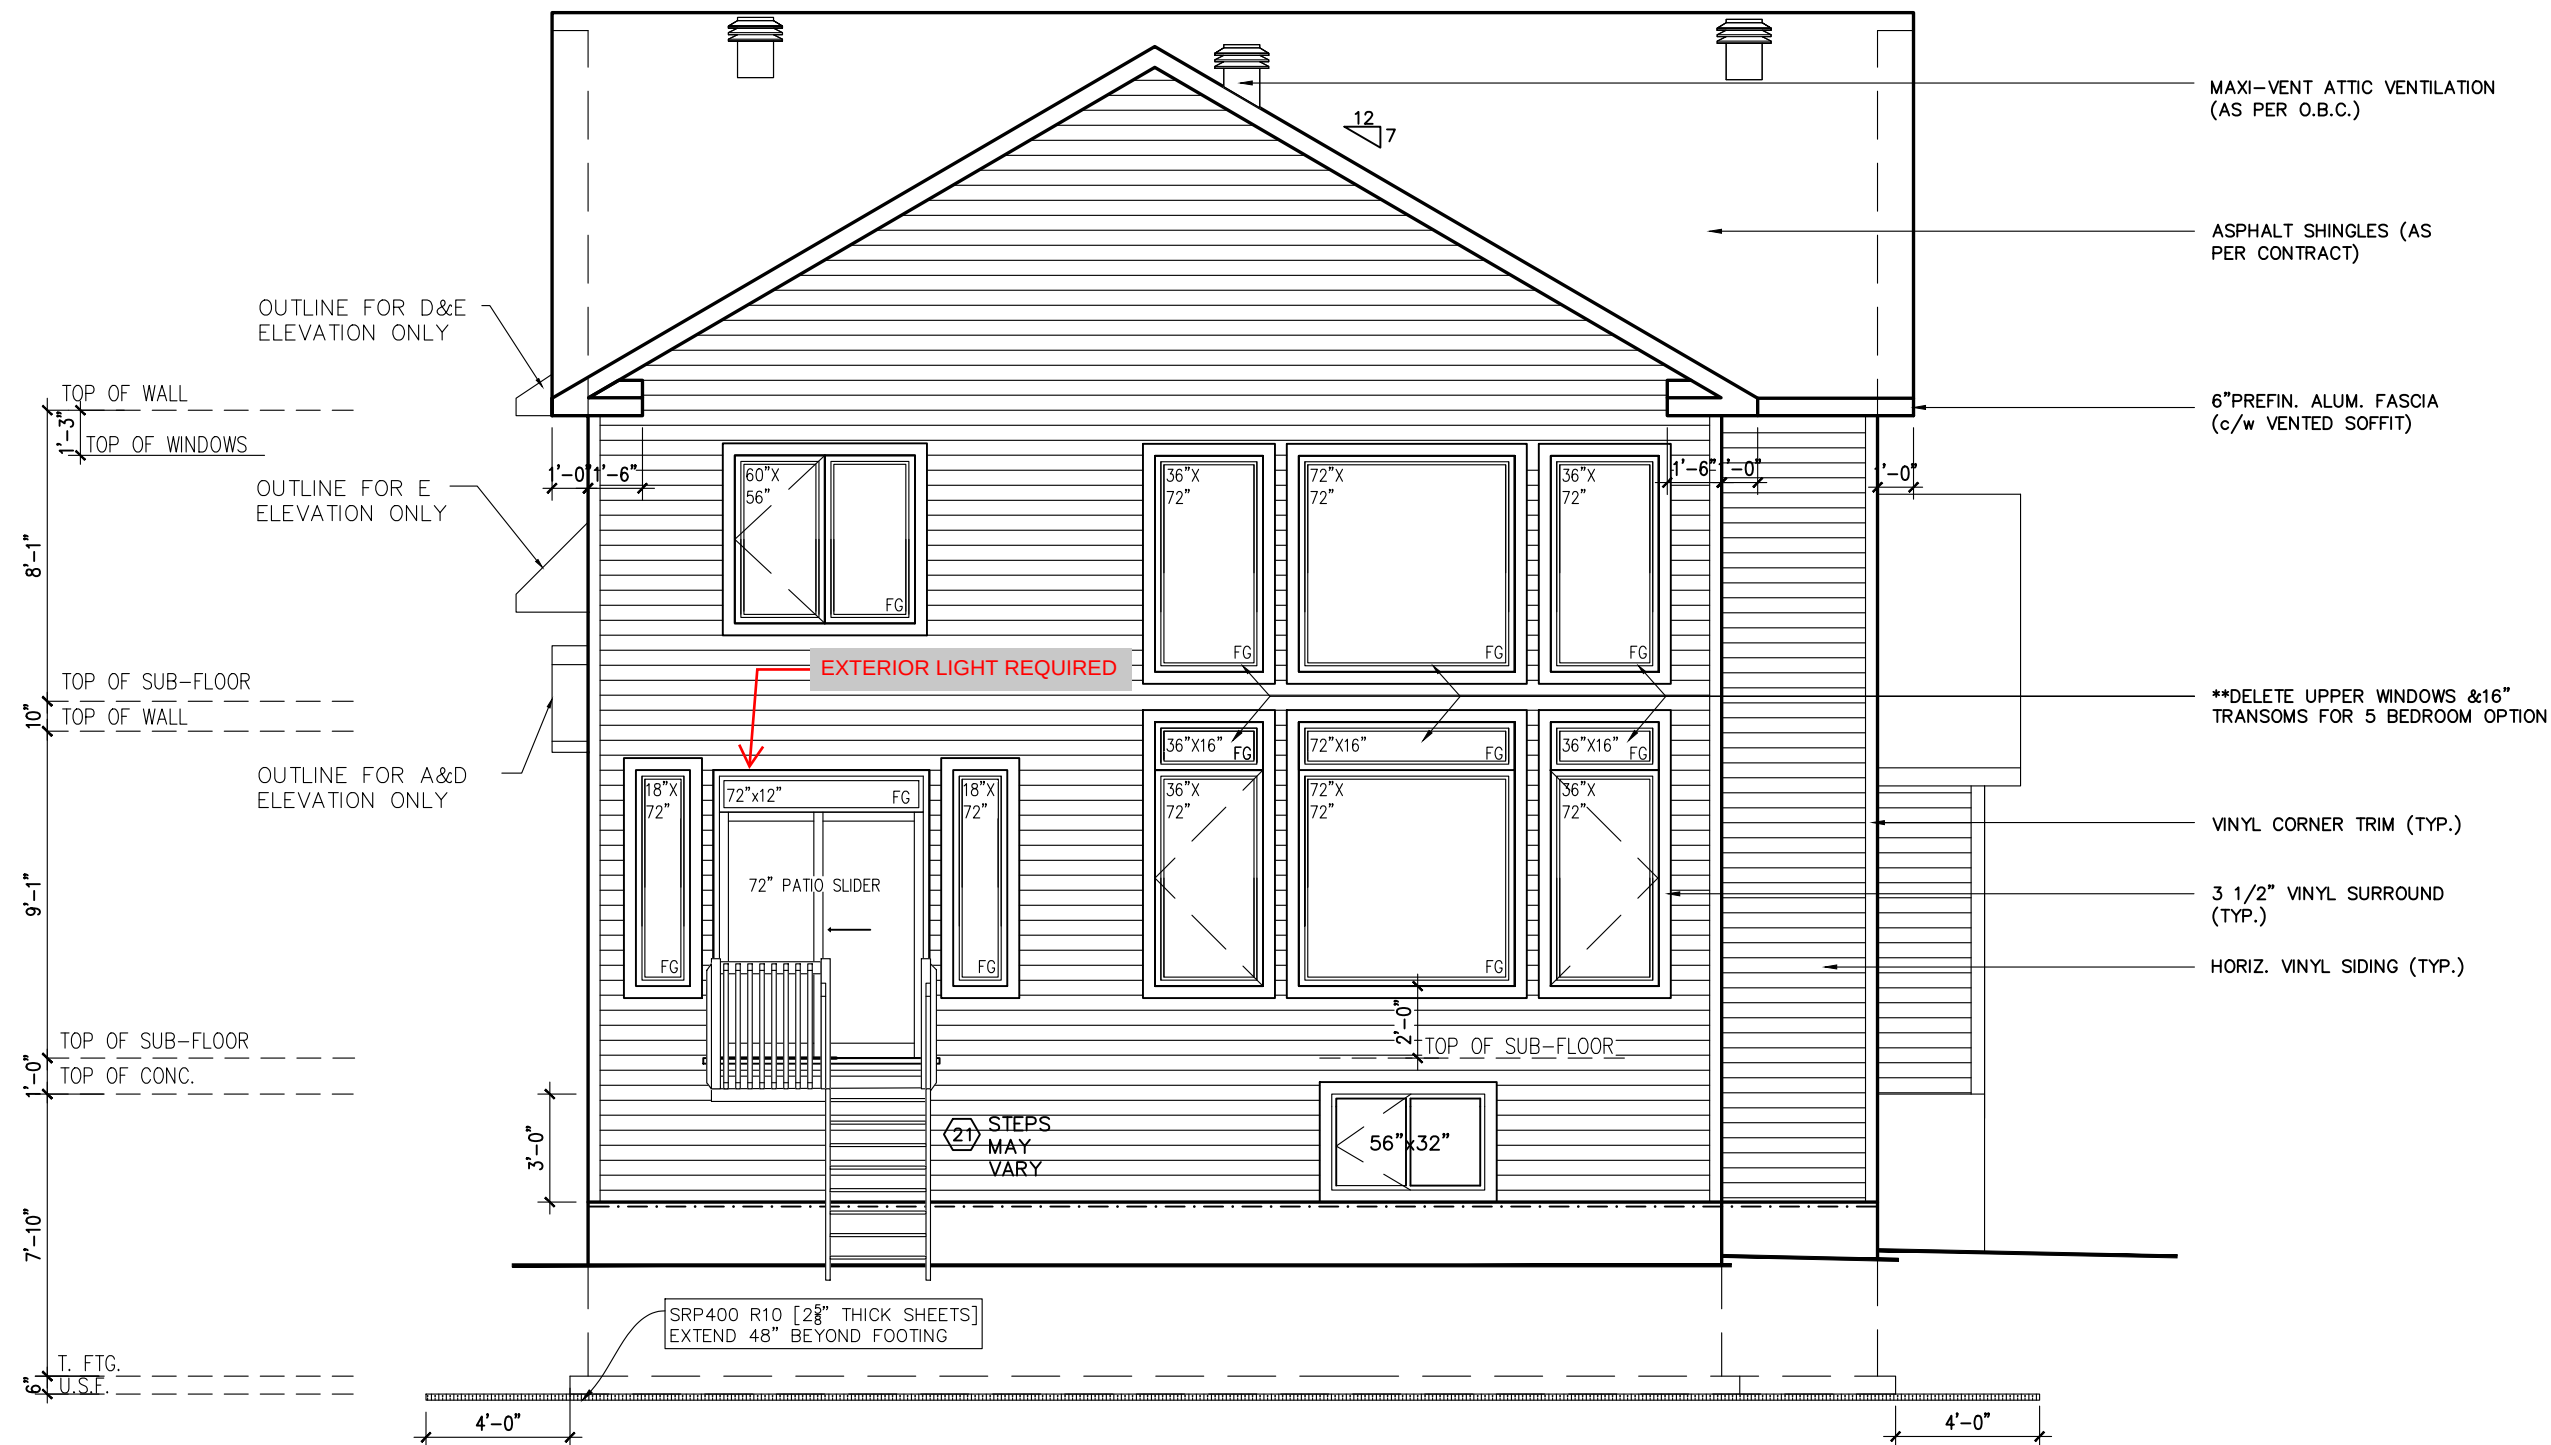

2022-11-07

REAR ELEVATION

ALL GUARDS TO COMPLY WITH SB-7 OR  
P.ENG DESIGN. GUARDS TO BE MIN. 36" HIGH.  
WHERE DECK WALKING SURFACE EXCEEDS  
5'-11", GUARD HEIGHT TO BE 42" HIGH



517-RUTHERFORD-2015

SITE: WHITE TAIL RIDGE PH3


LOT NUMBER:

52

CIVIC ADDRESS:  
308 ANTLER COURT

|                 |                                   |          |    |
|-----------------|-----------------------------------|----------|----|
| 9               | FINAL BLACKLINES                  | 05/08/22 | CB |
| 8               | ISSUED FOR LAYOUTS                | 13/06/22 | SP |
| 7               | BEP BLACKLINES                    | 18/05/22 | KE |
| 6               | TUB CHANGED TO MAAX EXHIBIT 60X32 | 09/02/21 | CB |
| 5               | UPDATE BASEMENT WINDOWS           | 01/09/19 | SP |
| No. Description |                                   | dd/mm/yy | By |
| REVISIONS       |                                   |          |    |

|                    |        |
|--------------------|--------|
| footprint: 517     |        |
| designed by: TL    |        |
| drawn by: SP       |        |
| date: NOV/15       |        |
| scale: 3/16"=1'-0" |        |
| D.C.L.-193         | sheet  |
| sheet title: A5d   | 6 of 9 |

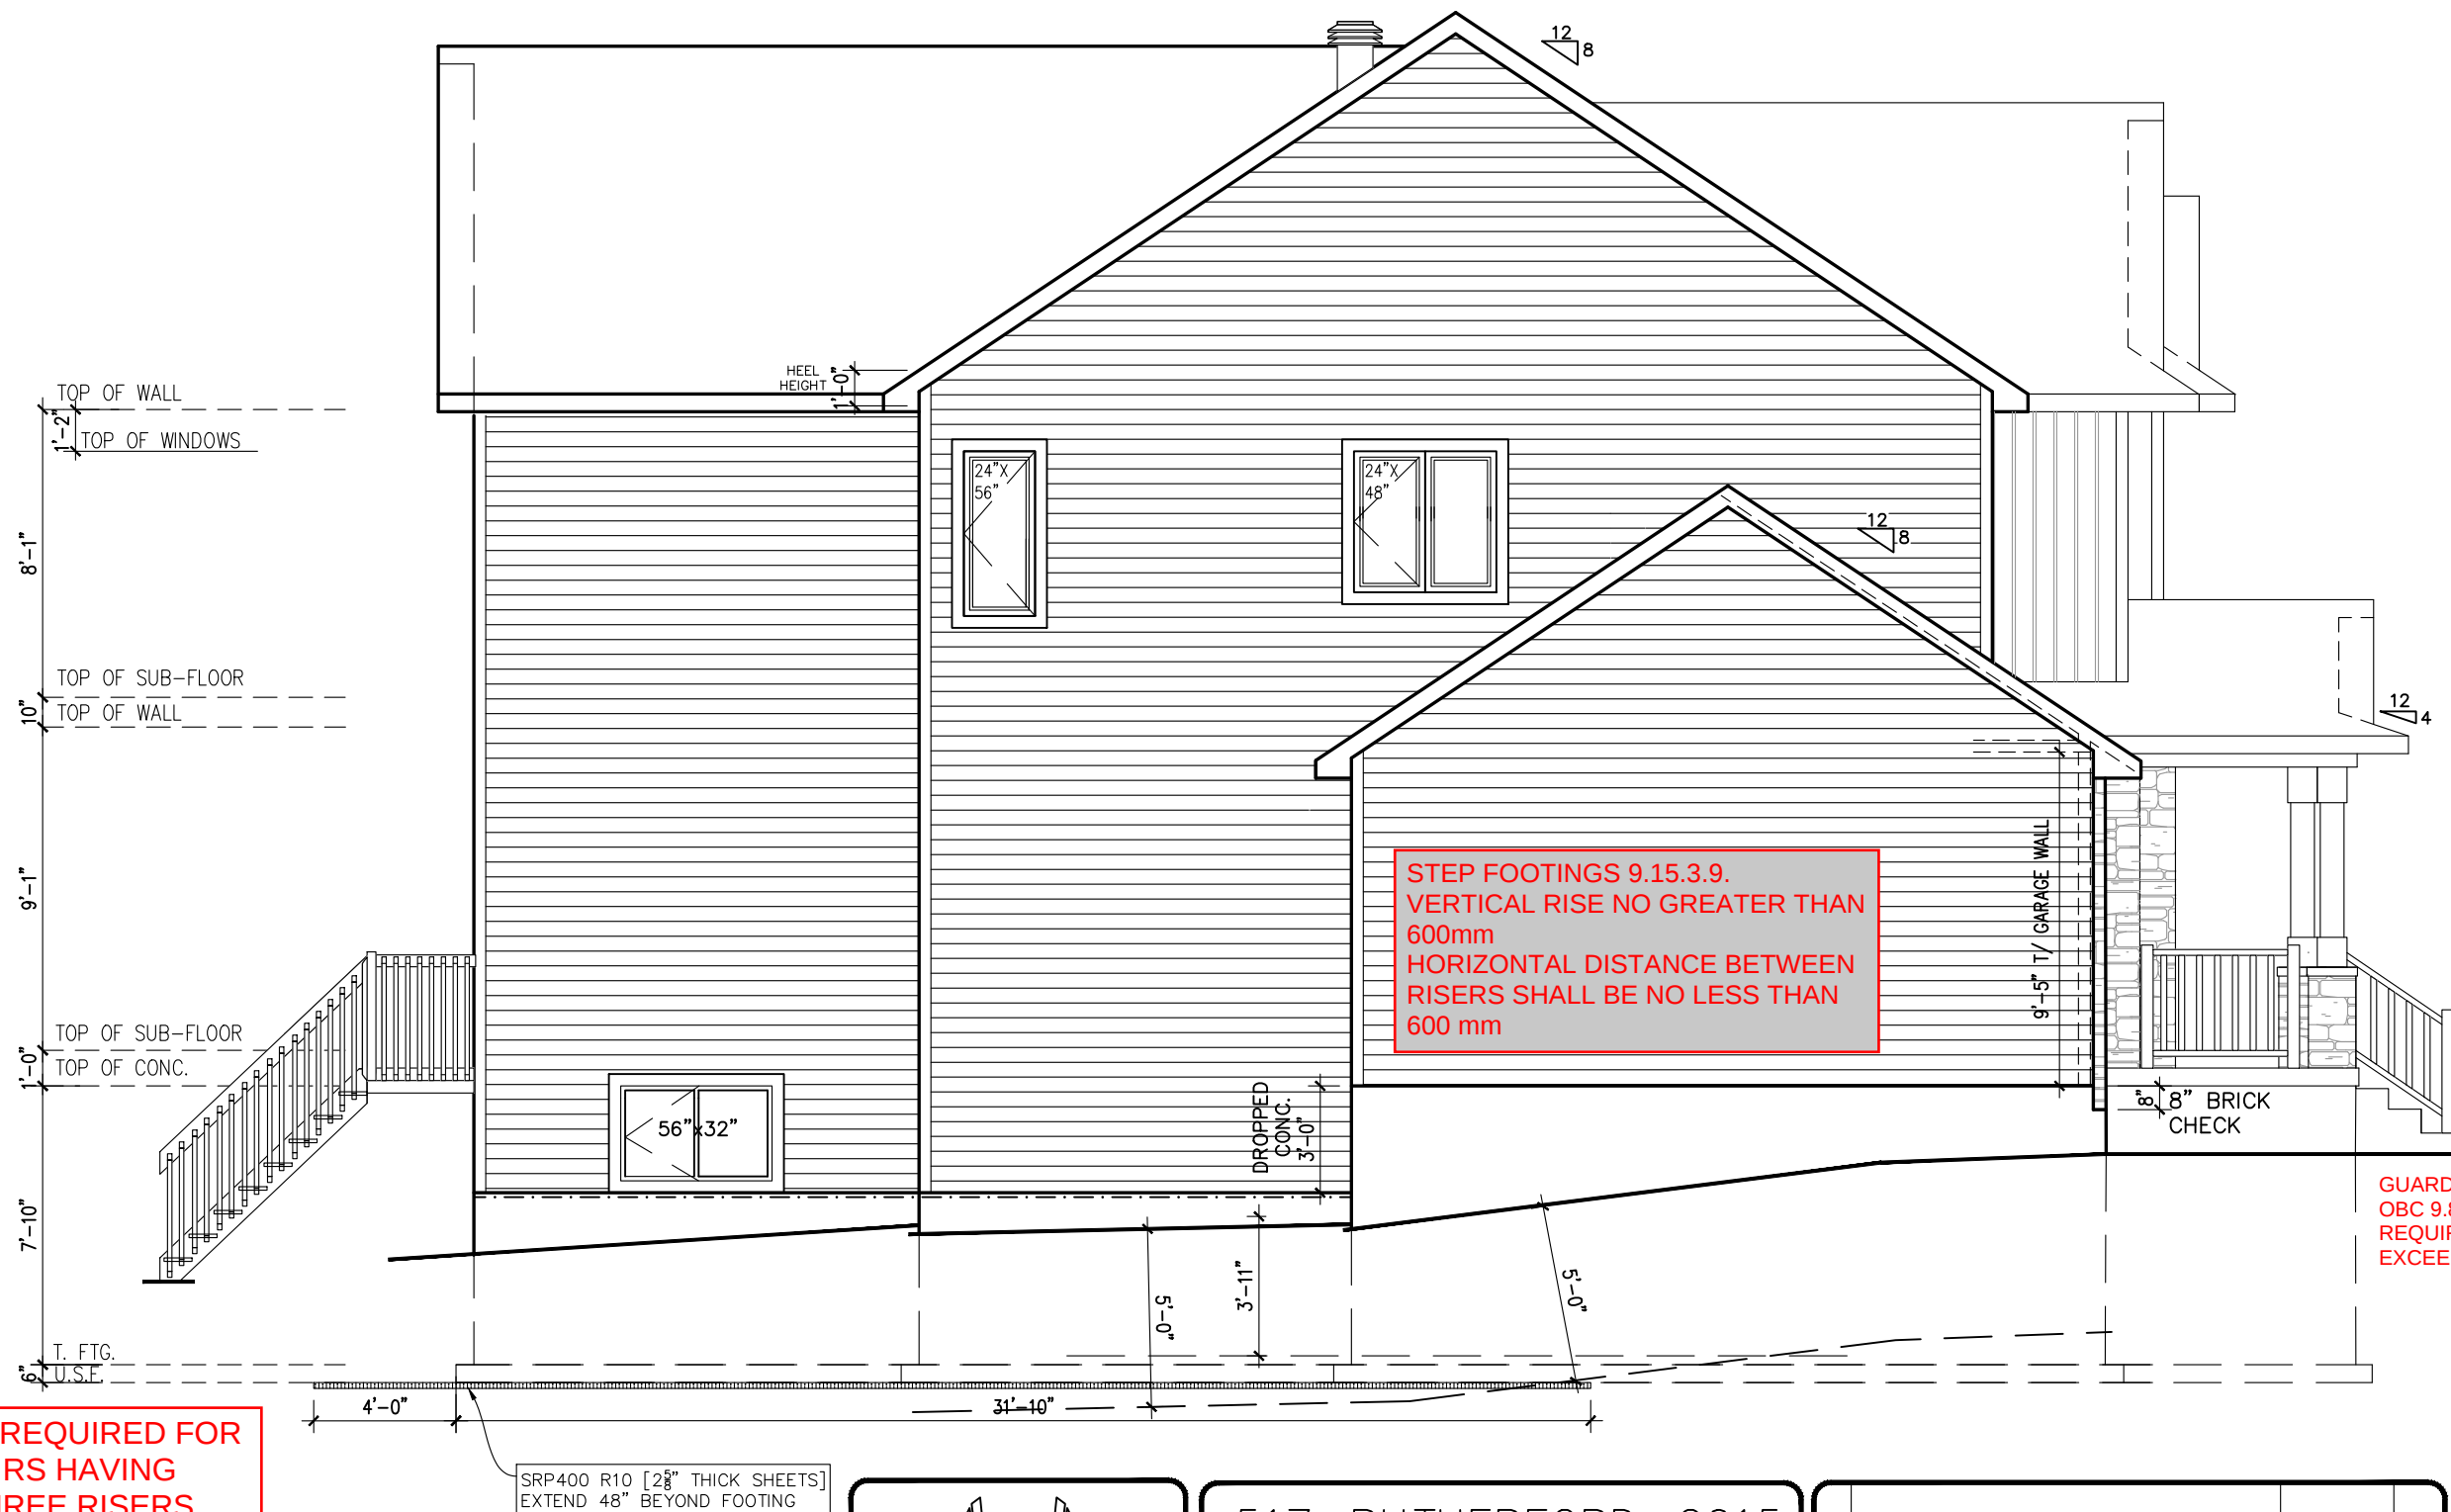

2022-11-07

A HANDRAIL IS REQUIRED FOR EXTERIOR STAIRS HAVING MORE THAN THREE RISERS

SRP400 R10 [28" THICK SHEETS] EXTEND 48" BEYOND FOOTING



517-RUTHERFORD-2015

SITE: WHITE TAIL RIDGE PH3

LOT NUMBER: 52

CIVIC ADDRESS: 308 ANTLER COURT


|           |                                   |          |    |
|-----------|-----------------------------------|----------|----|
| 9         | FINAL BLACKLINES                  | 05/08/22 | CB |
| 8         | ISSUED FOR LAYOUTS                | 13/06/22 | SP |
| 7         | BEP BLACKLINES                    | 18/05/22 | KE |
| 6         | TUB CHANGED TO MAAX EXHIBIT 60X32 | 09/02/21 | CB |
| 5         | UPDATE BASEMENT WINDOWS           | 01/09/19 | SP |
| No.       | Description                       | dd/mm/yy | By |
| REVISIONS |                                   |          |    |

|                    |
|--------------------|
| footprint: 517     |
| designed by: TL    |
| drawn by: SP       |
| date: NOV/15       |
| scale: 3/16"=1'-0" |
| D.C.L.-193 sheet   |
| sheet title: A6d   |
| 7 of 9             |

LEFT SIDE ELEVATION D



NOTE: CHANGE ALL  
WINDOWS ON RIGHT SIDE  
TO CASEMENT FOR  
ELEVATIONS D & E

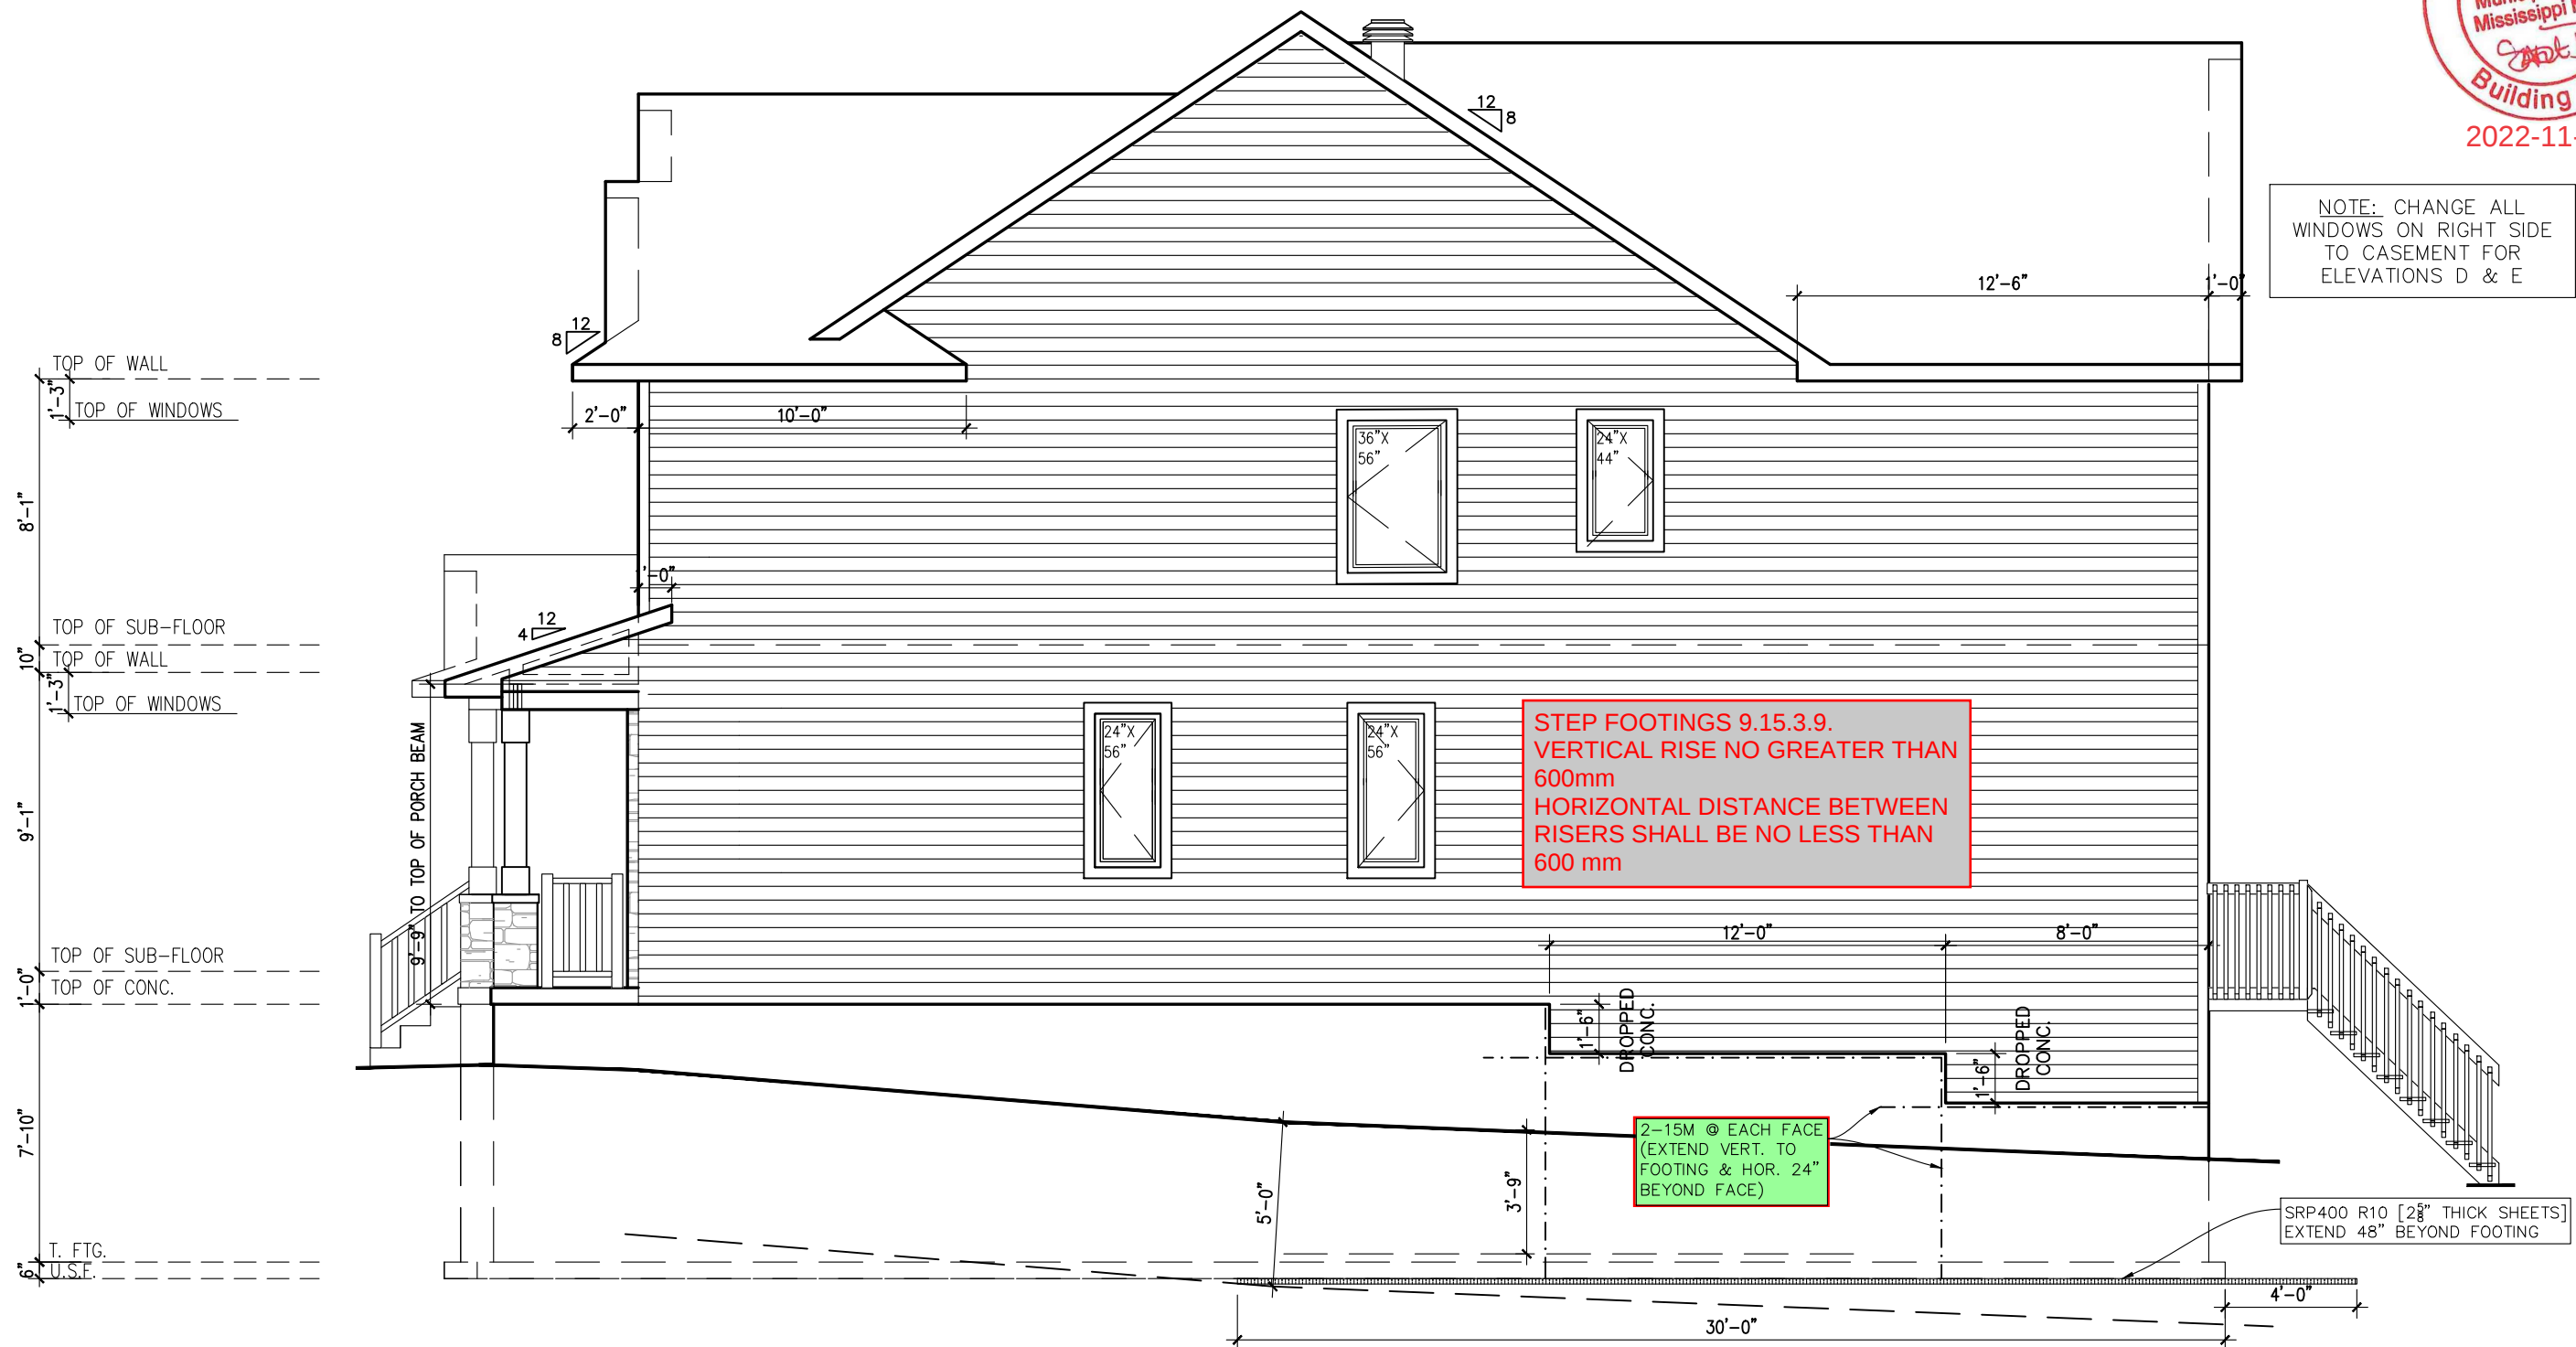

RIGHT SIDE ELEVATION D



517-RUTHERFORD-2015

SITE: WHITE TAIL RIDGE PH3

LOT NUMBER: 52

CIVIC ADDRESS:  
308 ANTLER COURT

|           |                                   |          |    |
|-----------|-----------------------------------|----------|----|
| 9         | FINAL BLACKLINES                  | 05/08/22 | CB |
| 8         | ISSUED FOR LAYOUTS                | 13/06/22 | SP |
| 7         | BEP BLACKLINES                    | 18/05/22 | KE |
| 6         | TUB CHANGED TO MAAX EXHIBIT 60X32 | 09/02/21 | CB |
| 5         | UPDATE BASEMENT WINDOWS           | 01/09/19 | SP |
| No.       | Description                       | dd/mm/yy | By |
| REVISIONS |                                   |          |    |

footprint: 517

designed by: TL

drawn by: SP


date: NOV/15

scale: 3/16"=1'-0"

D.C.L.-193 sheet

sheet title: A7d

8 of 9

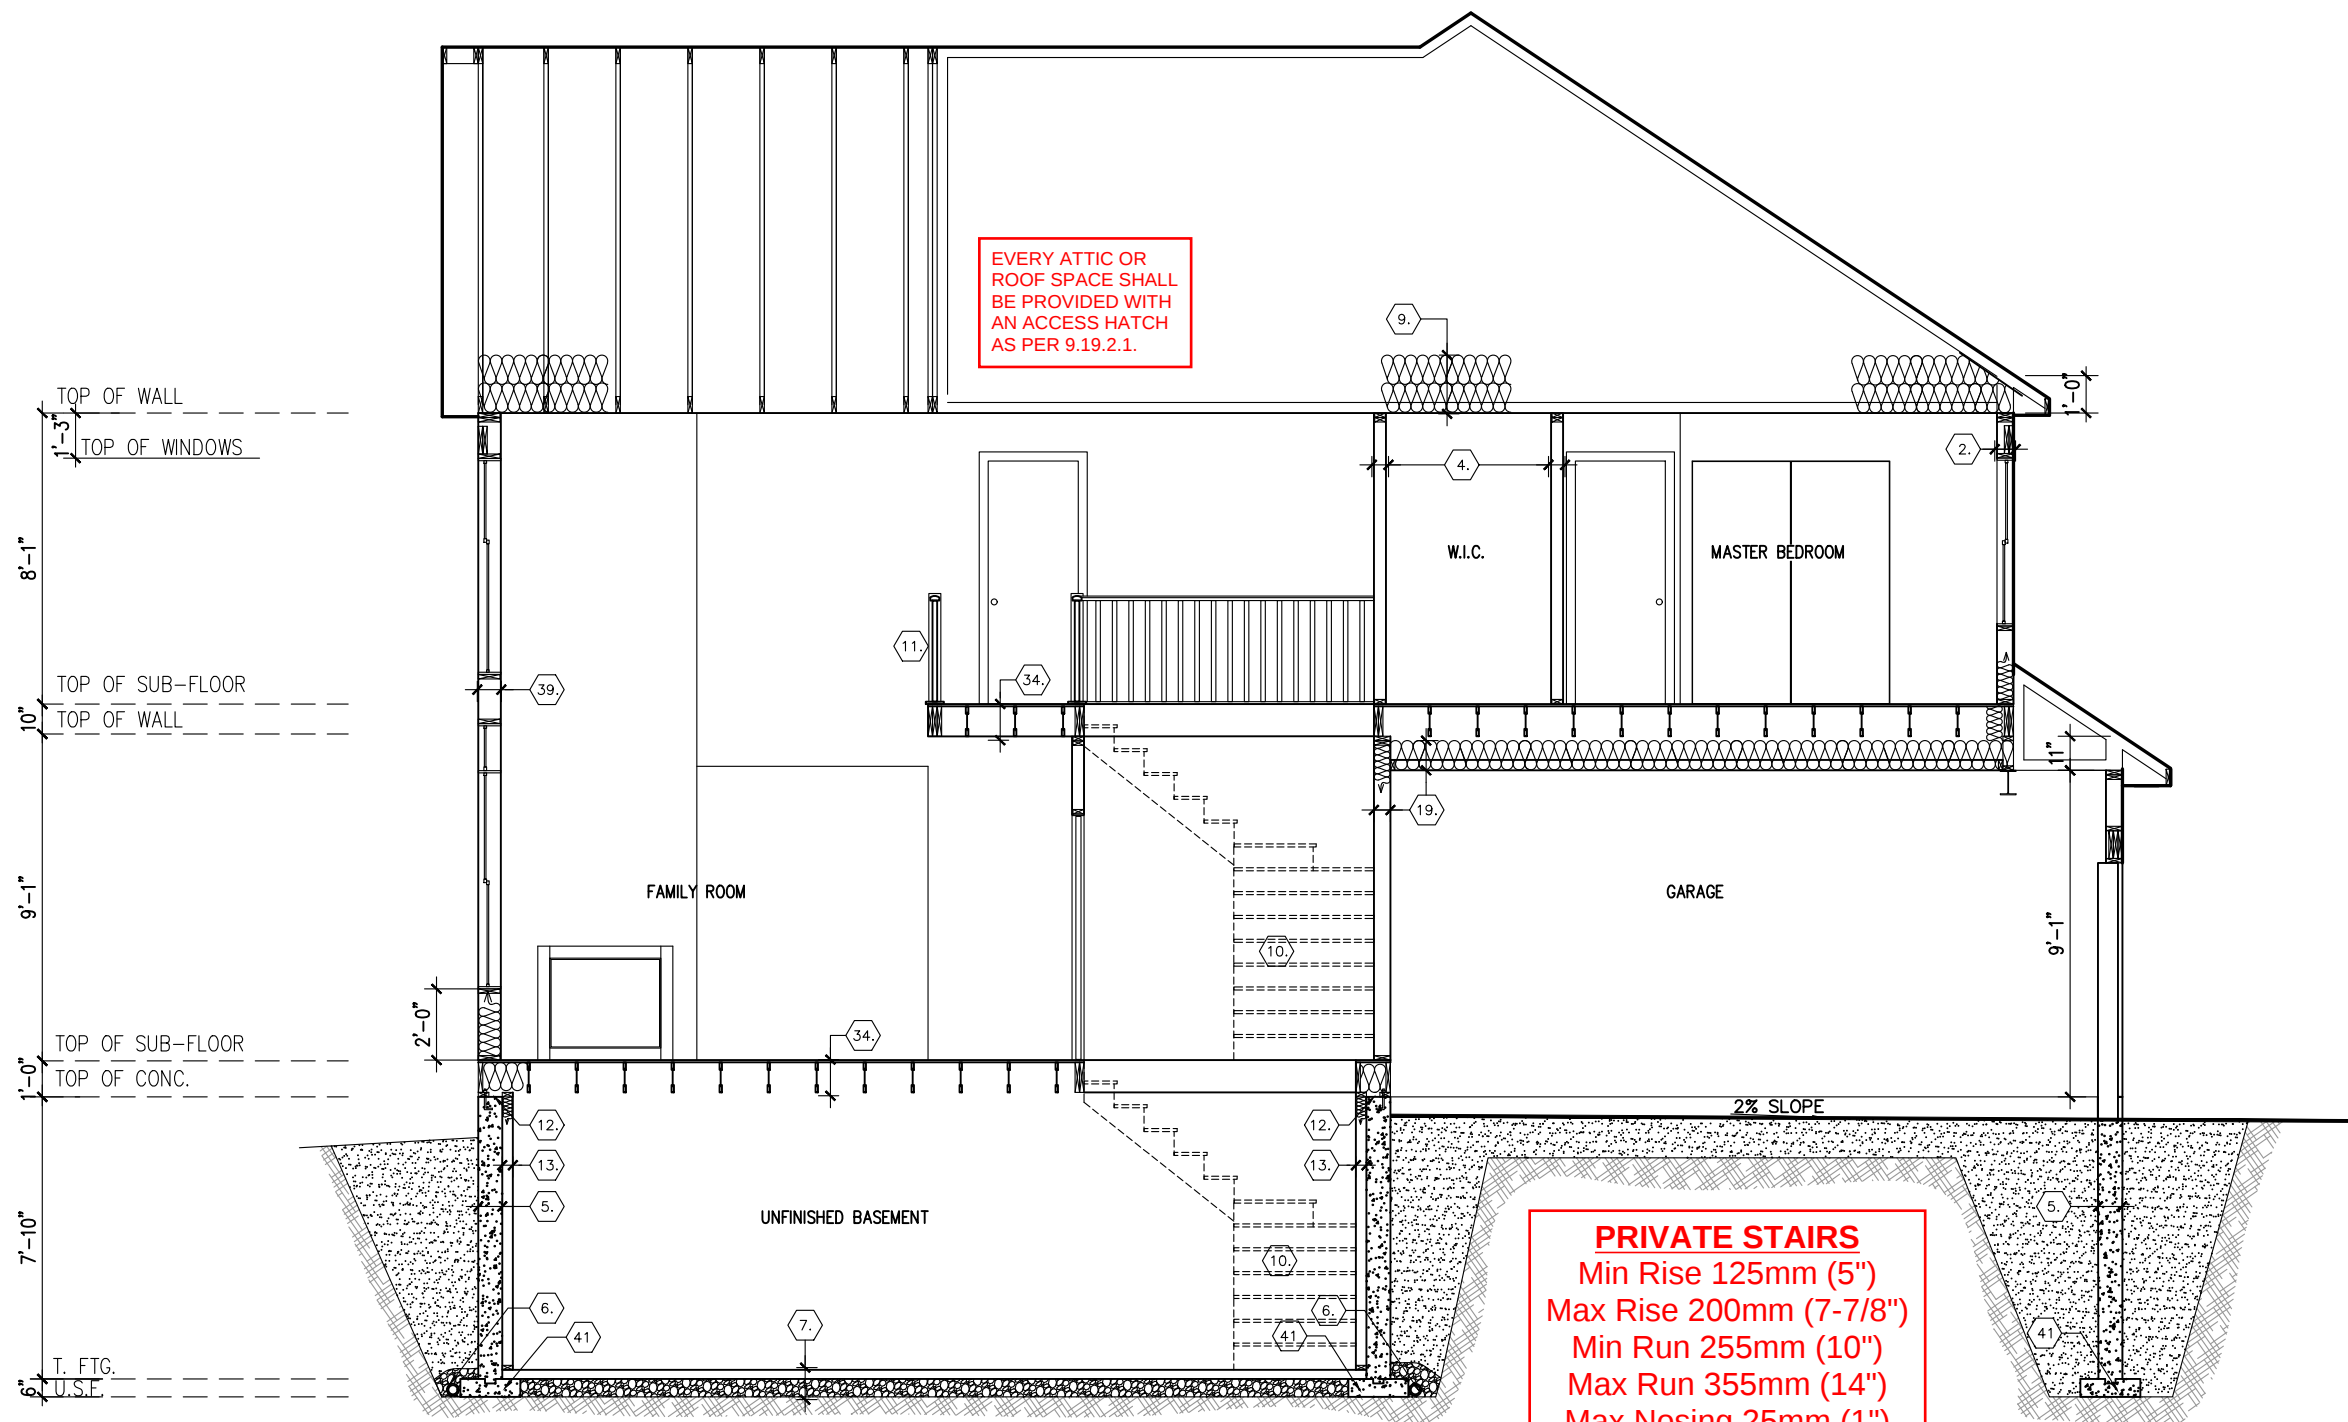

SECTION ELEVATION D



517-RUTHERFORD-2015

SITE: WHITE TAIL RIDGE PH3


LOT NUMBER:

52

CIVIC ADDRESS:  
308 ANTLER COURT

| No.       | Description                       | dd/mm/yy | By |
|-----------|-----------------------------------|----------|----|
| 9         | FINAL BLACKLINES                  | 05/08/22 | CB |
| 8         | ISSUED FOR LAYOUTS                | 13/06/22 | SP |
| 7         | BEP BLACKLINES                    | 18/05/22 | KE |
| 6         | TUB CHANGED TO MAAX EXHIBIT 60X32 | 09/02/21 | CB |
| 5         | UPDATE BASEMENT WINDOWS           | 01/09/19 | SP |
| REVISIONS |                                   |          |    |

|                    |        |
|--------------------|--------|
| footprint: 517     |        |
| designed by: TL    |        |
| drawn by: SP       |        |
| date: NOV/15       |        |
| scale: 3/16"=1'-0" |        |
| D.C.L.-193         | sheet  |
| sheet title: A8d   | 9 of 9 |

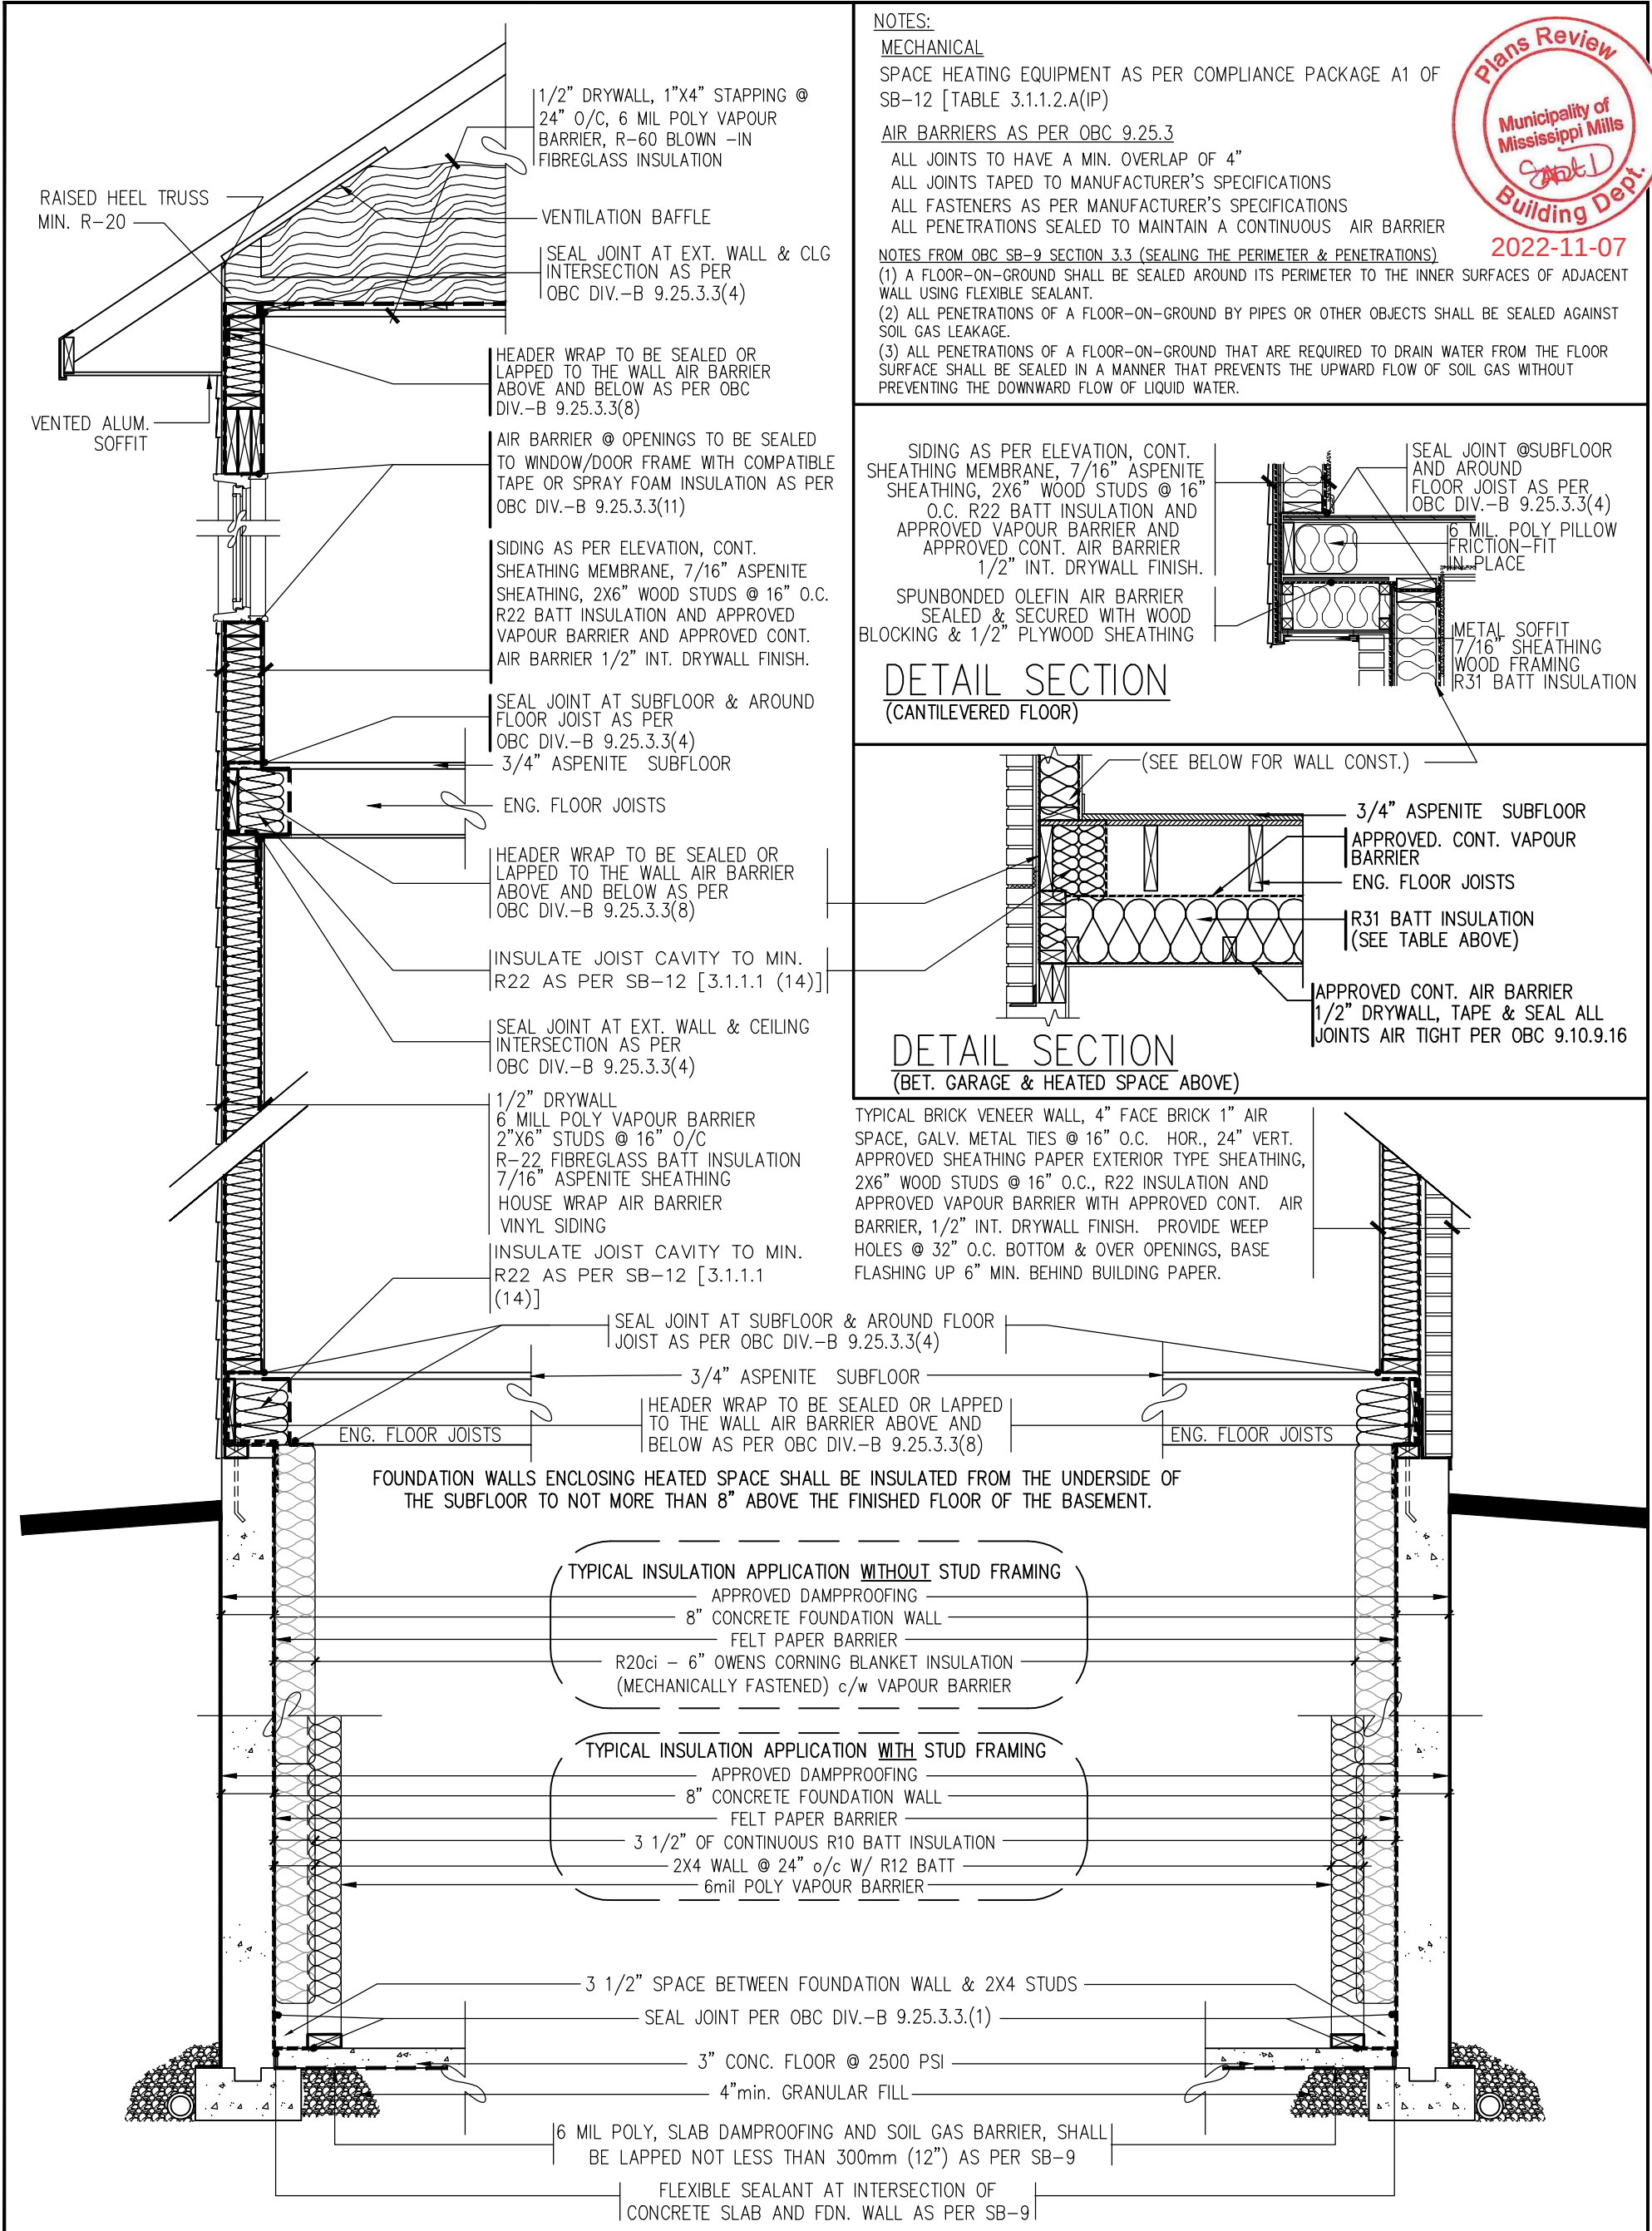

NOTES:

MECHANICAL

SPACE HEATING EQUIPMENT AS PER COMPLIANCE PACKAGE A1 OF SB-12 [TABLE 3.1.1.2.A(IP)]

AIR BARRIERS AS PER OBC 9.25.3

ALL JOINTS TO HAVE A MIN. OVERLAP OF 4"

ALL JOINTS TAPED TO MANUFACTURER'S SPECIFICATIONS

ALL FASTENERS AS PER MANUFACTURER'S SPECIFICATIONS

ALL PENETRATIONS SEALED TO MAINTAIN A CONTINUOUS AIR BARRIER

NOTES FROM OBC SB-9 SECTION 3.3 (SEALING THE PERIMETER & PENETRATIONS)

(1) A FLOOR-ON-GROUND SHALL BE SEALED AROUND ITS PERIMETER TO THE INNER SURFACES OF ADJACENT WALL USING FLEXIBLE SEALANT.

(2) ALL PENETRATIONS OF A FLOOR-ON-GROUND BY PIPES OR OTHER OBJECTS SHALL BE SEALED AGAINST SOIL GAS LEAKAGE.

(3) ALL PENETRATIONS OF A FLOOR-ON-GROUND THAT ARE REQUIRED TO DRAIN WATER FROM THE FLOOR SURFACE SHALL BE SEALED IN A MANNER THAT PREVENTS THE UPWARD FLOW OF SOIL GAS WITHOUT PREVENTING THE DOWNWARD FLOW OF LIQUID WATER.



2022-11-07

SIDING AS PER ELEVATION, CONT.  
SHEATHING MEMBRANE, 7/16" ASPENITE  
SHEATHING, 2X6" WOOD STUDS @ 16"  
O.C. R22 BATT INSULATION AND  
APPROVED VAPOUR BARRIER AND  
APPROVED CONT. AIR BARRIER  
1/2" INT. DRYWALL FINISH.

SPUNBONDED OLEFIN AIR BARRIER  
SEALED & SECURED WITH WOOD  
BLOCKING & 1/2" PLYWOOD SHEATHING

DETAIL SECTION  
(CANTILEVERED FLOOR)

SEAL JOINT @SUBFLOOR  
AND AROUND  
FLOOR JOIST AS PER  
OBC DIV.-B 9.25.3.3(4)  
6 MIL. POLY PILLLOW  
FRICTION-FIT  
IN PLACE  
METAL SOFFIT  
7/16" SHEATHING  
WOOD FRAMING  
R31 BATT INSULATION


(SEE BELOW FOR WALL CONST.)  
3/4" ASPENITE SUBFLOOR  
APPROVED. CONT. VAPOUR  
BARRIER  
ENG. FLOOR JOISTS  
R31 BATT INSULATION  
(SEE TABLE ABOVE)

DETAIL SECTION  
(BET. GARAGE & HEATED SPACE ABOVE)

TYPICAL BRICK VENEER WALL, 4" FACE BRICK 1" AIR  
SPACE, GALV. METAL TIES @ 16" O.C. HOR., 24" VERT.  
APPROVED SHEATHING PAPER EXTERIOR TYPE SHEATHING,  
2X6" WOOD STUDS @ 16" O.C., R22 INSULATION AND  
APPROVED VAPOUR BARRIER WITH APPROVED CONT. AIR  
BARRIER, 1/2" INT. DRYWALL FINISH. PROVIDE WEEP  
HOLES @ 32" O.C. BOTTOM & OVER OPENINGS, BASE  
FLASHING UP 6" MIN. BEHIND BUILDING PAPER.

TYP. DETAIL SECTION (PARTIAL)  
FOR SIDING APPLICATION

TYP. DETAIL SECTION (PARTIAL)  
FOR BRICK VENEER APPLICATION

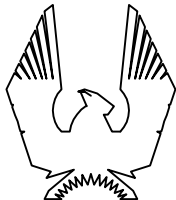

PHOENIX HOMES

SB-12 COMPLIANCE PACKAGE  
DETAILS (ALL MODELS)

| No.       | Description                         | Date       | By |
|-----------|-------------------------------------|------------|----|
| 4         | SB-12 - 2022 UPDATE                 | JAN - 2022 | SP |
| 3         | SB-12 - 2017 UPDATE                 | JAN - 2017 | SP |
| 2         | ADDED CANTILEVERED FLOOR DETAIL     | MAR28-12   | TL |
| 1         | OBC SB-9 & SB-12 COMPLIANCE PACKAGE | JAN22-12   | TL |
| REVISIONS |                                     |            |    |

footprint:


drawn by: SP

date:

scale: N/A

sheet no:

SB-12  
DETAILS

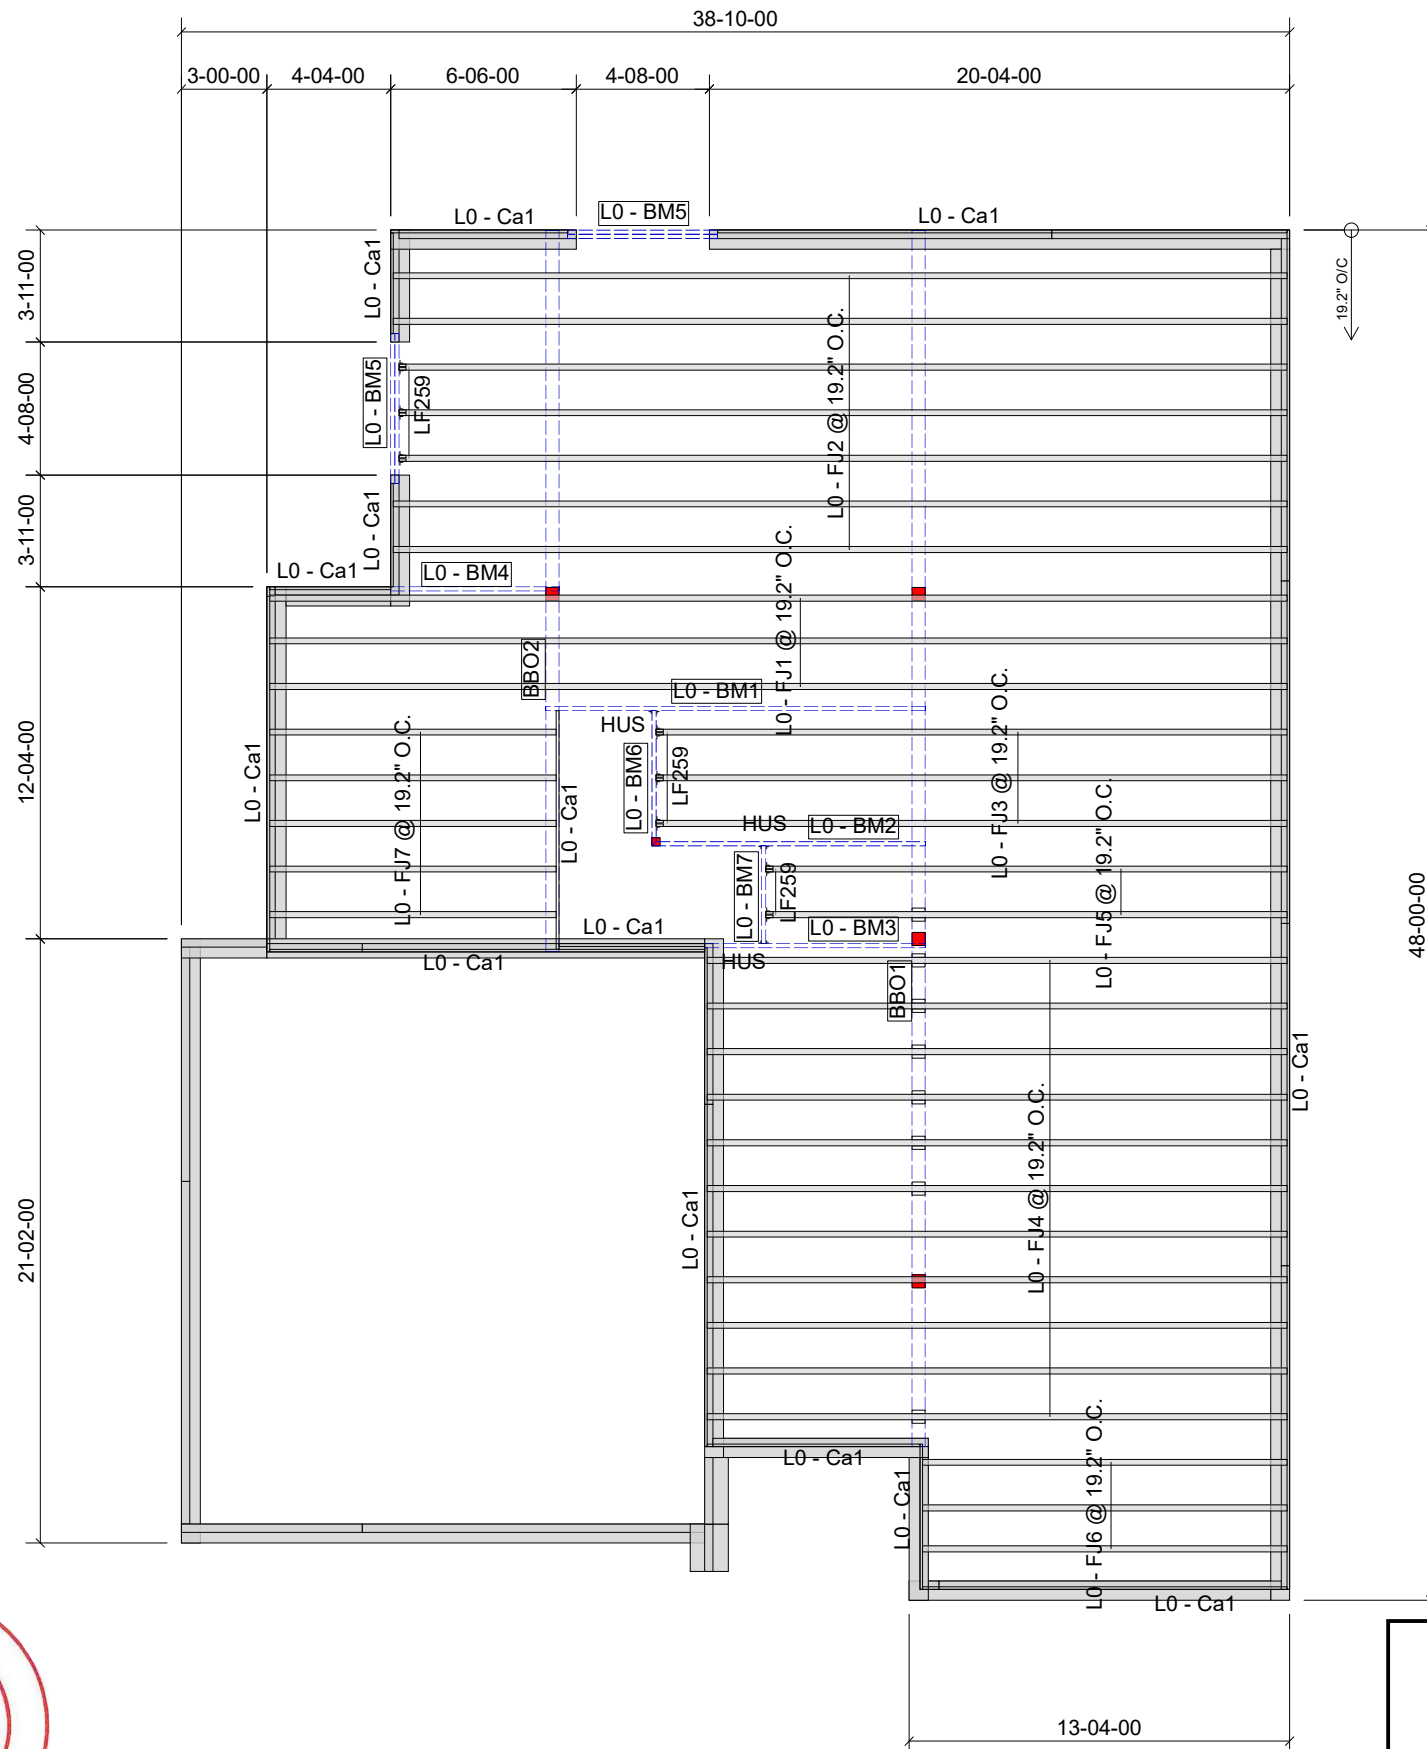

ANY OPENINGS IN FLOOR WEB FOR PLUMBING, HVAC AND ELECTRICAL TO MEET THE MANUFACTURER'S SPECS. P.ENG REPAIRS MAY BE REQUIRED IF HOLES ARE TOO LARGE, TOO CLOSE TOGETHER OR TOO CLOSE TO THE EDGES

GLUED AND NAILED

| LEVEL AND FLOOR CONTAINER NOTES     |                                    |
|-------------------------------------|------------------------------------|
| Current Date:                       | 7/7/2022                           |
| File Name:                          | WTR3-52 Rutherford D.mmdl          |
| Level Name:                         | 1st Floor                          |
| Building Code - Design Methodology: | NBCC 2015                          |
| Floor Container:                    | FC1                                |
| Floor Area Loading is:              | 40 Live Load & 15 Dead Load        |
| Maximum Allowed Deflection          | L/480 Live Load & L/240 Total Load |

| Products              |          |                                            |       |         |          |
|-----------------------|----------|--------------------------------------------|-------|---------|----------|
| PlotID                | Length   | Product                                    | Plies | Net Qty | Fab Type |
| L0 - FJ1 @ 19.2" O.C. | 36-00-00 | 9 1/2" NI-20                               | 1     | 3       | MFD      |
| L0 - FJ2 @ 19.2" O.C. | 32-00-00 | 9 1/2" NI-20                               | 1     | 7       | MFD      |
| L0 - FJ3 @ 19.2" O.C. | 24-00-00 | 9 1/2" NI-20                               | 1     | 3       | MFD      |
| L0 - FJ4 @ 19.2" O.C. | 22-00-00 | 9 1/2" NI-20                               | 1     | 11      | MFD      |
| L0 - FJ5 @ 19.2" O.C. | 19-00-00 | 9 1/2" NI-20                               | 1     | 2       | MFD      |
| L0 - FJ6 @ 19.2" O.C. | 13-00-00 | 9 1/2" NI-20                               | 1     | 3       | MFD      |
| L0 - FJ7 @ 19.2" O.C. | 11-00-00 | 9 1/2" NI-20                               | 1     | 5       | MFD      |
| L0 - BM1              | 14-00-00 | 1 3/4" x 9 1/2" (2.0E 3100) WestFraser LVL | 1     | 1       | MFD      |
| L0 - BM2              | 10-00-00 | 1 3/4" x 9 1/2" (2.0E 3100) WestFraser LVL | 1     | 1       | MFD      |
| L0 - BM3              | 8-00-00  | 1 3/4" x 9 1/2" (2.0E 3100) WestFraser LVL | 1     | 1       | MFD      |
| L0 - BM4              | 6-00-00  | 1 3/4" x 9 1/2" (2.0E 3100) WestFraser LVL | 1     | 1       | MFD      |
| L0 - BM5              | 6-00-00  | 1 3/4" x 9 1/2" (2.0E 3100) WestFraser LVL | 2     | 4       | MFD      |
| L0 - BM6              | 5-00-00  | 1 3/4" x 9 1/2" (2.0E 3100) WestFraser LVL | 1     | 1       | MFD      |
| L0 - BM7              | 4-00-00  | 1 3/4" x 9 1/2" (2.0E 3100) WestFraser LVL | 1     | 1       | MFD      |
| L0 - Ca1              | 12-00-00 | 1 1/8" x 9 1/2" APA Rim Board              | 1     | 15      | MFD      |

| Accessories |        |                                                                   |       |         |          |
|-------------|--------|-------------------------------------------------------------------|-------|---------|----------|
| PlotID      | Length | Product                                                           | Plies | Net Qty | Fab Type |
|             |        | 3/4" Plywood or OSB (23/32" APA Rated Sheathing 48/24 Exposure 1) | 1     | 40      | MFD      |

| Connector Summary |         |          |      |               |
|-------------------|---------|----------|------|---------------|
| Qty               | Manuf   | Product  | Skew | Supported Mtl |
| 8                 | SIMPSON | LF259    | -    | 9 1/2" NI-20  |
| 3                 | SIMPSON | HUS18110 | -    | 9 1/2" WF LVL |

PROVIDE A COMPLETE PACKAGE OF SEALED TRUSS AND FLOOR PLANS PRIOR TO THE FRAMING INSPECTION. WIHTOUT THE STAMPED TRUSS AND FLOOR DRAWINGS, THE FRAMING INSPECTION WILL NOT BE CONDUCTED



THIS DESIGN COMPLIES WITH:

- PART 4 OR 9 OF OBC 2012 Reg. 332/12
- NORDIC LAM CCMC: 13216-R
- NORDIC JOISTS CCMC: 13032-R
- WEST FRASER CCMC: 12904

(REFER TO INDIVIDUAL FLOOR DRAWINGS FOR SPECIFIC LOADS & SPACING)


FLOOR NOTES:

- FLOOR JOIST SYSTEMS ABOVE THE GARAGE HAS BEEN DESIGNED WITHOUT A DIRECTLY APPLIED CEILING. USE APPLICABLE BLOCKING OR STRAPPING WHERE REQUIRED AS INDICATED ON THE FRAMING PLAN.
- BLOCKING MATERIAL WILL BE SUPPLIED AND INDICATED AS "BLOCKING". NO LONGER ONLY 12' LENGTHS.



JOB:  
PHOENIX HOMES  
WHITE TAIL RIDGE  
LOT WTR3-52  
RUTHERFORD D  
1ST FLOOR 1 OF 2

DATE: 7/7/2022

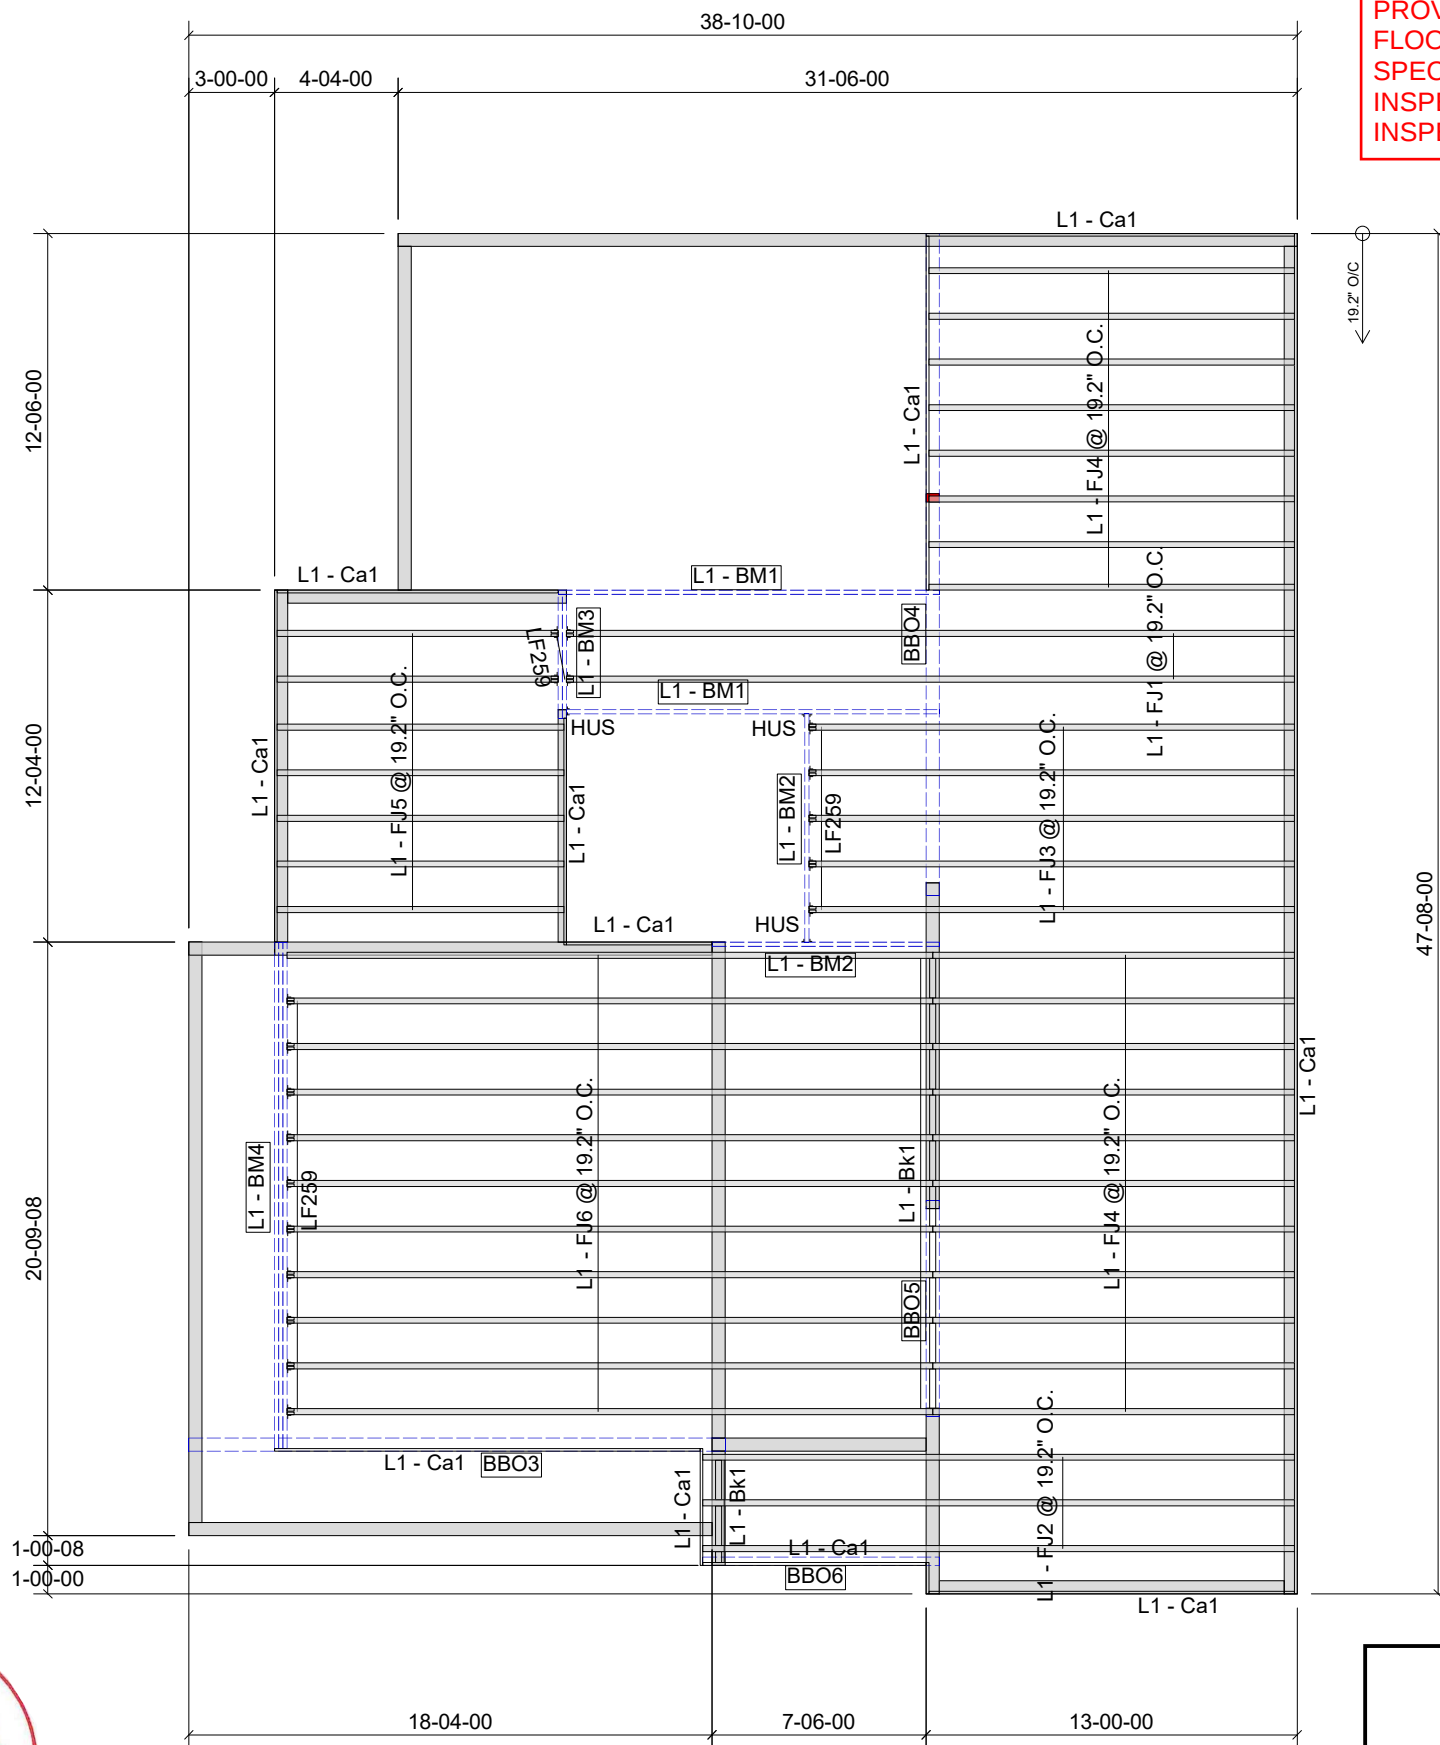

PROVIDE P.ENG APPROVED  
FLOOR DRAWINGS AND  
SPECIFICATIONS TO BUILDING  
INSPECTOR AT FRAMING  
INSPECTION

DETAILS SEALED BY A P.ENG ARE REQUIRED  
FOR THE LVL BEAMS ON FRAMING INSPECTION

GLUED AND NAILED

| LEVEL AND FLOOR CONTAINER NOTES     |                                    |
|-------------------------------------|------------------------------------|
| Current Date:                       | 7/7/2022                           |
| File Name:                          | WTR3-52 Rutherford D.mmdl          |
| Level Name:                         | 2nd Floor                          |
| Building Code - Design Methodology: | NBCC 2015                          |
| Floor Container:                    | FC2                                |
| Floor Area Loading is:              | 40 Live Load & 15 Dead Load        |
| Maximum Allowed Deflection          | L/480 Live Load & L/240 Total Load |

| Products              |          |                                            |       |         |          |
|-----------------------|----------|--------------------------------------------|-------|---------|----------|
| PlotID                | Length   | Product                                    | Plies | Net Qty | Fab Type |
| L1 - FJ1 @ 19.2" O.C. | 26-00-00 | 9 1/2" NI-20                               | 1     | 2       | MFD      |
| L1 - FJ2 @ 19.2" O.C. | 22-00-00 | 9 1/2" NI-20                               | 1     | 3       | MFD      |
| L1 - FJ3 @ 19.2" O.C. | 18-00-00 | 9 1/2" NI-20                               | 1     | 5       | MFD      |
| L1 - FJ4 @ 19.2" O.C. | 13-00-00 | 9 1/2" NI-20                               | 1     | 19      | MFD      |
| L1 - FJ5 @ 19.2" O.C. | 11-00-00 | 9 1/2" NI-20                               | 1     | 7       | MFD      |
| L1 - FJ6 @ 19.2" O.C. | 24-00-00 | 9 1/2" NI-40x                              | 1     | 11      | MFD      |
| L1 - BM1              | 14-00-00 | 1 3/4" x 9 1/2" (2.0E 3100) WestFraser LVL | 1     | 2       | MFD      |
| L1 - BM2              | 8-00-00  | 1 3/4" x 9 1/2" (2.0E 3100) WestFraser LVL | 1     | 2       | MFD      |
| L1 - BM3              | 5-00-00  | 1 3/4" x 9 1/2" (2.0E 3100) WestFraser LVL | 2     | 2       | MFD      |
| L1 - BM4              | 18-00-00 | 1 3/4" x 14" (2.0E 3100) WestFraser LVL    | 3     | 3       | MFD      |
| L1 - Ca1              | 12-00-00 | 1 1/8" x 9 1/2" APA Rim Board              | 1     | 2       | FF       |
| L1 - Ca1              | 12-00-00 | 1 1/8" x 9 1/2" APA Rim Board              | 1     | 12      | MFD      |
| L1 - Bk1              | 18-00-00 | 9 1/2" NI-20                               | 1     | 1       | MFD      |

| Accessories |        |                                                                   |       |         |          |
|-------------|--------|-------------------------------------------------------------------|-------|---------|----------|
| PlotID      | Length | Product                                                           | Plies | Net Qty | Fab Type |
|             |        | 3/4" Plywood or OSB (23/32" APA Rated Sheathing 48/24 Exposure 1) | 1     | 42      | MFD      |

| Connector Summary |         |          |      |               |
|-------------------|---------|----------|------|---------------|
| Qty               | Manuf   | Product  | Skew | Supported Mt  |
| 20                | SIMPSON | LF259    | -    | 9 1/2" NI-20  |
| 3                 | SIMPSON | HUS18110 | -    | 9 1/2" WF LVL |

THIS DESIGN COMPLIES WITH:

- PART 4 OR 9 OF OBC 2012 Reg. 332/12
- NORDIC LAM CCMC: 13216-R
- NORDIC JOISTS CCMC: 13032-R
- WEST FRASER CCMC: 12904

(REFER TO INDIVIDUAL FLOOR DRAWINGS  
FOR SPECIFIC LOADS & SPACING)

FLOOR NOTES:

- FLOOR JOIST SYSTEMS ABOVE THE GARAGE HAS BEEN DESIGNED WITHOUT A DIRECTLY APPLIED CEILING. USE APPLICABLE BLOCKING OR STRAPPING WHERE REQUIRED AS INDICATED ON THE FRAMING PLAN.
- BLOCKING MATERIAL WILL BE SUPPLIED AND INDICATED AS "BLOCKING". NO LONGER ONLY 12' LENGTHS.



GRANDOR  
LUMBER INC.


JOB:  
PHOENIX HOMES  
WHITE TAIL RIDGE  
LOT WTR3-52  
RUTHERFORD D  
2ND FLOOR 2 OF 2

DATE: 7/7/2022



2022-11-07


PROVIDE P.ENG APPROVED TRUSS  
DRAWINGS AND SPECIFICATIONS  
TO BUILDING INSPECTOR AT  
FRAMING INSPECTION

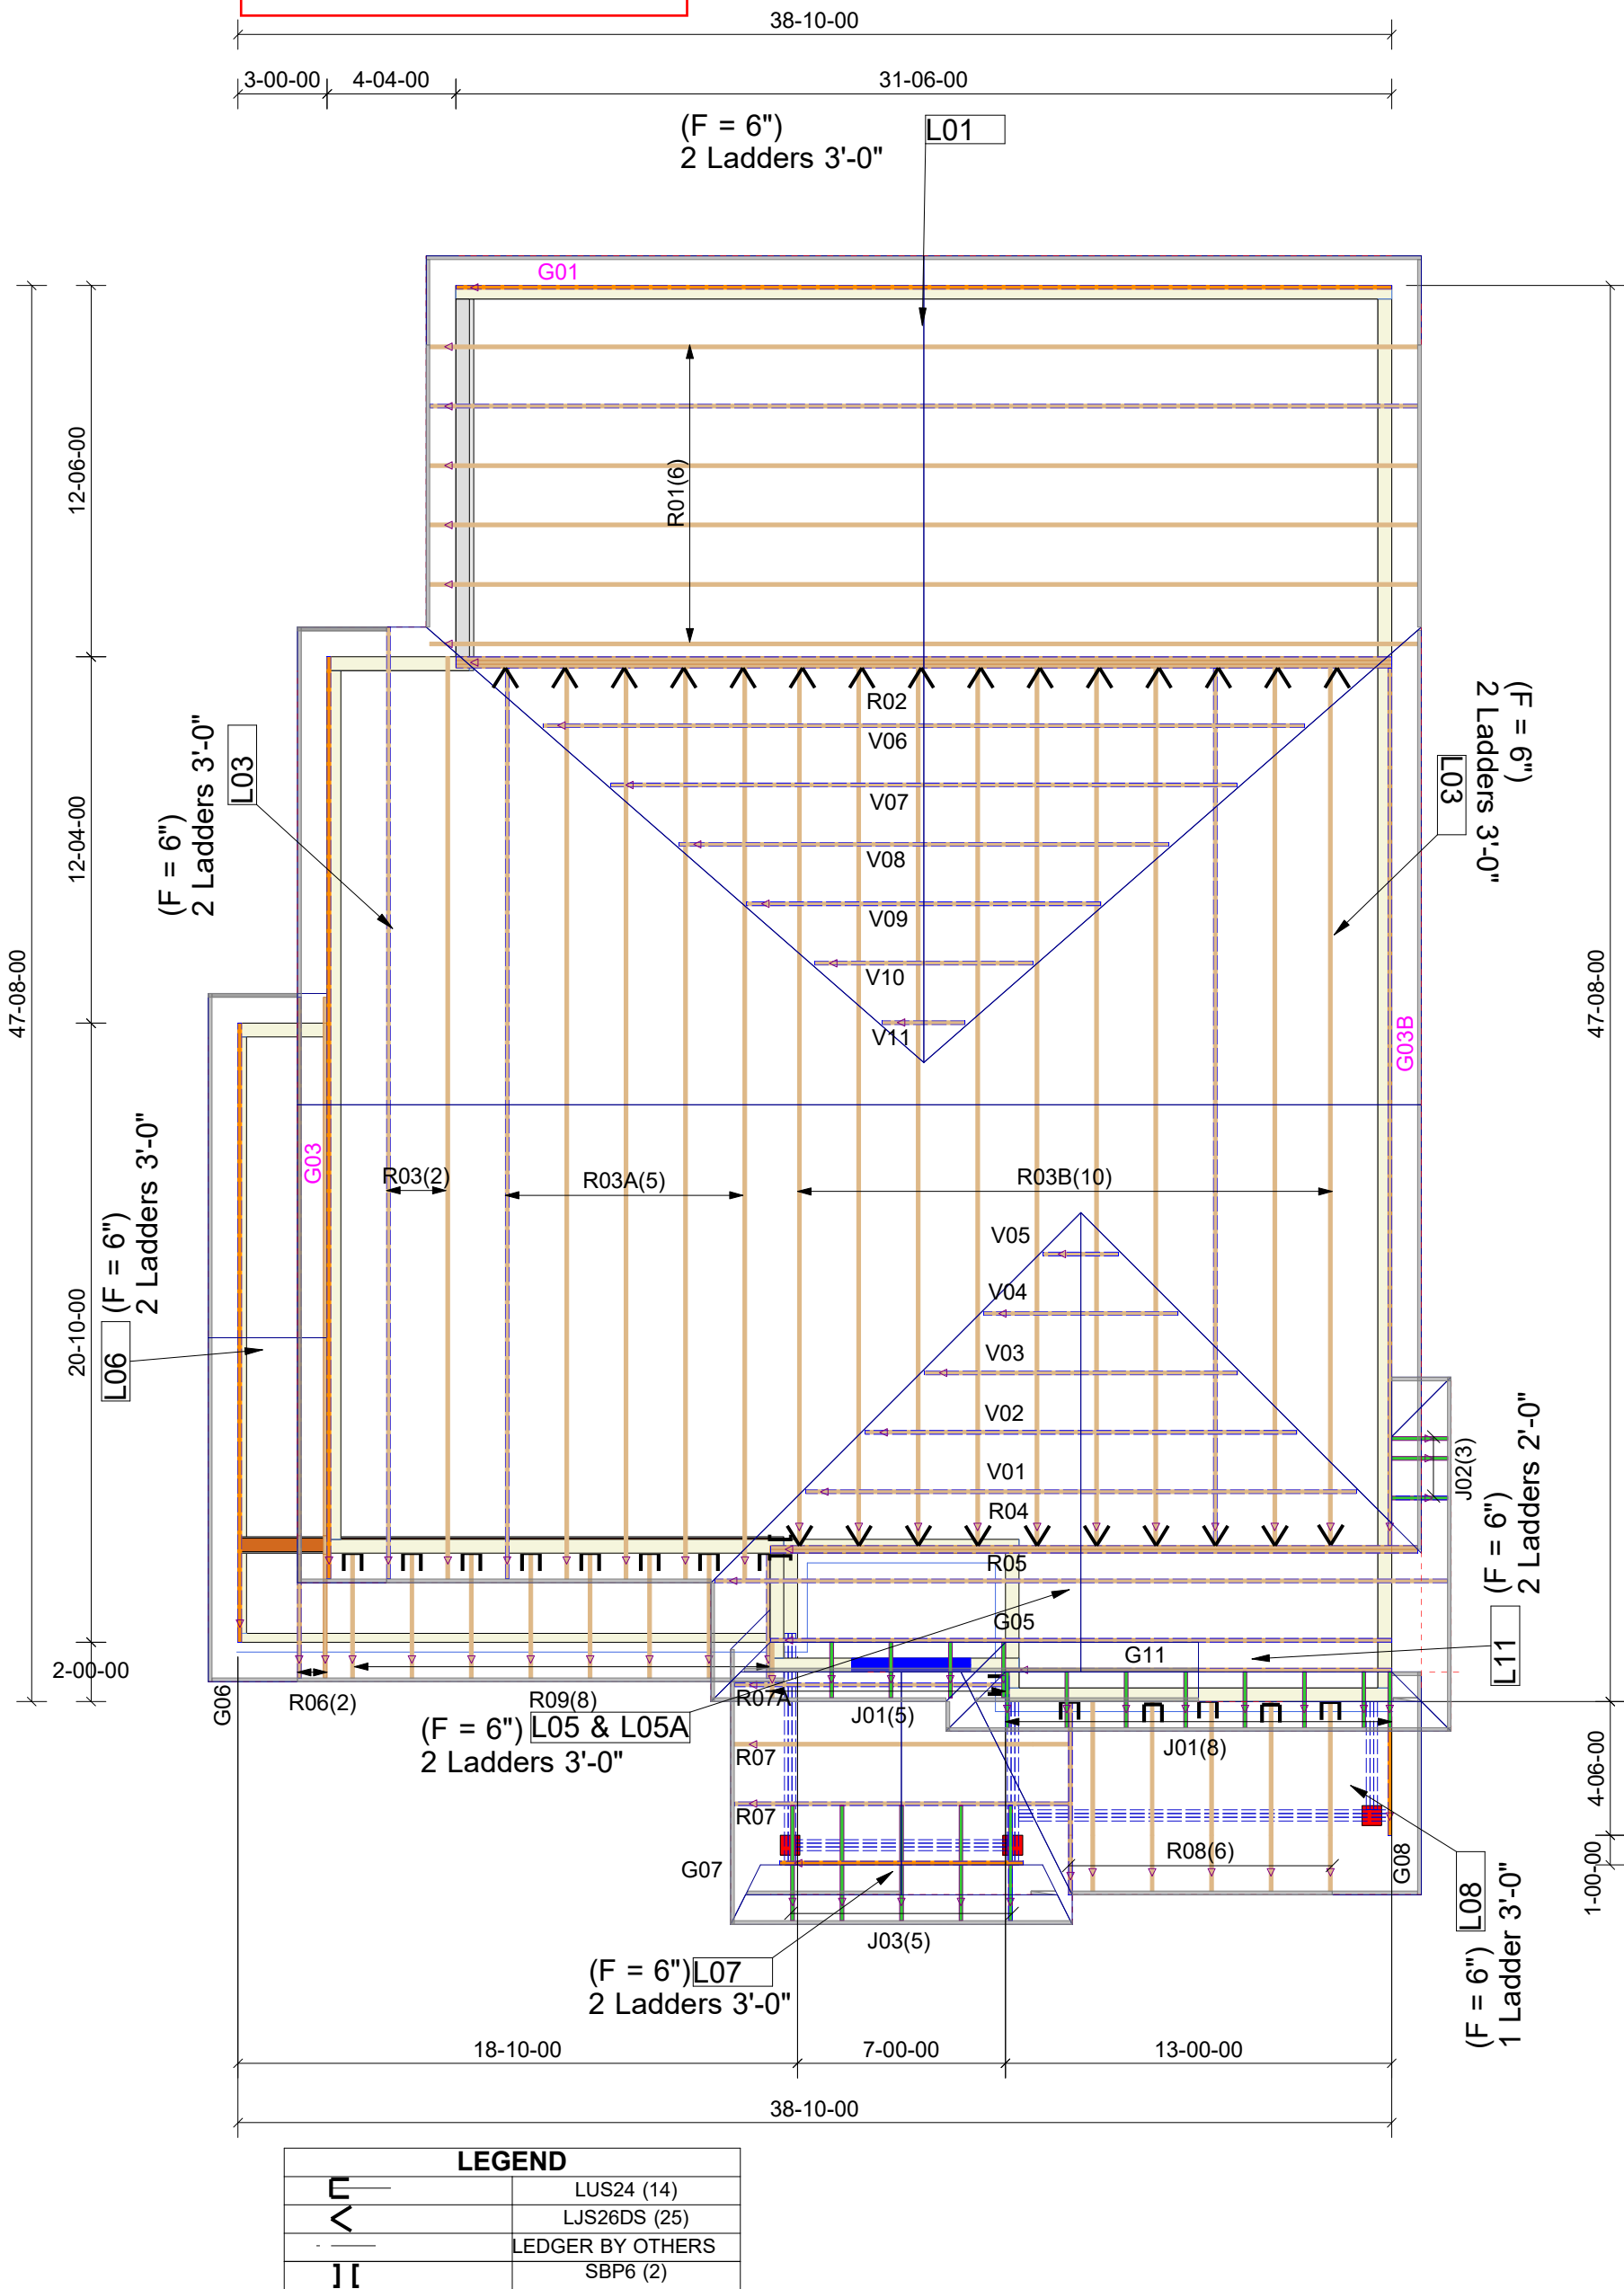


| TYPICAL OTTAWA DESIGN LOADS |           |      |      | THIS DESIGN COMPLIES WITH:                                                                                         |   | HURRICANE AND SEISMIC TIES: |                                                                                   |
|-----------------------------|-----------|------|------|---|---|-----------------------------|-----------------------------------------------------------------------------------|
| Member                      | Load Type | PT 9 | PT 4 | - PART 4 OR 9 OF OBC 2012 Reg. 332/12<br>- CSA 086-09<br>- CCMC ACCEPTANCE 11996-L, 0319-L, 13270-L<br>- TPIC 2011 | - ANY TIES SPECIFIED ON THIS LAYOUT FOR UPLIFT OR SEISMIC CONNECTIONS MUST BE REVIEWED AND APPROVED BY THE BUILDING DESIGNER/ENGINEER, AS STATED IN THE TPIC 2011. THE TRANSFER OF THESE LOADS TO THE ENTIRE STRUCTURE BELOW HAS NOT BEEN ANALYZED. |                             | JOB:<br>PHOENIX HOMES<br>DIAMOND VIEW ESTATE<br>RUTHERFORD "D"<br>PRUTD-3 WTR3-52 |
|                             |           |      |      |   |   |                             |                                                                                   |
| Top Chord                   | Snow      | 37.1 | 50   | (REFER TO INDIVIDUAL TRUSS DRAWINGS FOR SPECIFIC LOADS & SPACING)                                                  |   |                             |                                                                                   |
|                             | Dead      | 3    | 5-10 |   |   |                             |                                                                                   |
| Bot Chord                   | Live      | 0    | 10   |   |   |                             |                                                                                   |
|                             | Dead      | 7    | 7    |   |   |                             |                                                                                   |

TYPICAL SPACING = 24.0 IN C/C

DATE: 7/6/2022

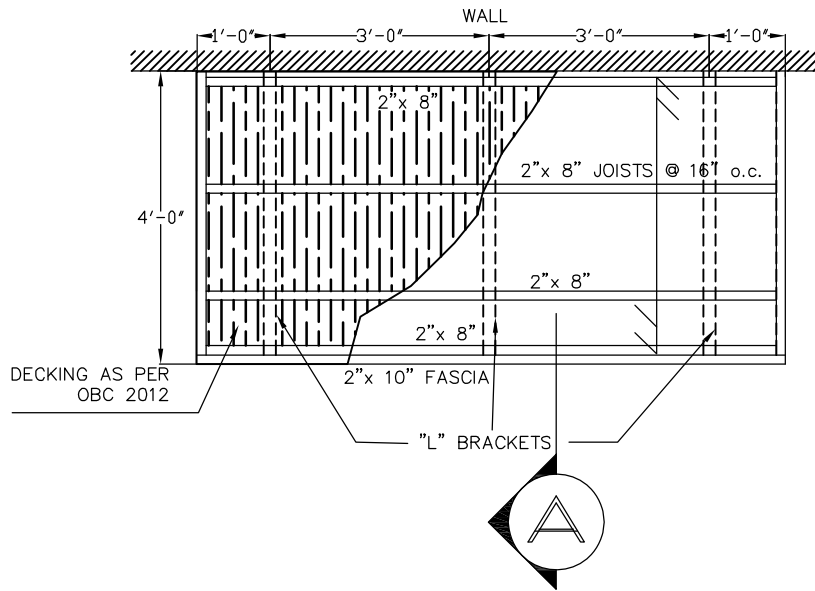

## PLAN

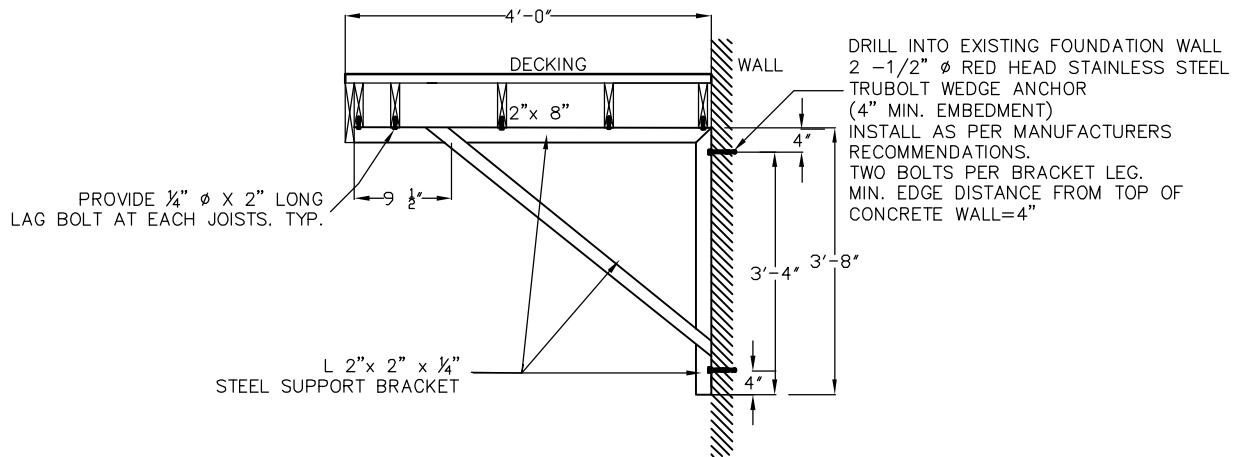

## SECTION 'A'



2022-11-07

### NOTES:

- STEEL
- ALL STRUCTURAL STEEL WORK INCLUDING DESIGN OF ALL COMPONENTS SHALL BE CARRIED OUT IN ACCORDANCE WITH CAN/CSA-S16-09.
- HOLLOW STRUCTURAL SECTIONS TO CAN/CSA G40.20 GRADE 350, CLASS C OF H.
- STRUCTURAL STEEL SHALL CONFORM TO CAN/CSA G40.21 GRADE 300W
- ALL WORK SHALL CONFORM OBC 2012
- CONTRACTOR TO VERIFY ALL DIMENSIONS ON SITE.
- FOR ADDITIONAL INFORMATION, SEE ENGINEERING DWGS.
- ALL HARDWARE TO BE HOT-DIP GALVANIZED
- CONCRETE MIN. STRENGTH: 25 MPA

| No. | Revision | Date | By |
|-----|----------|------|----|
|     |          |      |    |
|     |          |      |    |
**Estructura Inc.**

TEL: (819) 918-4382  
EMAIL: estructurainc@yahoo.com



|              |                             |             |
|--------------|-----------------------------|-------------|
| Client       | CUT RITE CONSTRUCTION       |             |
| Project Name | DECK CONNECTION 4'-0"x8'-0" |             |
| Drawn By     | DS                          | Checked By  |
| Project No.  |                             | Scale       |
| Date         | DECEMBER 2019               | N.T.S.      |
| File Name    |                             | Drawing No. |
|              |                             | SK-1        |

Contractor must verify all dimensions on the job and report any discrepancy to the architect before proceeding with the work.  
All drawings and specifications are instruments of service and the property of the architect which must be returned at the completion of the work. Drawings are NOT to be scaled.


Furn GMEC960603BNA

Plenum 63" & CAB 10"x23 3/4" x5

| Description                                      |
|--------------------------------------------------|
| 210121.1AR Rutherford 4-Bed WRT2-26              |
| 210419.1AR WTR-27 Rutherford Std 4Bed-Air Kit-WO |
| 210924.2AR 4Permit 517 Rutherford 4Bed           |

\*\*NOTE\*\*  
ALL WINDOW UNITS TO BE 2-2X10  
W/ P2 POSTS ON EACH SIDE U.N.O.

| Heat Loss       |            |            |            |
|-----------------|------------|------------|------------|
| Room Name       | Htg<br>cfm | Clg<br>cfm | Htg<br>btu |
| 1-BREAKFAST     | 79.        | 90.        | 3165.      |
| 1-DININGROOM    | 34.        | 16.        | 1377.      |
| 1-FAMILYROOM    | 189.       | 280.       | 7565.      |
| 1-FOYER         | 62.        | 12.        | 2473.      |
| 1-KITCHEN       | 19.        | 196.       | 768.       |
| 1-MUDROOM       | 35.        | 8.         | 1402.      |
| 1-OFFICE        | 70.        | 64.        | 2810.      |
| 1-PDRM          | 18.        | 7.         | 714.       |
| 1-STAIRS        | 7.         | 2.         | 292.       |
| 2-BEDROOM 2     | 65.        | 59.        | 2597.      |
| 2-BEDROOM 3     | 33.        | 17.        | 1339.      |
| 2-BEDROOM 4     | 65.        | 47.        | 2611.      |
| 2-ENSUITE       | 34.        | 24.        | 1371.      |
| 2-ENSUITE 2     | 41.        | 35.        | 1646.      |
| 2-ENSUITE 3     | 22.        | 12.        | 880.       |
| 2-HALL          | 23.        | 10.        | 932.       |
| 2-LAUNDRY       | 33.        | 19.        | 1303.      |
| 2-MASTERBEDROOM | 78.        | 66.        | 3113.      |
| 2-W.I.C.        | 3.         | 1.         | 115.       |
| BASEMENT        | 259.       | 35.        | 10349.     |
|                 | 1169       | 1000       | 46822      |

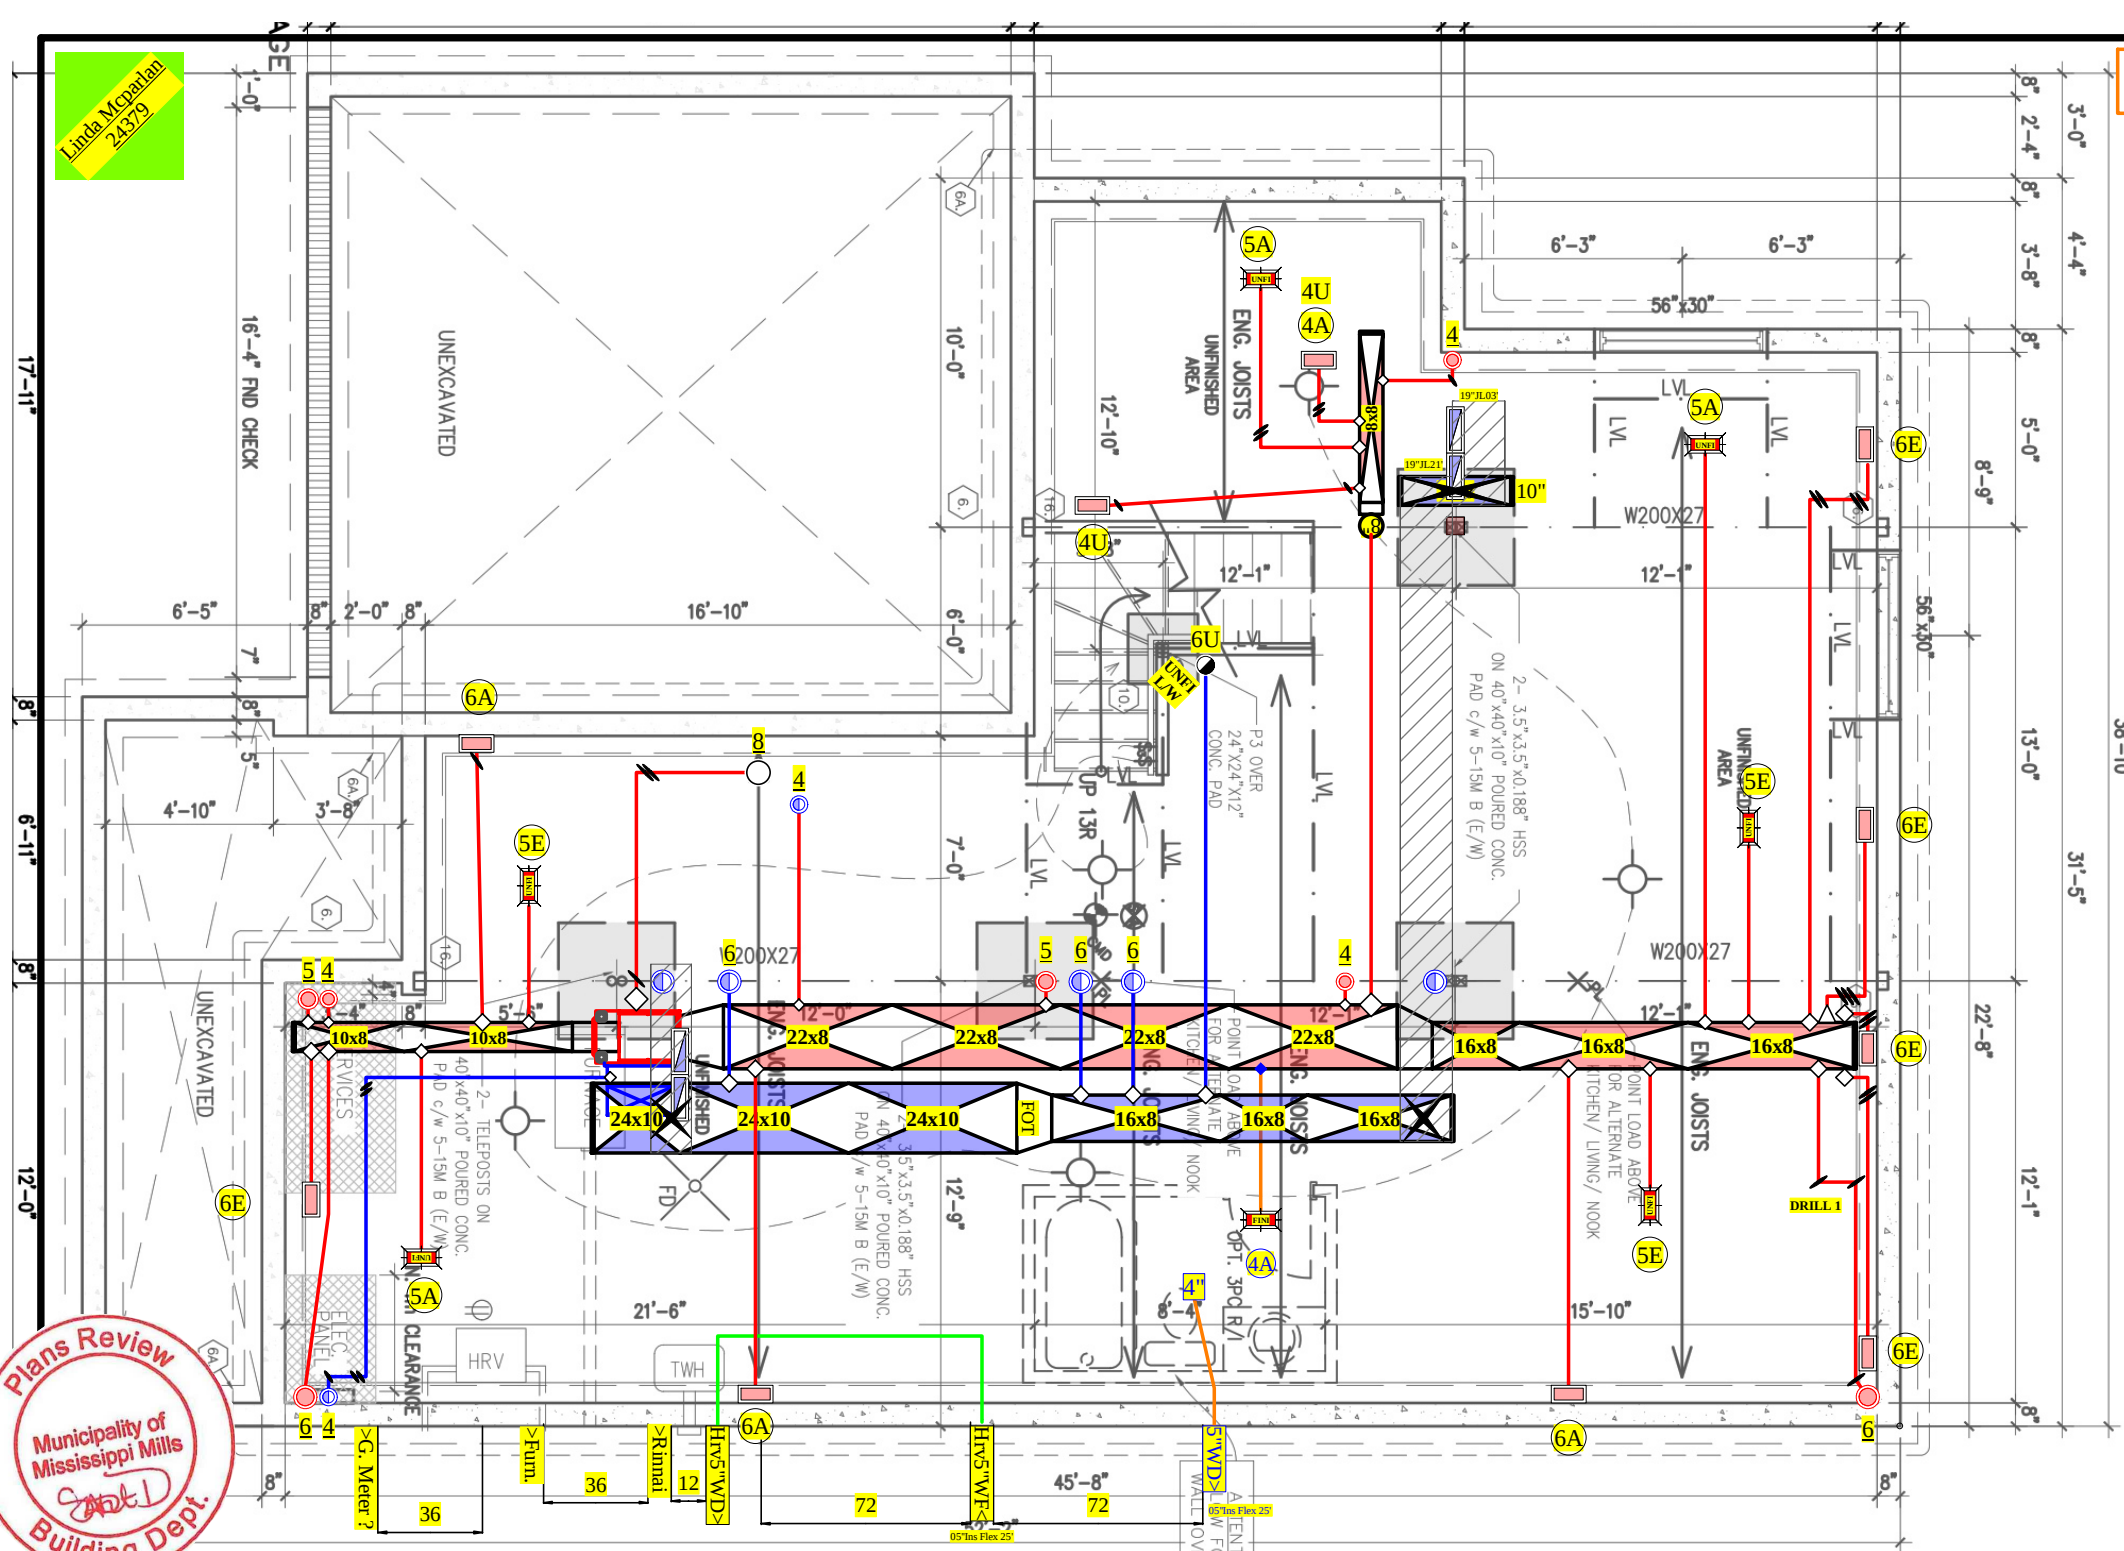


Linda Mcparlan  
24379


Plans Review  
Municipality of  
Mississippi Mills  
Building Dept.

| Description                                       |
|---------------------------------------------------|
| 210121.1AR Rutherford 4+Loft WRT2-26              |
| 210419.1AR WTR-27 Rutherford Std 4Bed+Alt. Kit+WO |
| 210924.2AR 4Permit 517 Rutherford 4Bed            |

| Heat Loss       |         |         |         |
|-----------------|---------|---------|---------|
| Room Name       | Htg cfm | Clg cfm | Htg btu |
| 1-BREAKFAST     | 79.     | 90.     | 3165.   |
| 1-DININGROOM    | 34.     | 16.     | 1377.   |
| 1-FAMILYROOM    | 189.    | 280.    | 7565.   |
| 1-FOYER         | 62.     | 12.     | 2473.   |
| 1-KITCHEN       | 19.     | 196.    | 768.    |
| 1-MUDROOM       | 35.     | 8.      | 1402.   |
| 1-OFFICE        | 70.     | 64.     | 2810.   |
| 1-PDRM          | 18.     | 7.      | 714.    |
| 1-STAIRS        | 7.      | 2.      | 292.    |
| 2-BEDROOM 2     | 65.     | 59.     | 2597.   |
| 2-BEDROOM 3     | 33.     | 17.     | 1339.   |
| 2-BEDROOM 4     | 65.     | 47.     | 2611.   |
| 2-ENSUITE 2     | 34.     | 24.     | 1371.   |
| 2-ENSUITE 2     | 41.     | 35.     | 1646.   |
| 2-ENSUITE 3     | 22.     | 12.     | 880.    |
| 2-HALL          | 23.     | 10.     | 932.    |
| 2-LAUNDRY       | 33.     | 19.     | 1303.   |
| 2-MASTERBEDROOM | 78.     | 66.     | 3113.   |
| 2-W.I.C.        | 3.      | 1.      | 115.    |
| BASEMENT        | 259.    | 35.     | 10349.  |
|                 | 1169    | 1000    | 46822   |

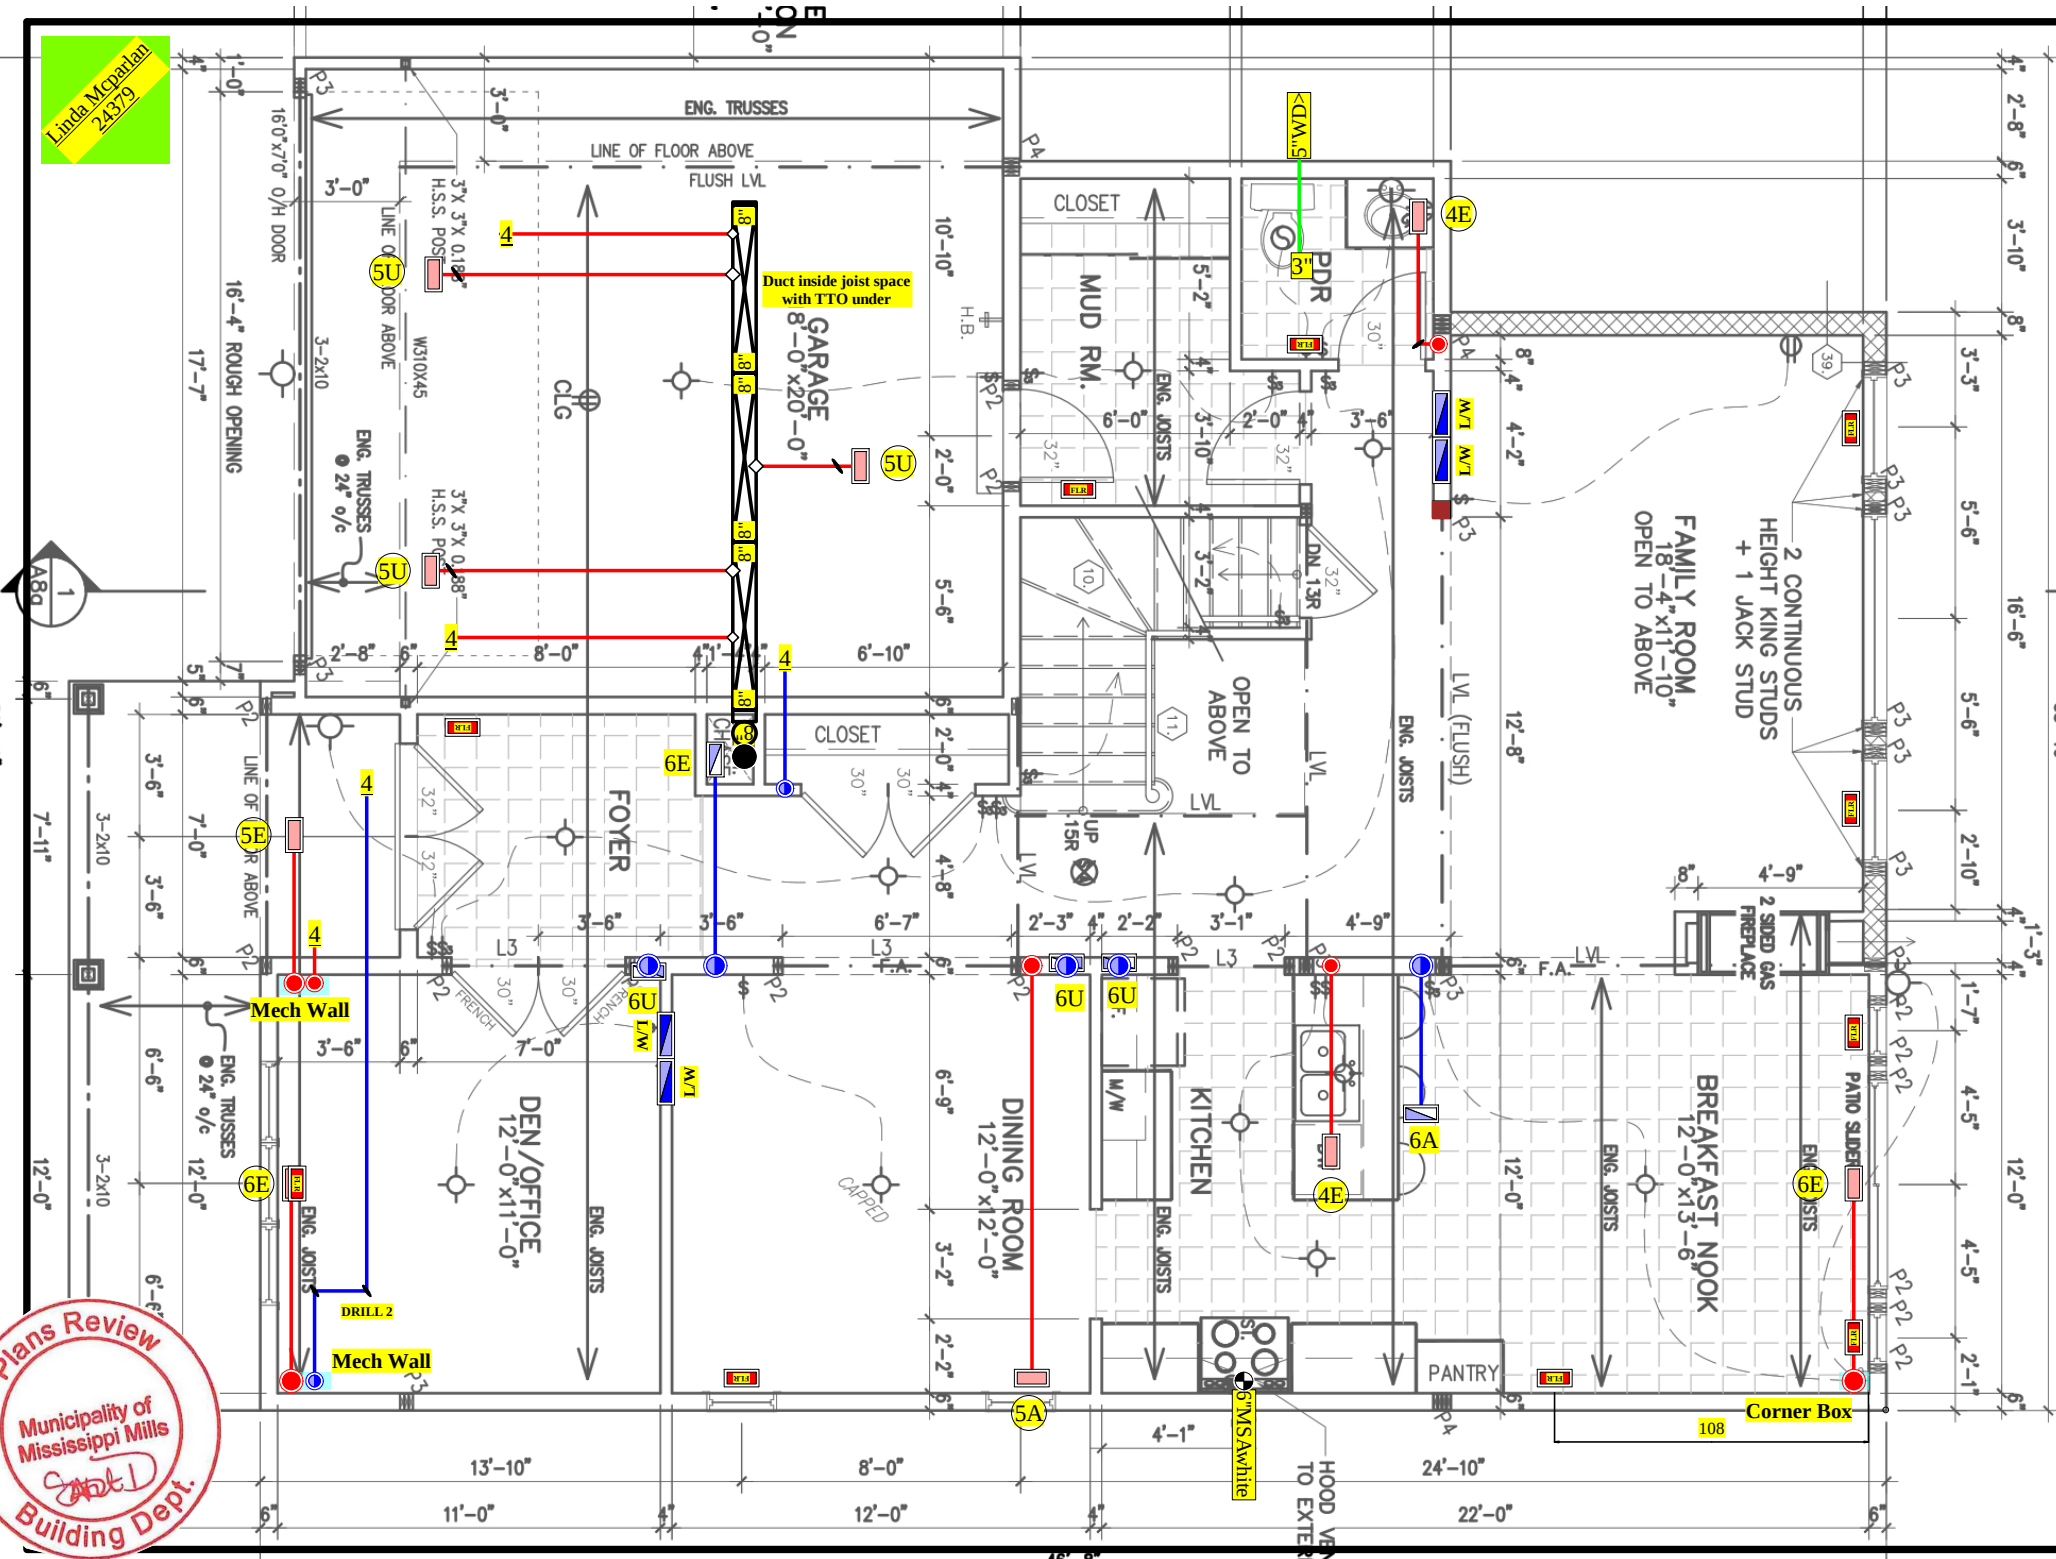

Linda Mcparlan  

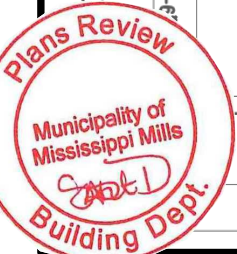

| Description                                        |
|----------------------------------------------------|
| 210121.1AR Rutherford 4+Loft WRT2-26               |
| 210419.1AR WTR-27 Rutherford Strd 4Bed+Alt. Kit+WO |
| 210924.2AR 4Permit 517 Rutherford 4Bed             |

| Heat Loss       |         |         |         |
|-----------------|---------|---------|---------|
| Room Name       | Htg cfm | Clg cfm | Htg btu |
| 1-BREAKFAST     | 79.     | 90.     | 3165.   |
| 1-DININGROOM    | 34.     | 16.     | 1377.   |
| 1-FAMILYROOM    | 189.    | 280.    | 7565.   |
| 1-FOYER         | 62.     | 12.     | 2473.   |
| 1-KITCHEN       | 19.     | 196.    | 768.    |
| 1-MUDROOM       | 35.     | 8.      | 1402.   |
| 1-OFFICE        | 70.     | 64.     | 2810.   |
| 1-PDRM          | 18.     | 7.      | 714.    |
| 1-STAIRS        | 7.      | 2.      | 292.    |
| 2-BEDROOM 2     | 65.     | 59.     | 2597.   |
| 2-BEDROOM 3     | 33.     | 17.     | 1339.   |
| 2-BEDROOM 4     | 65.     | 47.     | 2611.   |
| 2-ENSUITE       | 34.     | 24.     | 1371.   |
| 2-ENSUITE 2     | 41.     | 35.     | 1646.   |
| 2-ENSUITE 3     | 22.     | 12.     | 880.    |
| 2-HALL          | 23.     | 10.     | 932.    |
| 2-LAUNDRY       | 33.     | 19.     | 1303.   |
| 2-MASTERBEDROOM | 78.     | 66.     | 3113.   |
| 2-W.I.C.        | 3.      | 1.      | 115.    |
| BASEMENT        | 259.    | 35.     | 10349.  |
|                 | 1169    | 1000    | 46822   |

Linda Mcparlan  
24379



2022-11-07

