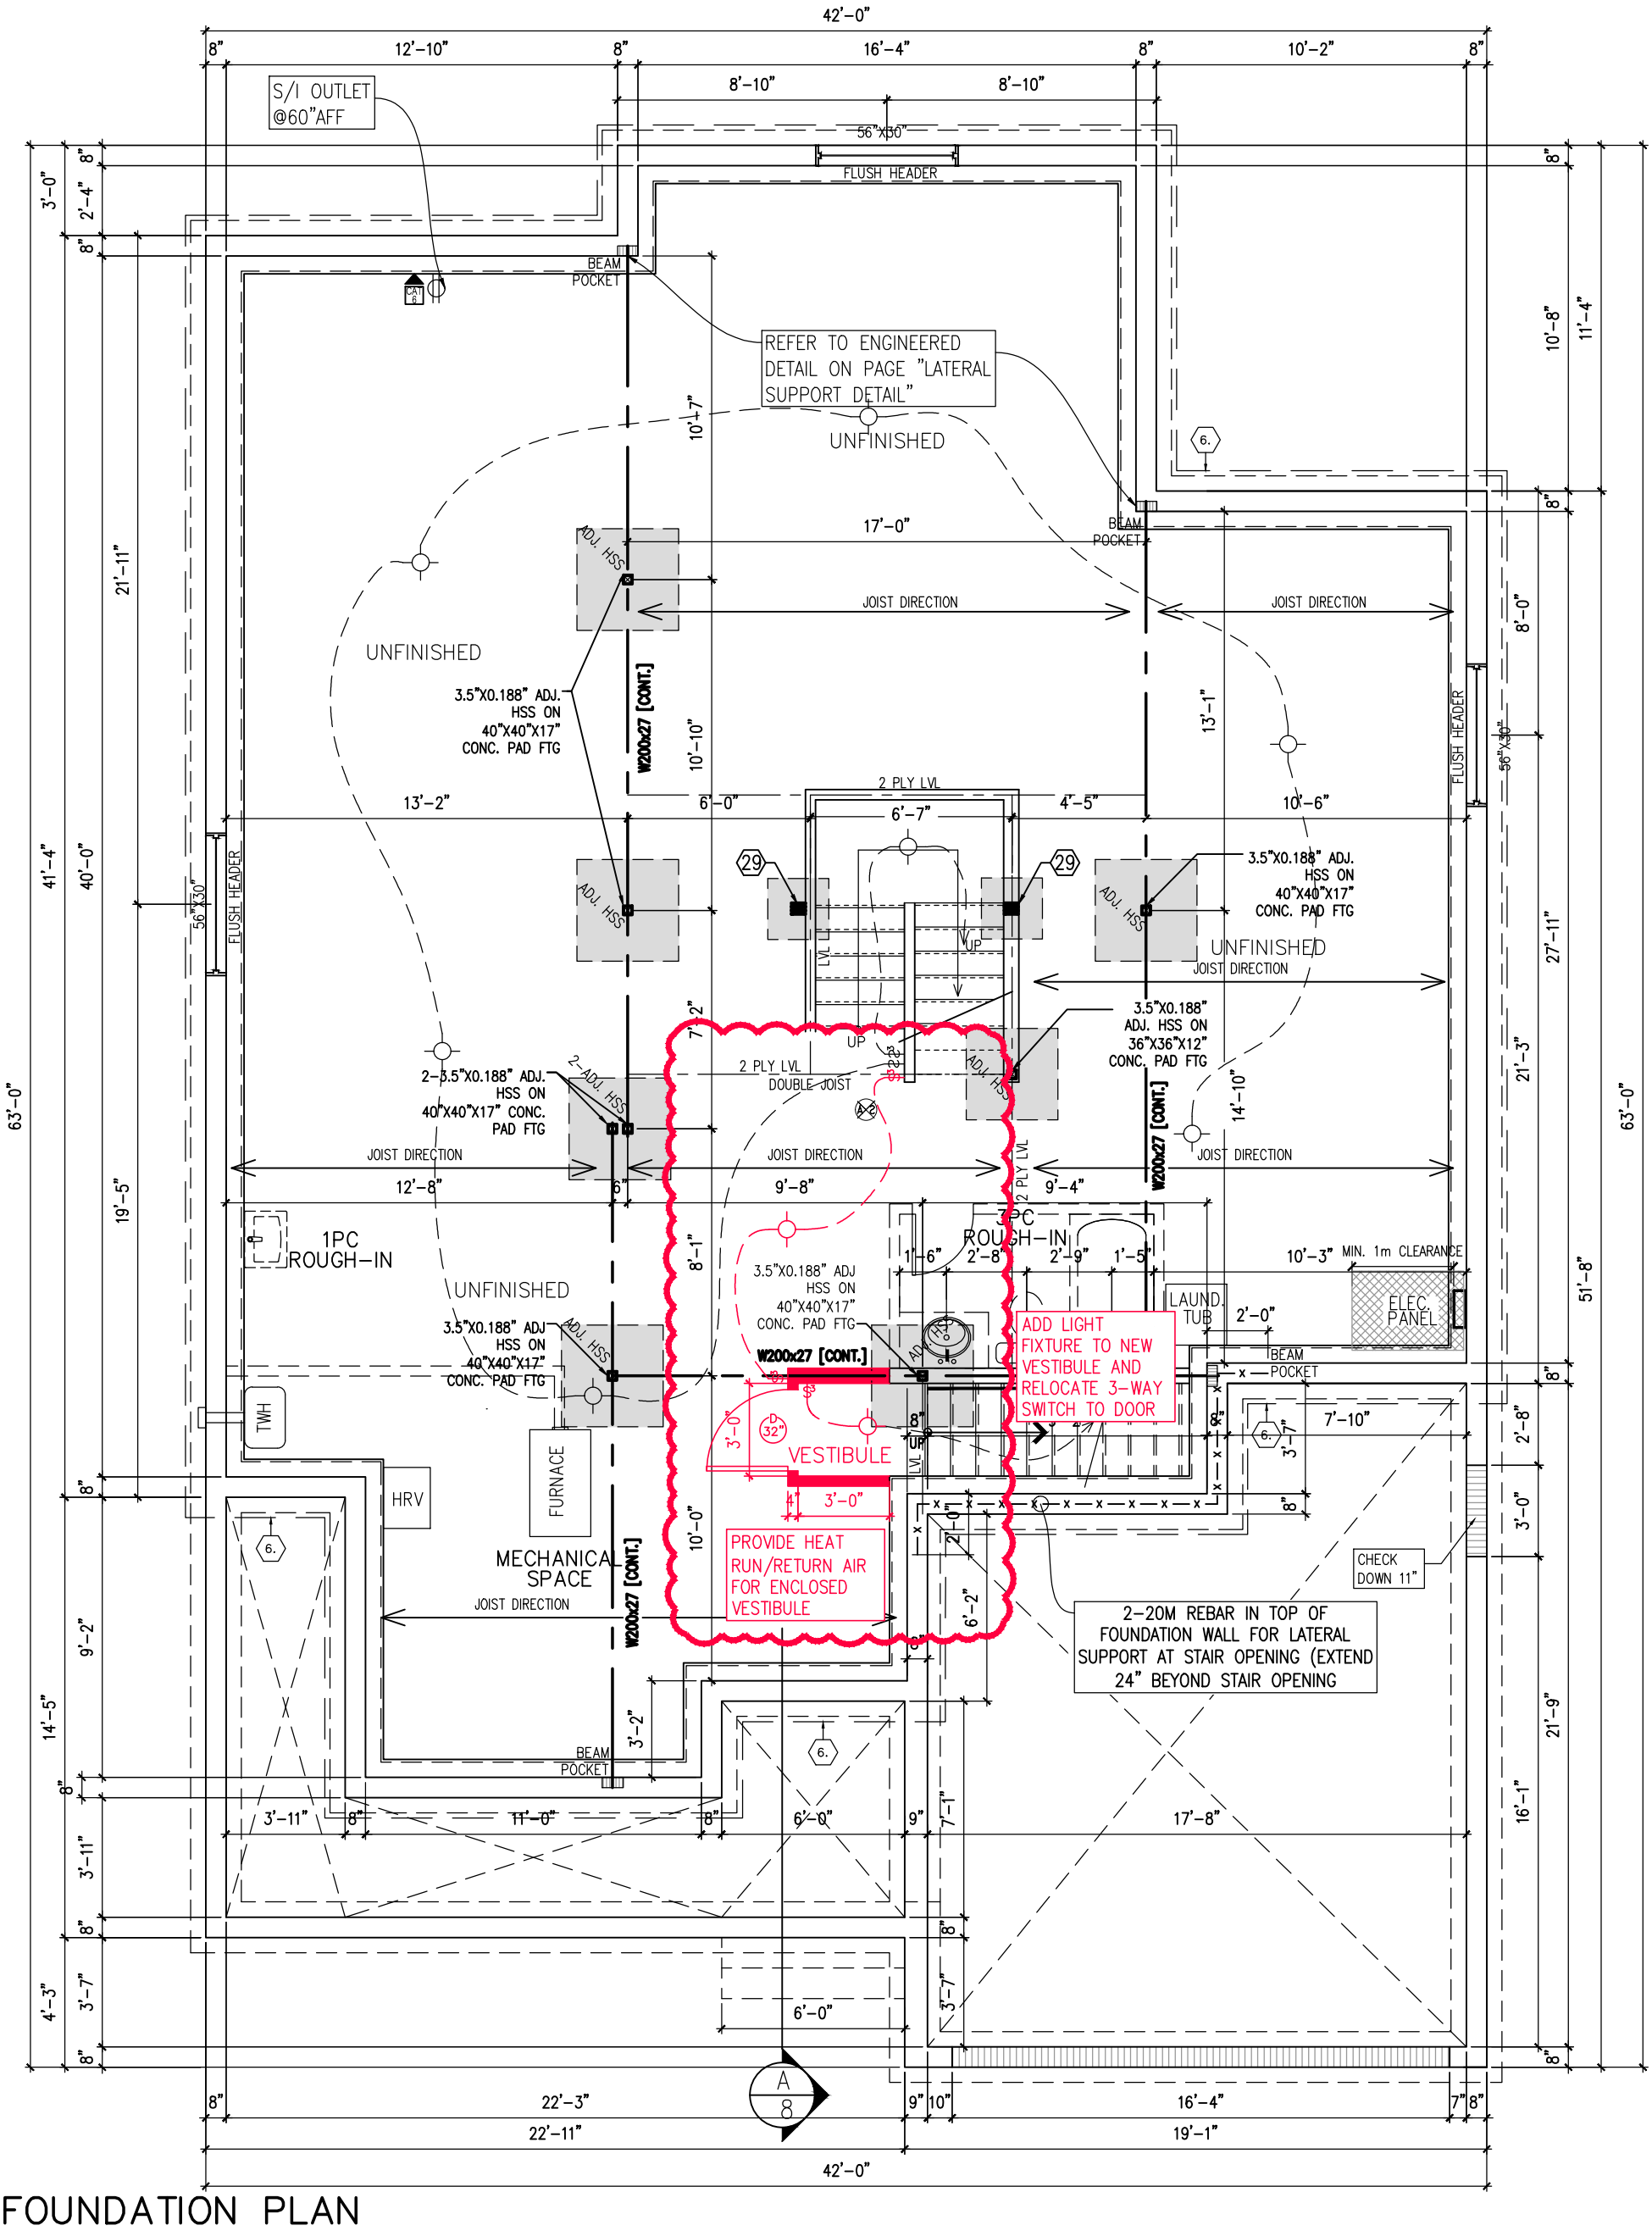

FOUNDATION PLAN

PHOENIX HOMES

NEWINGTON – 2018

SITE: PATHWAYS

LOT NUMBER: 299

CIVIC ADDRESS:
51 DUN SKIPPER DRIVE

No.	Description	dd/mm/yy	By
10	FINAL FOR CONSTRUCTION – REVISED	12/01/23	SP
9	FINAL FOR CONSTRUCTION	11/04/22	SP
8	STRUCTURAL REVIEW	22/09/21	SP
7	FINAL BLACKLINES	3/09/21	SP
6	ENGINEERING REVIEW	18/08/21	CB
5	BEP BLACKLINES	24/06/21	CB

REVISIONS

footprint:	518
drawn by:	SP
date:	JUN 12/16
scale:	3/16"=1'-0"
D.C.L. – 187	
sheet no:	2 of 8