


**USF to have min. 1.5m cover
around foundation or
foundation shall be insulated**

Sleeved services required under retaining walls / footings / garage, and are recommended under porches, decks, and similar structures

Development Review Branch
Grading & Servicing Reviewed

Date: Apr. 20, 2022

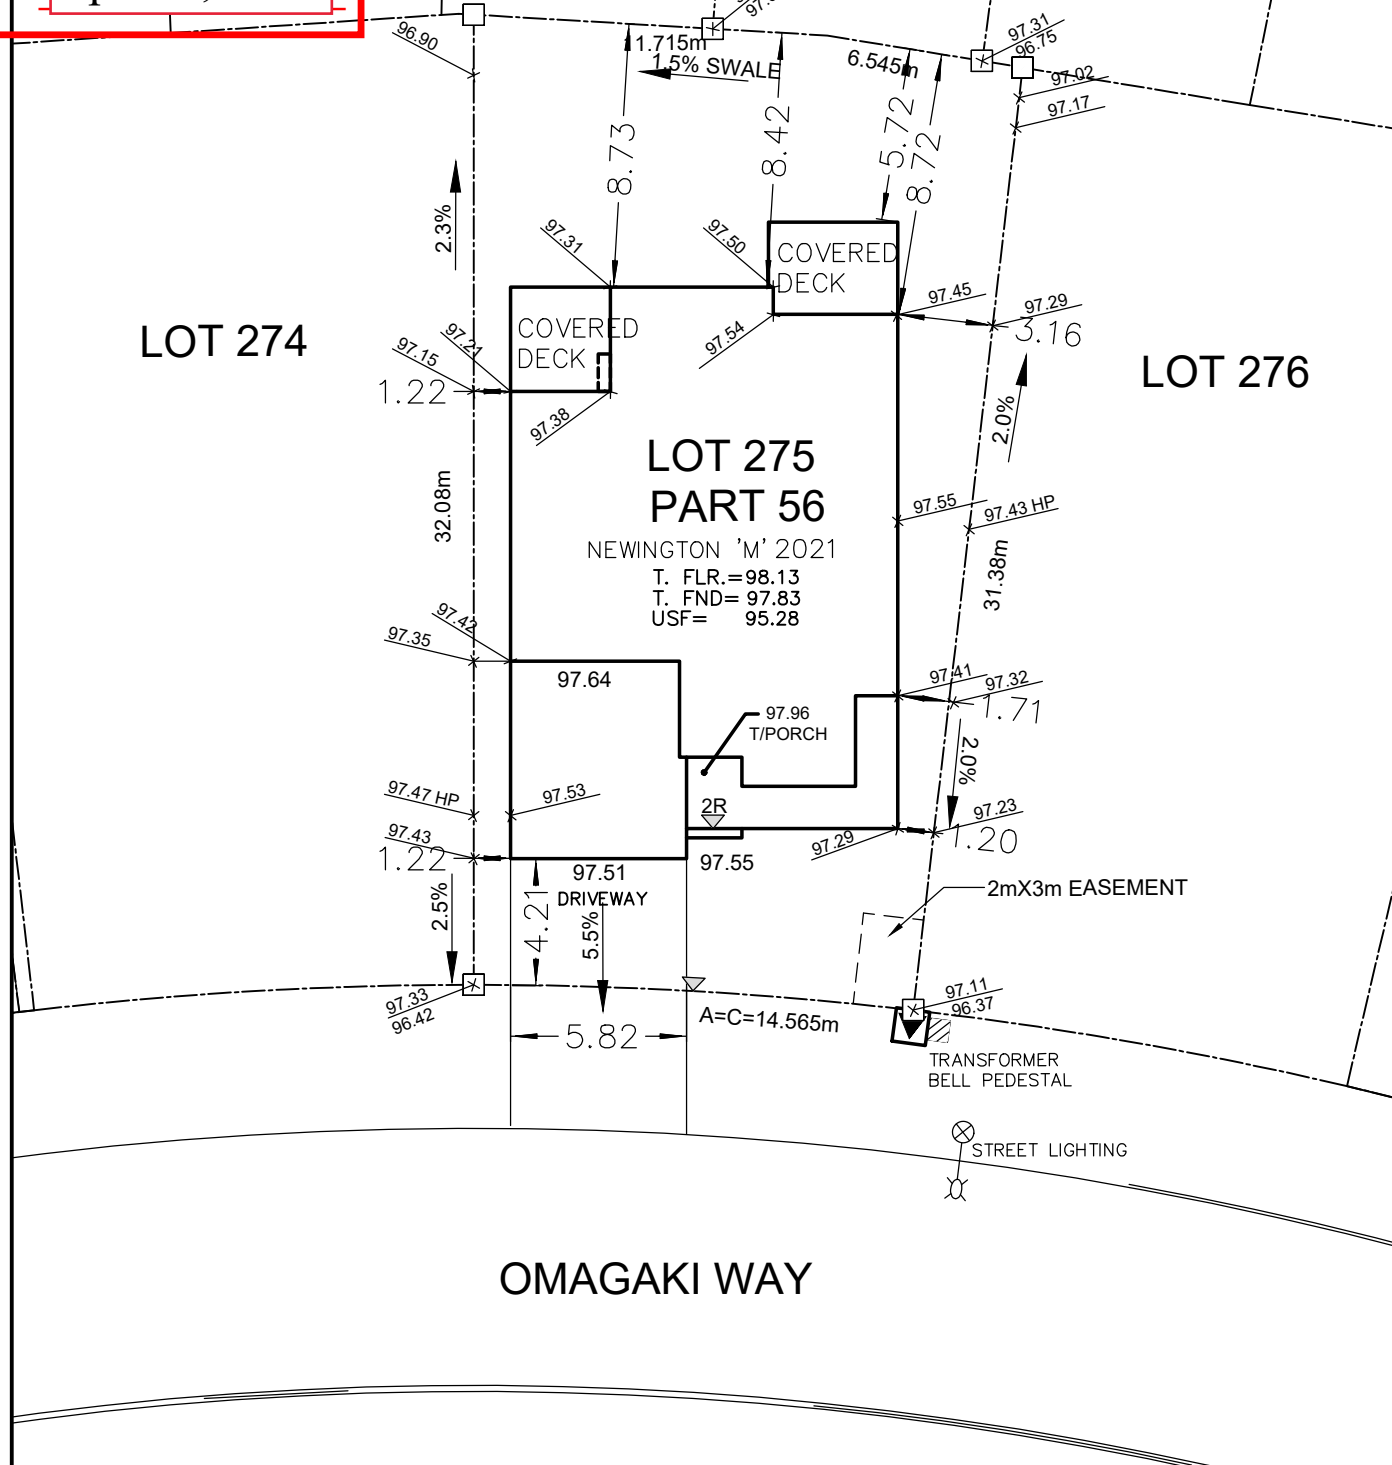

LOT
275

SITE/GRADING PLAN

PATHWAYS PHASE 2

THIS PLAN IS FOR REFERENCE ONLY AND IS PRELIMINARY IN NATURE, ALL DIMENSIONS SHOWN ARE APPROXIMATE. E,O&E.

CHECKED/APPROVED BY: T.L.MAK ENG.