


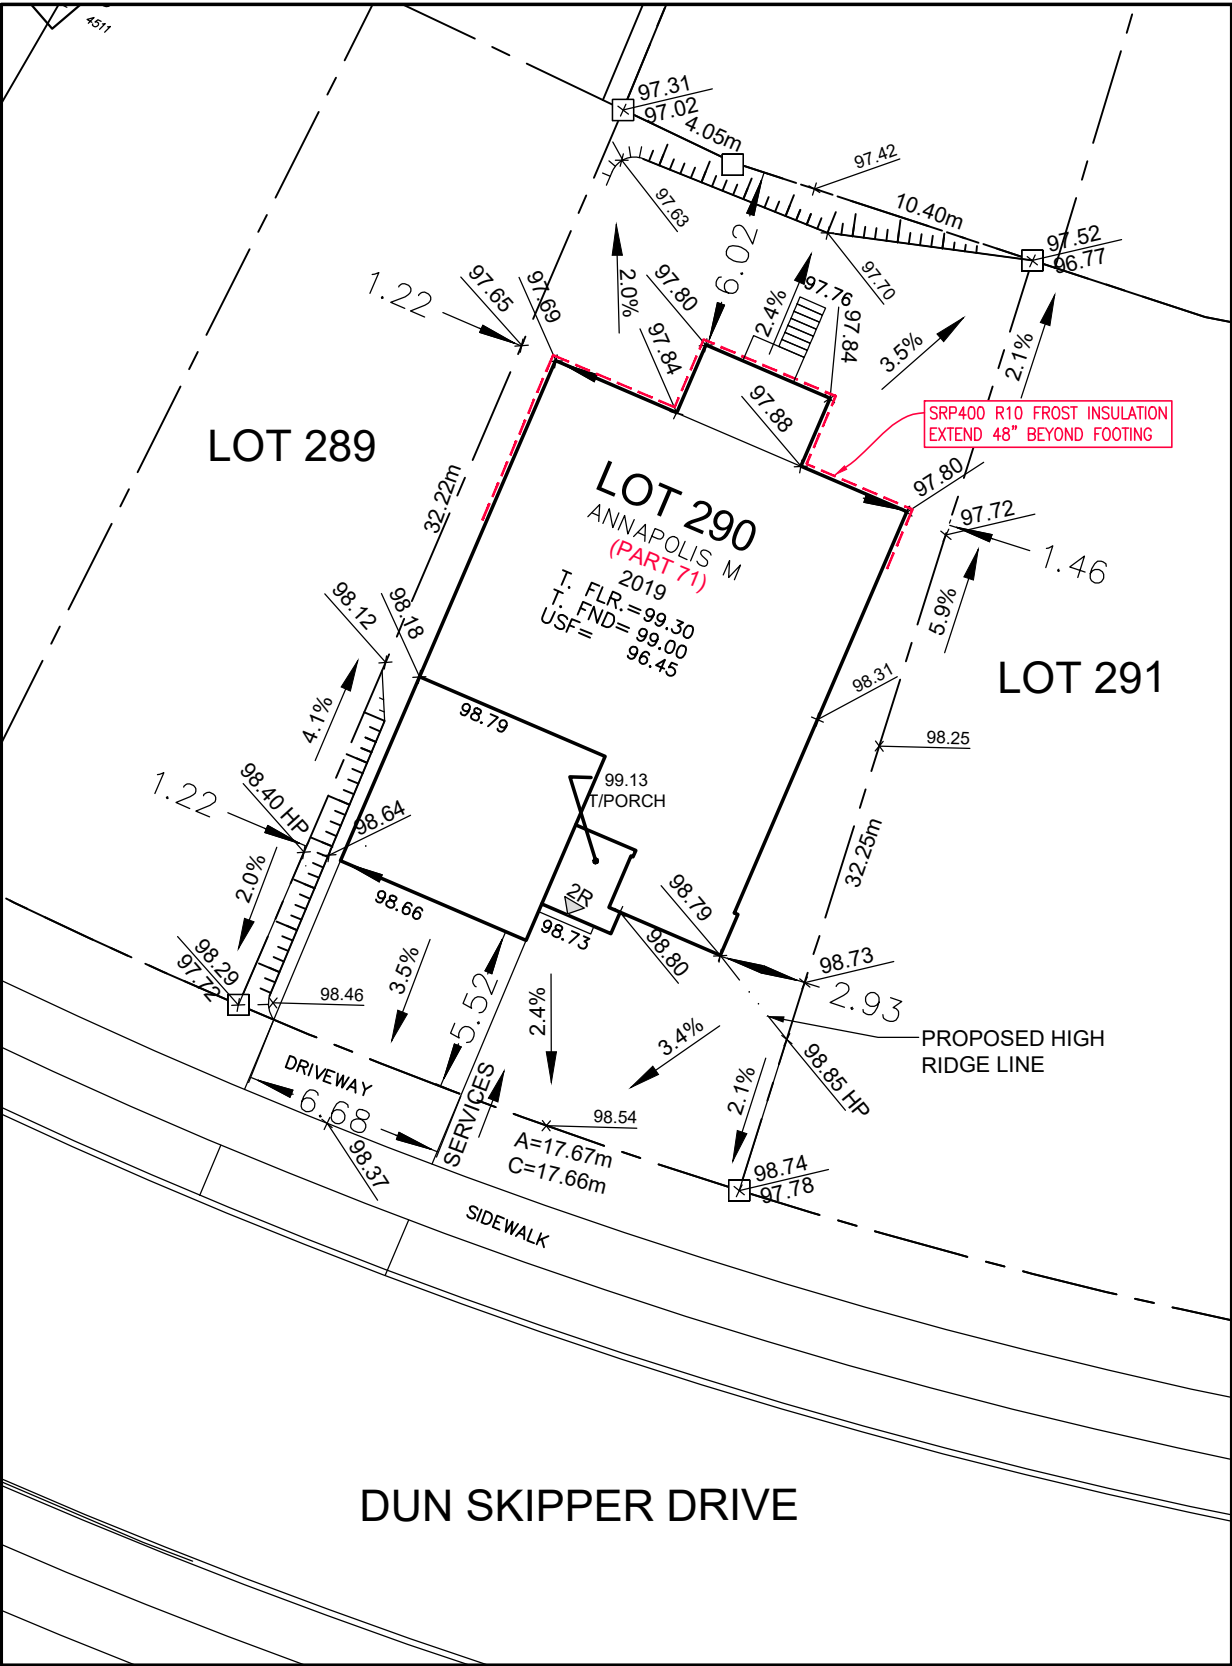

|   |   |
|---|---|
| <div>Owner/Applicant</div> <div>DCR/PHOENIX HOMES</div> <div>Telephone # 723-9227</div> <div>Plan # 4M- 1618</div> <div>Project name:PATHWAYS</div> <div>Civic Address:28 DUN SKIPPER</div> <div>House model: ANNAPOLIS M</div>                                           | <div><div></div><div><div>LOT290</div><div>SITE/GRADING PLAN</div><div>PATHWAYS PHASE 2</div></div></div> <div>INDIVIDUAL LOT GRADING REVIEW SUMMARY FOR SITED HOUSE AS COMPARED WITH OVERALL SUBDIVISION PLAN</div> |
| <div>Bldg. Ht. _____m</div> <div>Lot coverage _____%</div> <div>Scale 1:250</div> <div>Sod Area _____m<sup>2</sup></div> <div>Asphalt Area 66.35m<sup>2</sup></div> <div>CHECKED/APPROVED BY: T.L.MAK ENG.</div> <div>May 9th, 2022</div> <div>Sep. 27th, 2022 - CB</div> | <div>NOTE: THIS PLAN IS NOT A SURVEY PLAN OR SUBDIVISION PLAN WITHIN THE MEANING OF PLANNING ACT.</div> <div>THIS PLAN IS FOR REFERENCE ONLY AND IS PRELIMINARY IN NATURE, ALL DIMENSIONS SHOWN ARE APPROXIMATE. E.O&amp;E.</div>                                                                       |