


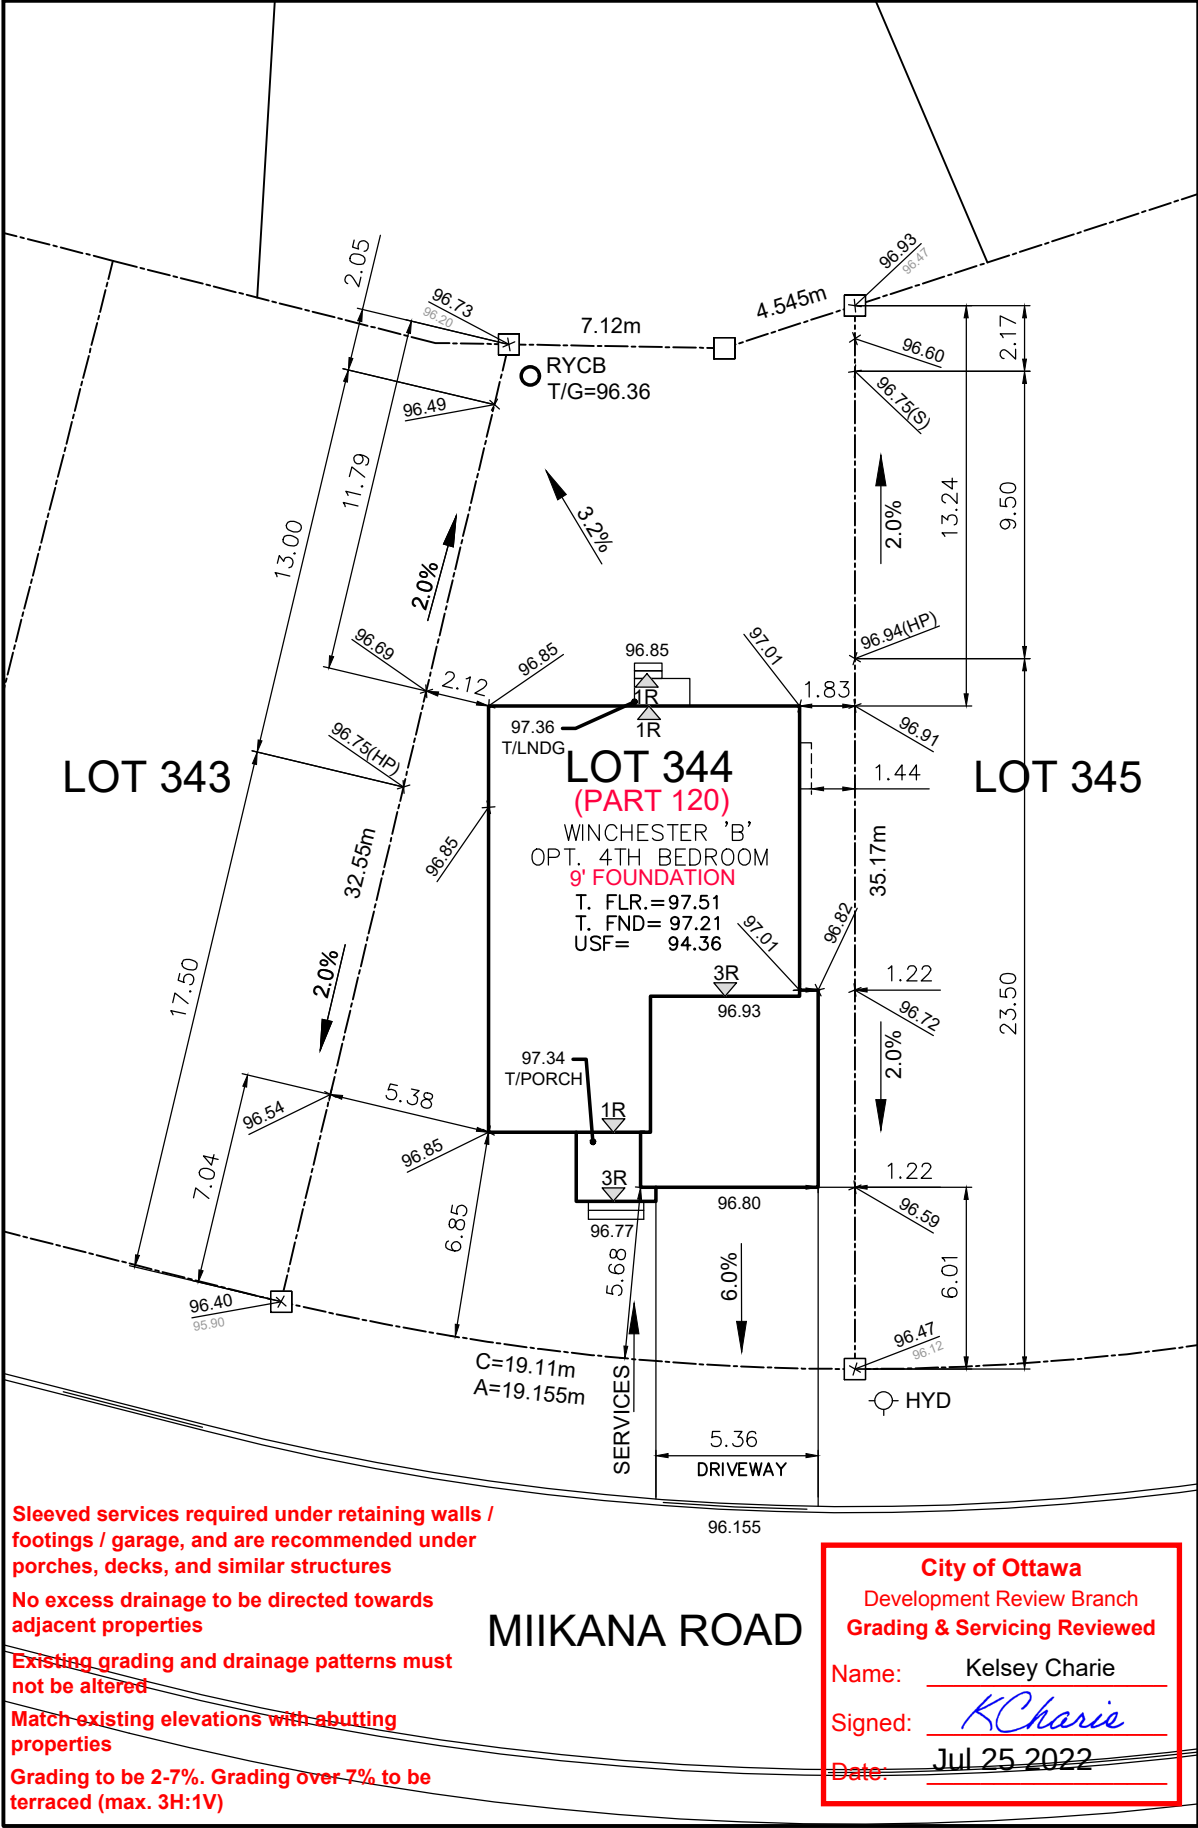

Owner/Applicant DCR/PHOENIX HOMES Telephone # 723-9227 Plan # 4M- 1618 Project name:PATHWAYS Civic Address:624 MIIKANA ROAD House model: WINCHESTER 'B' Bldg. Ht. _____m Lot coverage 32 % Scale 1: 250 Sod Area 382 m² Asphalt Area 57 m² CHECKED/APPROVED BY: T.L.MAK ENG.	 LOT 344 SITE/GRADING PLAN PATHWAYS PHASE 2 INDIVIDUAL LOT GRADING REVIEW SUMMARY FOR SITED HOUSE AS COMPARED WITH OVERALL SUBDIVISION PLAN NOTE: THIS PLAN IS NOT A SURVEY PLAN OR SUBDIVISION PLAN WITHIN THE MEANING OF PLANNING ACT. THIS PLAN IS FOR REFERENCE ONLY AND IS PRELIMINARY IN NATURE, ALL DIMENSIONS SHOWN ARE APPROXIMATE. E.O&E.
---	--