
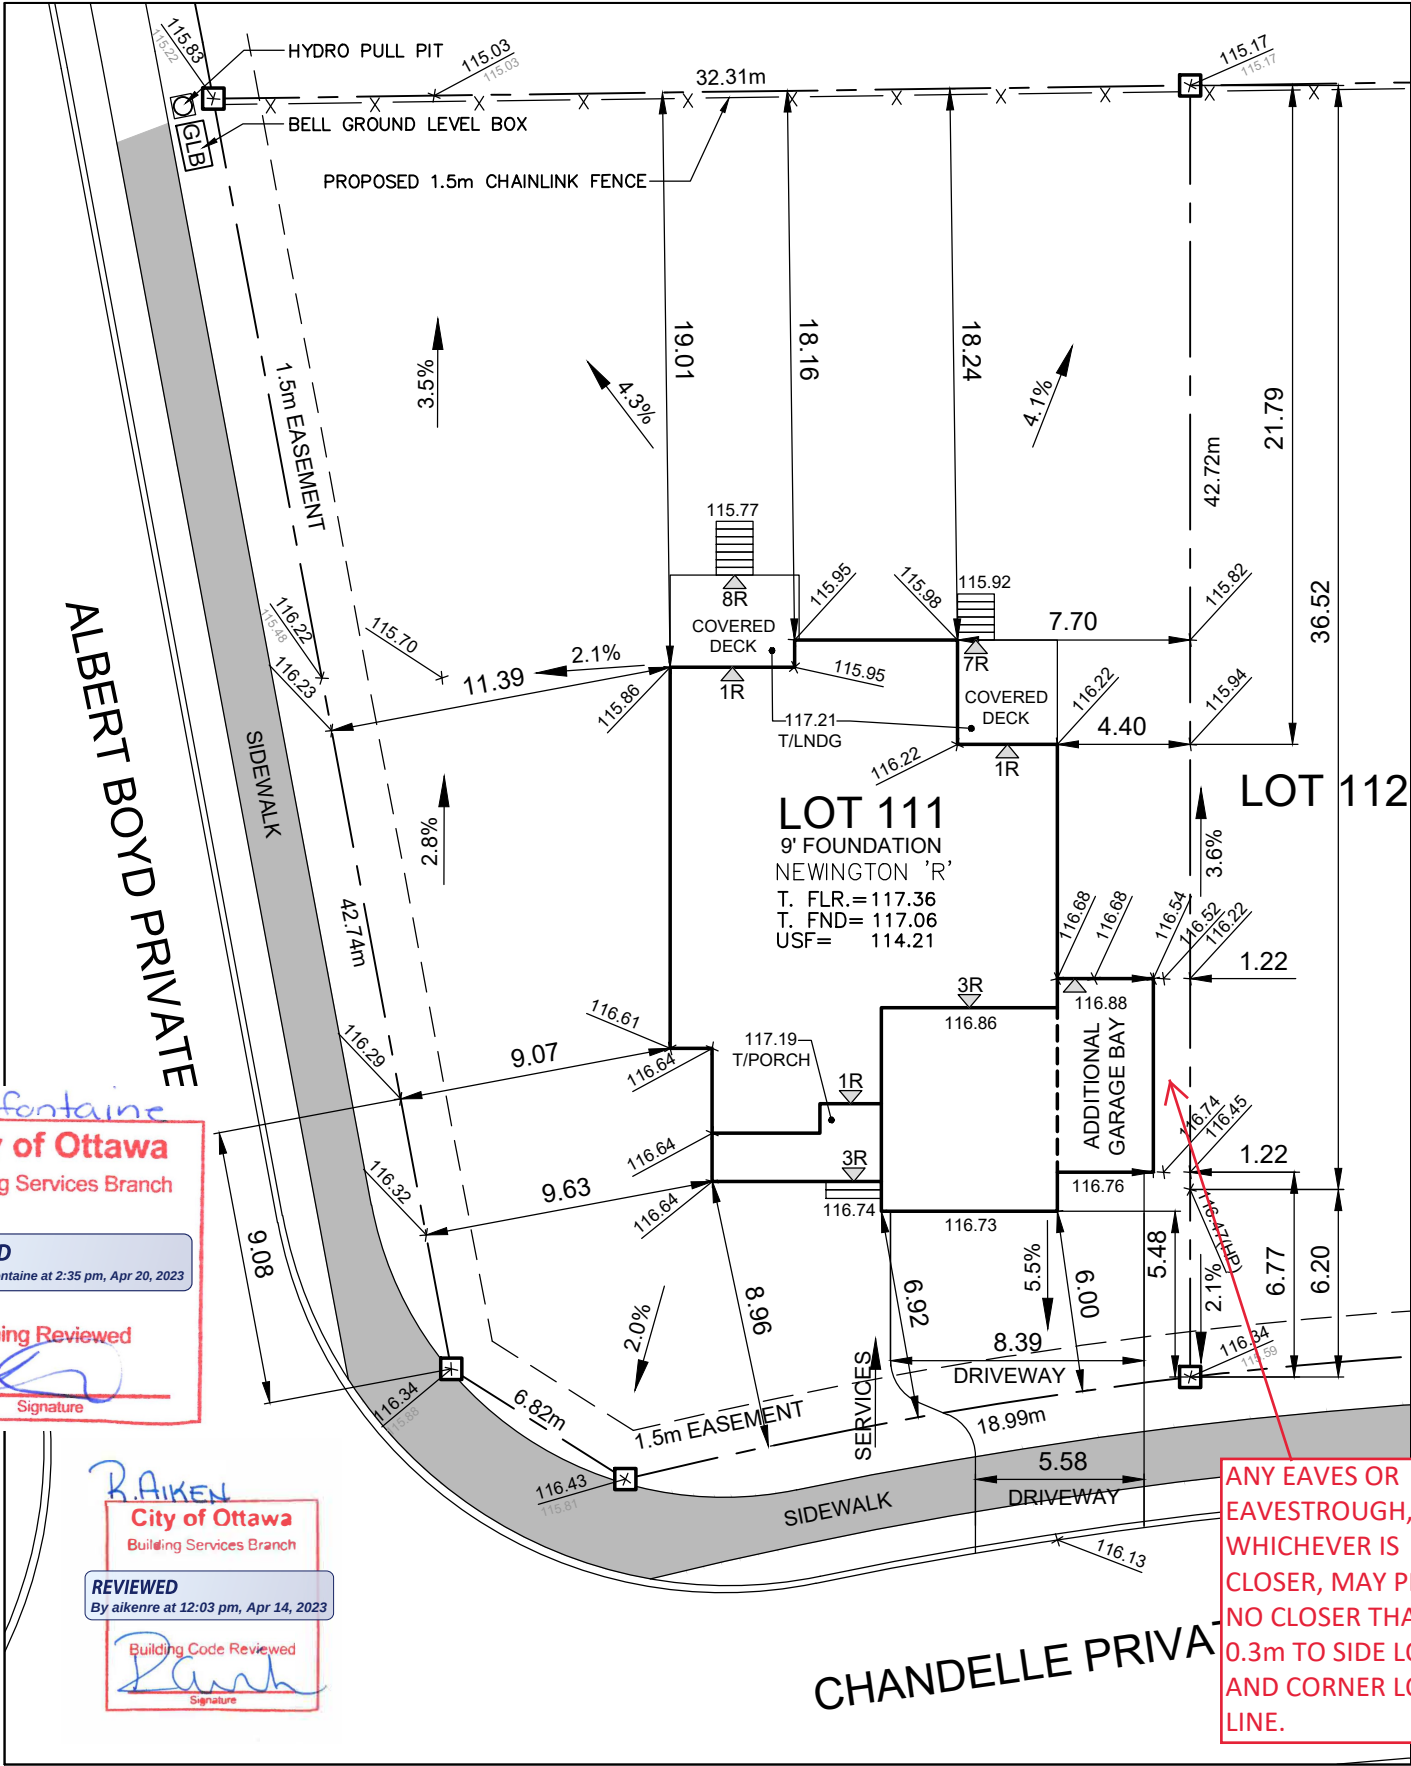


PLANS TO BE READ WITH MASTER FOOTPRINTED PLANS

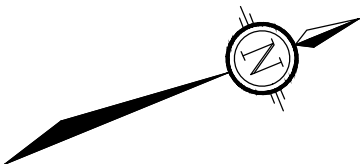

Owner/Applicant

DCR/PHOENIX HOMES

Telephone # 723-9227

Plan # 4M-1593

Project name: DIAMONDVIEW

Civic Address: 114 CHANDELLE PRIV.

House model: NEWINGTON 'R'

Bldg. Ht. m

Lot coverage 18.8% %

Scale 1:250

Sod Area 1100 m²

Asphalt Area 72 m²

CHECKED/APPROVED BY: T.L.MAK ENG.



SITE/GRADING PLAN

DIAMONDVIEW PHASE 3

INDIVIDUAL LOT GRADING REVIEW SUMMARY FOR SITED HOUSE AS COMPARED WITH OVERALL SUBDIVISION PLAN

NOTE: THIS PLAN IS NOT A SURVEY PLAN OR SUBDIVISION PLAN WITHIN THE MEANING OF PLANNING ACT.
THIS PLAN IS FOR REFERENCE ONLY AND IS PRELIMINARY IN NATURE, ALL DIMENSIONS SHOWN ARE APPROXIMATE. E.O&E.