


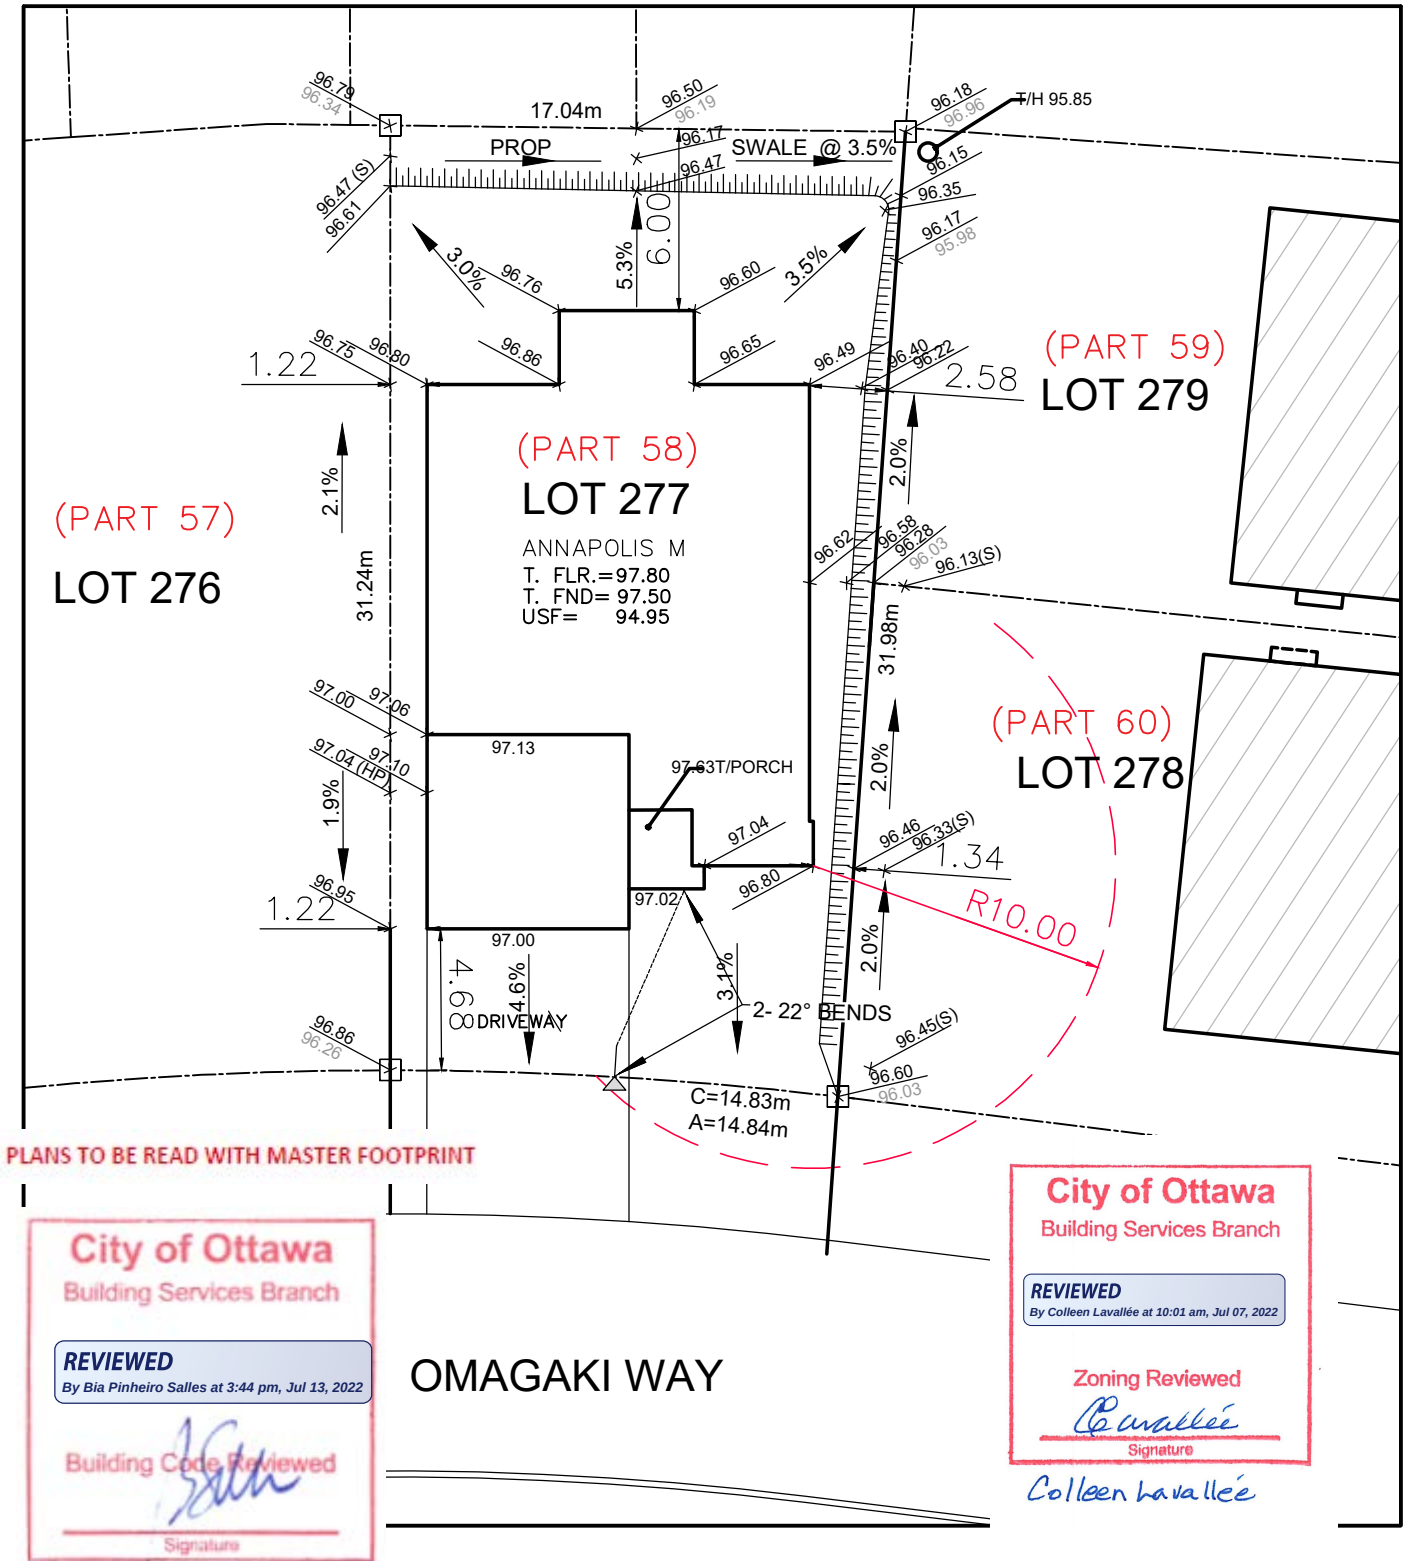

Owner/Applicant DCR/PHOENIX HOMES Telephone # <u>723-9227</u> Plan # <u>4M- 1618</u> Project name: <u>PATHWAYS</u> Civic Address: <u>904 OMAGAKI WAY</u> House model: <u>ANNAPOLIS M</u>	 LOT 277 SITE/GRADING PLAN PATHWAYS PHASE 2
Bldg. Ht. _____ m Lot coverage <u>45.5</u> % Scale <u>1: 250</u> Sod Area <u>278.68</u> m² Asphalt Area <u>63.67</u> m²	INDIVIDUAL LOT GRADING REVIEW SUMMARY FOR SITED HOUSE AS COMPARED WITH OVERALL SUBDIVISION PLAN
CHECKED/APPROVED BY: T.L.MAK ENG. MAY 17, 2022	NOTE: THIS PLAN IS NOT A SURVEY PLAN OR SUBDIVISION PLAN WITHIN THE MEANING OF PLANNING ACT.