


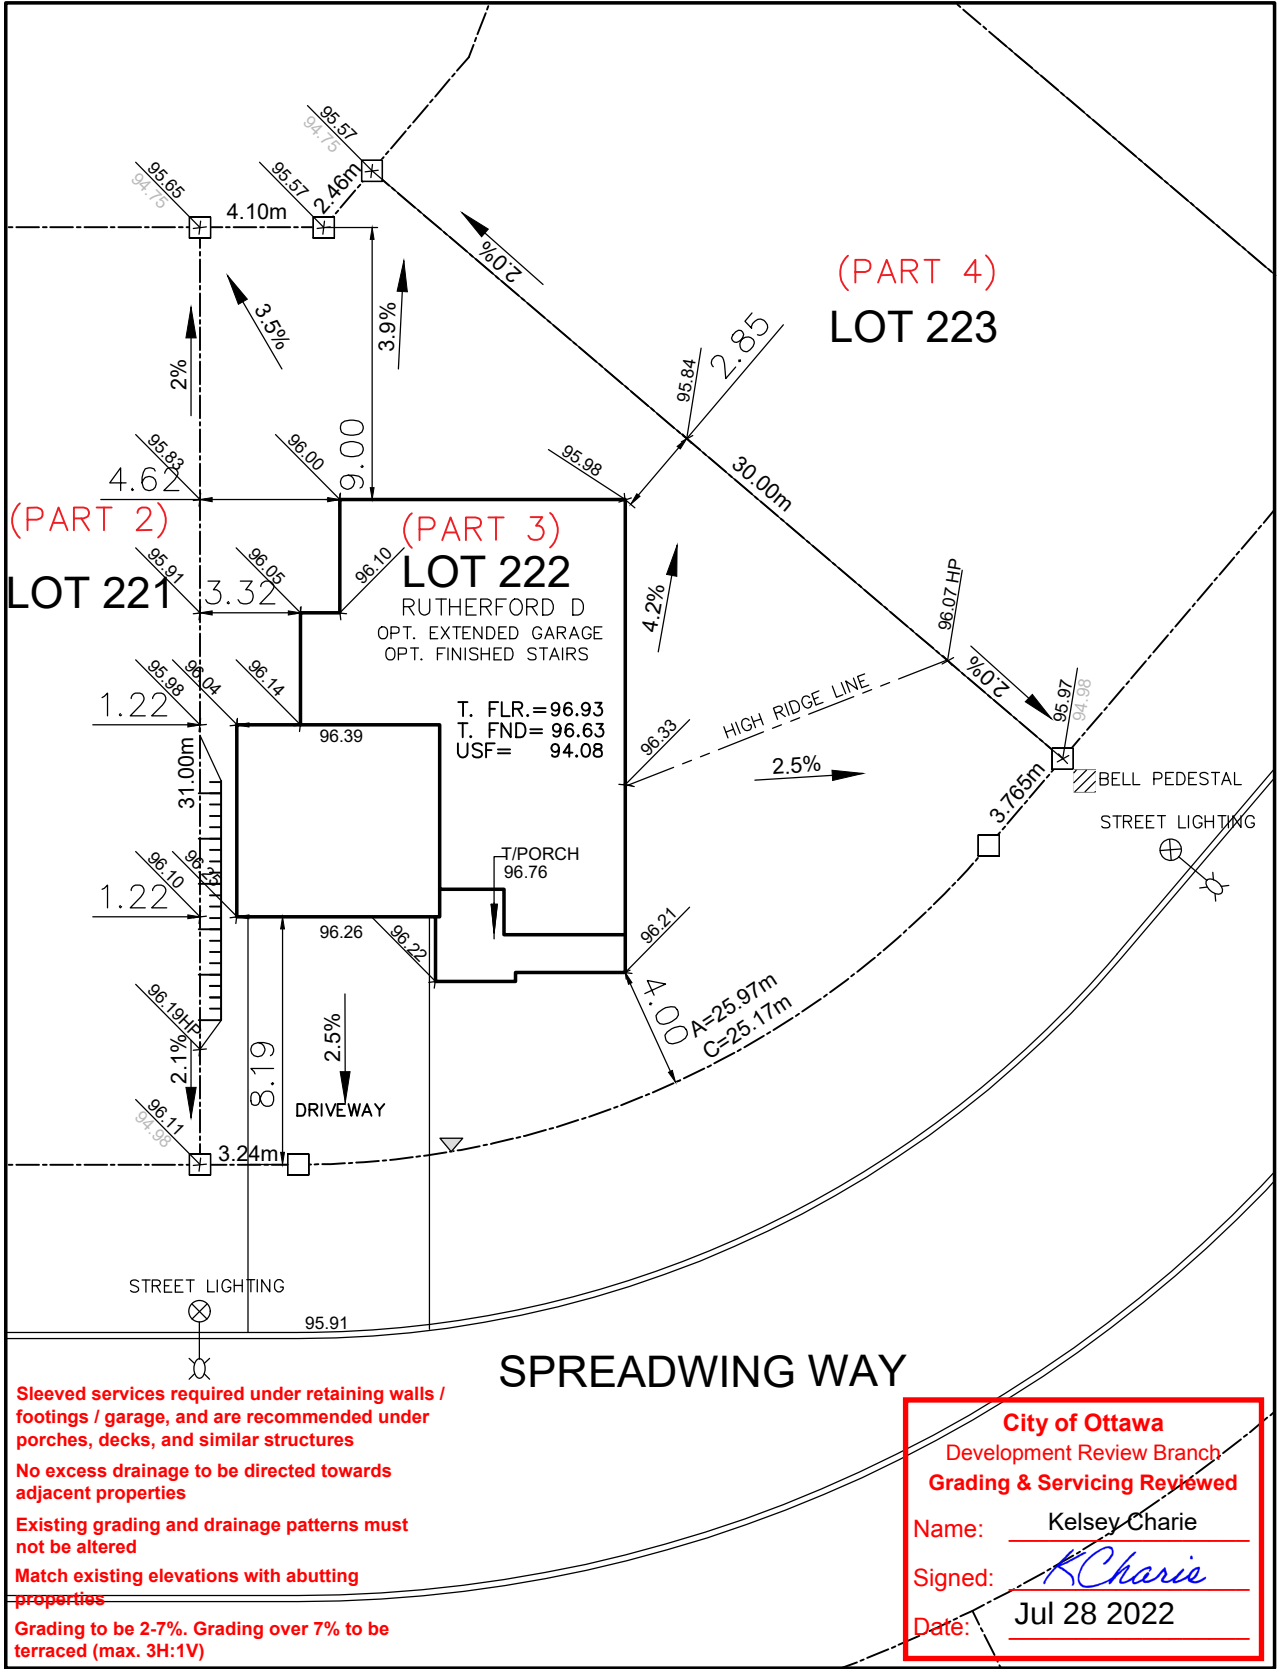

Owner/Applicant DCR/PHOENIX HOMES Telephone # 723-9227 Plan # 4M- 1618 Project name:PATHWAYS Civic Address:305 SPREADWING WAY House model: RUTHERFORD D	 LOT 222 SITE/GRADING PLAN PATHWAYS PHASE 2
Bldg. Ht. _____ m Lot coverage 28 % Scale 1: 250 Sod Area 564.675 m² Asphalt Area 83.32 m²	INDIVIDUAL LOT GRADING REVIEW SUMMARY FOR SITED HOUSE AS COMPARED WITH OVERALL SUBDIVISION PLAN NOTE: THIS PLAN IS NOT A SURVEY PLAN OR SUBDIVISION PLAN WITHIN THE MEANING OF PLANNING ACT.
CHECKED/APPROVED BY: T.L.MAK ENG. NOV 9, 2021	