


NOTE: UTILITIES/SERVICES/MAILBOXES/EASEMENT PLANS HAVE NOT BEEN FINALIZED – THIS PLAN SUBJECT TO FURTHER CHANGES.

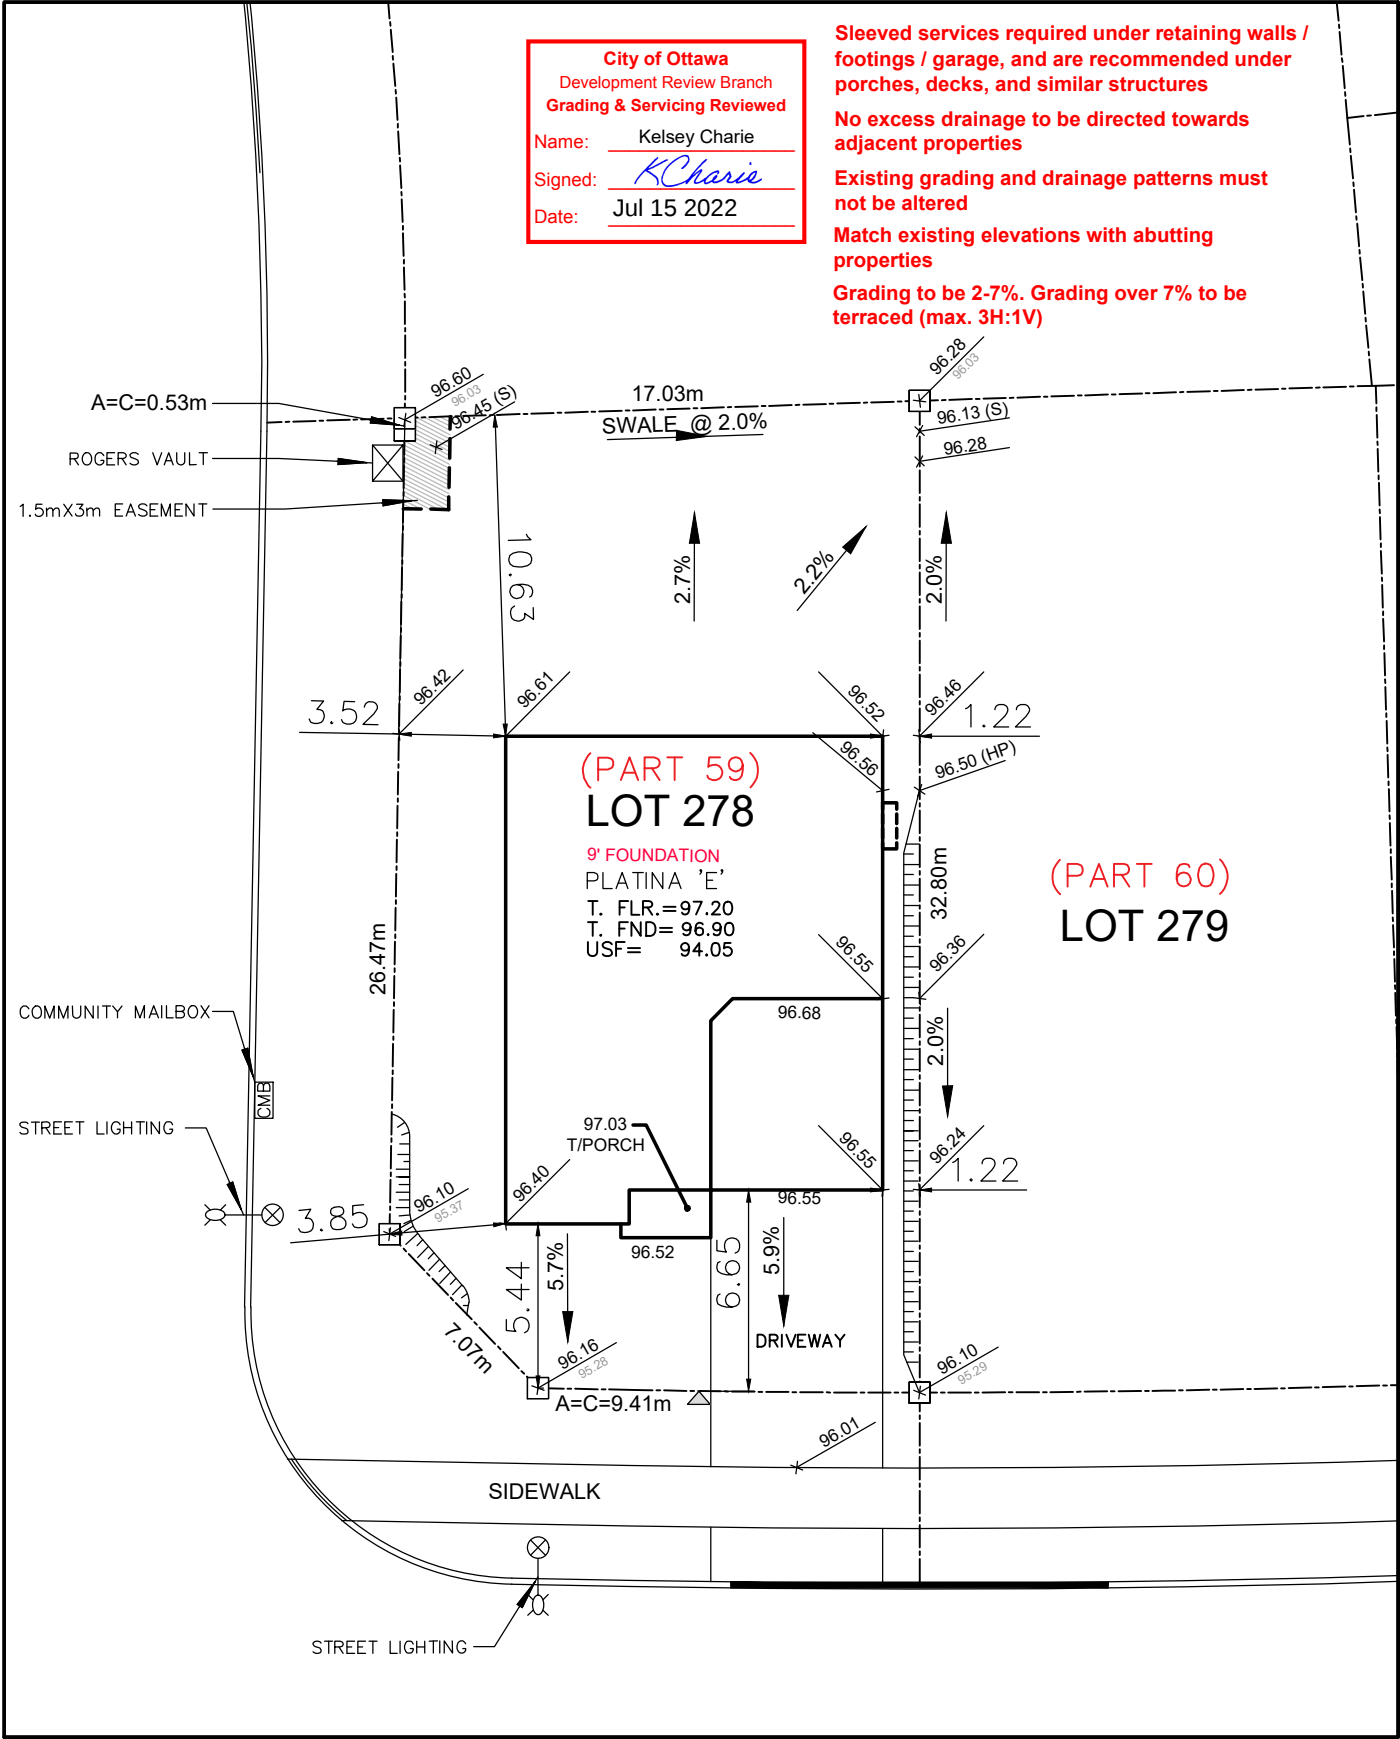

Owner/Applicant
DCR/PHOENIX HOMES

Telephone # 723-9227

Plan # 4M- 1618

Project name: PATHWAYS

Civic Address: 660 MIKANA ROAD

House model: PLATINA 'E'

Bldg. Ht. _____ m

Lot coverage 64 %

Scale 1:250

Sod Area 532 m²

Asphalt Area 63 m²



LOT
278

SITE/GRADING PLAN
PATHWAYS PHASE 2

INDIVIDUAL LOT GRADING REVIEW SUMMARY FOR SITED HOUSE AS COMPARED WITH OVERALL SUBDIVISION PLAN

NOTE: THIS PLAN IS NOT A SURVEY PLAN OR SUBDIVISION PLAN WITHIN THE MEANING OF PLANNING ACT.

CHECKED/APPROVED BY: T.L.MAK ENG.