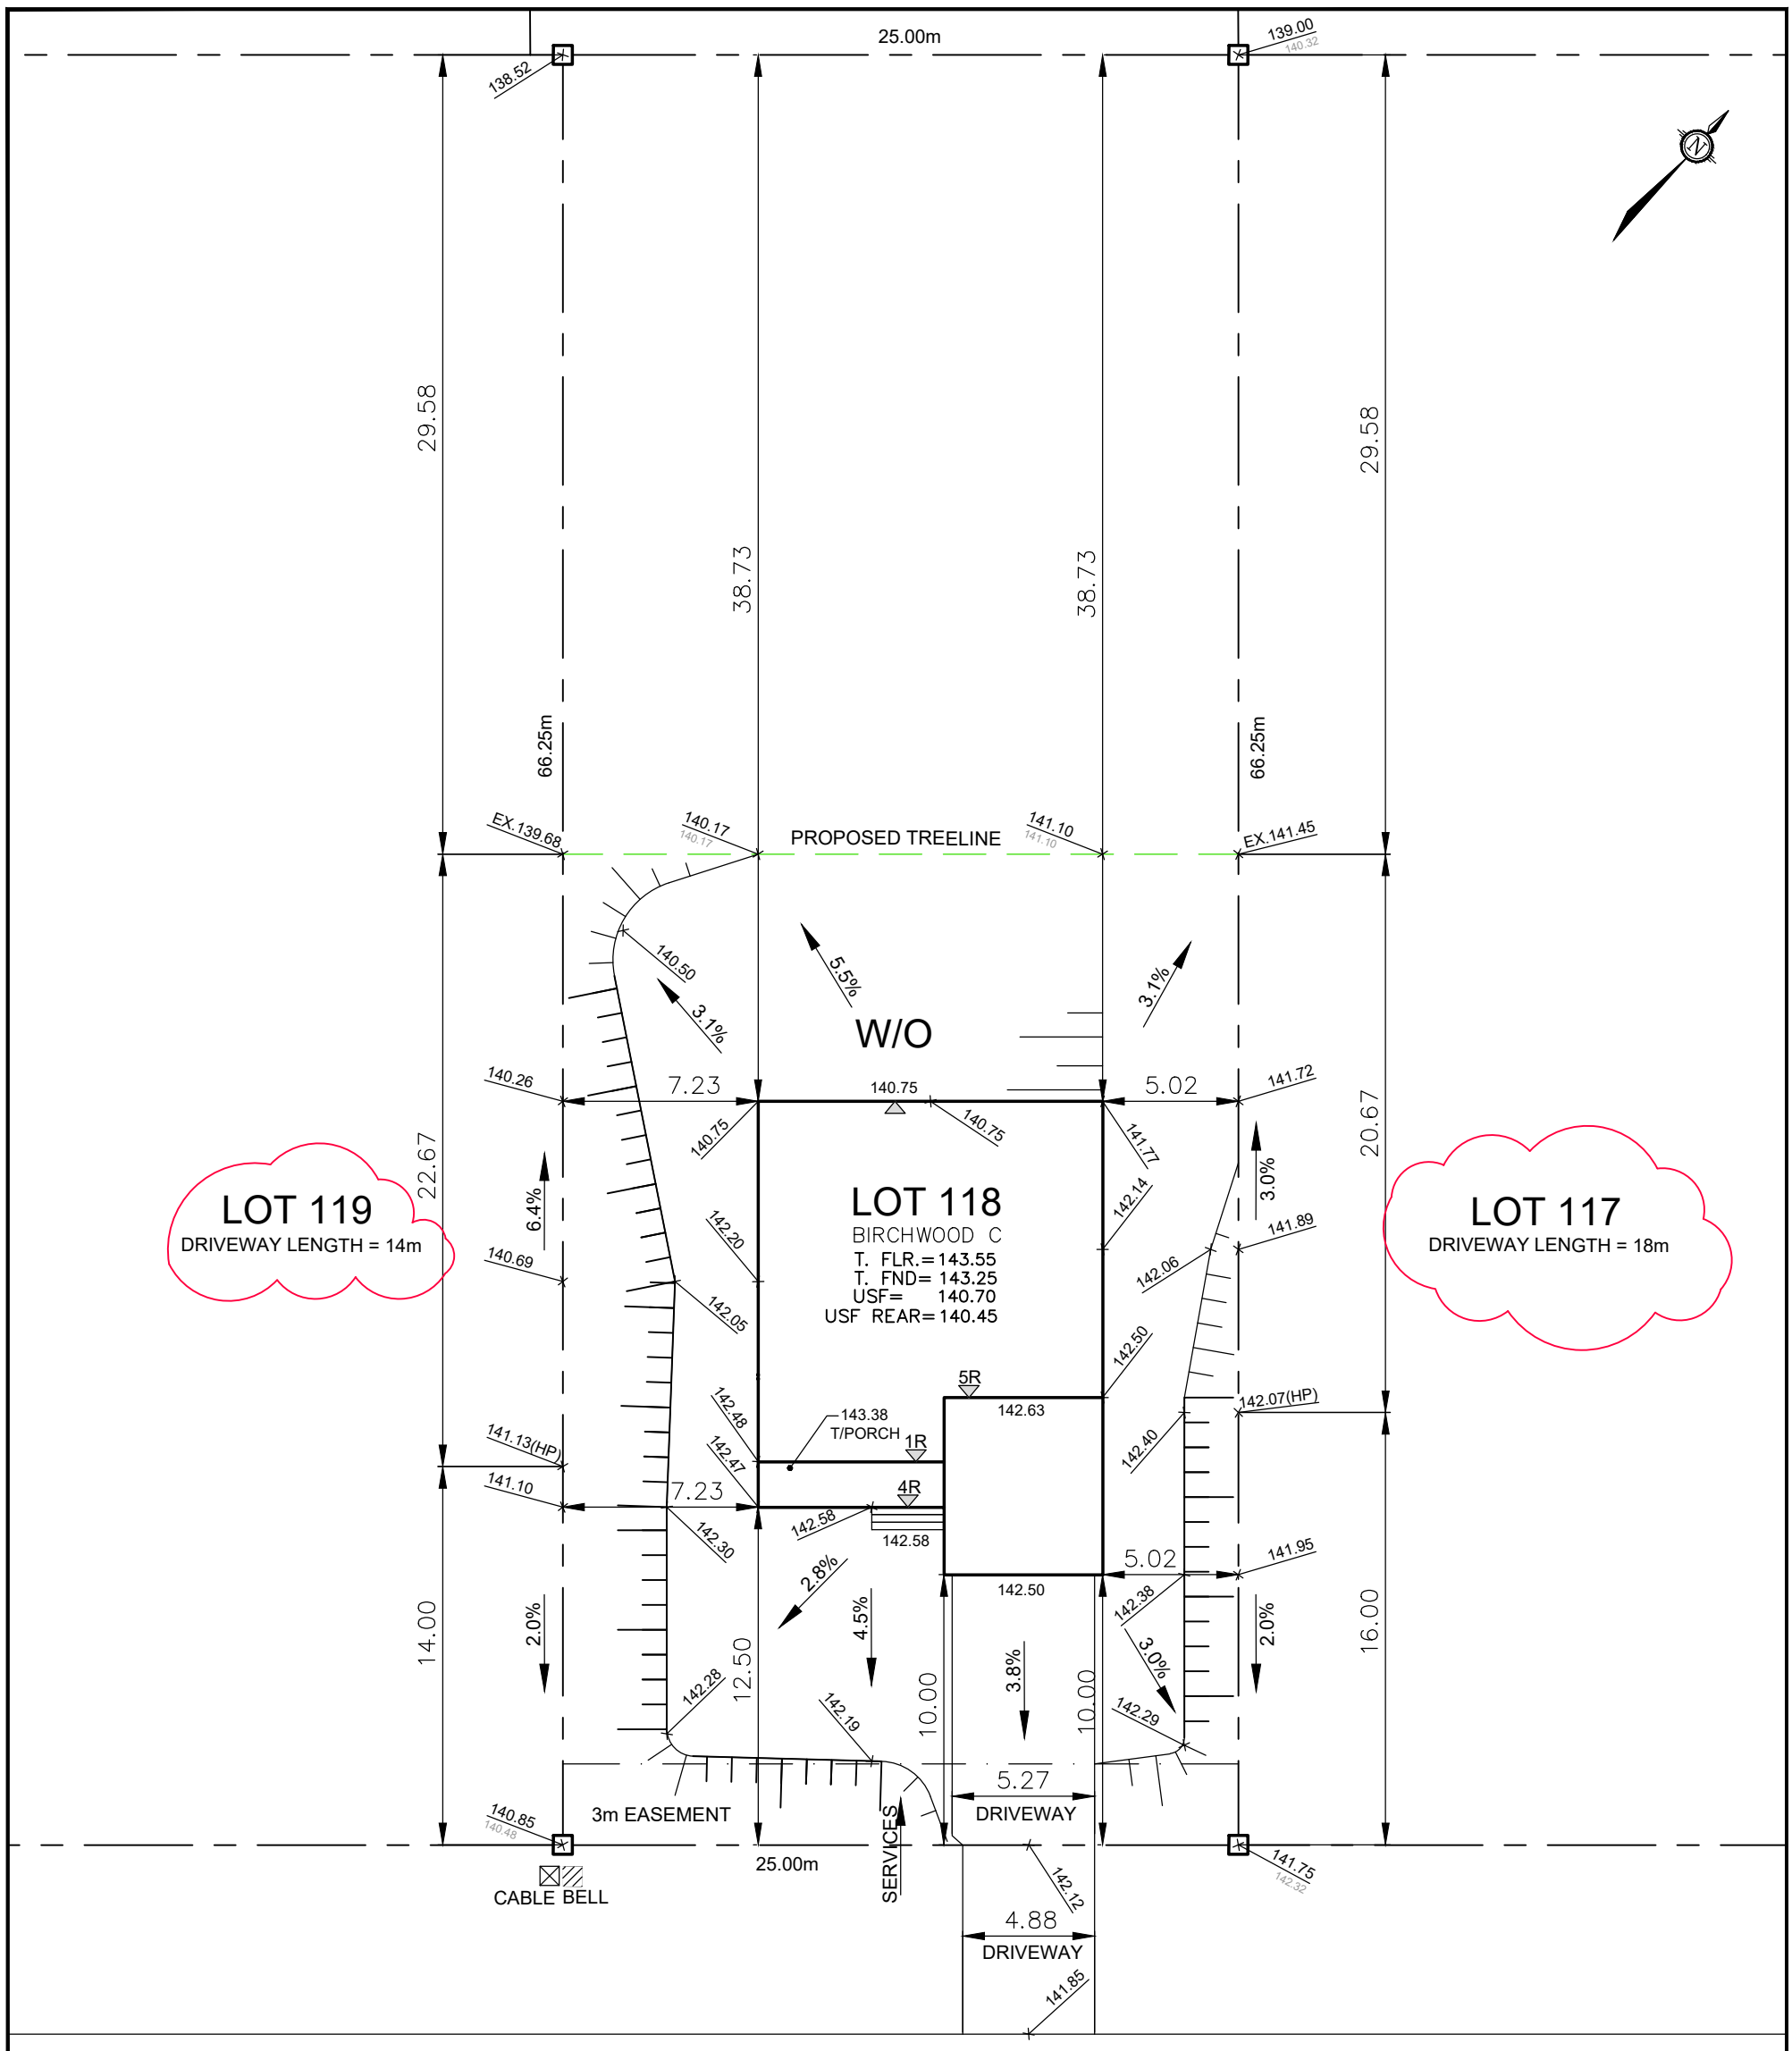

FRANK FISHER CRESCENT

Owner/Applicant
DCR/PHOENIX HOMES

Telephone # 723-9227
Plan # 27M- 47
Project name: WHITE TAIL RIDGE
Civic Address: 168 FRANK FISHER CRESCENT
House model: BIRCHWOOD C

Bldg. Ht. 8.84 m
Lot coverage 12.5 %
Scale 1:250
Sod Area 1539 m^2
Asphalt Area 87 m^2

CHECKED/APPROVED BY: T.L.MAK ENG.
APR. 17, 2023 – CB
MAY 08, 2023 – CB – ADDRESS CHANGE
JUN. 02, 2023 – CB

PHOENIX HOMES

LOT 118 SITE/GRADING PLAN
WHITE TAIL RIDGE PH.II

INDIVIDUAL LOT GRADING REVIEW SUMMARY FOR SITED HOUSE AS COMPARED WITH OVERALL SUBDIVISION PLAN

NOTE: THIS PLAN IS NOT A SURVEY PLAN OR SUBDIVISION PLAN WITHIN THE MEANING OF PLANNING ACT. THIS PLAN IS FOR REFERENCE ONLY AND IS PRELIMINARY IN NATURE, ALL DIMENSIONS SHOWN ARE APPROXIMATE. E,O&E.