




FRANK FISHER
CRESCENT

Owner/Applicant		
DCR/PHOENIX HOMES		
Telephone #	723-9227	
Plan #	27M-47	
Project name: WHITE TAIL RIDGE		
Civic Address: 130 FRANK FISHER CRESCENT		
House model: SPRINGFIELD R		
Bldg. Ht.	8.51	m
Lot coverage	11.9%	%
Scale	1:250	
Sod Area	1675	m ²
Asphalt Area	87	m ²

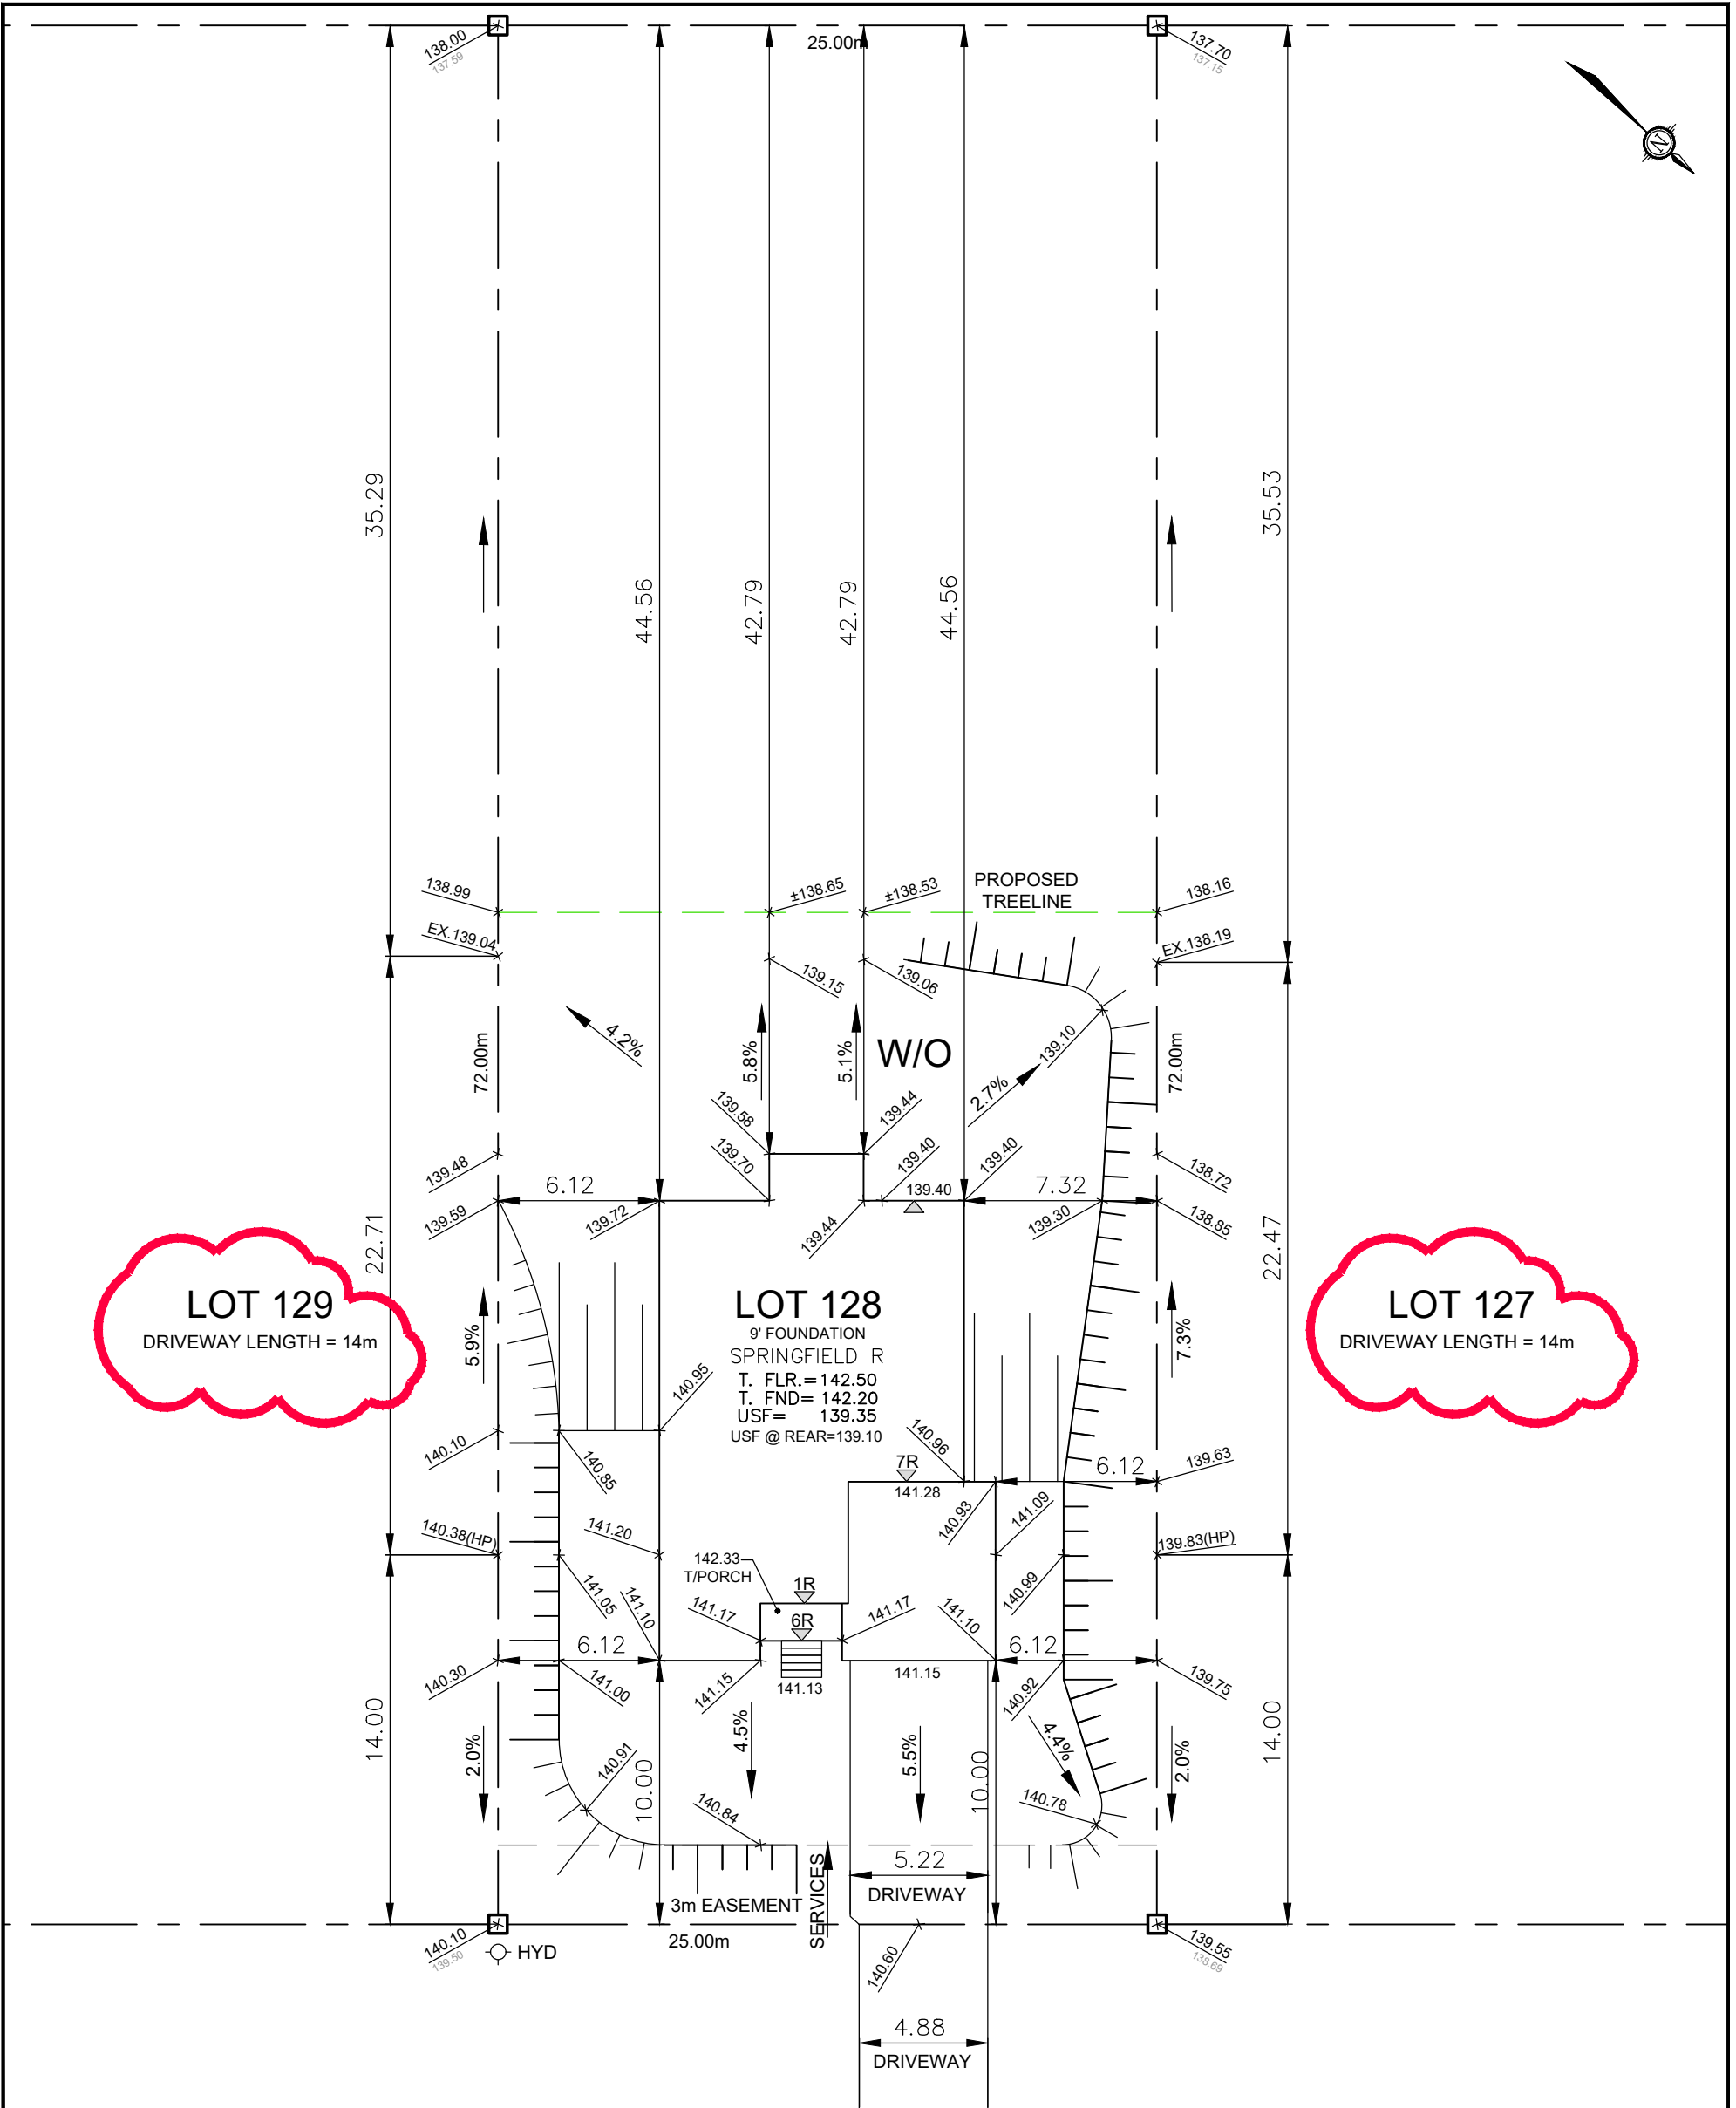

LOT 128

SITE/GRADING PLAN

WHITE TAIL RIDGE PH.IV

INDIVIDUAL LOT GRADING REVIEW SUMMARY FOR SITED HOUSE AS COMPARED WITH OVERALL SUBDIVISION PLAN

NOTE: THIS PLAN IS NOT A SURVEY PLAN OR SUBDIVISION PLAN WITHIN THE MEANING OF PLANNING ACT.

THIS PLAN IS FOR REFERENCE ONLY AND IS PRELIMINARY IN NATURE, ALL DIMENSIONS SHOWN ARE APPROXIMATE. E.O&E.

CHECKED/APPROVED BY:
T.L.MAK ENG.

REV. MAY 17/23 - CB

REV. JULY 06/23 - CB