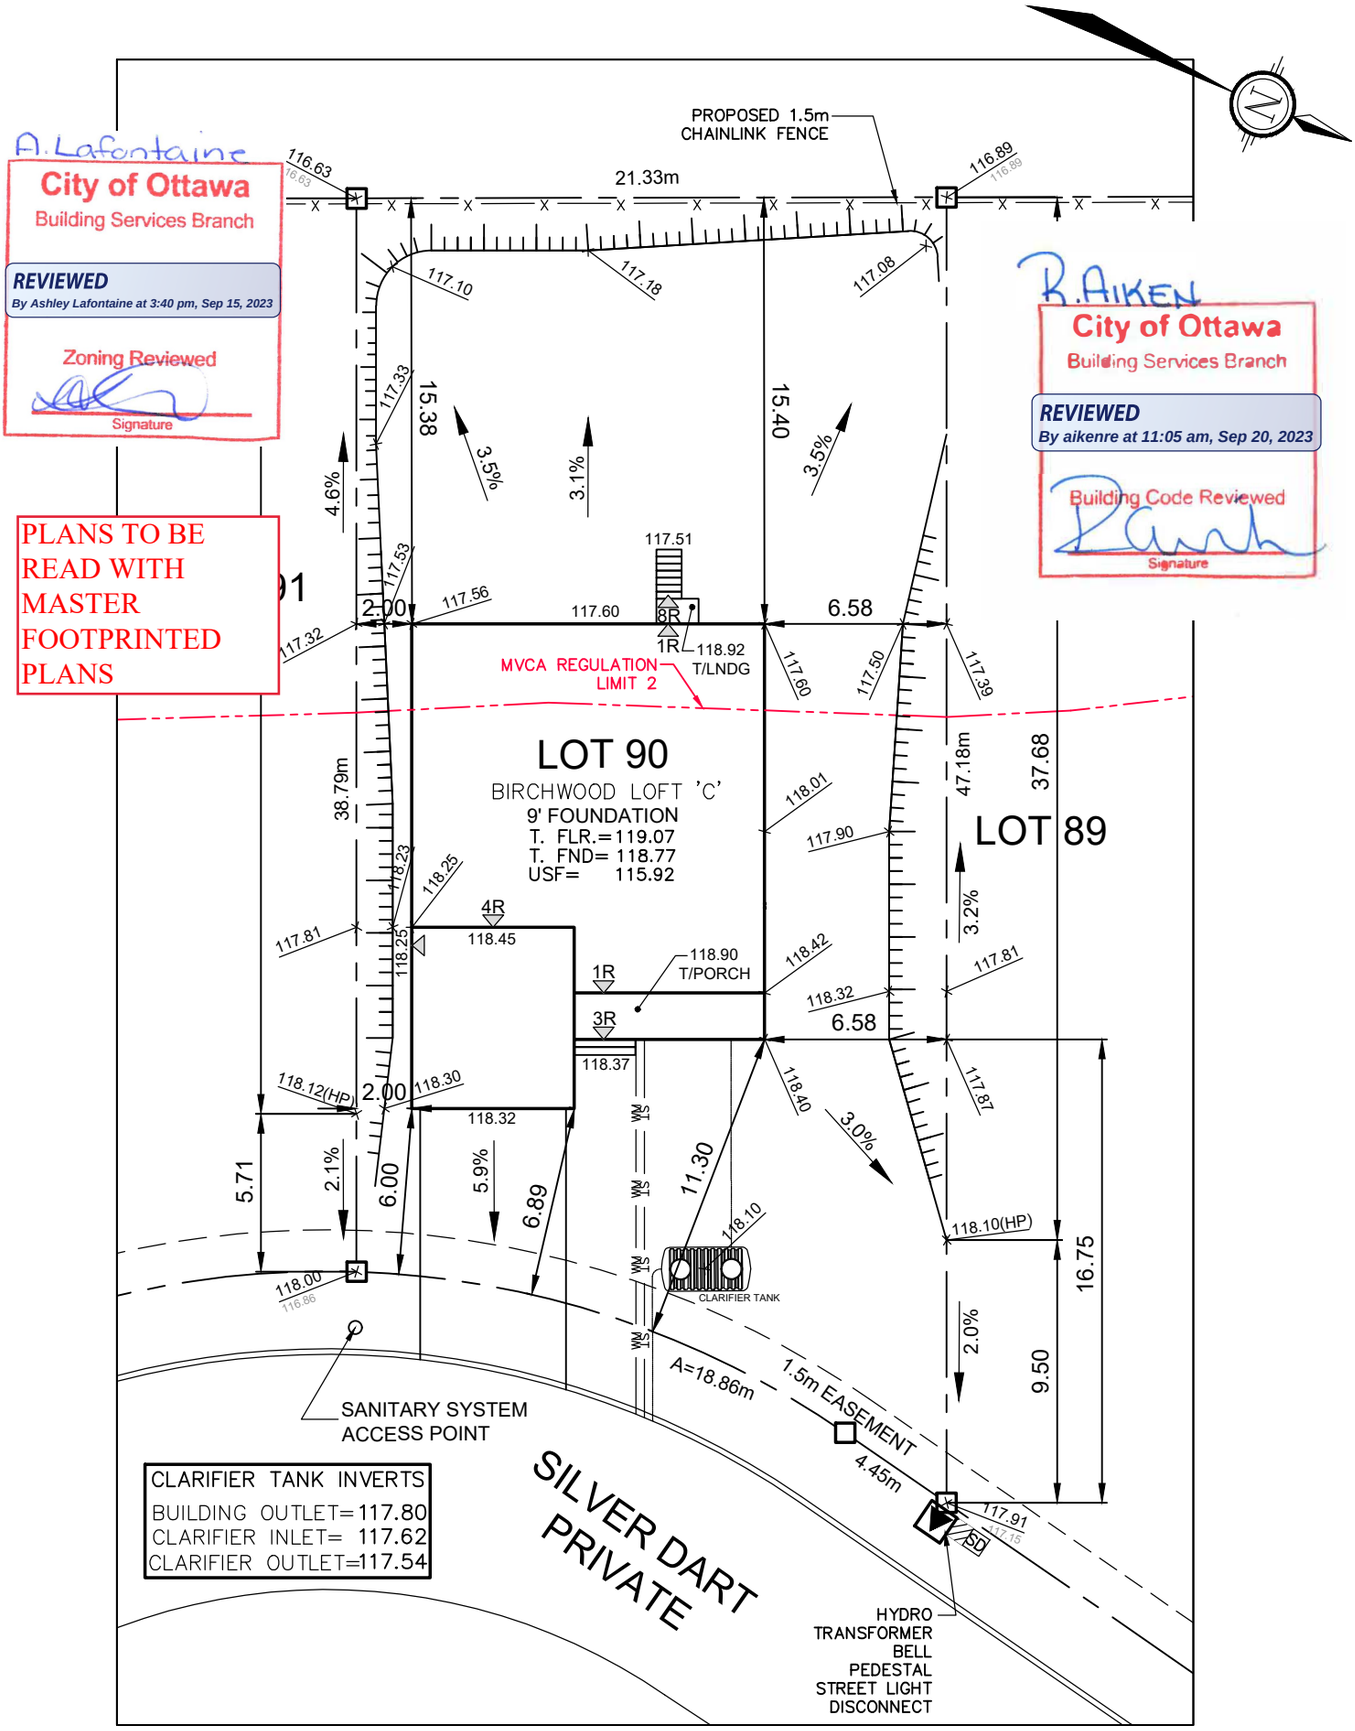

Owner/Applicant

DCR/PHOENIX HOMES

Telephone # 723-9227
Plan # 4M-1593
Project name: DIAMONDVIEW
Civic Address: 210 SILVER DART PRIV
House model: BIRCHWOOD LOFT 'C'

Bldg. Ht. _____ m
Lot coverage _____ %
Scale 1:250
Sod Area _____ m^2
Asphalt Area _____ m^2

CHECKED/APPROVED BY: T.L.MAK ENG.
REV. AUG 8/23 – CB
REV. AUG 29/23 – CB

PHOENIX HOMES

LOT 90 SITE/GRADING PLAN

DIAMONDVIEW PHASE 3

INDIVIDUAL LOT GRADING REVIEW SUMMARY FOR SITED HOUSE AS COMPARED WITH OVERALL SUBDIVISION PLAN

NOTE: THIS PLAN IS NOT A SURVEY PLAN OR SUBDIVISION PLAN WITHIN THE MEANING OF PLANNING ACT. THIS PLAN IS FOR REFERENCE ONLY AND IS PRELIMINARY IN NATURE, ALL DIMENSIONS SHOWN ARE APPROXIMATE. E,O&E.