




ANTLER COURT

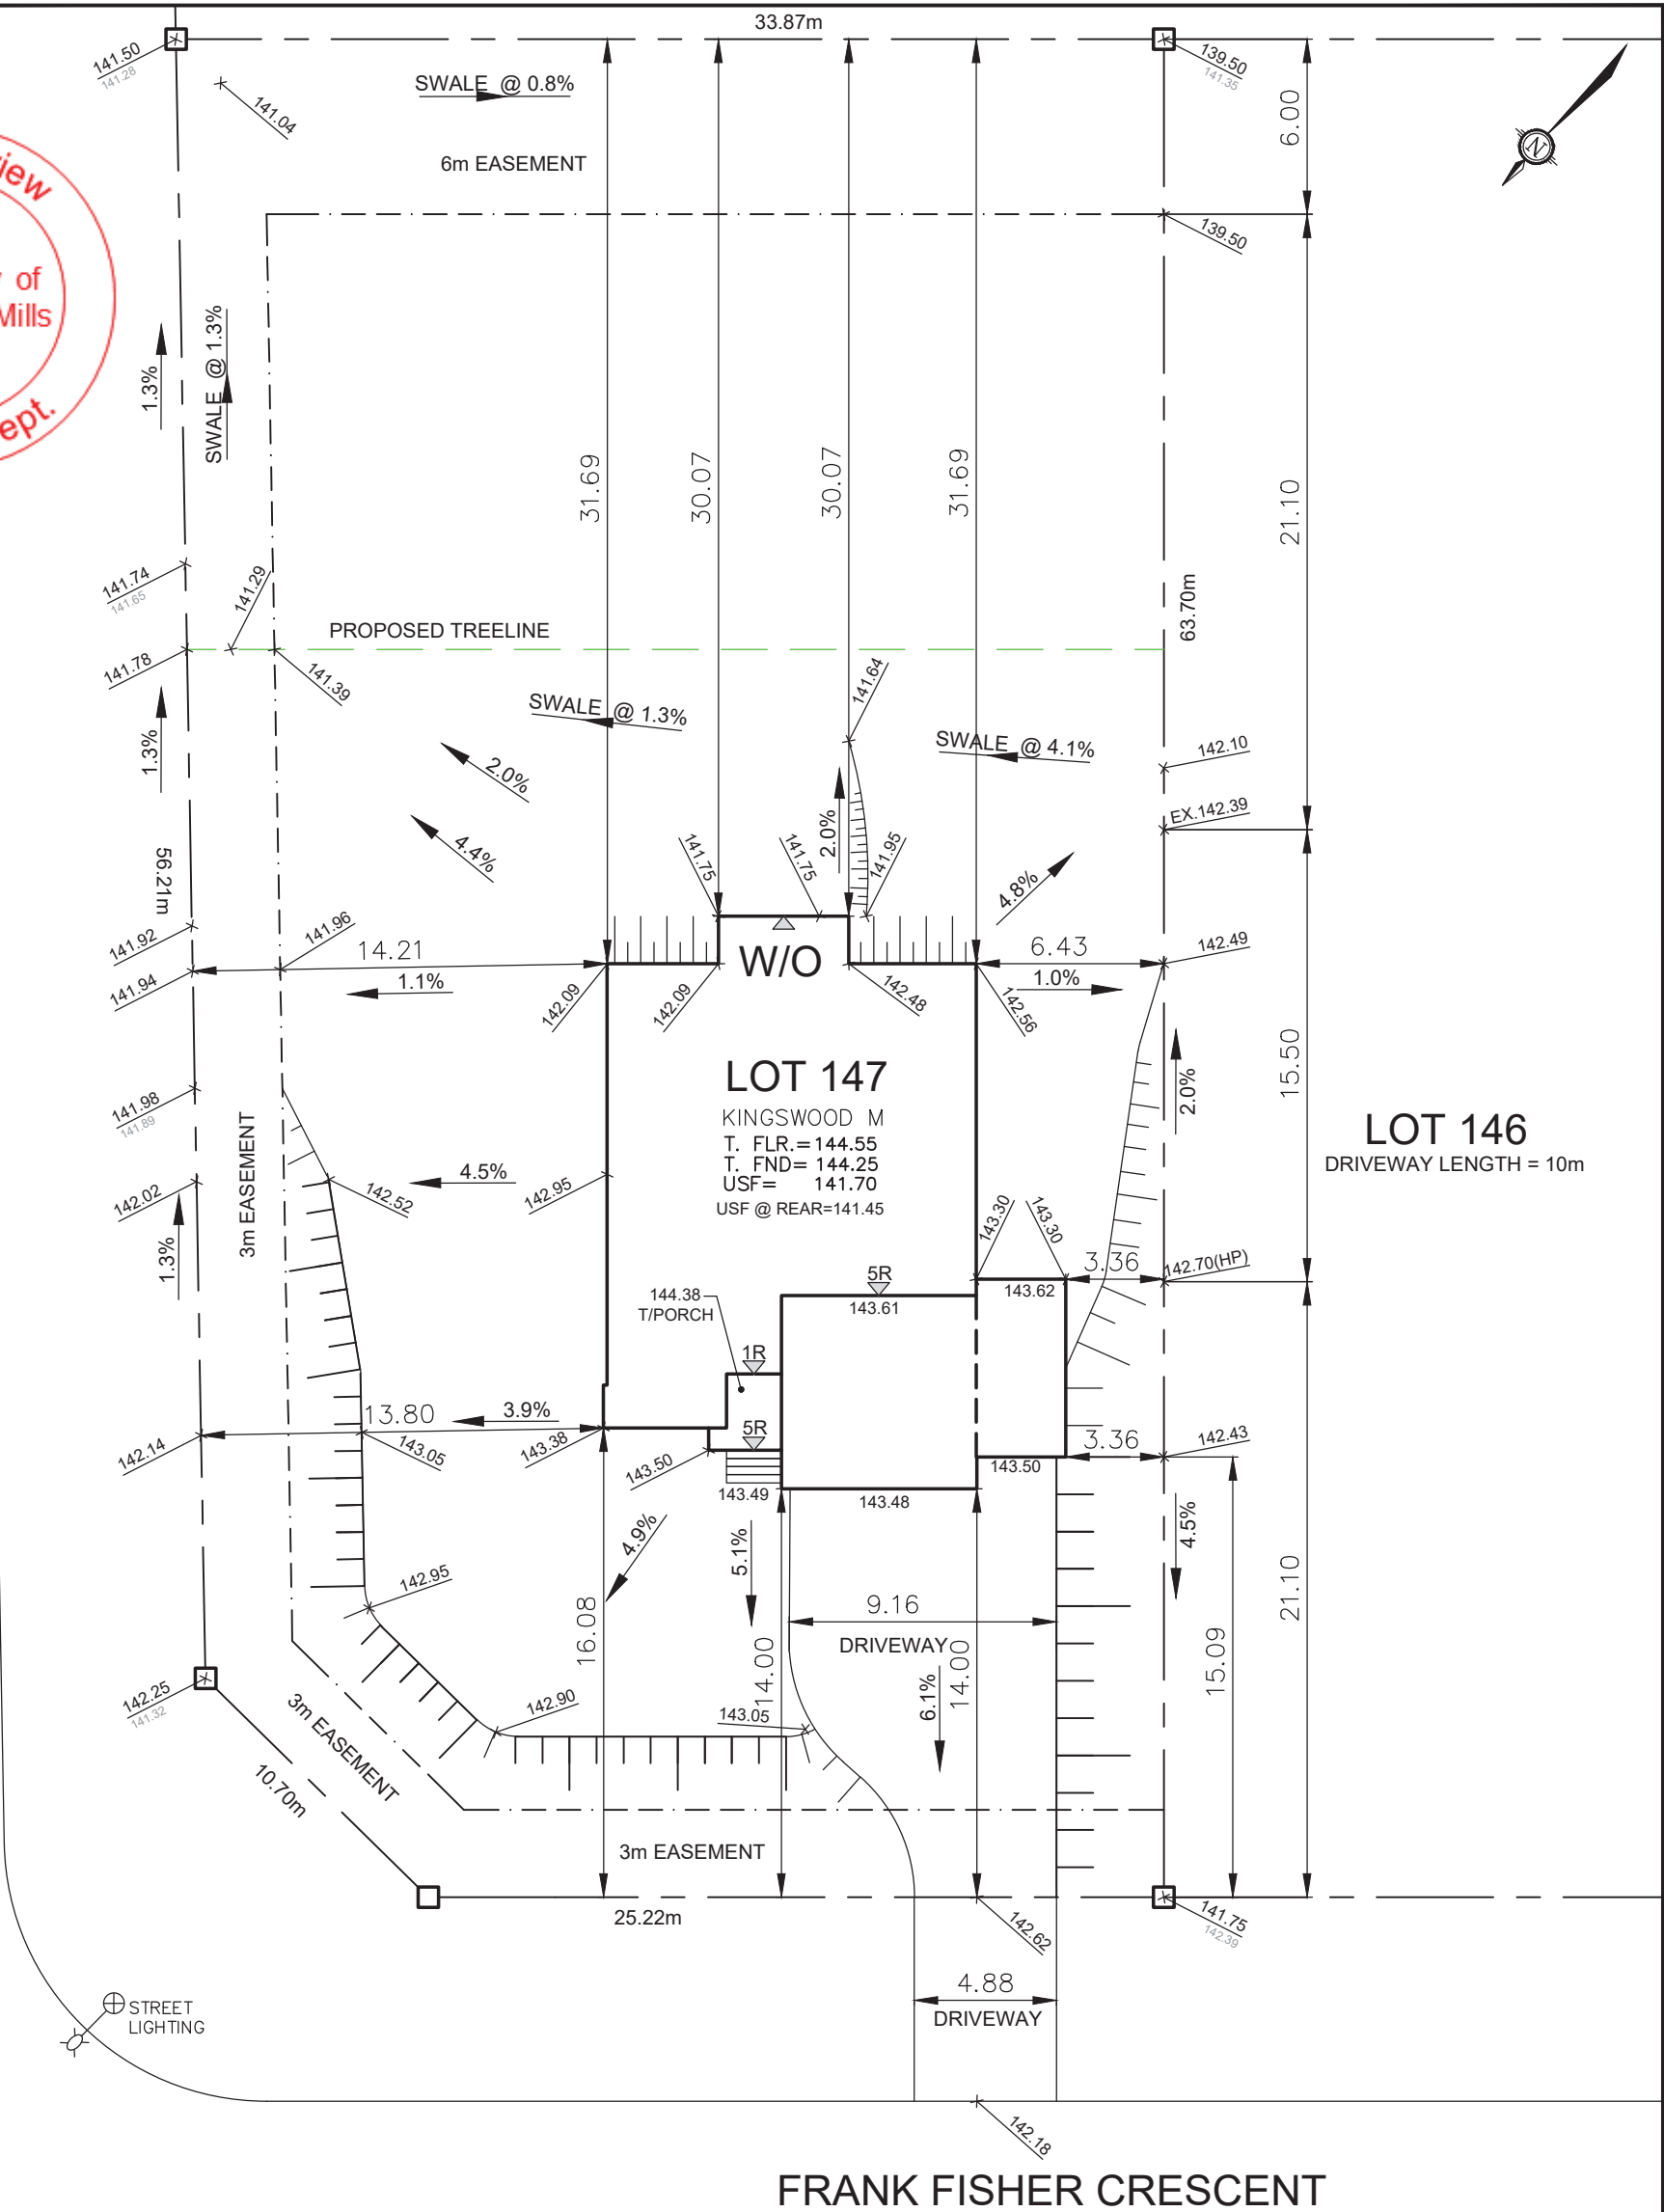

SITE/GRADING PLAN
WHITE TAIL RIDGE PH.IV

INDIVIDUAL LOT GRADING REVIEW SUMMARY FOR SITED
HOUSE AS COMPARED WITH OVERALL SUBDIVISION PLAN

NOTE: THIS PLAN IS NOT A SURVEY PLAN OR SUBDIVISION
PLAN WITHIN THE MEANING OF PLANNING ACT.
THIS PLAN IS FOR REFERENCE ONLY AND IS PRELIMINARY IN
NATURE, ALL DIMENSIONS SHOWN ARE APPROXIMATE. E.O&E.

Owner/Applicant	
DCR/PHOENIX HOMES	
Telephone #	723-9227
Plan #	27M-47
Project nameWHITE TAIL RIDGE	
Civic Address:173 FRANK FISHER CRES	
House model: KINGSWOOD M	
Bldg. Ht.	8.43
Lot coverage	11.6
Scale	1: 250
Sod Area	2438
Asphalt Area	147
CHECKED/APPROVED BY: T.L.MAK ENG.	