


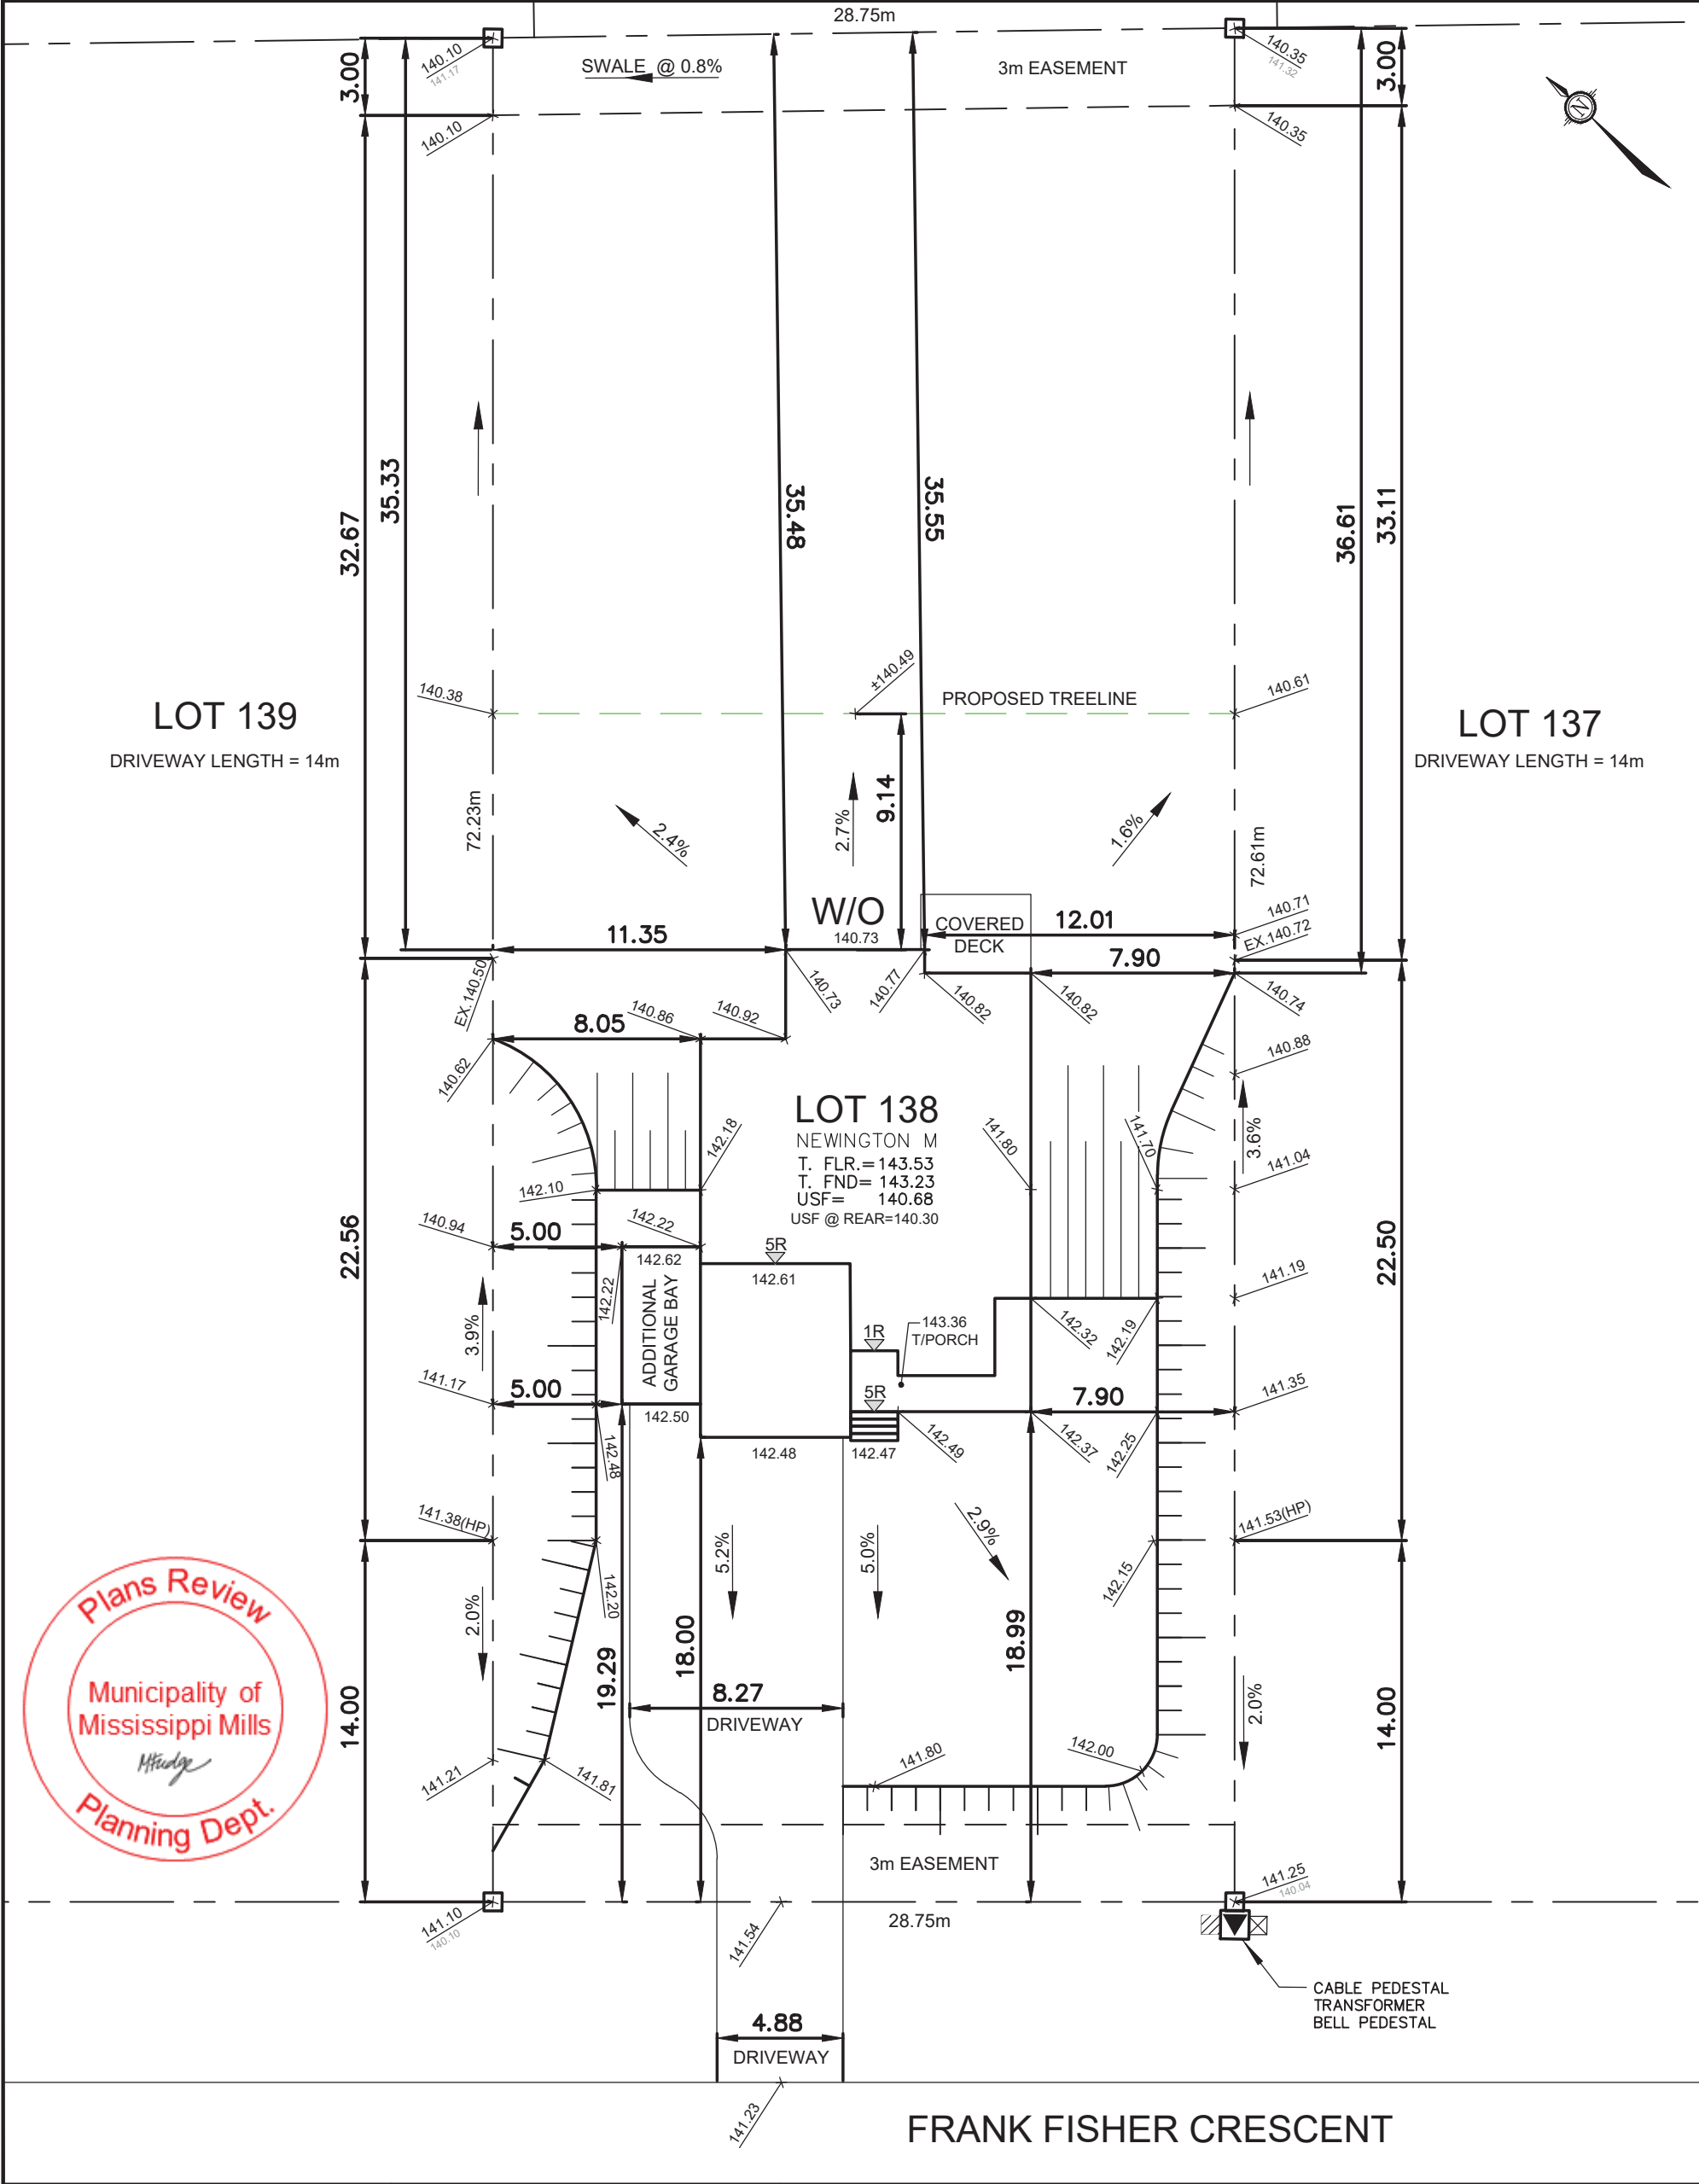

Owner/Applicant DCR/PHOENIX HOMES Telephone # 723-9227 Plan # 27M-47 Project nameWHITE TAIL RIDGE Civic Address115 FRANK FISHER House modelNEWINGTON M		Bldg. Ht.8.79m Lot coverage11.4% Scale1: 250 Sod Area1874m² Asphalt Area172m² CHECKED/APPROVED BY: T.L.MAK ENG. REV. AUG. 28/23 – CB	PHOENIX HOMES LOT 138 SITE/GRADING PLAN WHITE TAIL RIDGE PH.IV INDIVIDUAL LOT GRADING REVIEW SUMMARY FOR SITED HOUSE AS COMPARED WITH OVERALL SUBDIVISION PLAN NOTE: THIS PLAN IS NOT A SURVEY PLAN OR SUBDIVISION PLAN WITHIN THE MEANING OF PLANNING ACT. THIS PLAN IS FOR REFERENCE ONLY AND IS PRELIMINARY IN NATURE, ALL DIMENSIONS SHOWN ARE APPROXIMATE. E.O&E.
--	--	---	--