


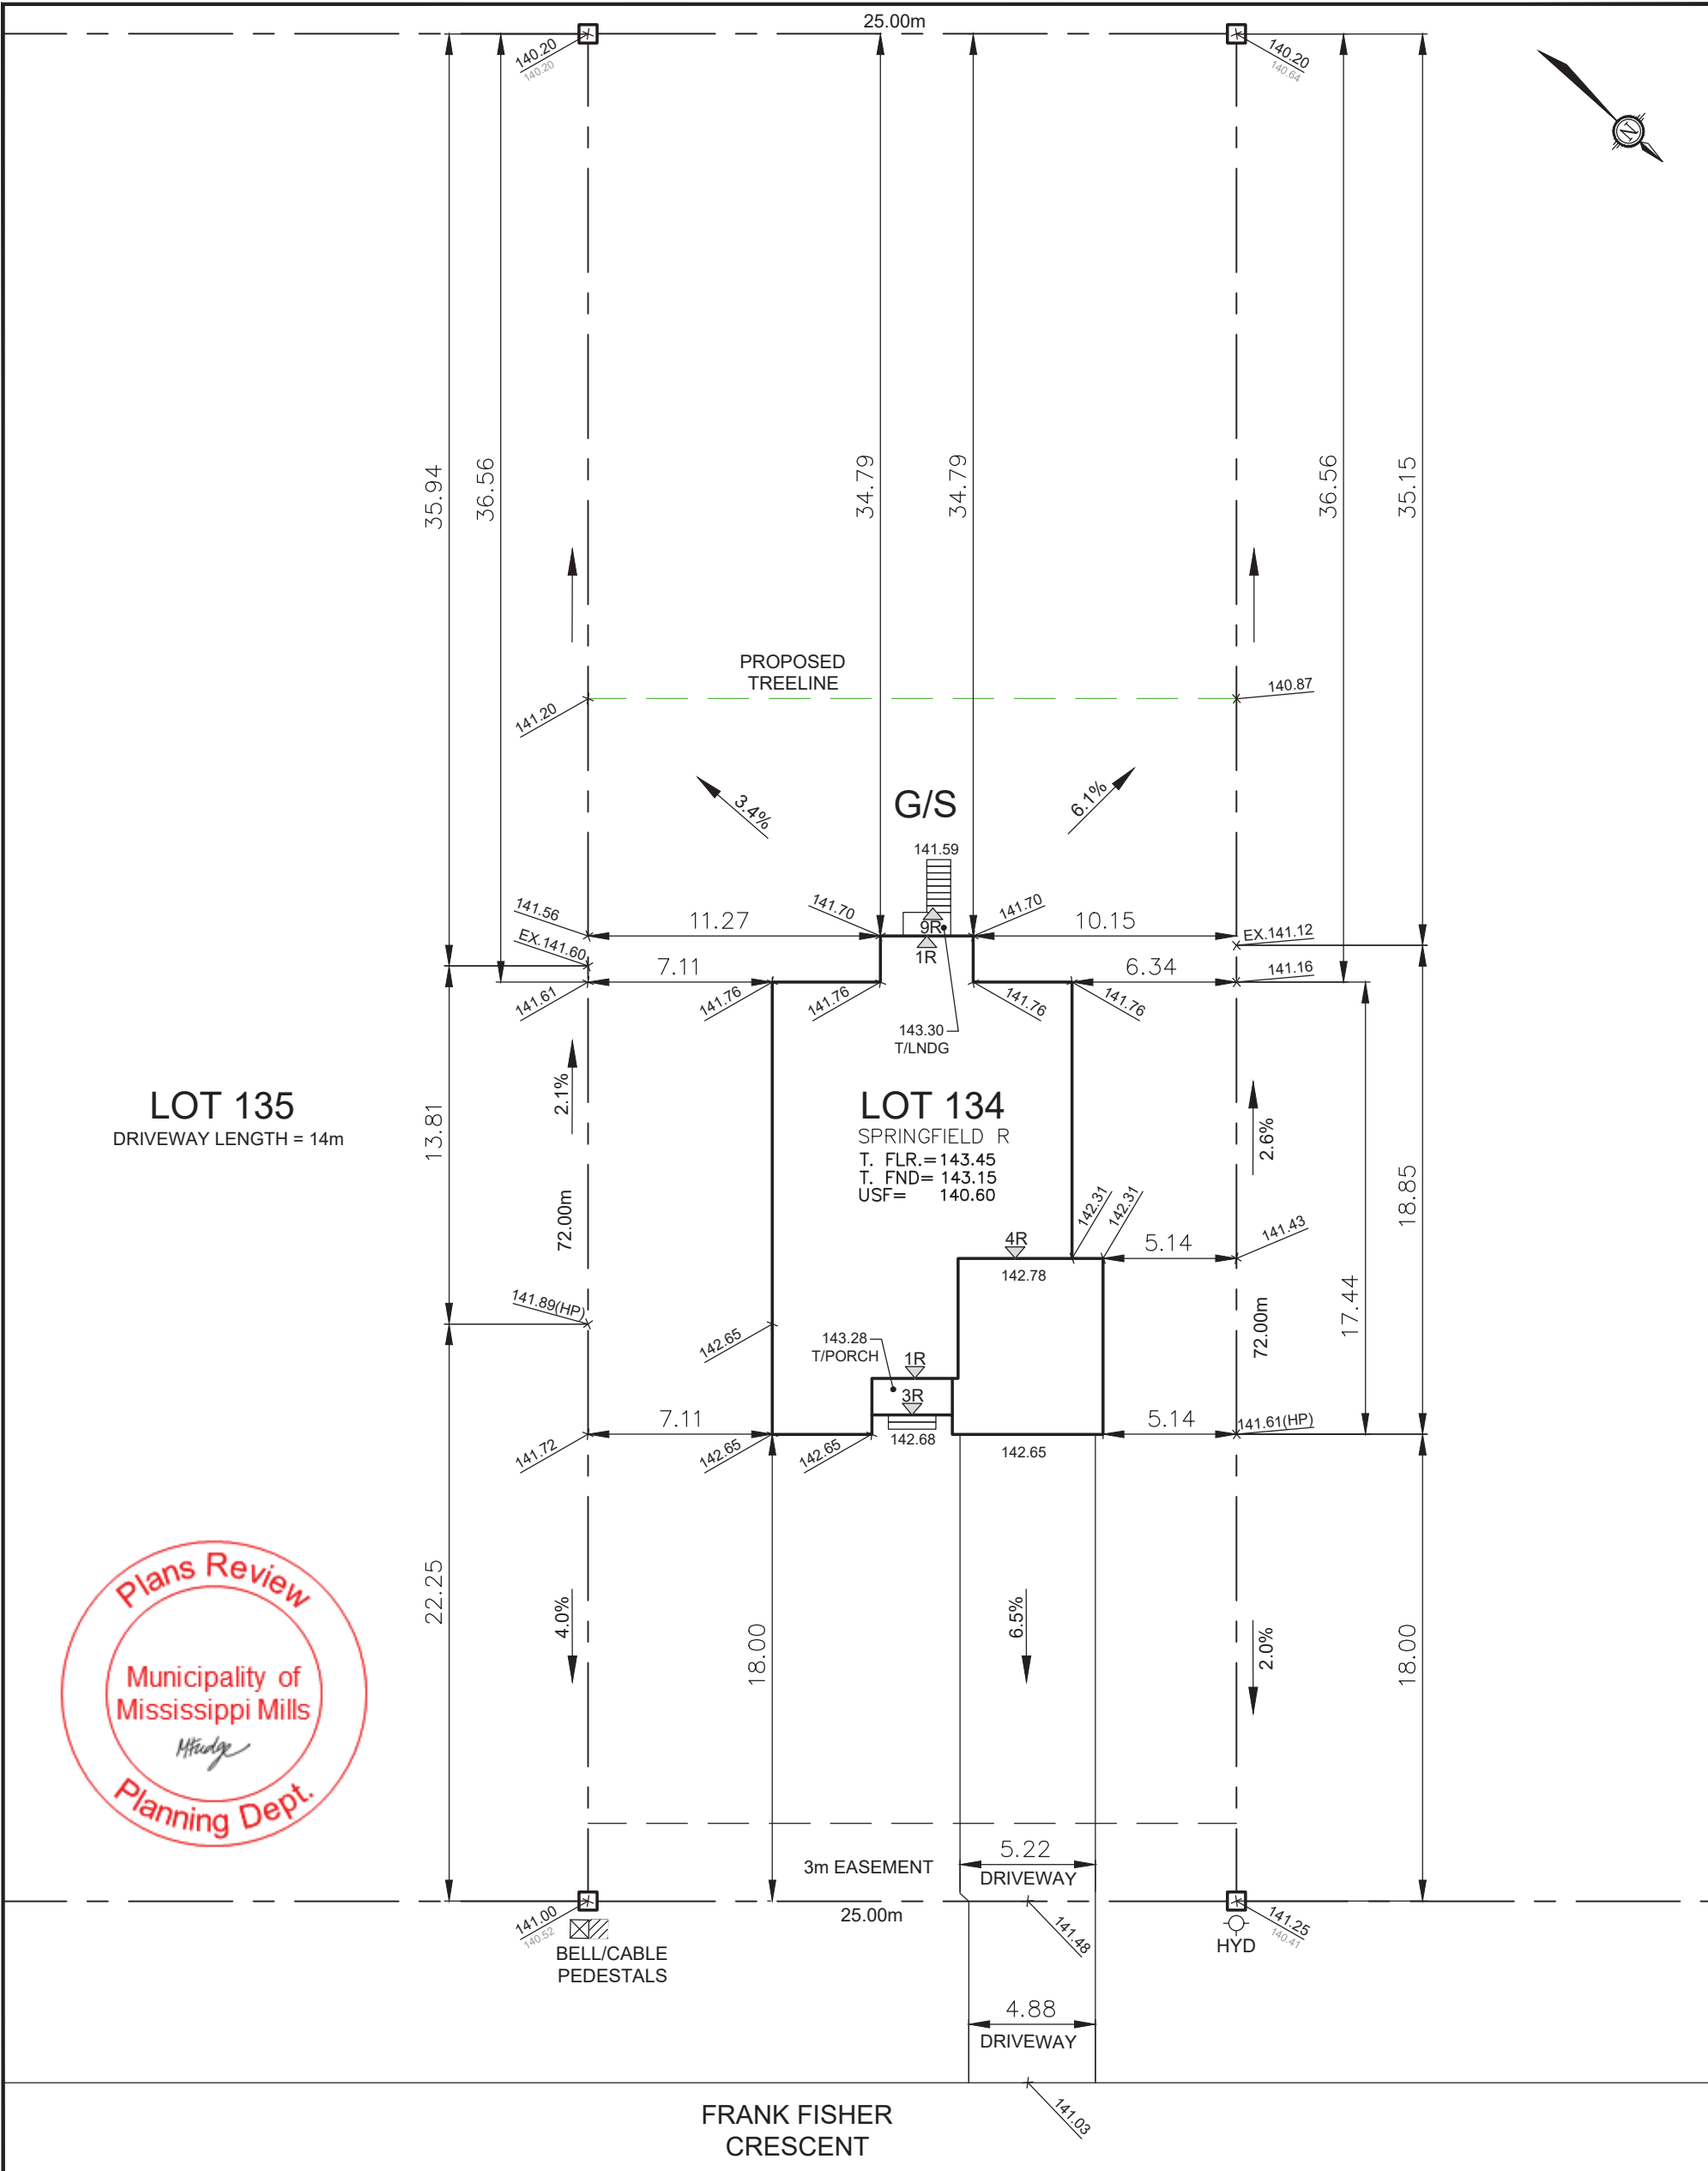

Owner/Applicant		
DCR/PHOENIX HOMES		
Telephone #	723-9227	
Plan #	27M-47	
Project name	WHITE TAIL RIDGE	
Civic Address	112 FRANK FISHER CRESCENT	
House model	SPRINGFIELD R	
Bldg. Ht.	7.42	m
Lot coverage	11.9	%
Scale	1:250	
Sod Area	128	m ²
Asphalt Area	1633	m ²



LOT
134

SITE/GRADING PLAN
WHITE TAIL RIDGE PH.IV

INDIVIDUAL LOT GRADING REVIEW SUMMARY FOR SITED HOUSE AS COMPARED WITH OVERALL SUBDIVISION PLAN

NOTE: THIS PLAN IS NOT A SURVEY PLAN OR SUBDIVISION PLAN WITHIN THE MEANING OF PLANNING ACT.

THIS PLAN IS FOR REFERENCE ONLY AND IS PRELIMINARY IN NATURE, ALL DIMENSIONS SHOWN ARE APPROXIMATE. E,O&E.

CHECKED/APPROVED BY:
T.L.MAK ENG.