

CONSTRUCTION NOTES

ALL CONSTRUCTION TO ADHERE TO THESE PLANS AND SPEC'S AND TO CONFORM TO THE ONTARIO BUILDING CODE AND ALL OTHER APPLICABLE CODES AND AUTHORITIES HAVING JURISDICTION. THESE REQUIREMENTS ARE TO BE TAKEN AS MINIMUM SPECIFICATIONS. ONT. REG. 332/12

1. ROOF CONSTRUCTION
NO.210 (10.25kg/m²) ASPHALT SHINGLES, 11.1mm (7/16") ASPENITE SHEATHING WITH "H" CHILLS. APPROVED WOOD TRUSSES @ 600mm (24") O.C. MAX. APPROVED EAVES PROTECTION TO EXTEND 900mm (3'-0") FROM EDGE OF ROOF AND MIN. 300mm (12") BEYOND INNER FACE OF EXTERIOR WALL. (EAVES PROTECTION NOT REQ. FOR ROOF 6-12 OR GREATER) 38x89 (2"x4") TRUSS BRACING @ 1830mm (6'-0") O.C. AT BOTTOM CHORD. PREF. ALUM. EXISTING/ROUGH, FASGA, R/W & VENTED SOFFIT. ATTIC VENTILATION 1:300 OF INSULATED CEILING AREA WITH 25% AT EAVES. AND 25% AT RIDGE (OBC 9.19.1.2)

2. FRAME WALL CONSTRUCTION (2"x6")
SIDING AS PER ELEVATION, APPROVED AIR BARRIER 11.1mm (7/16") EXTERIOR TYPE SHEATHING, 38x140 (2"x6") STUDS @ 400mm (16") O.C., RSI 3.87 (R22) INSULATION AND APPROVED VAPOUR BARRIER AND APPROVED CONT. AIR BARRIER, 13mm (1/2") INT. DRYWALL FINISH. SIDING TO BE MIN. 200mm (8") ABOVE FIN. GRADE

2A. SIDING AS PER ELEVATION, APPROVED AIR BARRIER, 38x89 (2"x4") STUDS @ 400mm (16") O.C., [FOR CLIENT UPGRADE ONLY - RSI 3.35 (R19) INSULATION AND APPROVED VAPOUR BARRIER, 13mm (1/2") INT. DRYWALL FINISH.] SIDING TO BE MIN. 200mm (8") ABOVE FIN. GRADE

3. BRICK VENEER CONSTRUCTION (2"x6")
90mm (4") FACE BRICK 25mm (1") AIR SPACE, 22x160x60.76mm (7/8"x7"x0.03") GALV. METAL TIES @ 400mm (16") O.C. HORIZONTAL 600mm (24") O.C. VERTICAL. APPROVED AIR BARRIER 11.1mm (7/16") EXTERIOR TYPE SHEATHING, 38x140 (2"x6") STUDS @ 400mm (16") O.C., RSI 3.87 (R22) INSULATION AND APPROVED VAPOUR BARRIER WITH APPROVED CONTIN. AIR BARRIER, 13mm (1/2") INT. DRYWALL FINISH. PROVIDE WEEP HOLES @ 800mm (32") O.C. BOTTOM COURSE AND OVER OPENINGS. PROVIDE THRU-WALL FLASHING UP MIN. 150mm (6") BEHIND BUILDING PAPER. BRICK TO BE MIN. 150mm (6") ABOVE FINISH GRADE.

3A. BRICK VENEER CONSTRUCTION (2"x4") GARAGE WALL
90mm (4") FACE BRICK 25mm (1") AIR SPACE, 22x160x60.76mm (7/8"x7"x0.03") GALV. METAL TIES @ 400mm (16") O.C. HORIZONTAL 600mm (24") O.C. VERTICAL. APPROVED AIR BARRIER, 38x89 (2"x4") STUDS @ 400mm (16") O.C. [FOR CLIENT UPGRADE ONLY - RSI 3.35 (R19) INSULATION AND APPROVED VAPOUR BARRIER, 13mm (1/2") INT. DRYWALL FINISH.] PROVIDE WEEP HOLES @ 800mm (32") O.C. BOTTOM COURSE AND OVER OPENINGS. PROVIDE THRU-WALL FLASHING UP MIN. 150mm (6") BEHIND BUILDING PAPER. BRICK TO BE MIN. 150mm (6") ABOVE FINISH GRADE.

4. INTERIOR STUD PARTITIONS FOR BEARING PARTITIONS 38x89 (2"x4") @ 400mm (16") O.C. FOR 2 STOREYS AND 300mm (12") O.C. FOR 3 STOREYS. NON-BEARING PARTITIONS 38x89 (2"x4") @ 600mm (24") O.C. PROVIDE 38x89 (2"x4") BOTTOM PLATE AND 2/38x89 (2/2"x4") TOP PLATE. 13mm (1/2") INT. DRYWALL BOTH SIDES OF STUDS, PROVIDE 38x140 (2"x6") STUDS/PLATES WHERE NOTED.

5. FOUNDATION WALL/FOOTINGS: -SEE OBC 9.15.3.1, 9.15.4.2, 9.15.4.4 (8") POURED CONC. FDN. WALL 20MPa (G/W 2-15M REBAR TOP & BOTTOM) WITH BITUMINOUS DAMPROOFING AND OPT. DRAINAGE LAYER, DRAINAGE LAYER REQ. WHEN BASEMENT INSUL. EXTENDS 800 (2'-11") BELOW FIN. GRADE. MAXIMUM POUR HEIGHT 2390 (7'-10") ON 500x155 (2"x6") CONTINUOUS KEYS CONC. FIG. BRACE FDN. WALL PRIOR TO BACKFILLING. ALL FOOTINGS SHALL REST ON NATURAL UNDISTURBED SOIL OR COMPACTED ENGINEERED FILL WITH MIN. BEARING CAPACITY OF 80kPa OR GREATER. IF SOIL BEARING DOES NOT MEET MIN. CAPACITY, ENGINEERED FOOTINGS ARE REQUIRED. MAX. FLOOR LIVE LOAD OF 2.4kPa(50psf) PER FLOOR, AND MAX. LENGTH OF SUPPORTED JOISTS IS 4.9m (16'-1"). REFER TO SOILS REPORT FOR SOILS CONDITIONS AND BEARING CAPACITY.

6. 100mm (4") DIA. WEEP TILE 150mm (6") CRUSHED STONE OVER AND AROUND WEEPING TILES.

7. BASEMENT SLAB OBC 9.3.1.6(1)(b) & 9.16.4.5(1) 80mm (3") MIN. 25MPa (3600psi) CONC. SLAB ON 100mm (4") COARSE GRANULAR FILL OR 15MPa. (2200psi) CONC. WITH DAMPROOFING BELOW SLAB.

8. EXPOSED FLOOR TO EXTERIOR, PROVIDE RSI 5.46 (R31) INSULATION, APPROVED VAPOUR BARRIER AND CONTINUOUS AIR BARRIER, FINISHED SOFFIT.

9. OBC. 12.3.2.1 & 12.3.3.7 ATTIC INSULATION RSI 8.81 (R60) BLOWN IN ROOF INSULATION AND APPROVED VAPOUR BARRIER, 13mm (1/2") INT. DRYWALL FINISH OR APPROVED EQUAL.

10. STAIRS, STEPS, HANDRAILS -OBC. 9.8.-
-9.8.2.1(2) STAIR WIDTH MEASURED BETWEEN WALL FACES OR GUARDS SHALL BE NOT LESS THAN 860mm (33 3/8") FOR REQUIRED EXIT STAIRS SERVING A HOUSE OR DWELLING UNIT. THAN 1950mm (76 3/8") CLEAR HEIGHT OVER STAIRS SHALL NOT BE LESS THAN 1950mm (76 3/8")
-9.8.4.4 STEP DIMENSIONS (TABLE 9.8.4.1)
STAIR COMPONENT MINIMUM MAXIMUM
RISE 125mm (4 7/8") 200mm (7 7/8")
RUN 255mm (10 1/4") 355mm (14")
-9.8.4.4.4 UNIFORMITY & TOLERANCES FOR RISERS & TREADS
-BETWEEN ADJACENT TREADS FOR RISERS & TREADS = 5mm
-BETWEEN TALLEST & SHORTEST RISER IN FLIGHT=10mm
-9.8.4.6(1)(b) MAX. NOSING 25mm (1")
-9.8.7.6(1)(b) CLEARANCE BETWEEN HANDRAIL AND SURFACE BEHIND IT TO BE MIN. 50mm (1 7/8")
-9.8.7.6(1) HANDRAILS SHALL NOT PROJECT MORE THAN 100mm (3 7/8") INTO REQUIRED WIDTH OF STAIR <SEE 9.8.2.1(1)>

11. GUARDS -OBC. 9.8.8.3.-
(1) EXT. GUARDS HEIGHT: =1070mm (42 1/2") MIN.
(2) INT. GUARDS HEIGHT: =900mm (35 3/8") MIN.
(1) STAIR LANDING GUARDS: =1070mm (42 1/2") MIN.
-9.8.8.8.5(1) MAX. OPENINGS THROUGH GUARDS =100mm (3 7/8")

12. 38x89 (2"x4") SILL PLATE WITH 13mm (1/2") DIA. ANCHOR BOLTS 200mm (8") LONG, EMBEDDED MIN. 100mm (4") INTO CONC. @ 2400mm (7'-10") O.C. USE NON-SHRINK GROUT TO LEVEL SILL PLATE WHEN REQUIRED. (SEE OBC 9.23.7)

13. R12 (3/8") CONTINUOUS BATT INSULATION, 2"x4" STUD WALL PLACED 3/4" AWAY FROM FILL STUD CAVITY WITH R10 BATT INSULATION, APPROVED VB TO 8" ABOVE FLOOR LEVEL

-APPROVED BLANKET INSULATION (R20) MECHANICALLY SECURED TO CONCRETE FOUNDATION WALL WITH 100mm HILT PINS (COMES WITH PLASTIC WASHER)

DAMPPOOF WITH BUILDING PAPER BETWEEN THE FOUNDATION WALL AND INSULATION UP TO GRADE LEVEL.
(SEE DETAIL ON "SB-12 DETAILS" PAGE)



PHOENIX HOMES

NEWINGTON R - 2022
SITE: DIAMONDVIEW PH 3

LOT NUMBER:

CIVIC ADDRESS:
102 CHANDELLE PVT

80

14. BEARING STUD PARTITION
38x89 (2"x4") STUDS @ 400mm (16") O.C. 38x89 (2"x4") SILL PLATE ON DAMPROOFING MATERIAL, 13mm (1/2") DIA. ANCHOR BOLTS 200mm (8") LONG, EMBEDDED MIN. 100mm (4") INTO CONC. @ 2400mm (7'-10") O.C. FOOTING. ADD HORIZ. CONC. CURB ON 38x155 (14"x6") CONC. FOOTING. ADD HORIZ. BLOCKING AT MID-HEIGHT IF WALL IS UNFINISHED.

15. STEEL BASEMENT COLUMN [SEE OBC. 9.17.3.1, 9.17.3.4]
75mm (3") DIA. ADJUSTABLE STL. COL. CONFORMING TO CAN/CSSB-7.2M. AND WITH 102x150x9.5 (4"x6"x3/8") STL. PLATE TOP & BOTTOM, 910x910x300 (36"x36"x12") CONC. FOOTING ON UNDISTURBED SOIL OR ENGINEERED FILL CAPABLE OF SUSTAINING A PRESSURE OF 100 Kpa. MINIMUM AND AS PER SOILS REPORT.

15A. STEEL BASEMENT COLUMN [SEE OBC. 9.17.3.1, 9.17.3.4]
38x89 (2"x4") NON-ADJUSTABLE STL. COL. WITH 150x150x9.5 (6"x6"x3/8") STL. TOP & BOTTOM PLATE ON 910x910x300 (36"x36"x12") CONC. FOOTING ON UNDISTURBED SOIL OR ENGINEERED FILL CAPABLE OF SUSTAINING A PRESSURE OF 100 Kpa. MIN. AND AS PER SOILS REPORT.

15B. STEEL BASEMENT COLUMN [SEE OBC. 9.17.3.1, 9.17.3.4]
38x89 (2"x4") NON-ADJUSTABLE STL. COL. WITH 150x150x9.5 (6"x6"x3/8") STL. TOP & BOTTOM PLATE ON 910x910x300 (36"x36"x12") CONC. FOOTING ON UNDISTURBED SOIL OR ENGINEERED FILL CAPABLE OF SUSTAINING A PRESSURE OF 100 Kpa. MIN. AND AS PER SOILS REPORT.

15C. STEEL COLUMN [SEE OBC. 9.17.3.1, 9.17.3.4]
38x89 (2"x4") NON-ADJUSTABLE STL. COL. WITH 150x150x9.5 (6"x6"x3/8") STL. TOP & BOTTOM PLATE ON 910x910x300 (36"x36"x12") CONC. FOOTING ON UNDISTURBED SOIL OR ENGINEERED FILL CAPABLE OF SUSTAINING A PRESSURE OF 100 Kpa. MIN. AND AS PER SOILS REPORT.

16. BEAM POCKET OR 300x150 (12"x6") POURED CONC. NIB WALLS. MIN. BEARING 90mm (3-1/2")

17. 19x64 (1"x3") CONTINUOUS WD. STRAPPING BOTH SIDES OF STEEL BEAM.

18. GARAGE SLAB, 100mm (4") 32MPa (4640psi) CONC. SLAB WITH 8-# AIR ENTRAINMENT ON OPT. 100 (4") COARSE GRANULAR FILL WITH COMPACTED SUB-BASE OR COMPACTED NATIVE FILL SLOPE TO FRONT AT 1% MIN.

19. 13mm (1/2") GYPSUM BD. ON WALL AND CEILING BETWEEN HOUSE AND GARAGE. RSI 3.87 (R22) IN WALLS, RSI 5.46 (R31) IN CEILING. PROVIDE APPROVED AIR BARRIER. TAPE AND SEAL ALL JOINTS AIR TIGHT.

20. DOOR AND FRAME GASPROOFED. DOOR EQUIPPED WITH SELF CLOSING DEVICE AND WEATHERSTRIPPING. PER OBC 9.10.13.1/5

21. WOOD STEP C/W HANDRAIL & LANDING IF MORE THAN 3 RISERS, MAX. RISE 200mm (7-7/8") MIN. TREAD 255mm (10-1/16") SEE OBC 9.8.9.2, 9.8.9.3 & 9.8.10

22. CAPPED DRYER EXHAUST VENTED TO EXTERIOR. (USE 100mm(4") DIA. SMOOTH WALL VENT PIPE) OBC 6.2.3.8(7)

23. ATTIC ACCESS HATCH 545x610 (21.5"x24") WITH A MIN. AREA OF 3.44 SF WITH WEATHERSTRIPPING RSI 7.0 (R40) RIGID INSUL BACKING OBC 9.19.2

24. FIREPLACE CHIMNEYS -OBC. 9.21.- TOP OF FIREPLACE CHIMNEY SHALL BE 915mm (3'-0") ABOVE THE HIGHEST POINT AT WHICH IT COMES IN CONTACT WITH THE ROOF AND 610mm (2'-0") ABOVE THE ROOF SURFACE WITHIN A HORIZ. DISTANCE OF 3050mm (10'-0") FROM THE CHIMNEY.

25. LINEN CLOSET, 4 SHELVES MIN. 350mm (14") DEEP.

26. MECHANICAL EXHAUST FAN, VENTED TO EXTERIOR, TO PROVIDE AT LEAST ONE AIR CHANGE PER HOUR.

27. STEEL BEARING PLATE FOR MASONRY WALLS 280x280x16 (11"x11"x5/8") STL. PLATE FOR STL BEAMS AND 280x280x12 (11"x11"x1/2") STL. PLATE FOR WOOD BEAMS BEARING ON CONC. BLOCK PARTIALLY ANCHORED WITH 2-19mm (3/4") x 200mm (8") LONG GALV. ANCHORS WITHIN SOLID BLOCK COURSE. LEVEL WITH NON-SHRINK GROUT.

28. U.L.C. RATED CLASS "B" VENT 610mm (2'-0") ABOVE THE POINT IN CONTACT WITH THE ROOF FOR SLOPES UP TO 9/12. REFER TO THE ONTARIO GAS UTILIZATION CODE.
3-2"x6" BUILT-UP-POST ON 24"x24"x10" CONCRETE FOOTING. (SEPARATE WOOD FROM CONCRETE W/ 6mil POLY AS PER OBC 9.17.4)

29. STEP FOOTINGS: MIN. HORIZ. STEP = 600mm (23-5/8"). MAX. VERT. STEP = 600mm (23-5/8") FOR FIRM SOILS.

30. PORCH SLAB/STEPS: 130 mm (5") MIN. CONC. 32 MPa SLAB AIR ENTRAINMENT MIN. 5 TO 8% AT 28 DAYS. 10 M BARS @ 250 O/C EACH WAY 10M DOWELS @400 (16") O.C. 2-15m IN THICKENED AREA FROM WALL TO SLAB ALL SIDES (SEE DETAIL)

31. DIRECT VENT FURNACE TERMINAL MIN. 900mm (36") FROM A GAS REGULATOR MIN. 300mm (12") ABOVE FIN. GRADE FROM ALL OPENINGS, EXHAUST AND INTAKE VENTS. HRV INTAKE TO BE A MIN. OF 1830mm (6'-0") FROM ALL EXHAUST TERMINALS. REFER TO GAS UTILIZATION CODE.
DIRECT VENT GAS FIREPLACE. VENT TO BE A MINIMUM 300mm (12") FROM ANY OPENING AND ABOVE FIN. GRADE. REFER TO GAS UTILIZATION CODE.

32. SUBFLOOR -19mm (3/4") T & G SUBFLOOR GLUED AND SCREWED TO ENGINEERED FLOOR JOIST SYSTEM. SUPPLY AND INSTALL BLOCKING AND/OR BRIDGING IF INDICATED BY FLOOR JOIST DESIGNER (REFER TO MANUFACTURER'S LAYOUTS AND INSTALLATION INSTRUCTIONS)

33. EXPOSED BUILDING FACE -OBC. 9.10.14.5- EXTERIOR WALLS TO HAVE A FIRE RESISTANCE RATING OF NOT LESS THAN 45 min. WHERE LIMITING DISTANCE IS LESS THAN 1.2M (3'-11"). THE LIMITING DISTANCE IS LESS THAN 600mm (1'-11") WHERE EXPOSING FACE SHALL BE CLAD IN NON-COMBUSTIBLE MATERIAL.

34. LINTEL SPECIFICATION
ALL WINDOW AND DOOR LINTELS TO BE COMPRISED OF 2-2X10 BUILT-UP WOOD BEAM, EACH END BEARING ON P2s (UNLESS NOTED OTHERWISE)

35. THE FDN. WALL SHALL NOT BE REDUCED TO LESS THAN 300mm (3 3/8") THICK TO A MAX. DEPTH OF 350mm (13 7/8") AND SHALL BE TIED TO THE FACING MATERIAL WITH METAL TIES SPACED 200mm (8") O.C. VERTICALLY AND 900mm (36") O.C. HORIZONTALLY. FILL SPACE BETWEEN WALL AND FACING SOLID WITH MORTAR. (SEE OBC 9.15.4.7)

36. CONVENTIONAL ROOF FRAMING 38x140 (2"x6") RAFTERS @ 400mm (16") O.C., FOR MAX. 11'-7" SPAN. 38x184 (2"x8") RIDGE BOARD. 38x89 (2"x4") COLLAR TIES AT MIDSPANS. CEILING JOISTS TO BE 38x89 (2"x4") @ 400mm (16") O.C. FOR MAX. 2830mm (9'-3") SPAN & 38x140 (2"x6") @ 400mm (16") O.C. FOR MAX. 4450mm (14'-7") SPAN. RAFTERS FOR BUILT-UP ROOF TO BE 38x89 (2"x4") @ 600mm (24") O.C. WITH A 38x89 (2"x4") CENTRE POST TO THE TRUSS BELOW, LATERALLY BRACED AT 1800mm (6'-0") O.C. VERTICALLY.

37. TWO STOREY VOLUME SPACES
FOR HIGH WALL UP TO 18'-0": CONSTRUCTION: 2"x6" SPACING AS INDICATED BLOCKING: 3 ROWS @ 4'-6" O/C ± SHEATHING: 7/16" ASPENITE NAULING: 2 STAPLES BET. 4" AND 6" O/C ALONG STUDS

38. STUD SPACING WITH VARIOUS FINISHES:
1. SIDING-METAL OR VINYL- 2"x6" @12" O/C
2. STUCCO -2"x6" @16" O/C
3. BRICK TO 4'-0" -2"x6" @16" O/C
4. BRICK FULL HEIGHT -2"x6" @12" O/C

40. TYPICAL 1 HOUR RATED PARTYWALL. REFER TO DETAILS FOR TYPE AND SPECIFICATIONS.

WINDOWS:

1. MINIMUM BEDROOM WINDOW -OBC. 9.9.10. AT LEAST ONE BEDROOM WINDOW ON A GIVEN FLOOR IS TO HAVE MIN. 0.35m² UNOBSTRUCTED GLAZED OR OPENABLE AREA WITH MIN. CLEAR WIDTH OF 380 mm (1'-3"). WINDOW GUARDS -OBC. 9.8.8.1. A GUARD IS REQUIRED WHERE THE TOP OF THE WINDOW SILL IS LOCATED LESS THAN 480mm (1'-7") ABOVE FIN. FLOOR AND THE DISTANCE FROM THE FIN. FLOOR TO THE ADJACENT GRADE IS GREATER THAN 1800mm (5'-11")

2. ALL WINDOWS TO COMPLY WITH THERMAL RESISTANCE REQUIREMENTS STATED IN OBC 12.3.2.6. AND SBI2 PRESCRIPTIVE COMPLIANCE PACKAGE, AND OBC 9.5, 9.6, 9.7

GENERAL:

1. MECHANICAL VENTILATION IS REQUIRED TO PROVIDE 0.3 AIR CHANGES PER HOUR AVERAGED OVER 24 HOURS. SEE MECHANICAL DRAWINGS.
2. ALL DOWNSPOUTS TO DRAIN AWAY FROM THE BUILDINGS PER OBC 9.26.18.2 AND MUN. STANDARDS.
3. ALL WINDOW WELLS TO DRAIN TO FOOTING LEVEL PER OBC 9.14.6.3 CHECK WITH LOCAL AUTHORITY.
4. PROVIDE STUD WALL REINFORCEMENT FOR FUTURE GRAB BARS IN BATHROOMS. REINF. OF STUD WALLS SHALL BE INSTALLED ADJACENT TO WATER CLOSETS AND SHOWER OR BATHTUB IN MAIN BATHROOM. SEE OBC 9.5.2.3.

LUMBER:

1. ALL LUMBER SHALL BE SPRUCE NO.2 GRADE, UNLESS NOTED OTHERWISE.
2. STUDS SHALL BE STUD GRADE SPRUCE, UNLESS NOTED OTHERWISE.
3. LUMBER EXPOSED TO THE EXTERIOR TO BE SPRUCE NO.2 GRADE PRESSURE TREATED OR CEDAR, UNLESS NOTED OTHERWISE.

4. ALL LAMINATED VENEER LUMBER (L.V.L.) BEAMS, GIRDER TRUSSES, AND METAL HANGER CONNECTIONS SUPPORTING ROOF FRAMING TO BE DESIGNED & CERTIFIED BY TRUSS MANUF.

5. LVL BEAMS SHALL BE 2.0E WS MICRO-LAM LVL (Fb=2800psi,MIN) OR EQUIVALENT. NAIL EACH PLY OF LVL WITH 89mm (3 1/2") LONG COMMON WIRE NAILS @ 300mm (12") O.C. STAGGERED IN 2 ROWS FOR 184, 240 & 300mm (7 1/4", 9 1/2", 11 7/8") DEPTHS AND STAGGERED IN 3 ROWS FOR GREATER DEPTHS AND FOR 4 PLY MEMBERS ADD 13mm (1/2") DIA. GALVANIZED BOLTS BOLTED AT MID-DEPTH OF BEAM @ 915mm (3'-0") O.C.

6. PROVIDE TOP MOUNT BEAM HANGERS TYPE "SC" MANUFACTURED BY MCA CONNECTOR LTD. Tel. (905) 642-3175 OR EQUAL FOR ALL LVL BEAM TO BEAM CONNECTIONS UNLESS OTHERWISE NOTED.

7. JOIST HANGERS, PROVIDE METAL HANGERS FOR ALL JOISTS AND BUILT-UP WOOD MEMBERS INTERSECTING FLUSH BUILT-UP WOOD MEMBERS.

8. WOOD FRAMING NOT TREATED WITH A WOOD PRESERVATIVE, IN CONTACT WITH CONCRETE, SHALL BE SEPARATED FROM THE CONCRETE BY AT LEAST 2 mil. POLYETHYLENE FILM, No. 50 (45lbs.) ROLL ROOFING OR OTHER DAMPROOFING MATERIAL, EXCEPT WHERE THE WOOD MEMBER IS AT LEAST 150mm (6") ABOVE THE GROUND.

STEEL:

1. STRUCTURAL STEEL SHALL CONFORM TO CAN/CSA-G40-21 GRADE 300M. HOLLOW STRUCTURAL SECTIONS SHALL CONFORM TO CAN/CSA-G40-21 GRADE 350W CLASS "H".
2. REINFORCING STEEL SHALL CONFORM TO CSA-G30-18M GRADE 400R.

WOOD LINTELS AND BUILT-UP WOOD BEAMS

L1	2/38 x 184 (2/2" x 8") SPR.#2	L7	90 x 90 x 6.0L (3-1/2" x 3-1/2" x 1/4")
B1	3/38 x 184 (3/2" x 8") SPR.#2	L8	90 x 90 x 8.0L (3-1/2" x 3-1/2" x 5/16")
B2	4/38 x 184 (4/2" x 8") SPR.#2	L9	100 x 90 x 8.0L (4" x 3-1/2" x 5/16")
		L10	125 x 90 x 8.0L (5" x 3-1/2" x 5/16")
L3	2/38 x 235 (2/2" x 10") SPR.#2	L11	125 x 90 x 10.0L (5" x 3-1/2" x 3/8")
B3	3/38 x 235 (3/2" x 10") SPR.#2	L12	150 x 100 x 10.0L (6" x 4" x 3/8")
B4	4/38 x 235 (4/2" x 10") SPR.#2		

LAMINATED VENEER LUMBER (LVL) BEAMS


LVL1	2-1 3/4"x7 1/4" (2-45x184)
LVL2	3-1 3/4"x7 1/4" (3-45x184)
LVL3	4-1 3/4"x7 1/4" (4-45x184)
LVL4	2-1 3/4"x9 1/2" (2-45x240)
LVL5	3-1 3/4"x9 1/2" (3-45x240)
LVL6	2-1 3/4"x11 7/8" (2-45x300)
LVL7	3-1 3/4"x11 7/8" (3-45x300)

STEEL COLUMNS (UNLESS NOTED OTHERWISE)

TP = (1) 3" DIA. ADJ. ST. POST
ZTP = (2) 3" DIA. ADJ. ST. POSTS
HSS = 3.5"x3.5" HOLLOW STRUCTURAL SECTION STEEL POST

OPENINGS	LINTEL SIZE
UP TO 8'-0"	3 1/2" x 3 1/2" x 1 1/4"
8'-0" TO 8'-8"	4" x 3 1/2" x 1 1/4"
8'-8" TO 10'-10"	5" x 3 1/2" x 5/16"
10'-10" TO 11'-5"	5" x 3 1/2" x 7/16"
11'-5" TO 11'-9"	5" x 3 1/2" x 1 1/2"
11'-9" TO 12'-6"	6" x 3 1/2" x 7/16"
12'-6" TO 13'-4"	6" x 3 1/2" x 1 1/2"

LEGEND

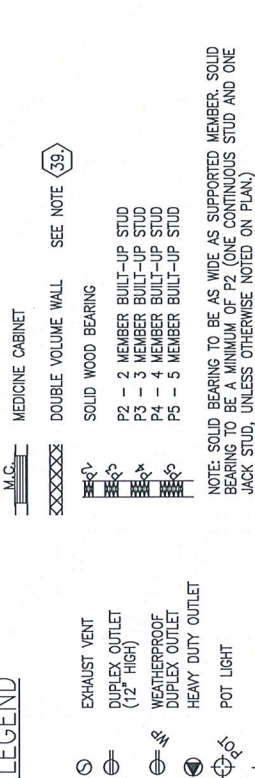

NOTE: SOLID BEARING TO BE AS WIDE AS SUPPORTED MEMBER. SOLID BEARING TO BE A MINIMUM OF P2 (ONE CONTINUOUS STUD AND ONE JACK STUD, UNLESS OTHERWISE NOTED ON PLAN).

SMOKE ALARM (AUDIBLE/VISUAL)-OBC 9.10.19.
PROVIDE 1 PER FLOOR NEAR THE STAIRS CONNECTING THE FLOOR LEVEL ONE PER SLEEPING ROOM. INCLUDING HALLWAYS BE CONNECTED TO AN ELECTRICAL CIRCUIT AND INTERCONNECTED TO ACTIVATE ALL ALARMS WHEN ONE ALARM SOUNDS.
-9.10.9.1(2) REQUIRED SMOKE ALARMS TO HAVE A VISUAL COMPONENT
WHERE A FUEL-BURNING APPLIANCE IS INSTALLED IN A DWELLING UNIT, A CARBON MONOXIDE ALARM CONFORMING TO CAN/CSA-6.19, CSA 6.19 OR UL2034 SHALL BE INSTALLED ADJACENT TO EACH SLEEPING AREA. CARBON MONOXIDE ALARM(S) SHALL BE PERMANENTLY WIRED SO THAT ITS ACTIVATION WILL ACTIVATE ALL CARBON MONOXIDE ALARMS AND BE EQUIPPED WITH AN ALARM THAT IS AUDIBLE WITHIN BEDROOMS WHEN THE INTERVENING DOORS ARE CLOSED.


SOIL GAS CONTROL OBC 9.13.1. & 9.13.4. & SB9) PROVIDE CONSTRUCTION TO PREVENT LEAKAGE OF SOIL GAS INTO THE BUILDING WHERE REQUIRED. (SEE ALSO OBC. 9.11.7.1(1))

CONTRACTOR MUST VERIFY ALL DIMENSIONS ON THE JOB AND REPORT ANY DISCREPANCY TO THE BUILDER BEFORE PROCEEDING WITH THE WORK. DO NOT SCALE DRAWINGS. USE DIMENSIONS PROVIDED. ALL DRAWINGS TO BE USED FOR CONSTRUCTION ONLY AFTER BUILDING PERMIT HAS BEEN ISSUED.


footprint:	50-22-7
drawn by:	SP
date:	JUN 12/16
scale:	3/16"=1'-0"
D.C.L. -	A-24
sheet no:	1
1R of	9

	09/05/24	08
6 ISSUED FOR ENGINEERING		
5 ISSUED FOR LAYOUTS	01/04/24	08
4 BEP BLACKLINES	25/03/24	08
3 B1 BLACKLINES	21/02/24	SP
2 KITCHEN LIGHT UPDATE	20/10/22	SP
1 FOR LAYOUTS AND STRUCTURE REVIEW	11/03/22	SP
No. Description	dd/mm/yy	By
REVISIONS		

****REQUIRED FOR WINDOWS OVER 47" WIDE****
O.B.C. 9.15.4.3
ADD 2-15M HORIZONTAL BARS BELOW WINDOW EXTENDING 2'-0"
BEYOND EDGE OF OPENING & 2-15M VERTICAL BARS EACH SIDE

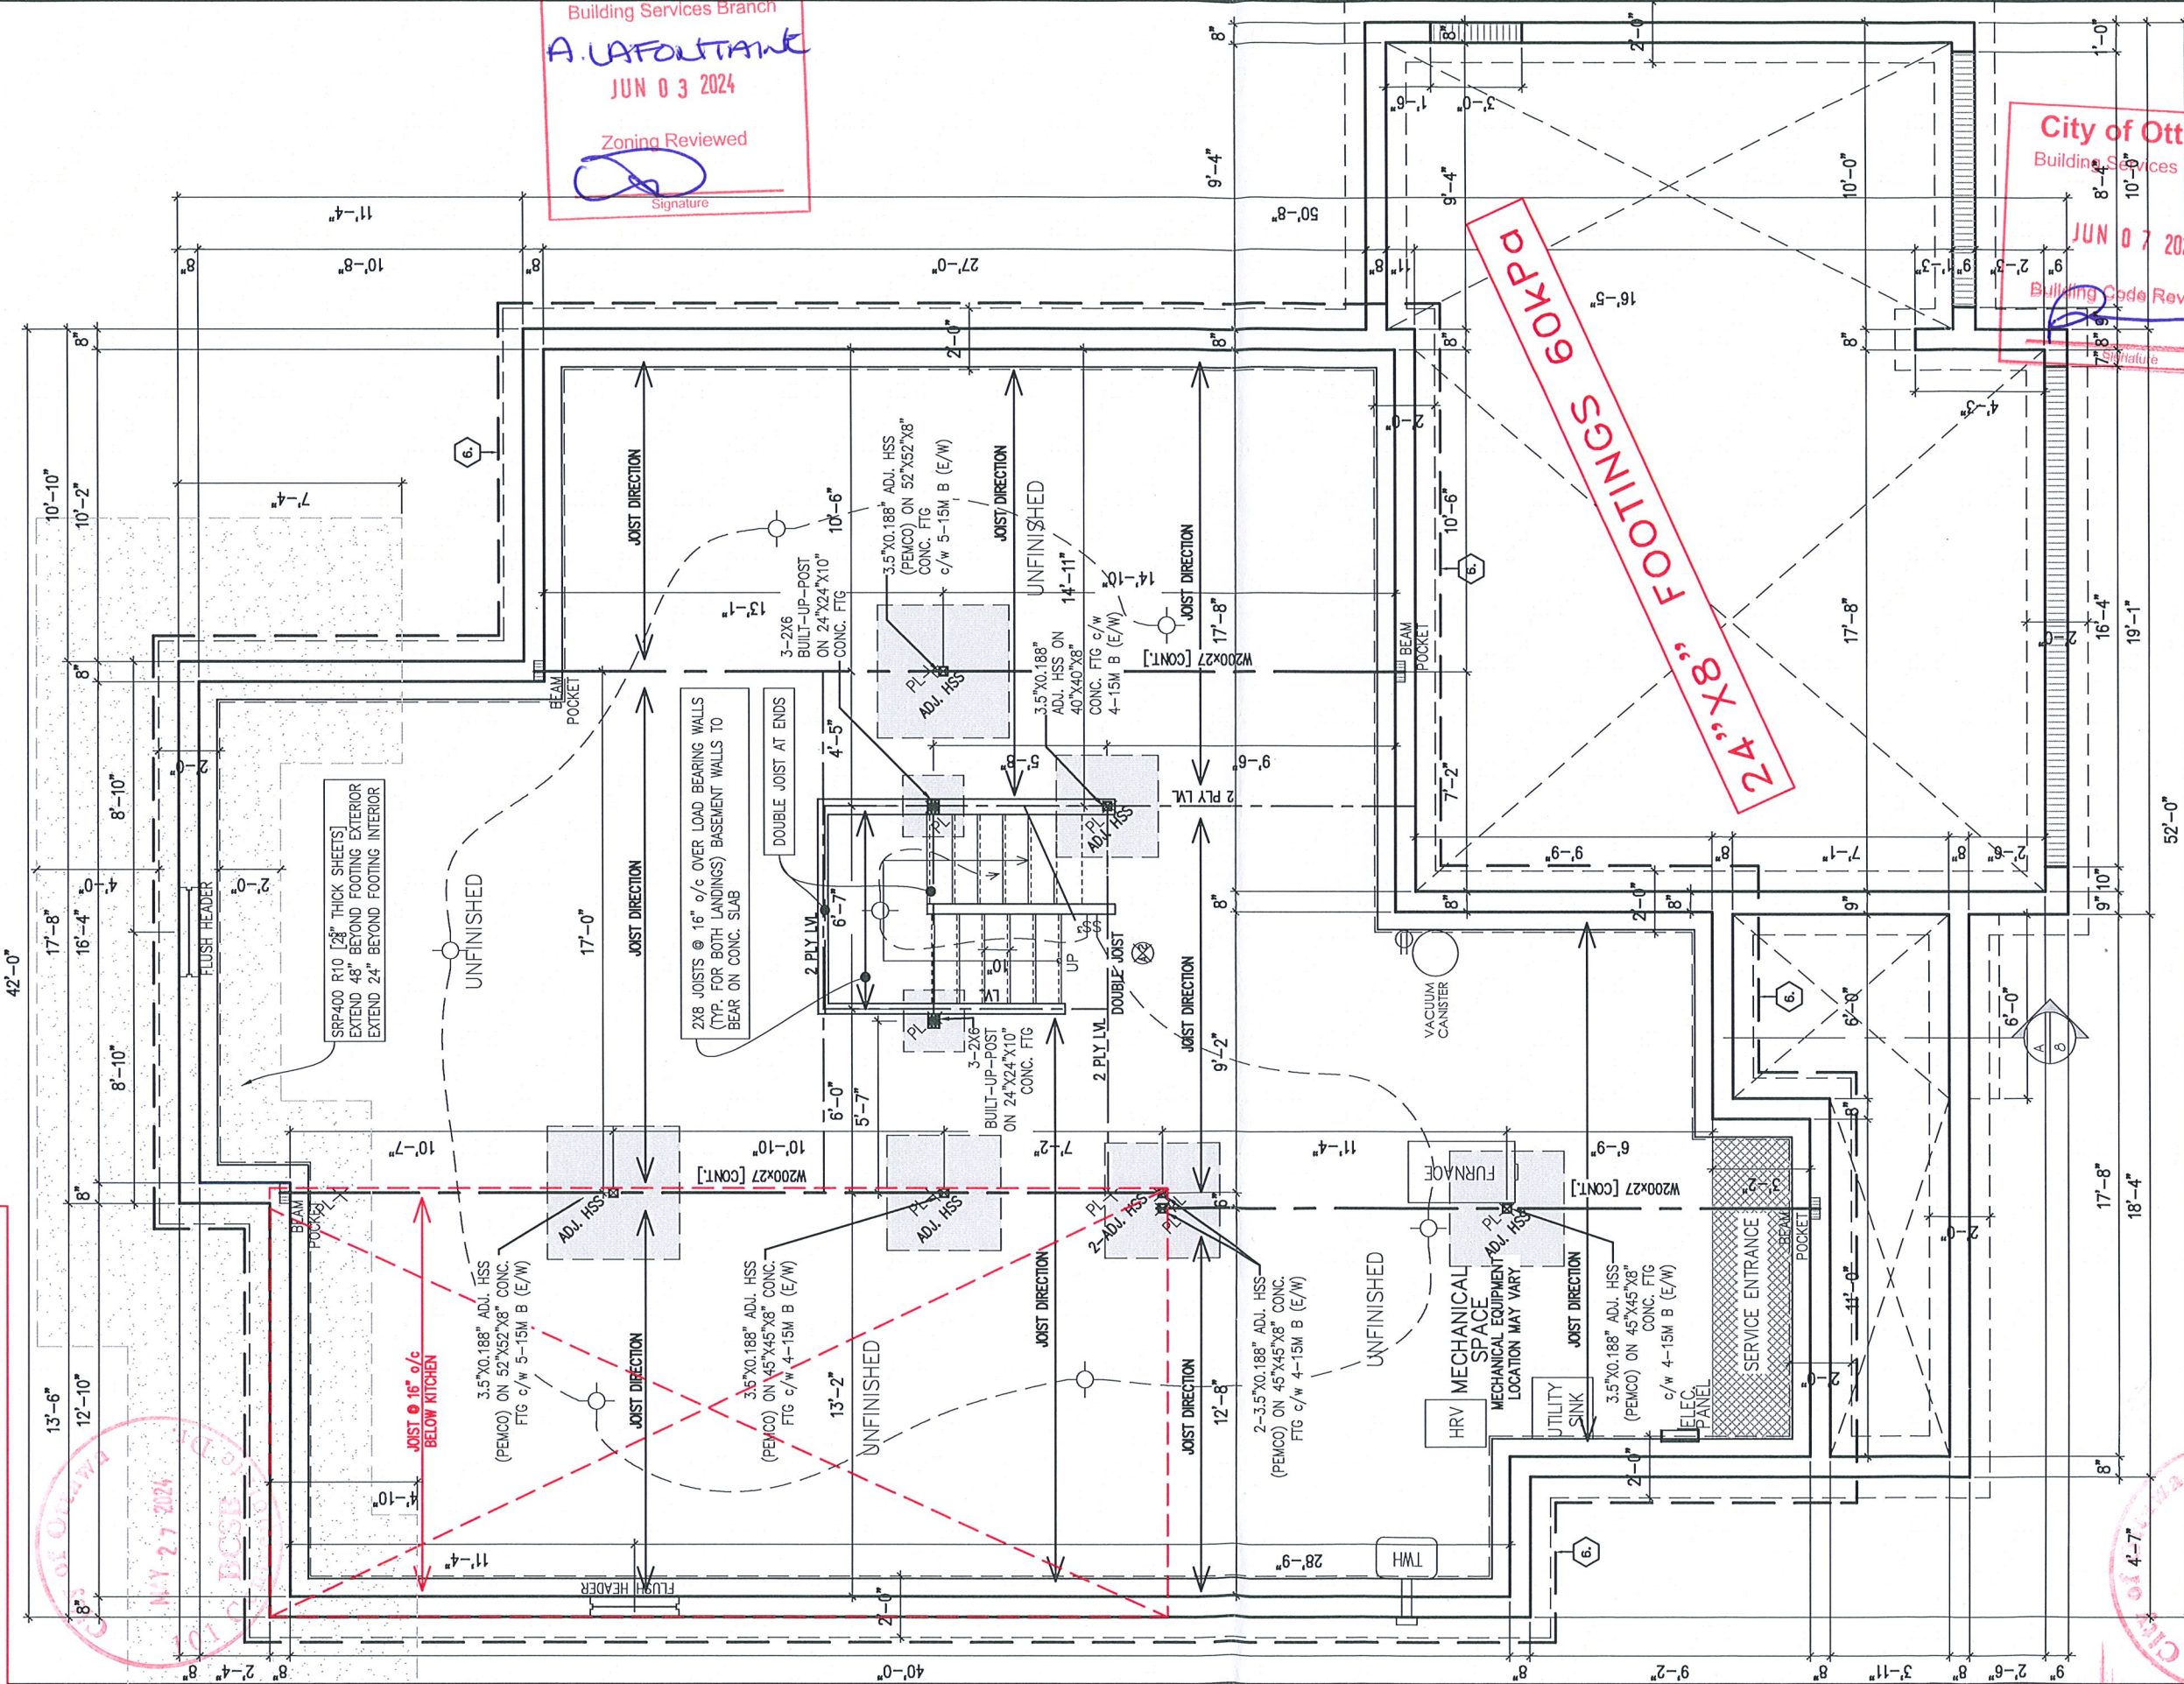

FOUNDATION PLAN (R ELEVATION)

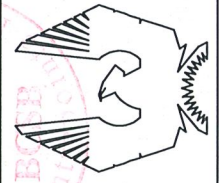

PHOENIX HOMES

NEWINGTON R - 2022


SITE: DIAMONDVIEW PH 3

LOT NUMBER:

CIVIC ADDRESS:
102 CHANDELLE PVT

80

6	ISSUED FOR ENGINEERING	09/05/24	CB
5	ISSUED FOR LAYOUTS	01/04/24	CB
4	BEP BLACKLINES	25/03/24	CB
3	B1 BLACKLINES	21/02/24	SP
2	KITCHEN LIGHT UPDATE	20/10/22	SP
1	FOR LAYOUTS AND STRUCTURE REVIEW	11/03/22	SP
No. Description		ad/mm/yy	By
REVISIONS			
footprint:		50-22-7	
drawn by:		SP	
date:		JUN 12/16	
scale:		3/16"=1'-0"	
D.C.L. - A-24			
sheet no:		2	
			2R of 9

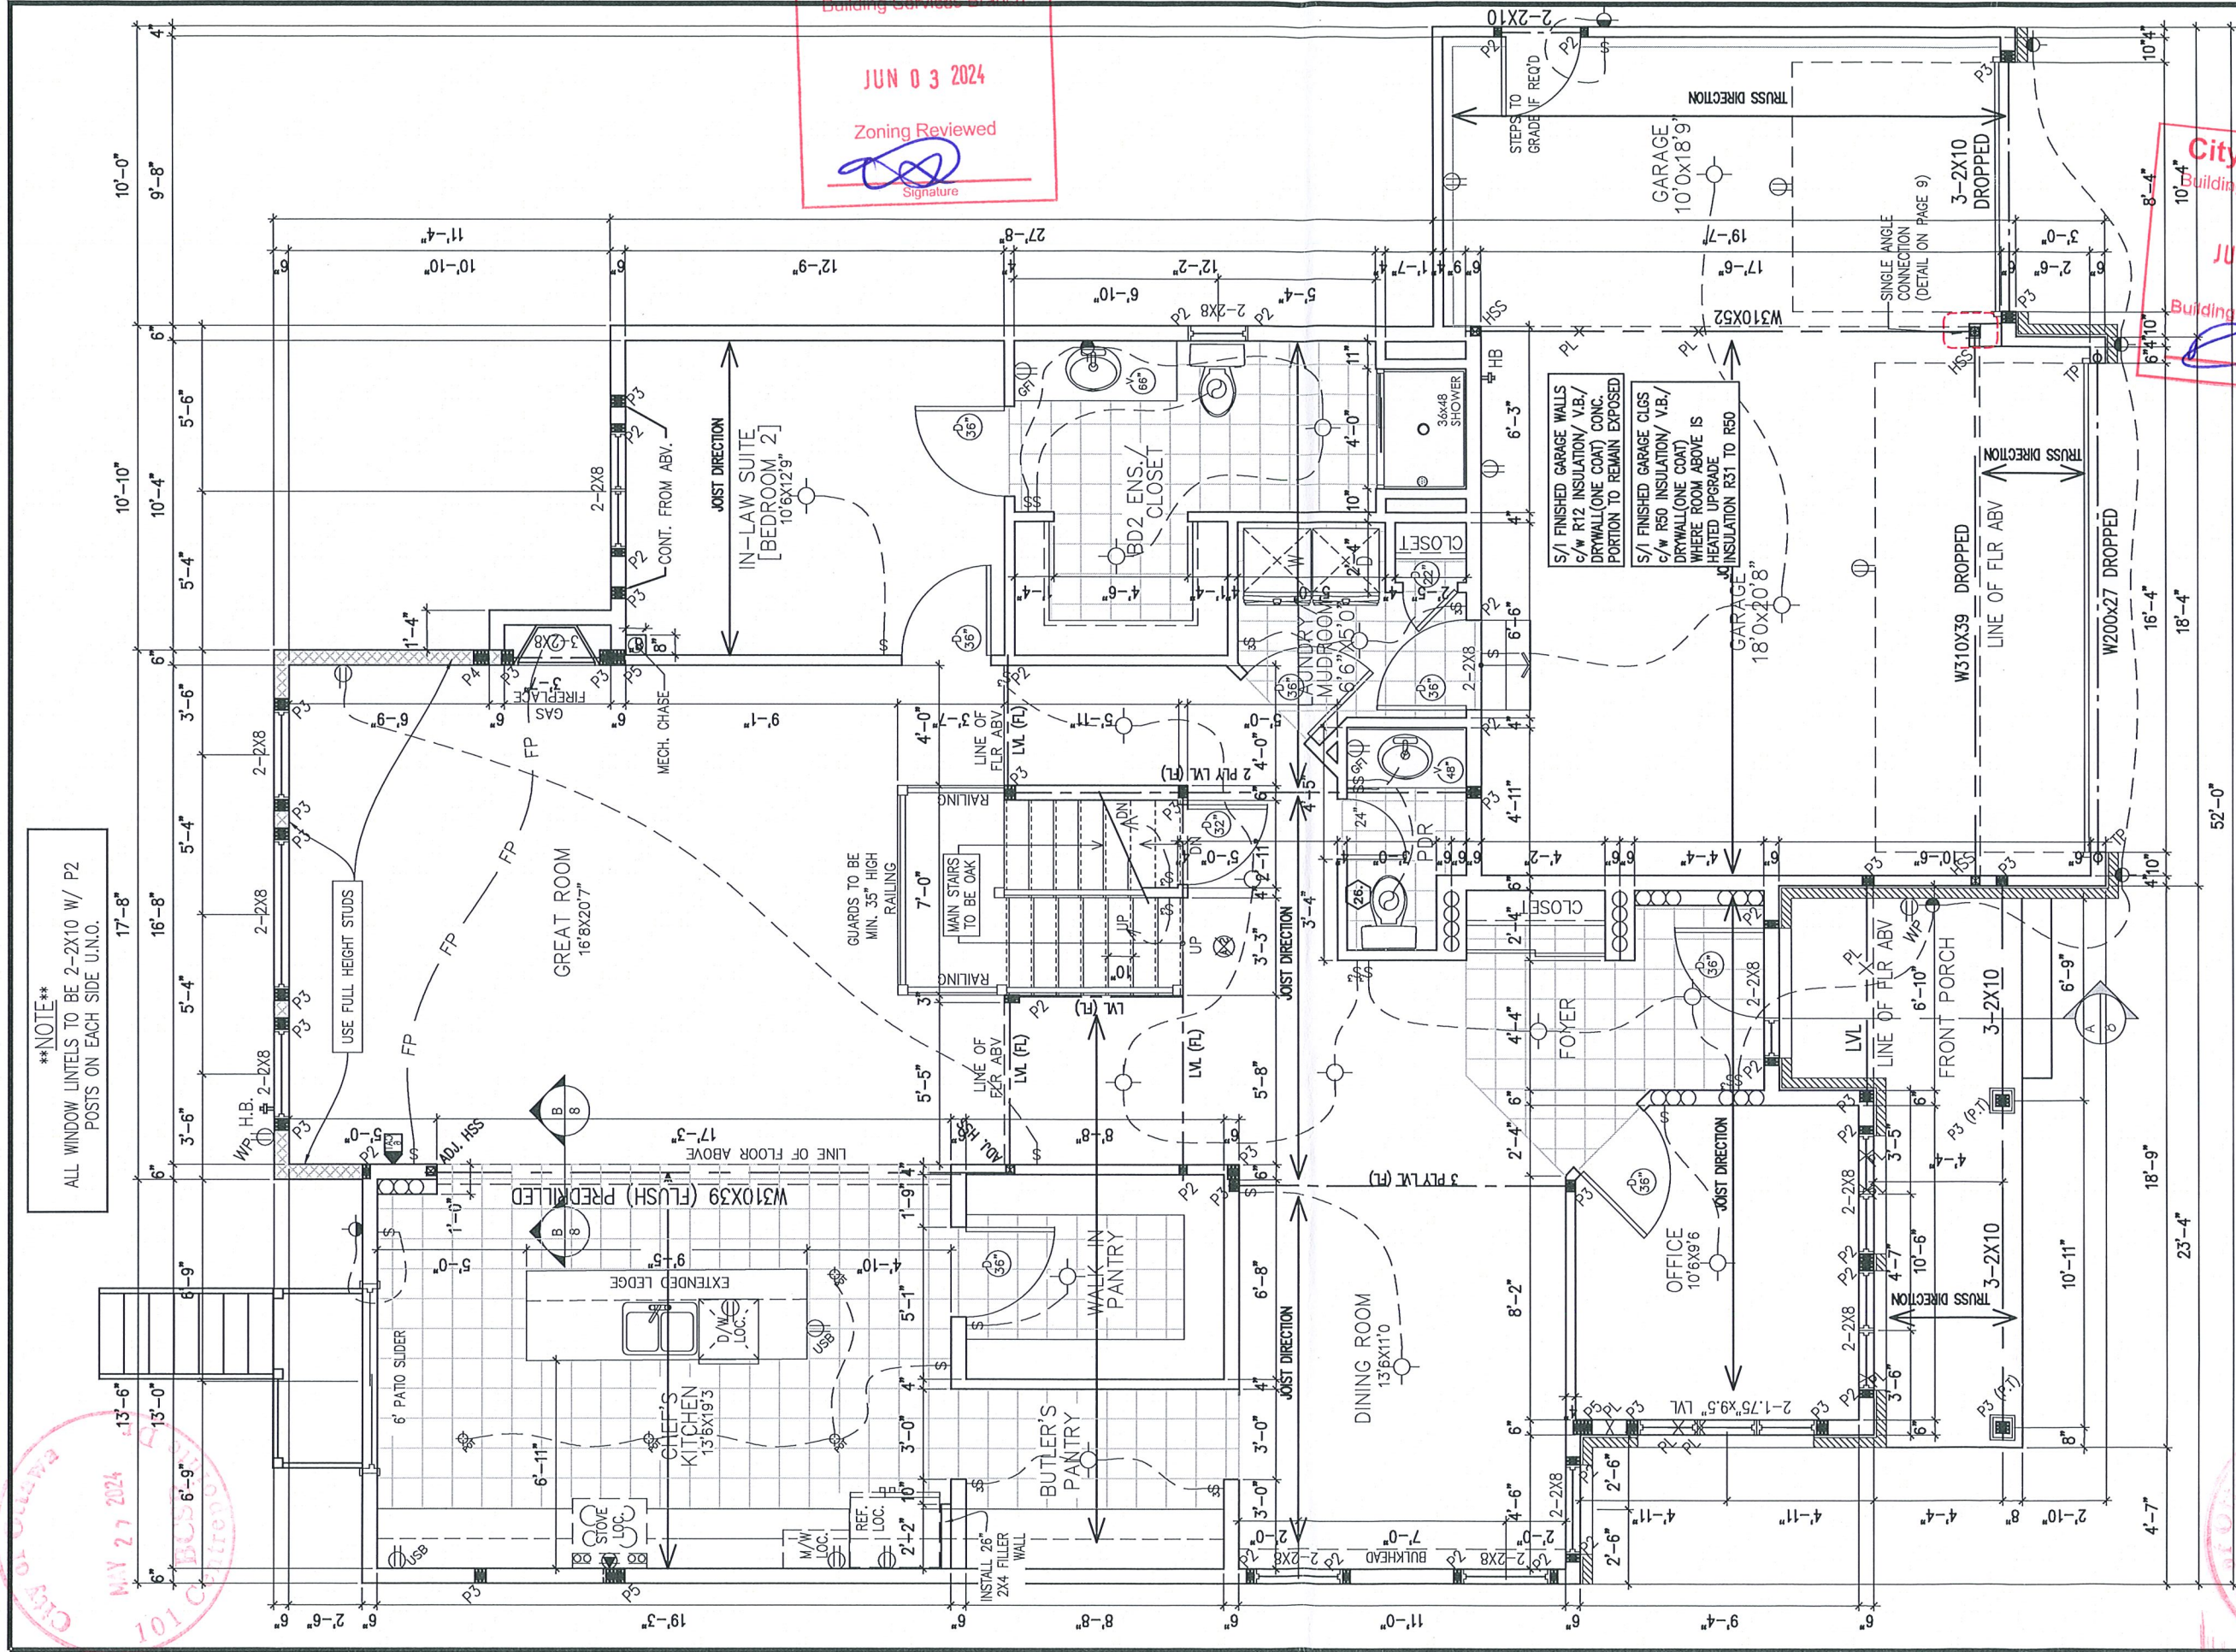


City of Ottawa
Building Services Branch
JUN 03 2024
Zoning Reviewed
Signature

SITE COPY

City of Ottawa
Building Services Branch
JUN 07 2024
Building Code Reviewed
Signature

GROUND FLOOR PLAN (ELEVATION R)
1782 SQ. FT.

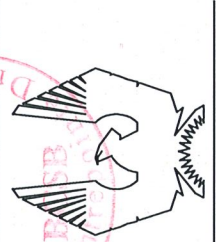

PHOENIX HOMES

NEWINGTON R - 2022

SITE: DIAMONDVIEW PH 3

LOT NUMBER:


CIVIC ADDRESS:
102 CHANDELLE PVT

80

No.	Description	dd/mm/yy	By
6	ISSUED FOR ENGINEERING	09/05/24	CB
5	ISSUED FOR LAYOUTS	01/04/24	CB
4	BEP BLACKLINES	25/03/24	CB
3	B1 BLACKLINES	21/02/24	SP
2	KITCHEN LIGHT UPDATE	20/10/22	SP
1	FOR LAYOUTS AND STRUCTURE REVIEW	11/03/22	SP

footprint	50-22-7
drawn by	SP
date	JUN 12/16
scale	3/16"=1'-0"
D.C.L. - A-24	
sheet no:	3
3R of	9

NOTE
ALL WINDOW LINTELS TO BE 2-2X10 W/ P2
POSTS ON EACH SIDE U.N.O.

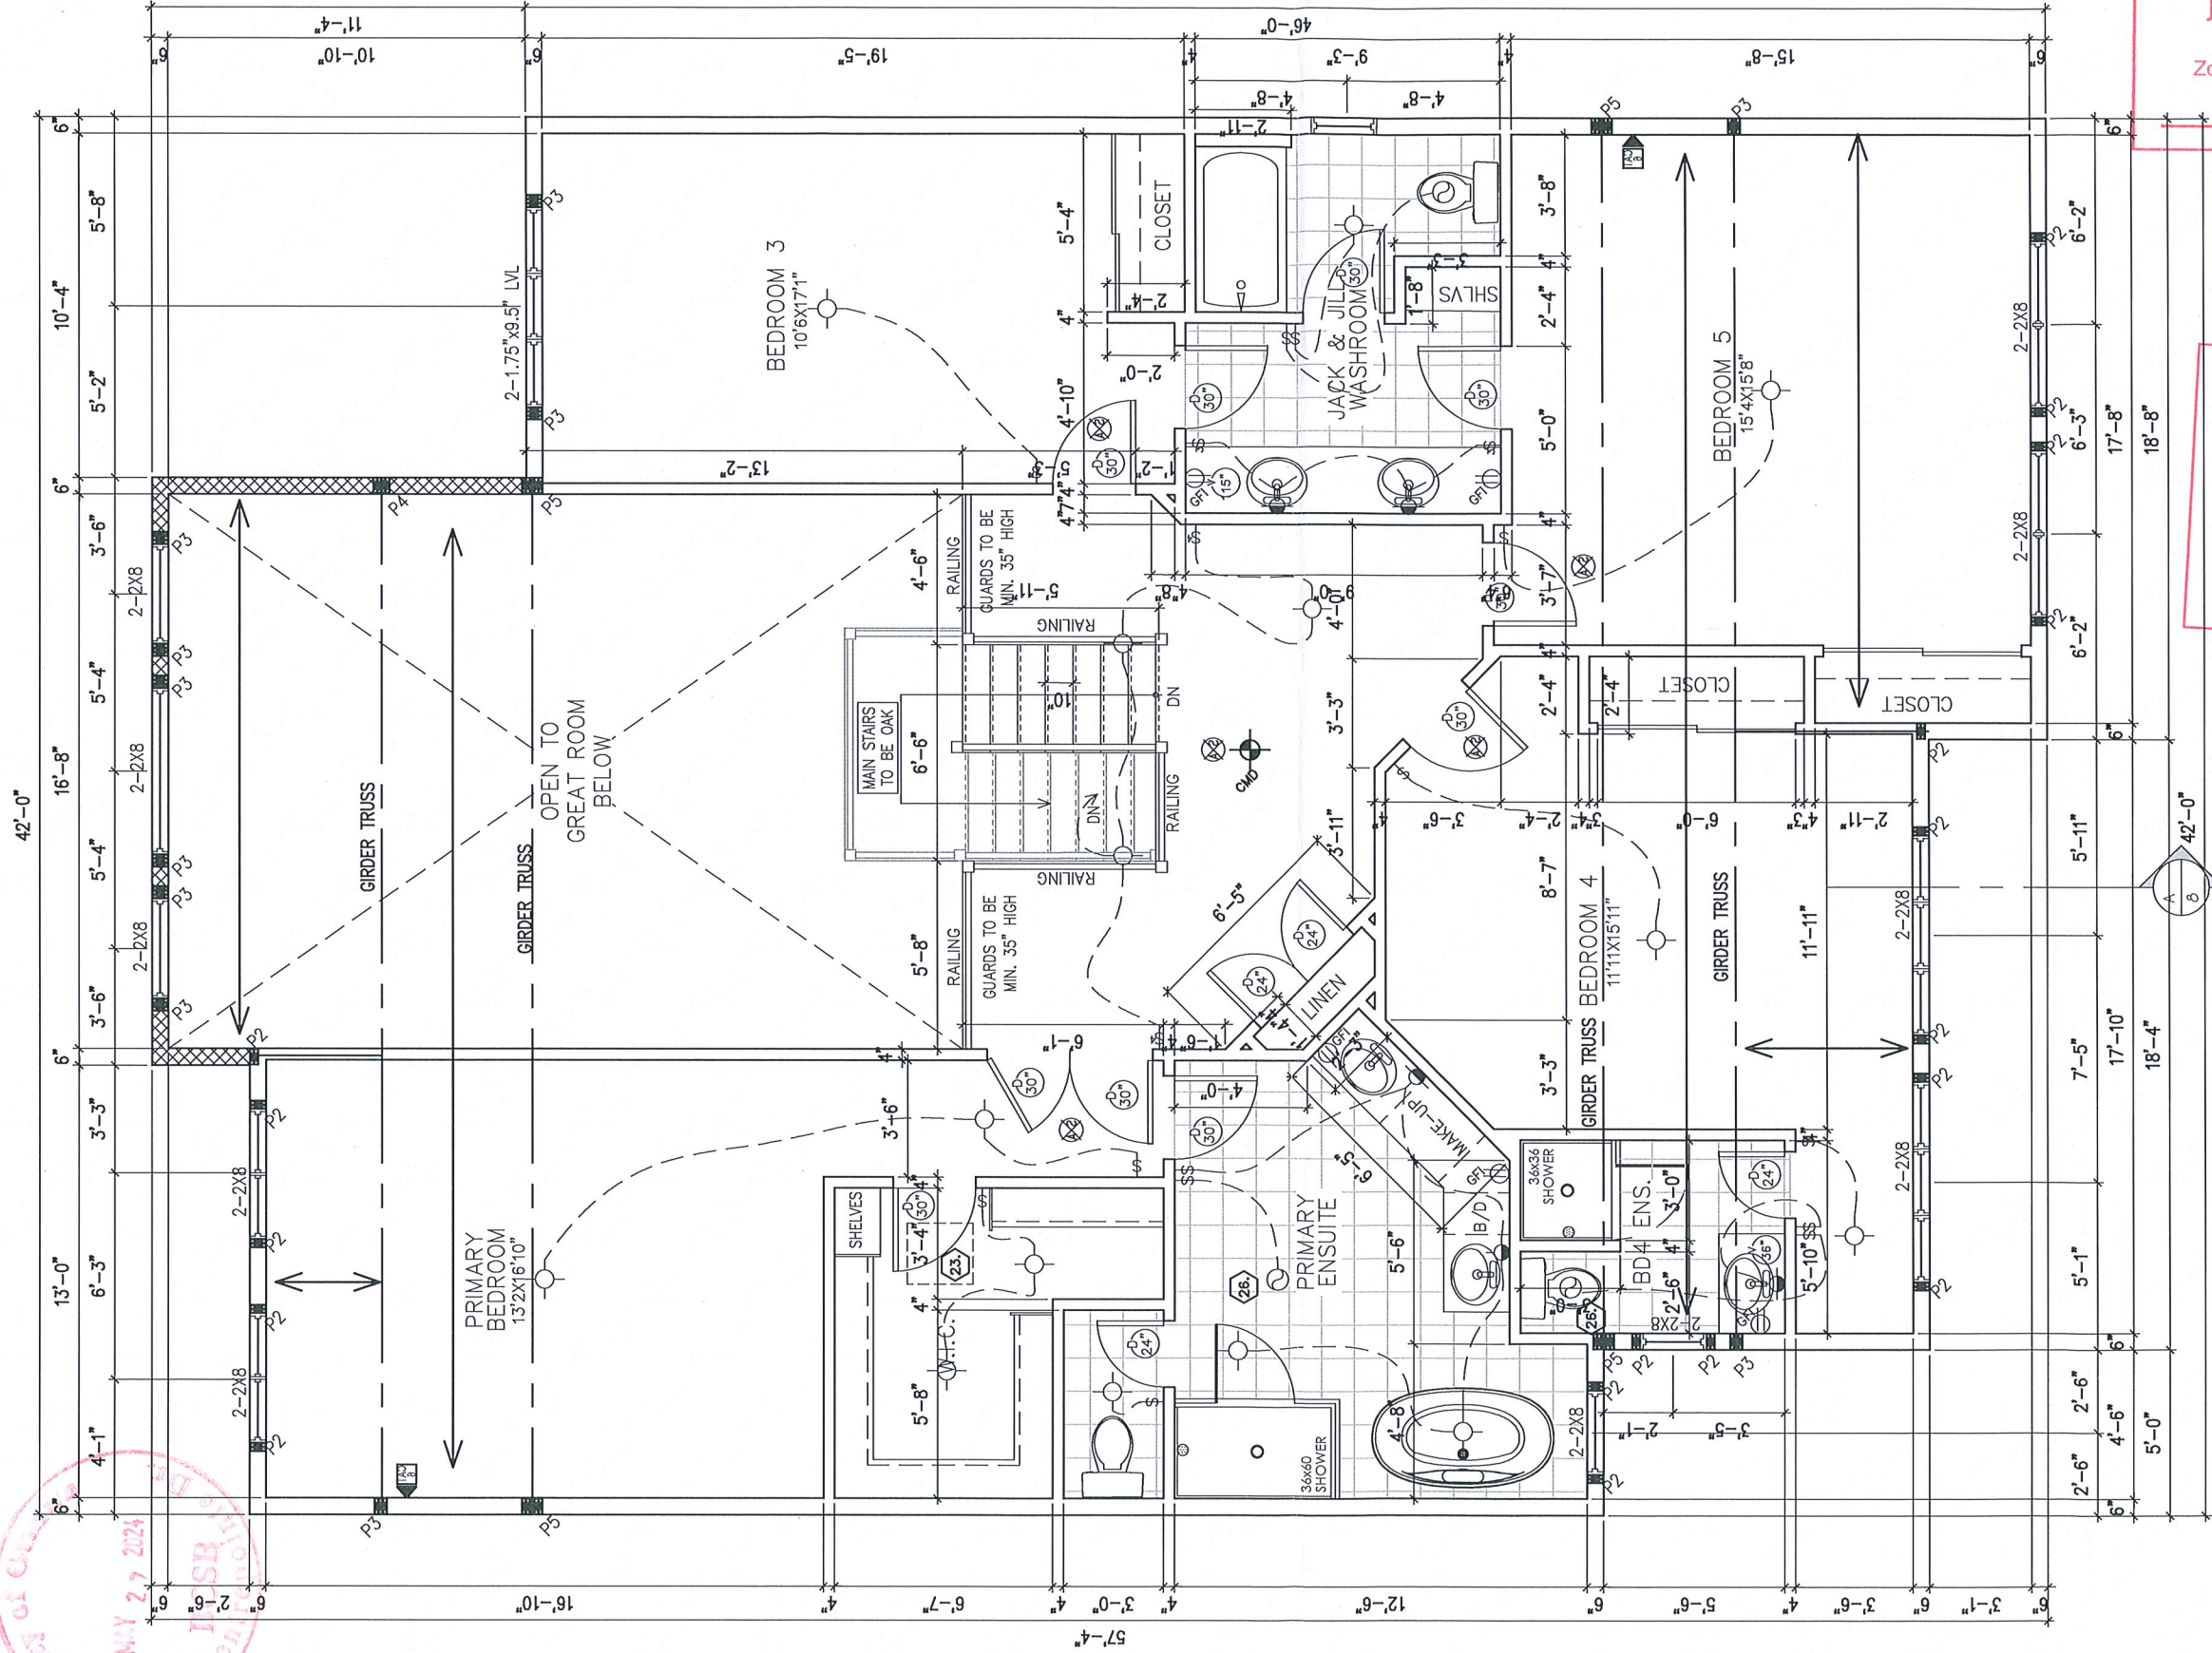


COPY

City of Ottawa
Building Services Branch
JUN 03 2024
Zoning Reviewed
Signature

City of Ottawa
Building Services Branch
JUN 07 2024
Building Code Reviewed
Signature

SECOND FLOOR PLAN (ELEVATION R) 1672 SQ. FT.

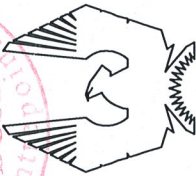

PHOENIX HOMES

NEWINGTON R - 2022

SITE: DIAMONDVIEW PH 3


LOT NUMBER:

80

CIVIC ADDRESS:
102 CHANDELLE PVT

6	ISSUED FOR ENGINEERING	09/05/24	CB
5	ISSUED FOR LAYOUTS	01/04/24	CB
4	BEP BLACKLINES	25/03/24	CB
3	B1 BLACKLINES	21/02/24	SP
2	KITCHEN LIGHT UPDATE	20/10/22	SP
1	FOR LAYOUTS AND STRUCTURE REVIEW	11/03/22	SP
No. Description		ad/mm/yy	By
REVISIONS			

footprint:	50-22-7
drawn by:	SP
date:	JUN 12/16
scale:	3/16"=1'-0"
D.C.L. - A-24	4R of 9
sheet no:	4

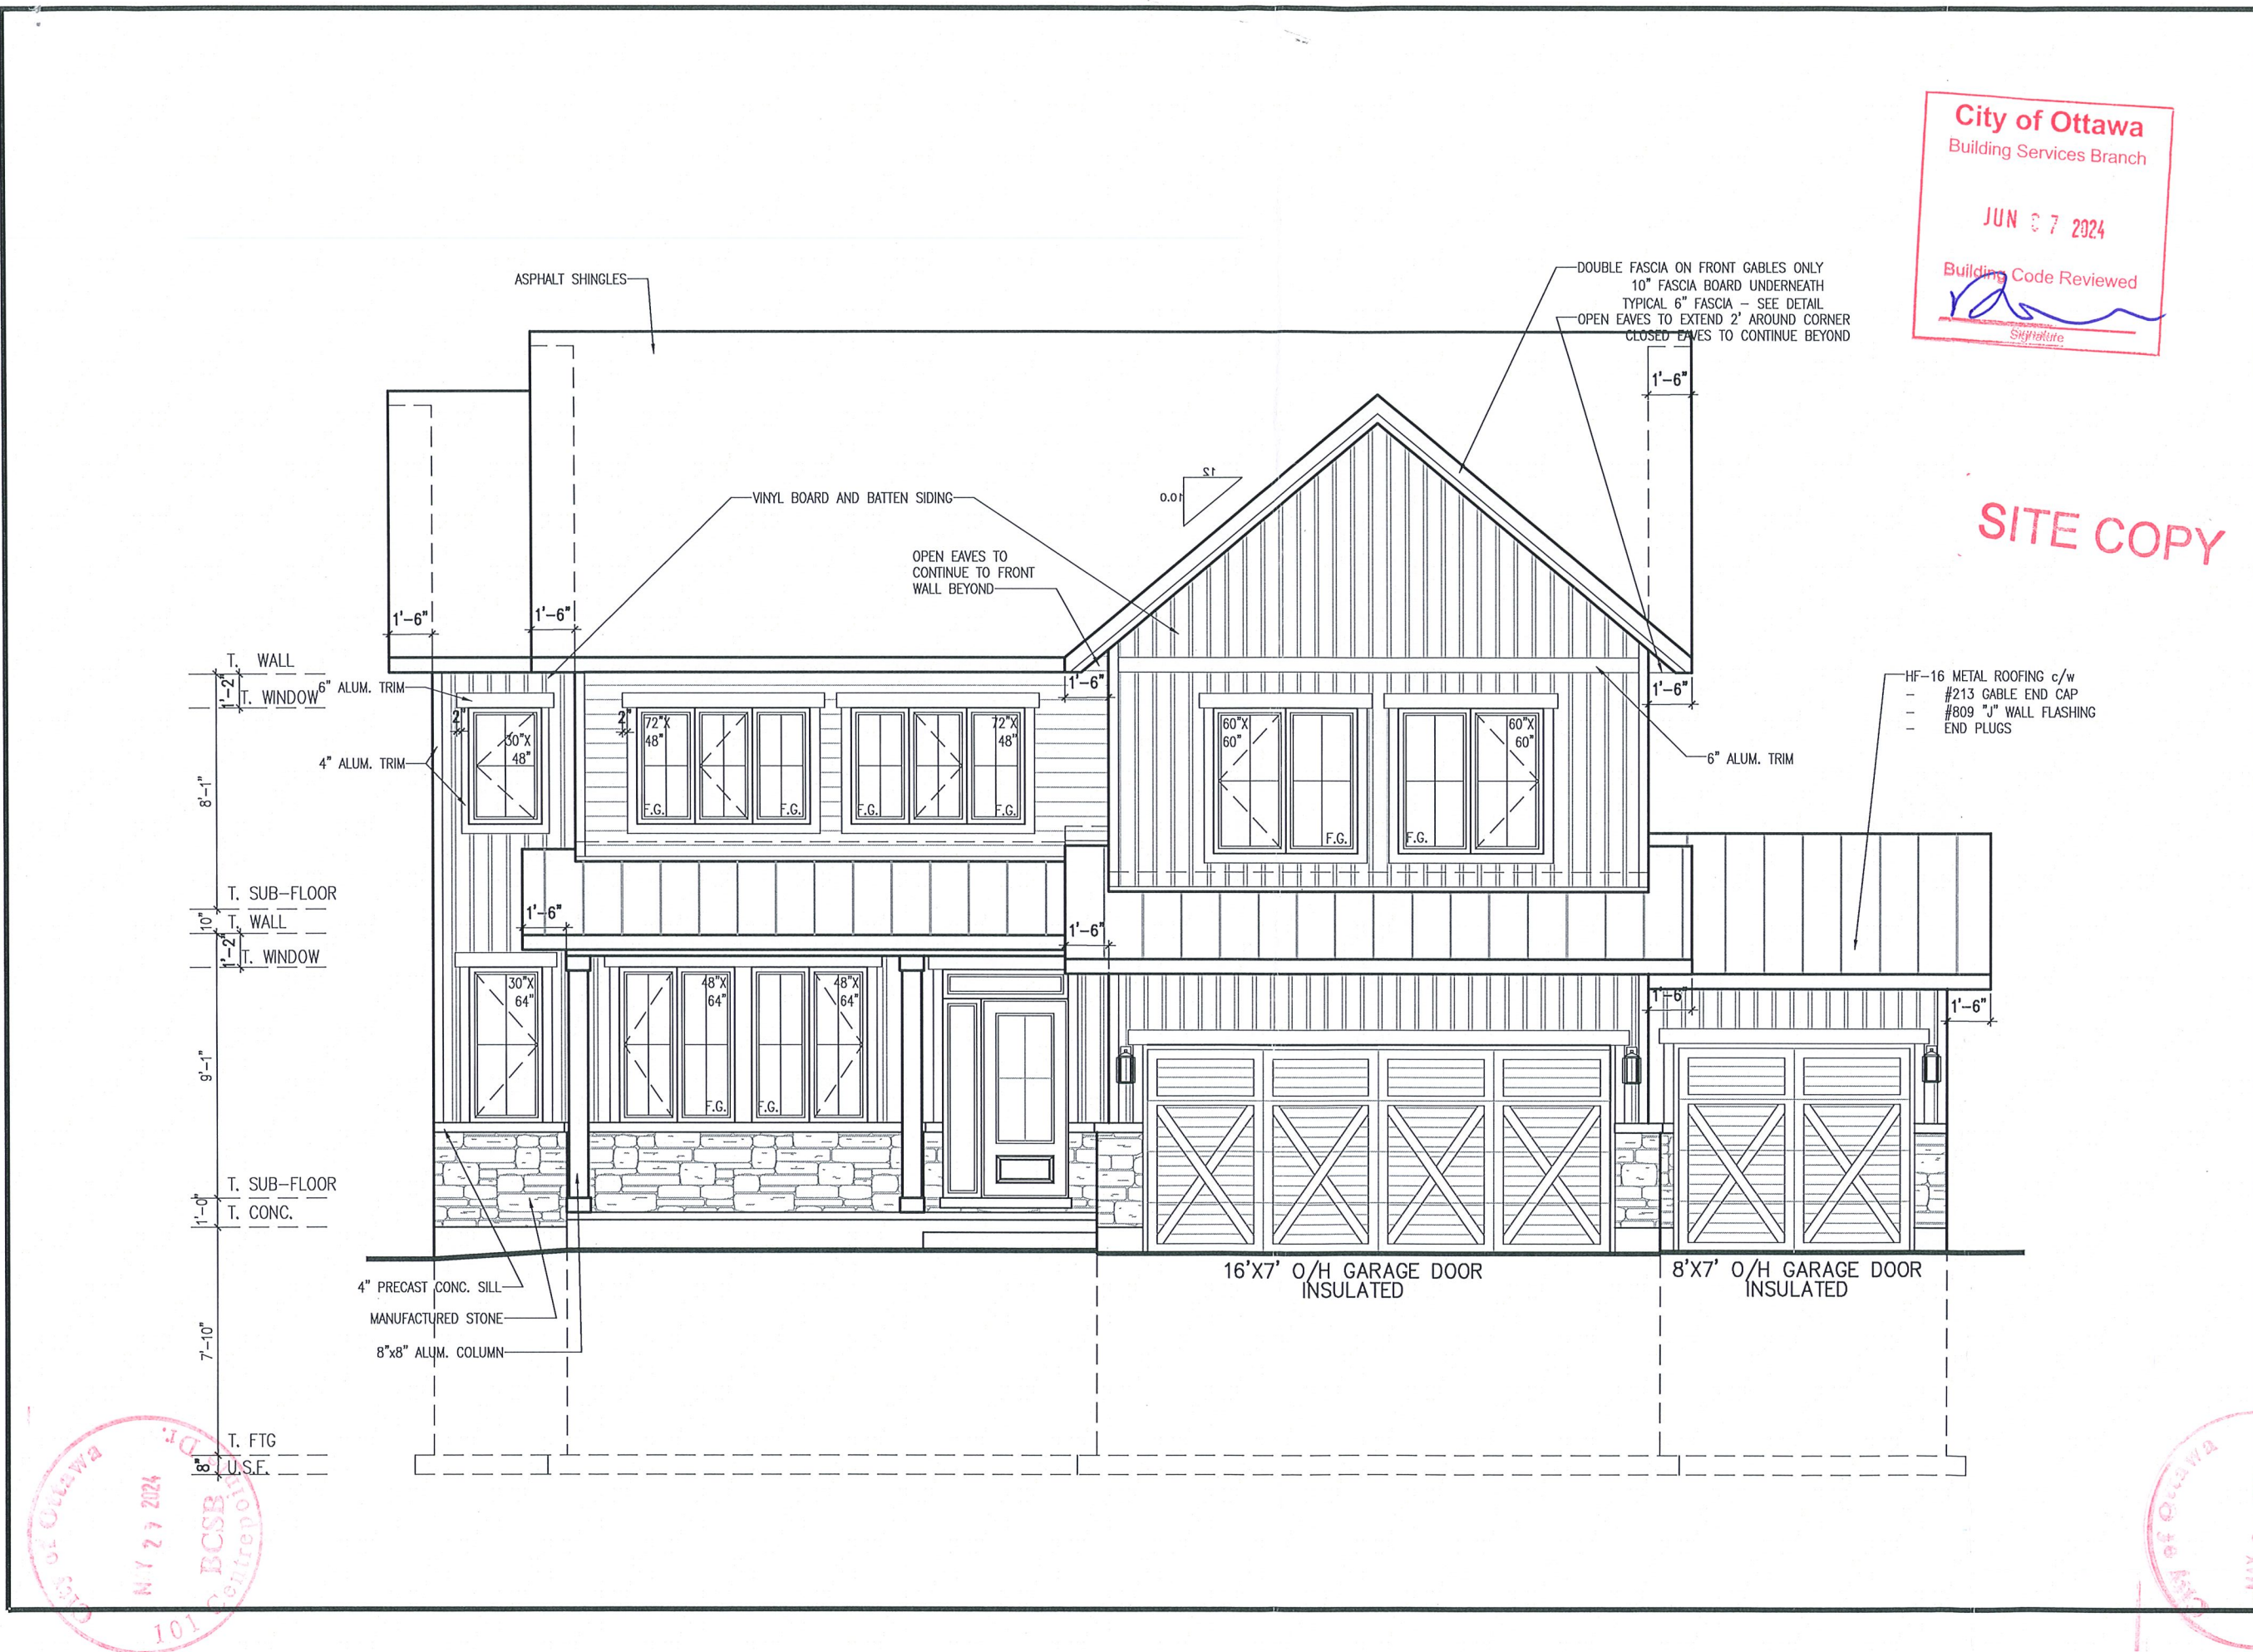

City of Ottawa
Building Services Branch

JUN 27 2024

Building Code Reviewed


Signature

SITE COPY

footprint:	50-22-7
drawn by:	SP
date:	JUN 12/16
scale:	3/16"=1'-0"
D.C.L. -	A-24
sheet no:	7
5R of 9	

No.	Description	dd/mm/yy	By
6	ISSUED FOR ENGINEERING	09/05/24	CB
5	ISSUED FOR LAYOUTS	01/04/24	CB
4	BEP BLACKLINES	25/03/24	CB
3	B1 BLACKLINES	21/02/24	SP
2	KITCHEN LIGHT UPDATE	20/10/22	SP
1	FOR LAYOUTS AND STRUCTURE REVIEW	11/03/22	SP

NEWINGTON R - 2022
SITE: DIAMONDVIEW PH 3
LOT NUMBER: 80
CIVIC ADDRESS: 102 CHANDELLE PVT

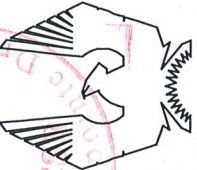

PHOENIX HOMES

City of Ottawa
Building Services Branch

JUN 07 2024

Building Code Reviewed


Signature

JUN 07 2024

Building Code Reviewed

Signature _____

footprint:	50-22-7
drawn by:	SP
date:	JUN 12/16
scale:	3/16"=1'-0"
D.C.L. - A-24	
sheet no:	

6	ISSUED FOR ENGINEERING	09/05/24	CB
5	ISSUED FOR LAYOUTS	01/04/24	CB
4	BEP BLACKLINES	25/03/24	CB
3	B1 BLACKLINES	21/02/24	SP
2	KITCHEN LIGHT UPDATE	20/10/22	SP
1	FOR LAYOUTS AND STRUCTURE REVIEW	11/03/22	SP
No.	Description	dd/mm/yy	By
REVISIONS			


NEWINGTON R - 2022


SITE: DIAMONDVIEW PH 3

LOT NUMBER:

CIVIC ADDRESS:
102 CHANDELLE PVT

PHOENIX HOMES

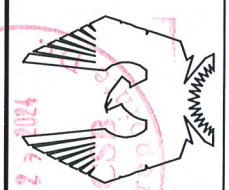

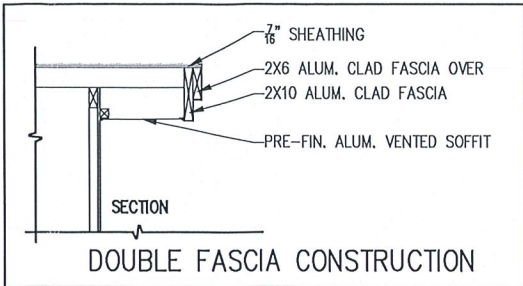

SITE COPY

City of Ottawa
Building Services Branch

JUN 03 2024

Zoning Reviewed


Signature

City of Ottawa
Building Services Branch

JUN 07 2024

Building Code Reviewed

Signature

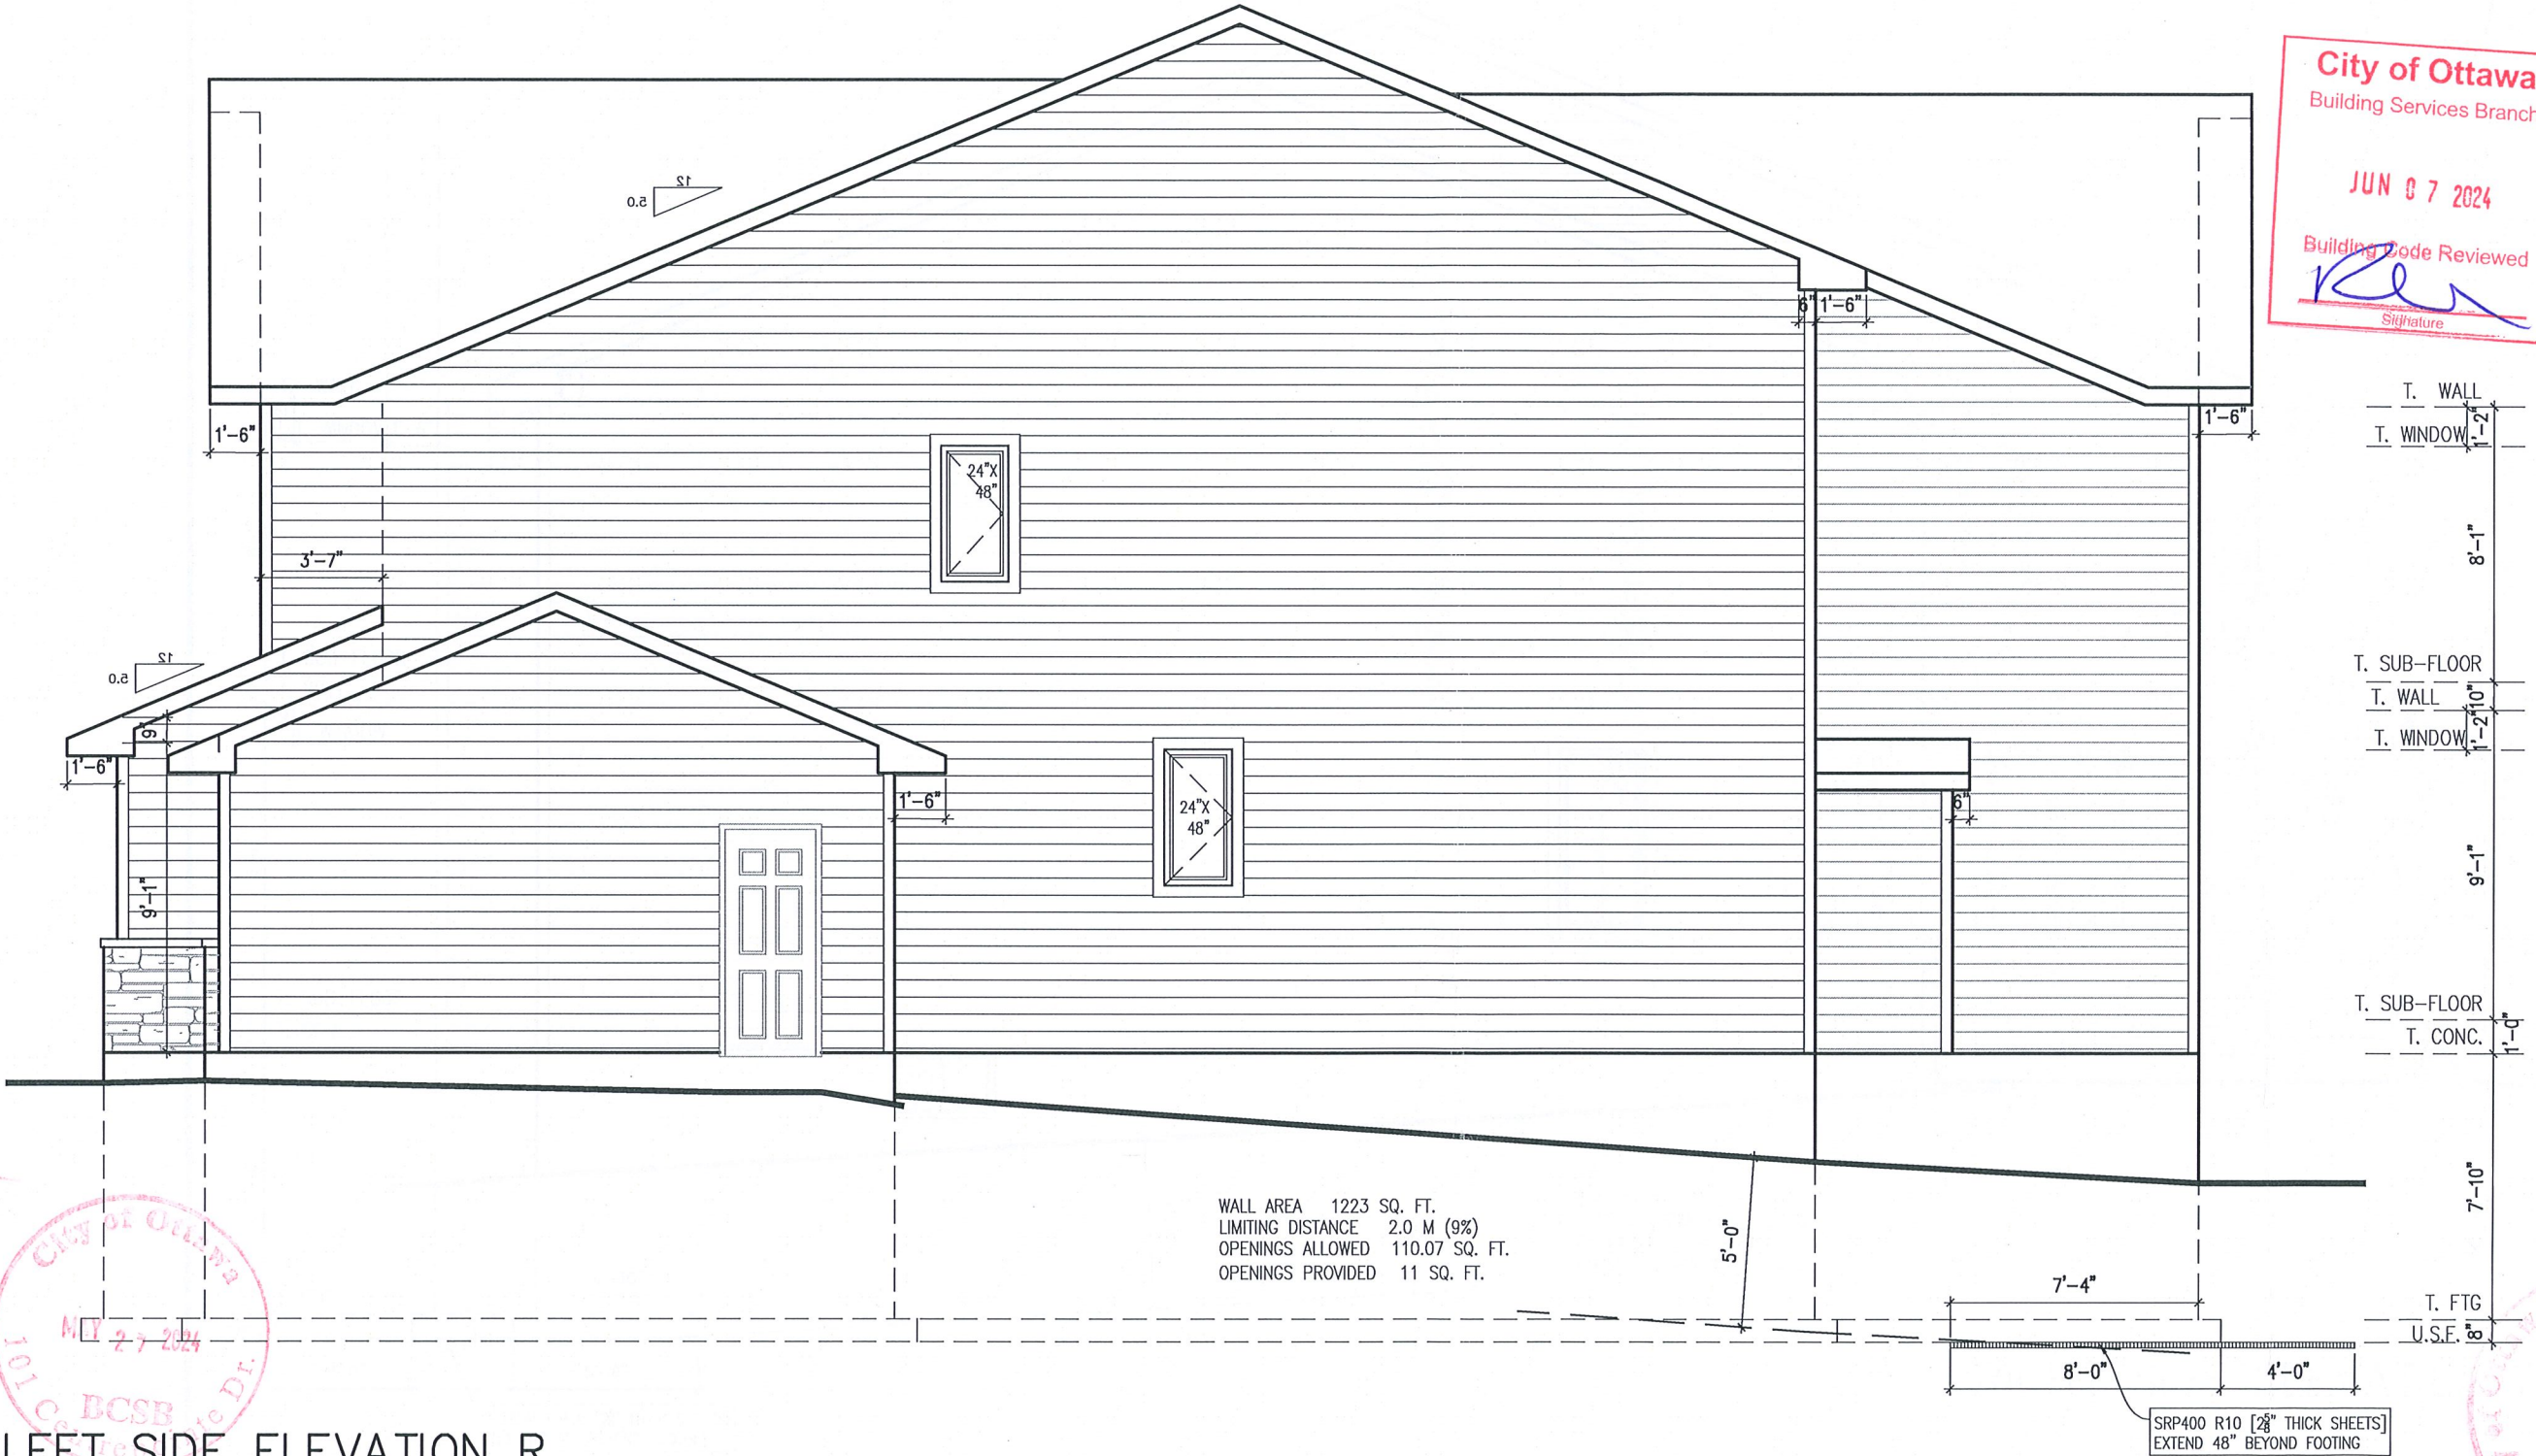

footprint:	50-22-7
drawn by:	SP
date:	JUN 12/16
scale:	3/16"=1'-0"
D.C.L. - A-24	
sheet no:	6
7R of	9

No.	Description	dd/mm/yy	By
6	ISSUED FOR ENGINEERING	09/05/24	CB
5	ISSUED FOR LAYOUTS	01/04/24	CB
4	BEP BLACKLINES	25/03/24	CB
3	B1 BLACKLINES	21/02/24	SP
2	KITCHEN LIGHT UPDATE	20/10/22	SP
1	FOR LAYOUTS AND STRUCTURE REVIEW	11/03/22	SP

NEWINGTON R - 2022


SITE: DIAMONDVIEW PH 3

LOT NUMBER: 80


CIVIC ADDRESS: 102 CHANDELLE PVT

PHOENIX HOMES


CITY OF OTTAWA
101 C. BCSB
101 C. BCSB
101 C. BCSB

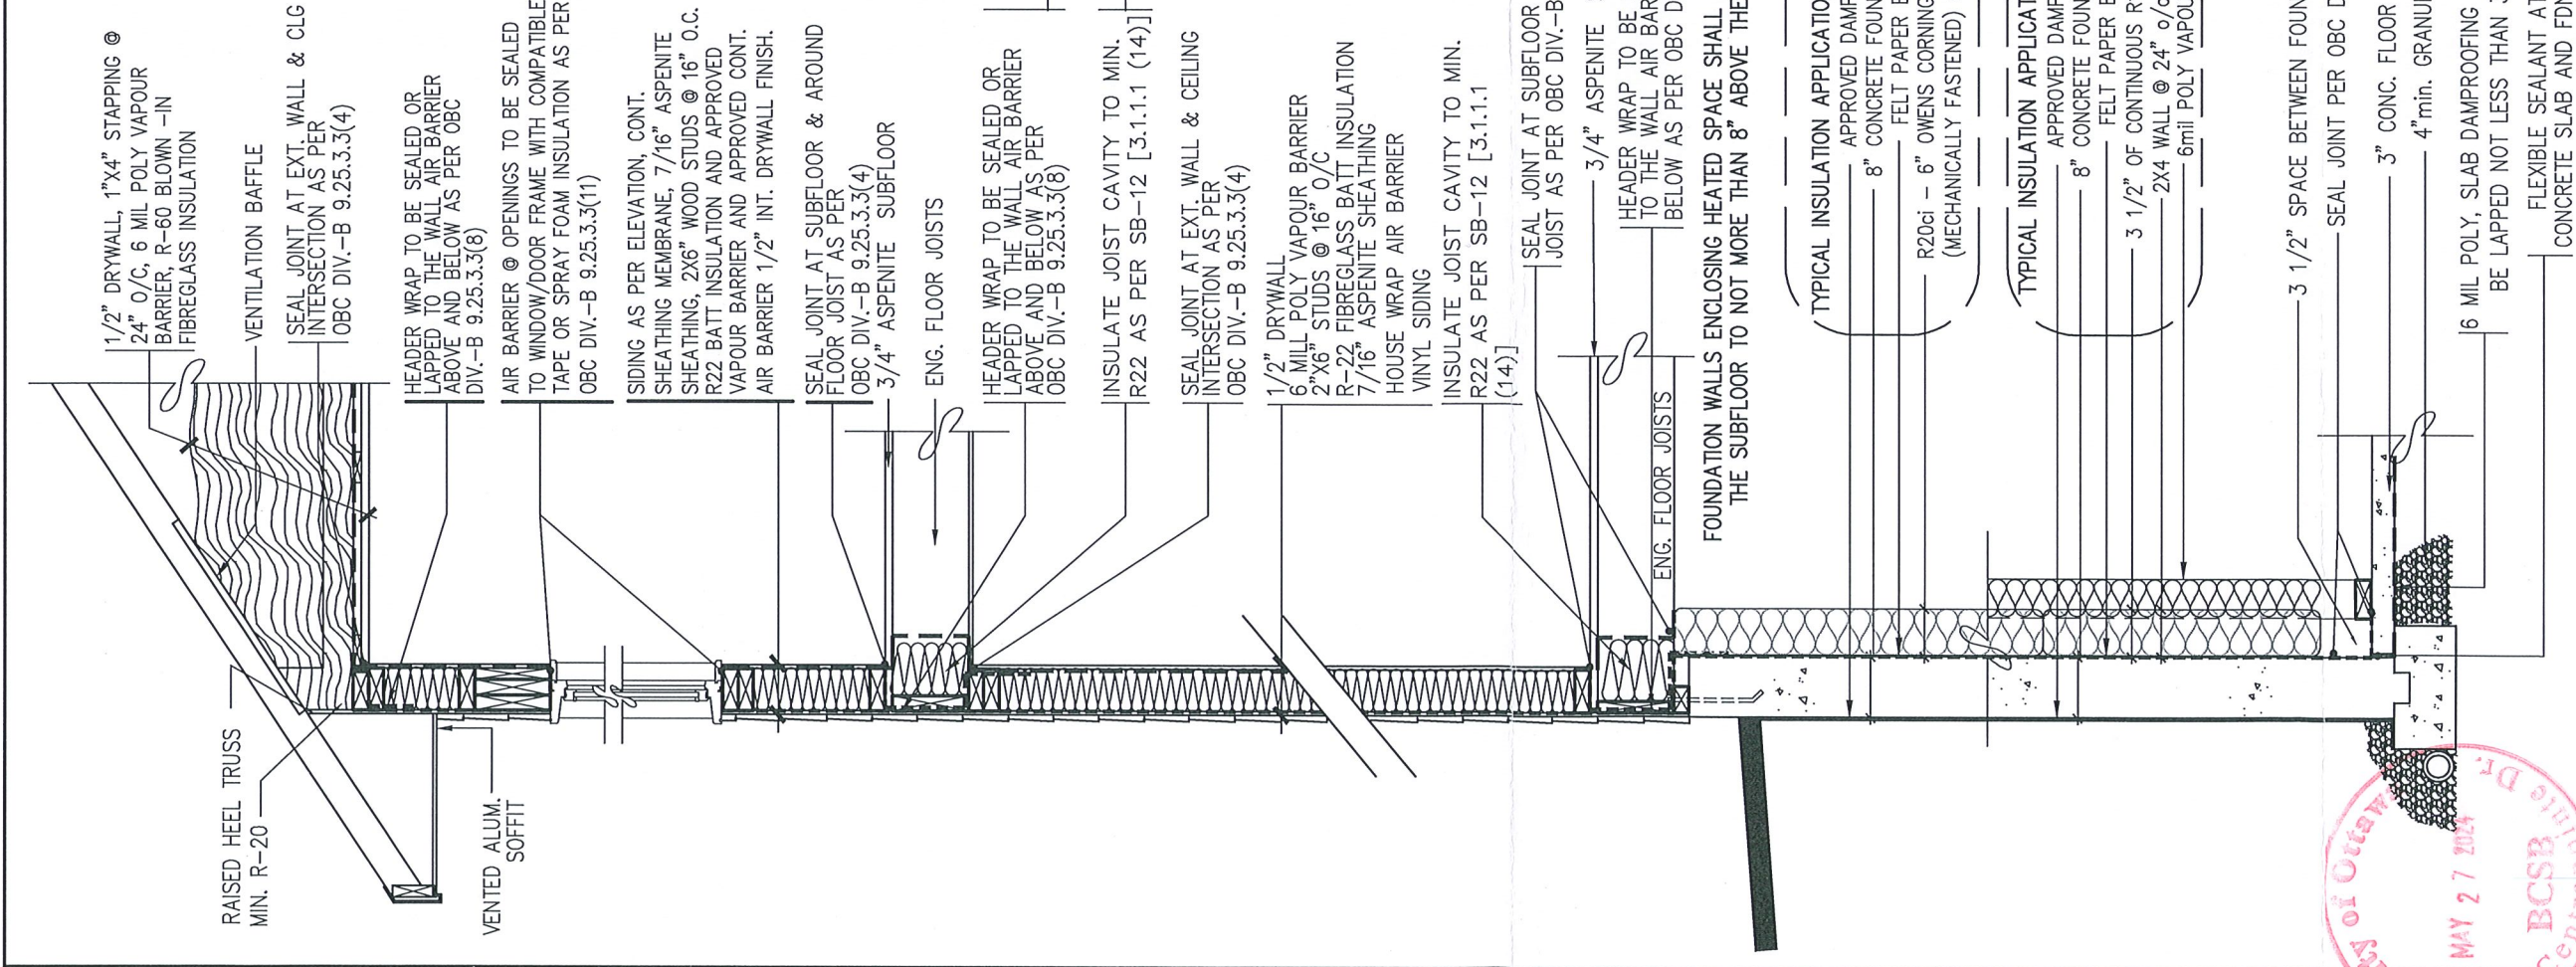

NOTES:
MECHANICAL
SPACE HEATING EQUIPMENT AS PER COMPLIANCE PACKAGE A1 OF SB-12 [TABLE 3.1.1.2.A(IP)]
AIR BARRIERS AS PER OBC 9.25.3
ALL JOINTS TO HAVE A MIN. OVERLAP OF 4"
ALL JOINTS TAPED TO MANUFACTURER'S SPECIFICATIONS
ALL FASTENERS AS PER MANUFACTURER'S SPECIFICATIONS
ALL PENETRATIONS SEALED TO MAINTAIN A CONTINUOUS AIR BARRIER
NOTES FROM OBC SB-9 SECTION 3.3 (SEALING THE PERIMETER & PENETRATIONS)
(1) A FLOOR-ON-GROUND SHALL BE SEALED AROUND ITS PERIMETER TO THE INNER SURFACES OF ADJACENT WALL USING FLEXIBLE SEALANT
(2) ALL PENETRATIONS OF A FLOOR-ON-GROUND BY PIPES OR OTHER OBJECTS SHALL BE SEALED AGAINST SOIL GAS LEAKAGE
(3) ALL PENETRATIONS OF A FLOOR-ON-GROUND THAT ARE REQUIRED TO DRAIN WATER FROM THE FLOOR SURFACE SHALL BE SEALED IN A MANNER THAT PREVENTS THE UPWARD FLOW OF SOIL GAS WITHOUT PREVENTING THE DOWNWARD FLOW OF LIQUID WATER.

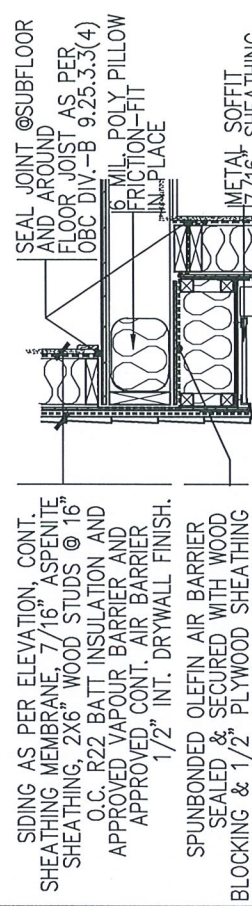

DETAIL SECTION
(CANTILEVERED FLOOR)

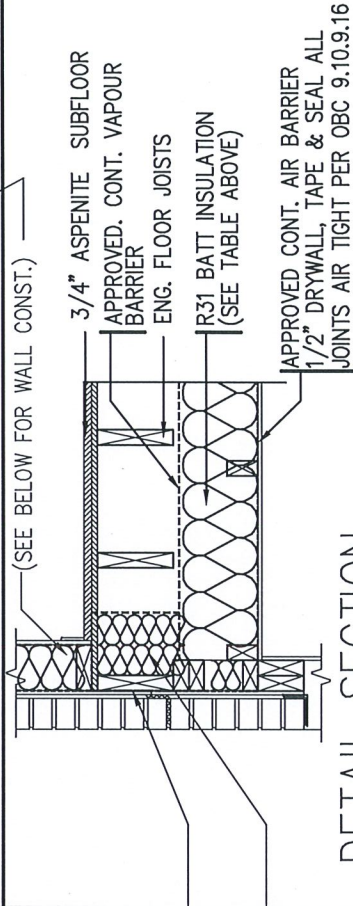

DETAIL SECTION
(BET. GARAGE & HEATED SPACE ABOVE)

TYPICAL BRICK VENEER WALL, 4" FACE BRICK 1" AIR SPACE, GALV. METAL TIES @ 16" O.C. HOR., 24" VERT. APPROVED SHEATHING PAPER EXTERIOR TYPE SHEATHING, 2X6" WOOD STUDS @ 16" O.C., R22 INSULATION AND APPROVED VAPOUR BARRIER WITH APPROVED CONT. AIR BARRIER, 1/2" INT. DRYWALL FINISH. PROVIDE WEEP HOLES @ 32" O.C. BOTTOM & OVER OPENINGS, BASE FLASHING UP 6" MIN. BEHIND BUILDING PAPER.


FOUNDATION WALLS ENCLOSING HEATED SPACE SHALL BE INSULATED FROM THE UNDERSIDE OF THE SUBFLOOR TO NOT MORE THAN 8" ABOVE THE FINISHED FLOOR OF THE BASEMENT.

TYPICAL INSULATION APPLICATION WITHOUT STUD FRAMING
APPROVED DAMPROOFING
8" CONCRETE FOUNDATION WALL
FELT PAPER BARRIER
R20ci - 6" OWENS CORNING BLANKET INSULATION (MECHANICALLY FASTENED) c/w VAPOUR BARRIER

TYPICAL INSULATION APPLICATION WITH STUD FRAMING
APPROVED DAMPROOFING
8" CONCRETE FOUNDATION WALL
FELT PAPER BARRIER
3 1/2" OF CONTINUOUS R10 BATT INSULATION
2X4 WALL @ 24" o/c w/ R12 BATT
6mil POLY VAPOUR BARRIER

3 1/2" SPACE BETWEEN FOUNDATION WALL & 2X4 STUDS
SEAL JOINT PER OBC DIV.-B 9.25.3.3(1)
3" CONC. FLOOR @ 2500 PSI
4"min. GRANULAR FILL
6 MIL POLY, SLAB DAMPROOFING AND SOIL GAS BARRIER, SHALL BE LAPPED NOT LESS THAN 300mm (12") AS PER SB-9
FLEXIBLE SEALANT AT INTERSECTION OF CONCRETE SLAB AND FDN. WALL AS PER SB-9

TYP. DETAIL SECTION (PARTIAL)
FOR SIDING APPLICATION

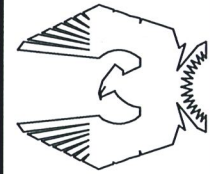

PHOENIX HOMES

SB-12 COMPLIANCE PACKAGE
DETAILS (ALL MODELS)

No.	Description	Date	By
4	SB-12 - 2022 UPDATE	JAN - 2022	SP
3	SB-12 - 2017 UPDATE	JAN - 2017	SP
2	ADDED CANTILEVERED FLOOR DETAIL	MAR28-12	TL
1	OBC SB-9 & SB-12 COMPLIANCE PACKAGE	JAN22-12	TL
REVISIONS			


footprint:	
drawn by:	SP
date:	
scale:	N/A
sheet no:	
SB-12 DETAILS	

TYP. DETAIL SECTION (PARTIAL)
FOR BRICK VENEER APPLICATION


Building Code Reviewed
Signature
JUN 07 2024

City of Ottawa
Building Services Branch

SITE COPY

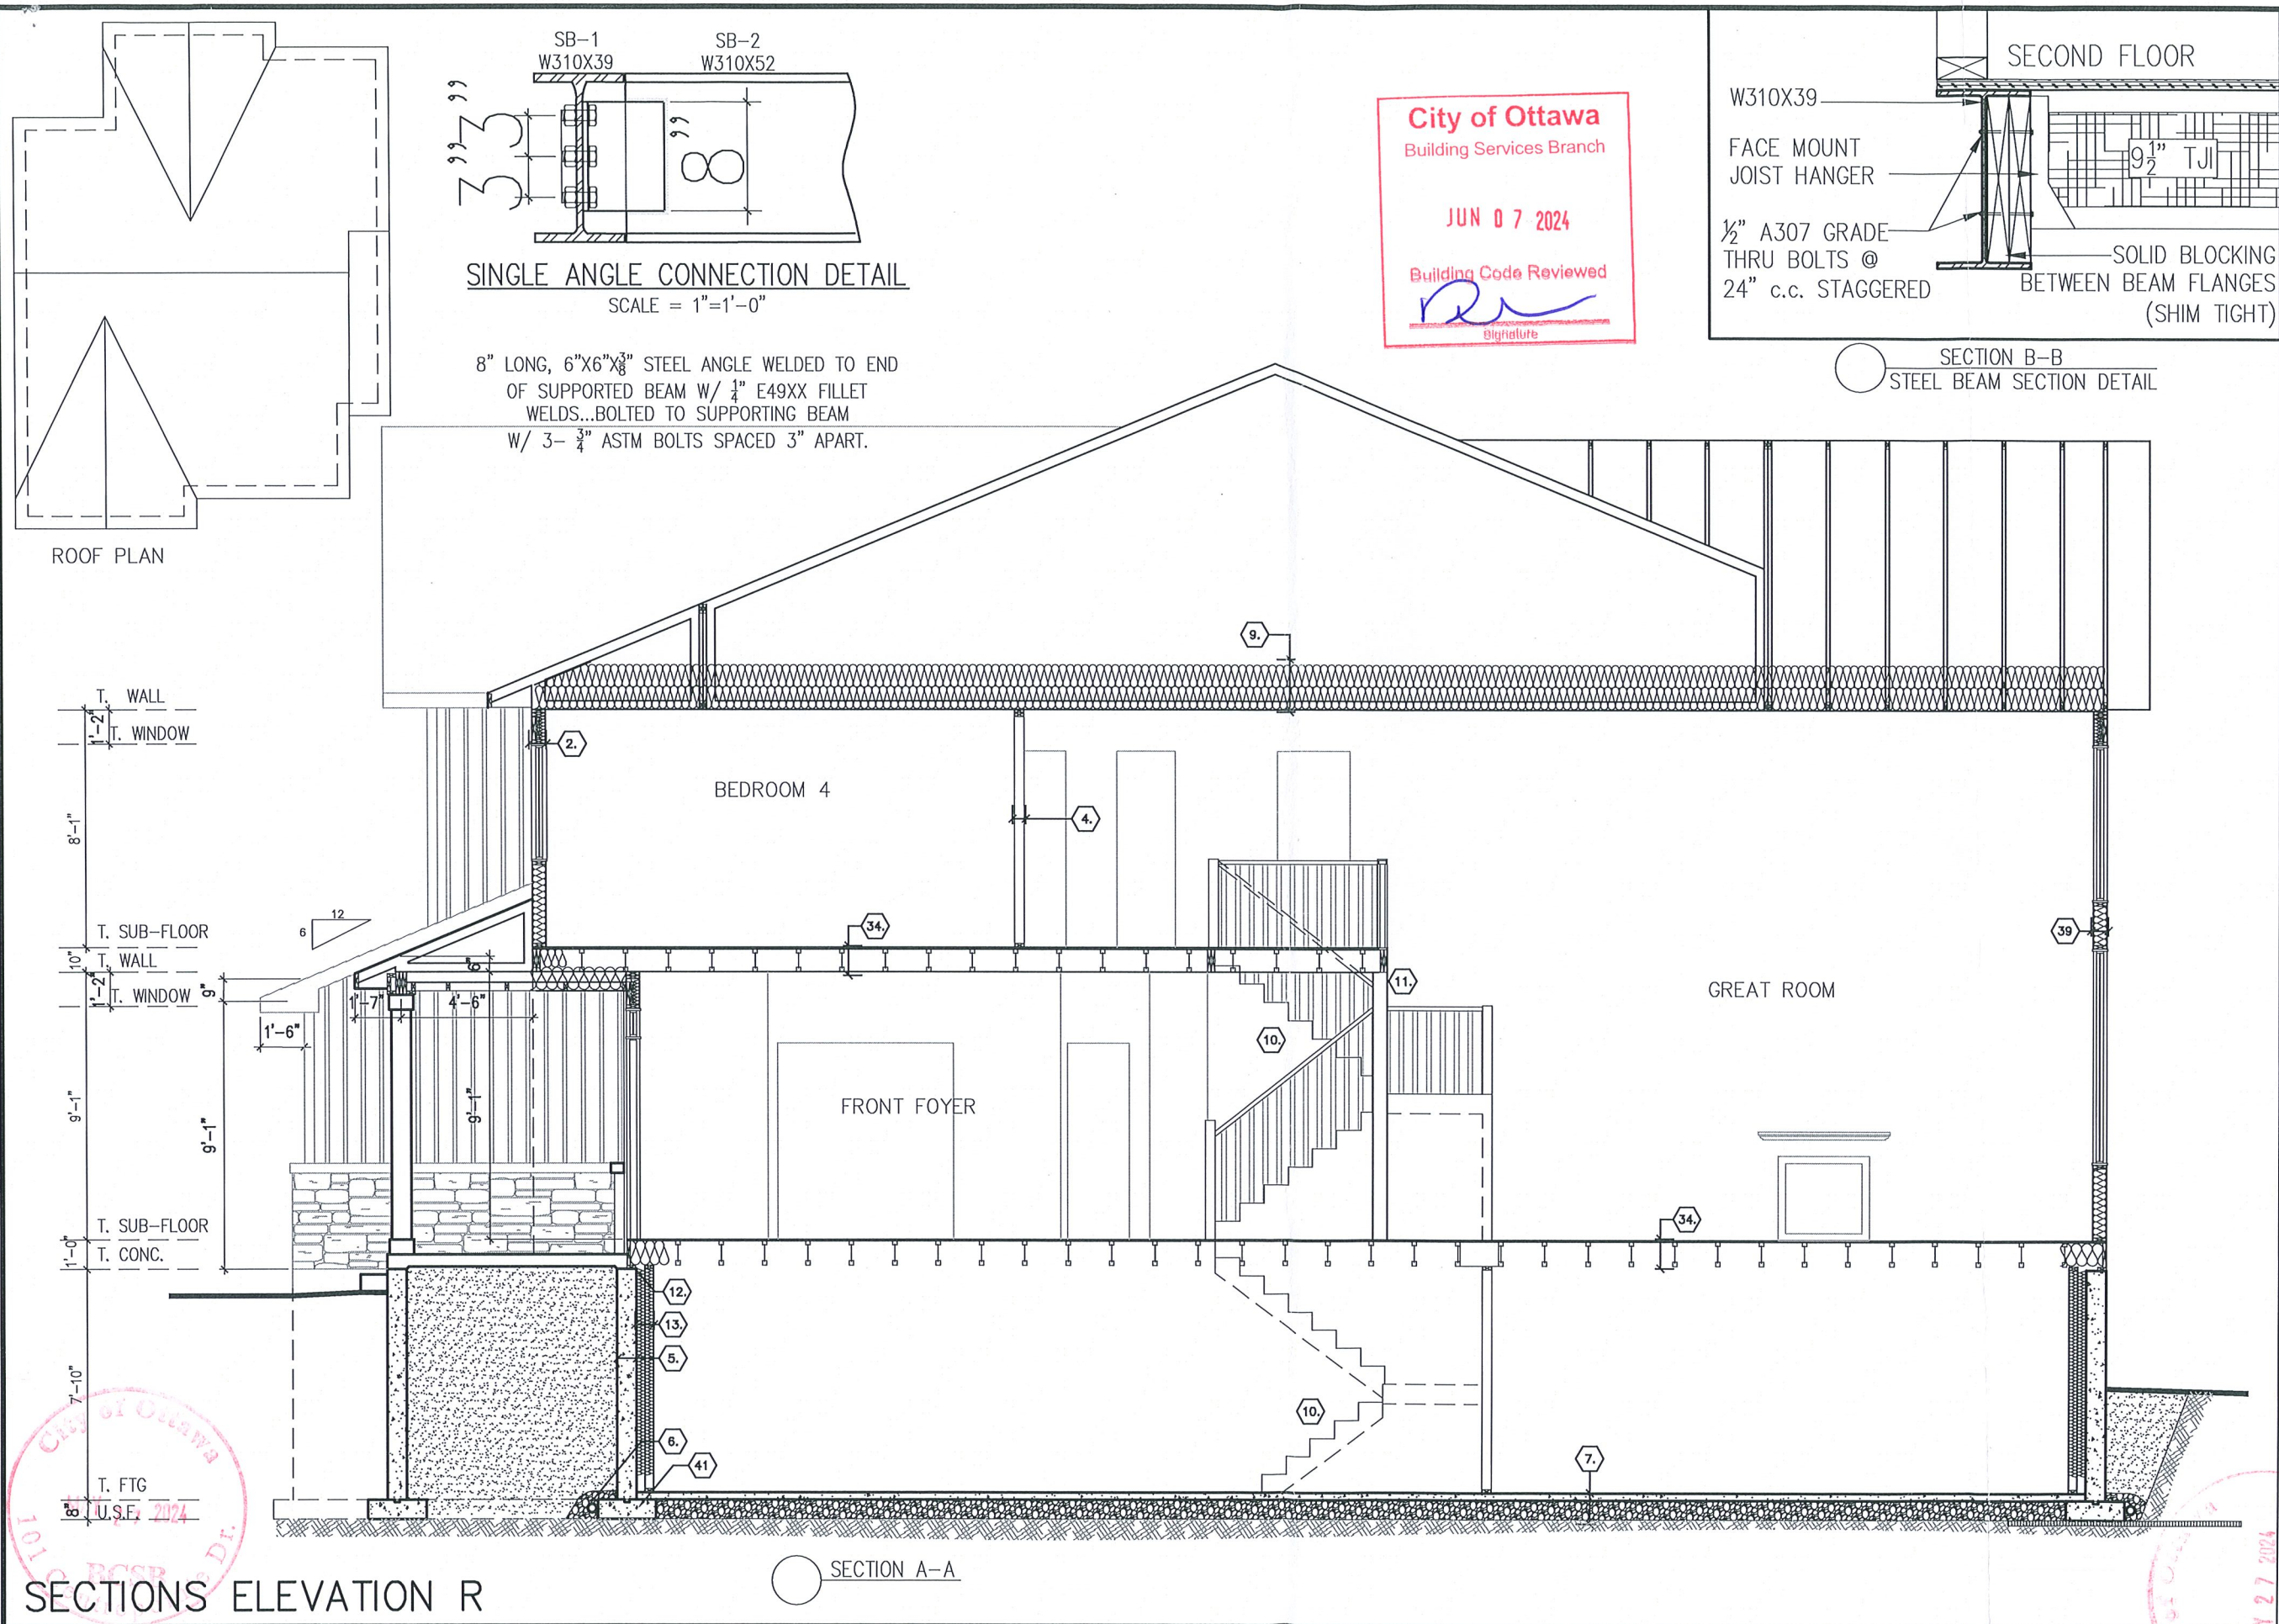

City of Ottawa
Building Services Branch
JUN 07 2024
Building Code Reviewed
[Signature]

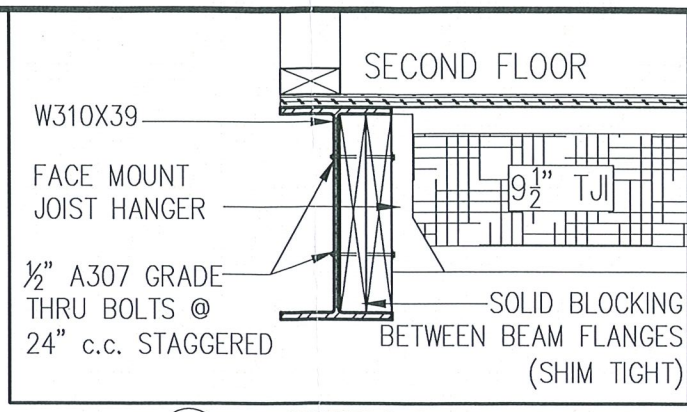

footprint: 50-22-7		drawn by: SP		date: JUN 12/16		scale: 3/16"=1'-0"		D.C.L. - A-24		sheet no: 8		9R of 9													
6	ISSUED FOR ENGINEERING	09/05/24	08	5	ISSUED FOR LAYOUTS	01/04/24	08	4	BEP BLACKLINES	25/03/24	08	3	B1 BLACKLINES	21/02/24	SP	2	KITCHEN LIGHT UPDATE	20/10/22	SP	1	FOR LAYOUTS AND STRUCTURE REVIEW	11/03/22	SP	By	dd/mm/yy
REVISIONS																									
NEWINGTON R - 2022																									
SITE: DIAMONDVIEW PH 3																									
LOT NUMBER: 80																									
CIVIC ADDRESS: 102 CHANDELLE PVT																									
PHOENIX HOMES																									