


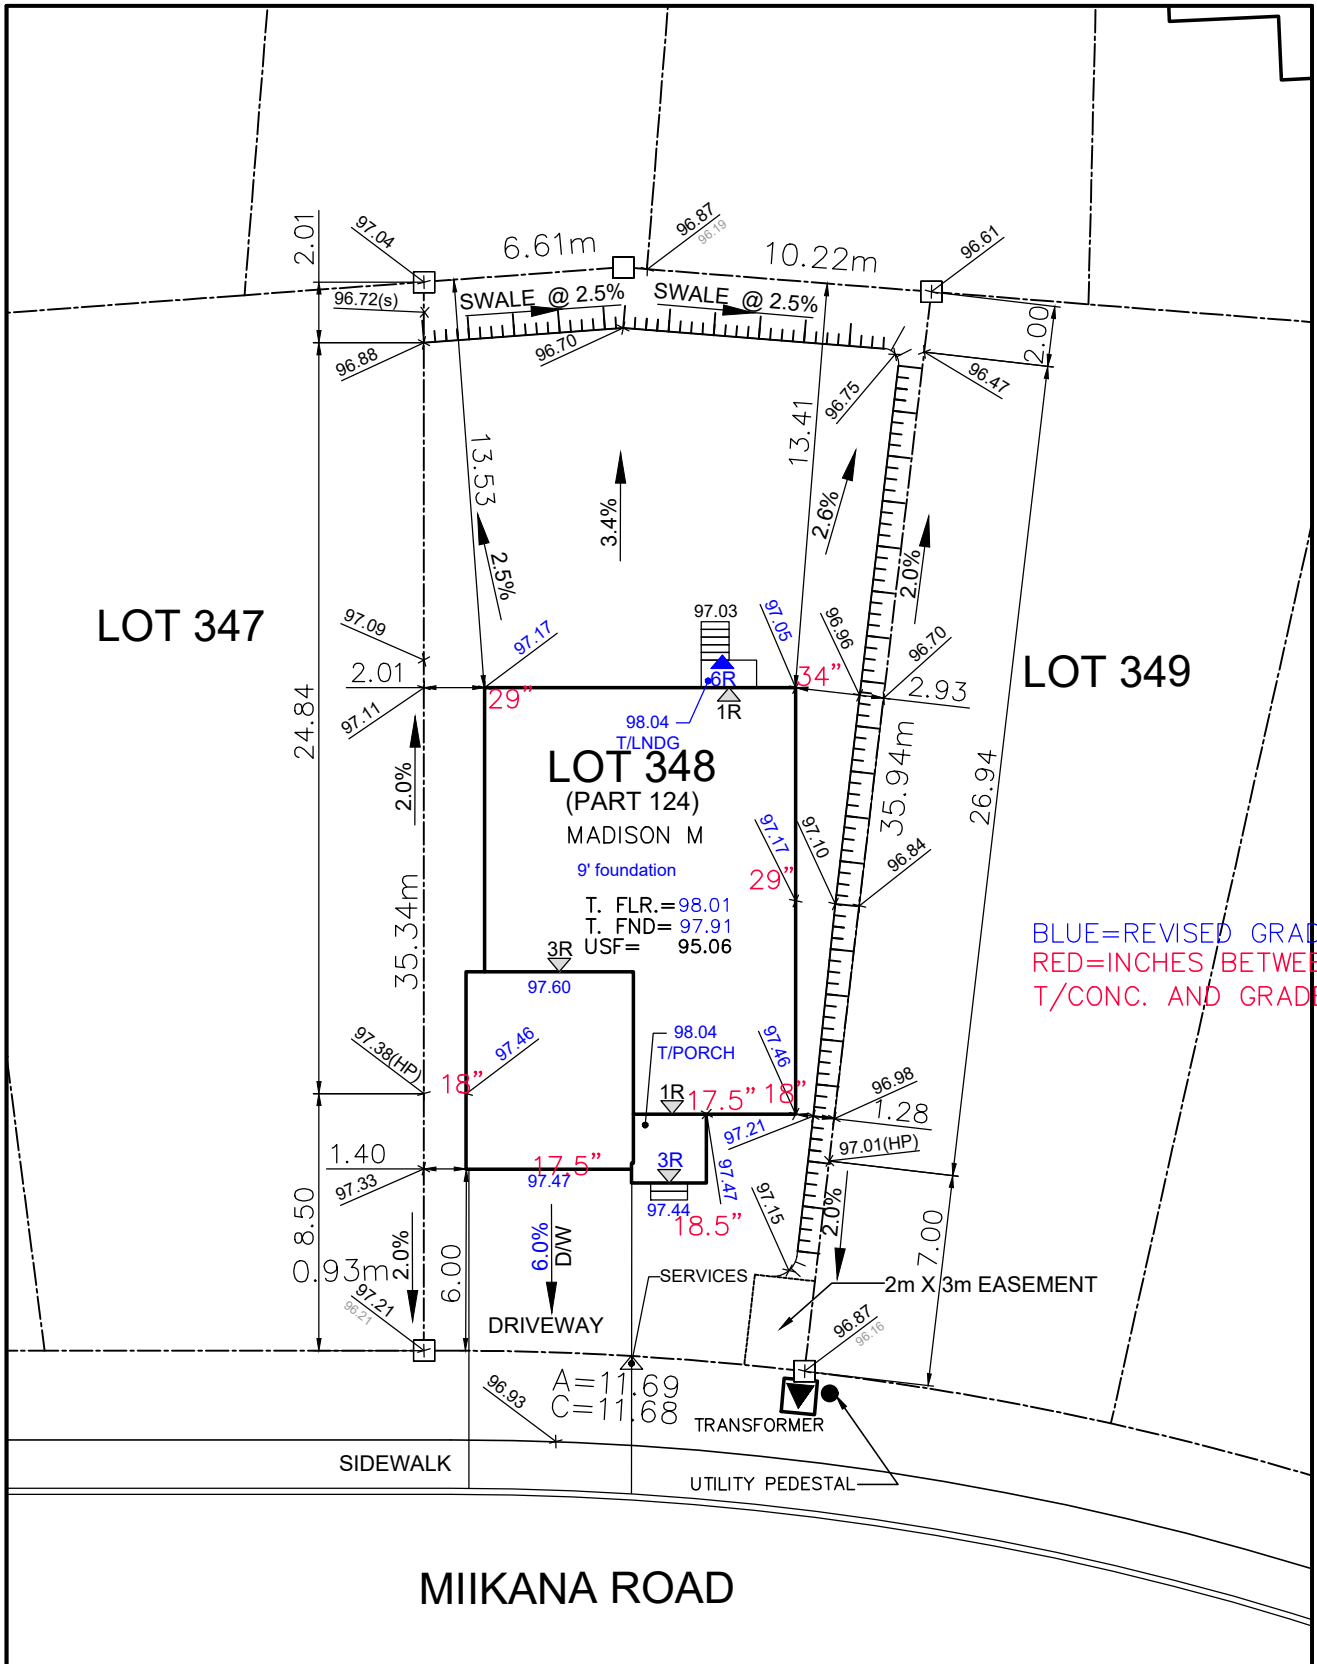

REV. SEPT. 27, 2024 – SP

