
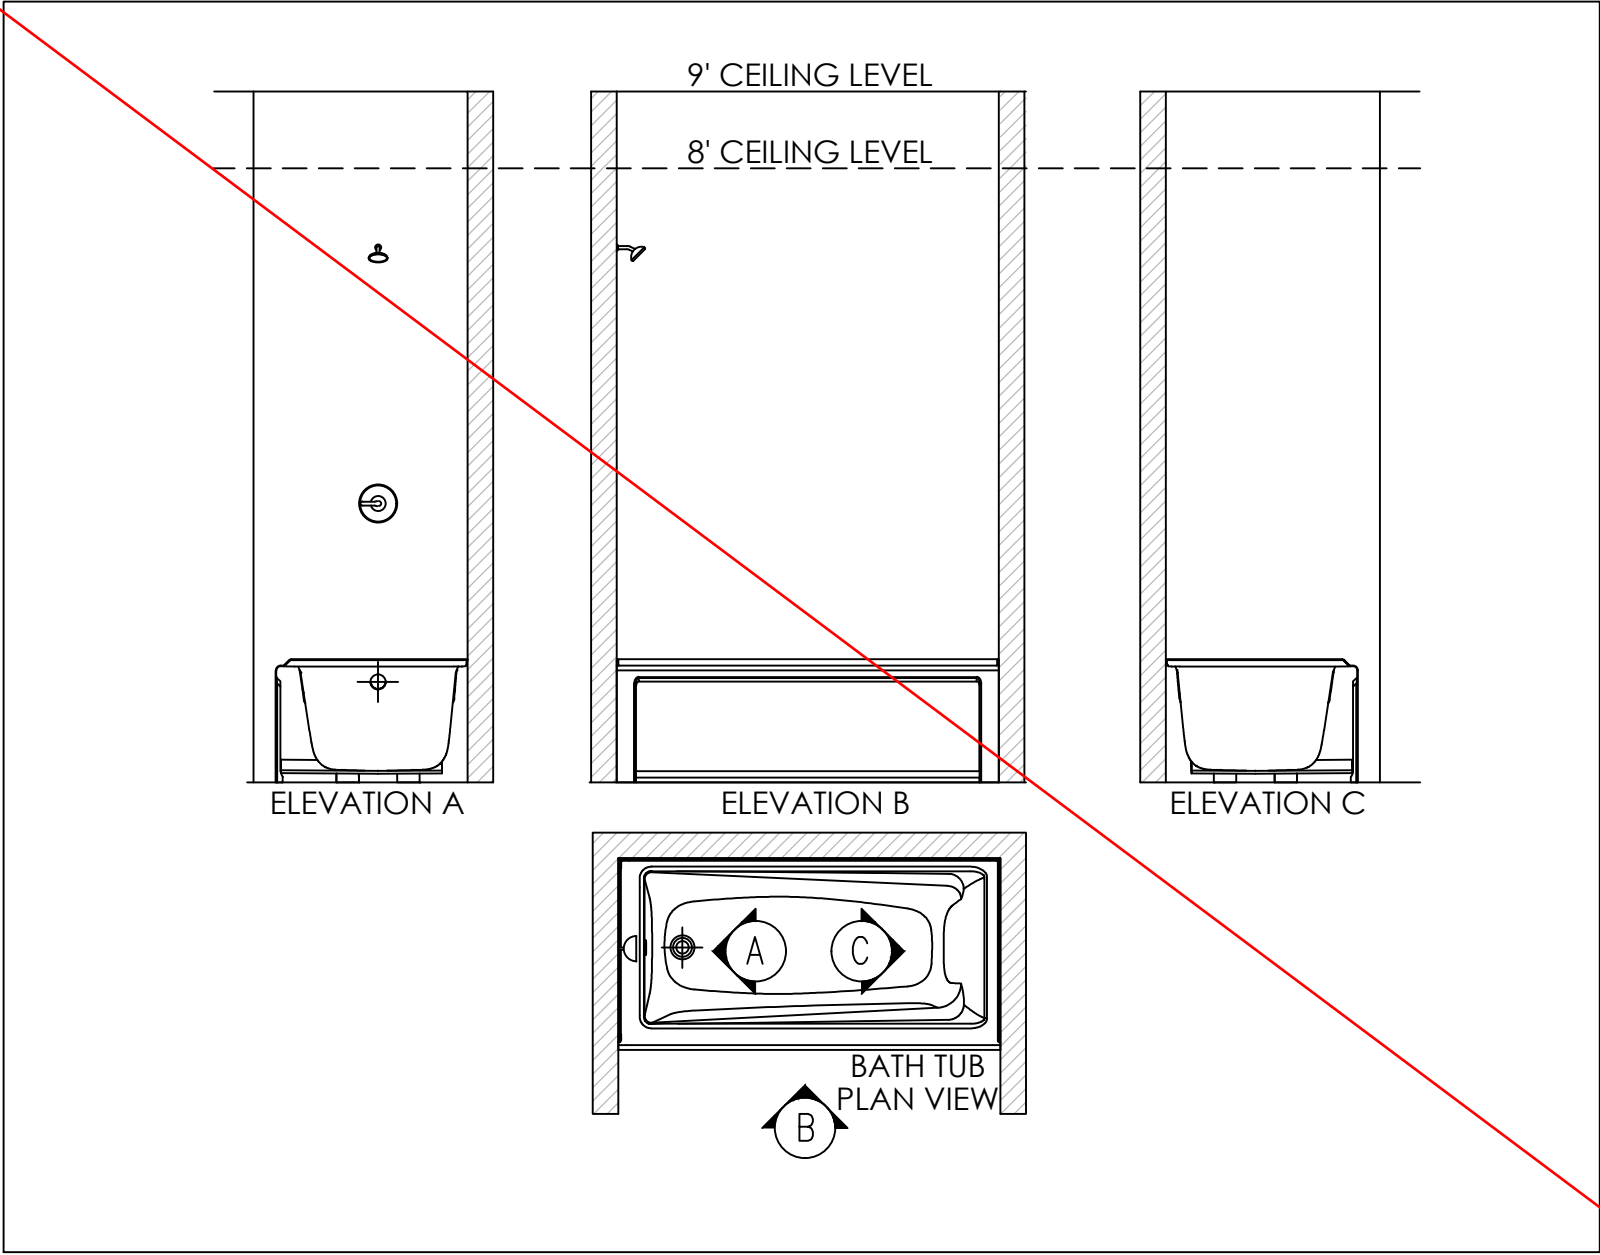


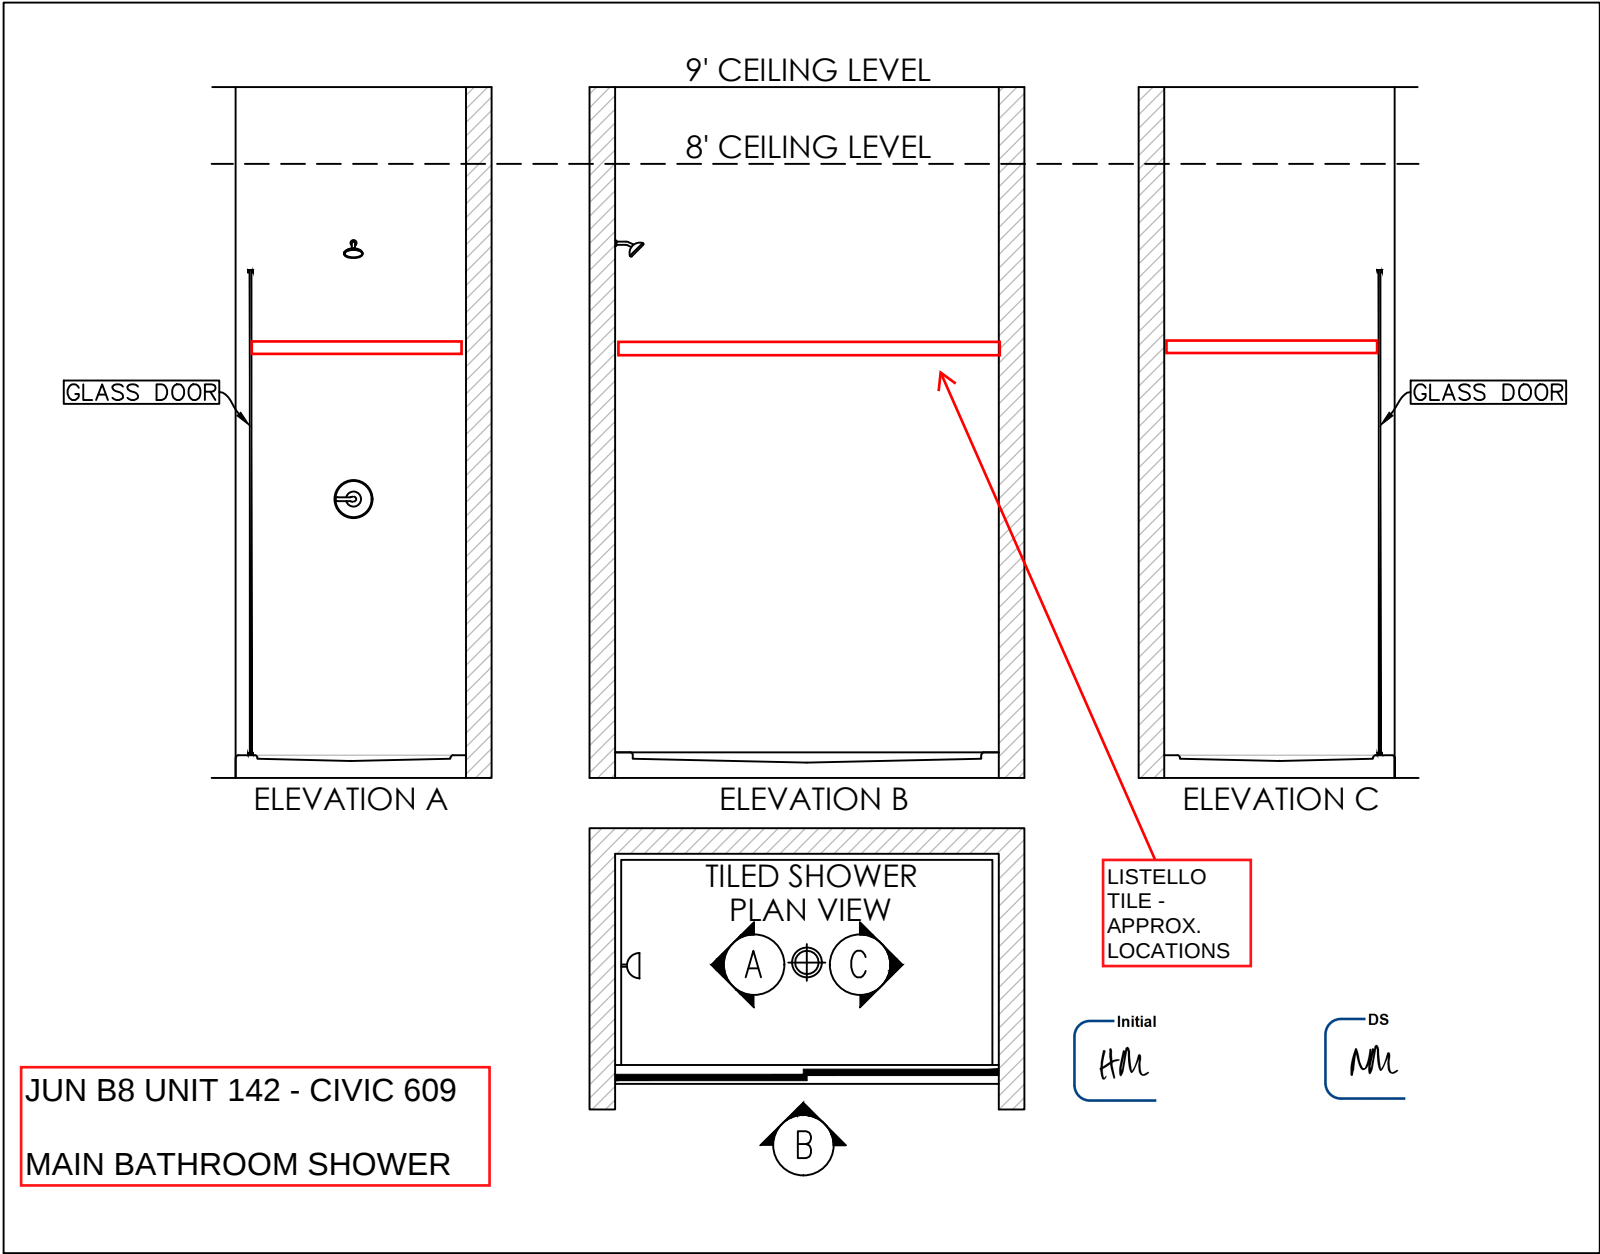

SCALE
NOT TO
SCALE

PHOENIX HOMES

TUB/SHOWER ELEVATIONS