

DCR PHOENIX HOMES



NUVO - BACK TO BACK
STACKED TERRACE HOMES

UPPER UNIT

REVISED: JANUARY 17, 2023

PATHWAYS BUILDING 2 UNIT 212

- CABINETS - CARTIER LINE 1
- HARDWARE - STD & 1ST UPGRADE
- STD HINGES
- STD METAL DRWRS
- 5 PCS - 5/8" KICK
- 6 PCS - FLAT SHOE MOULDING

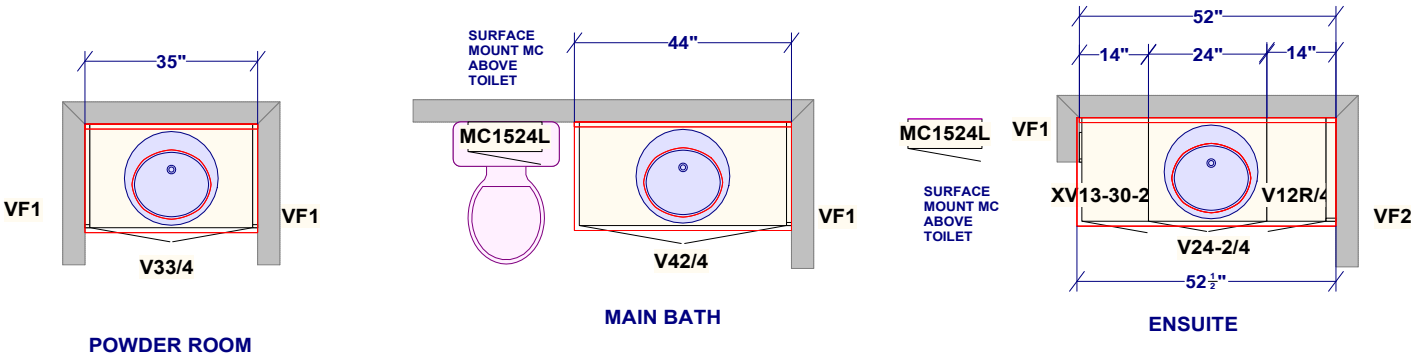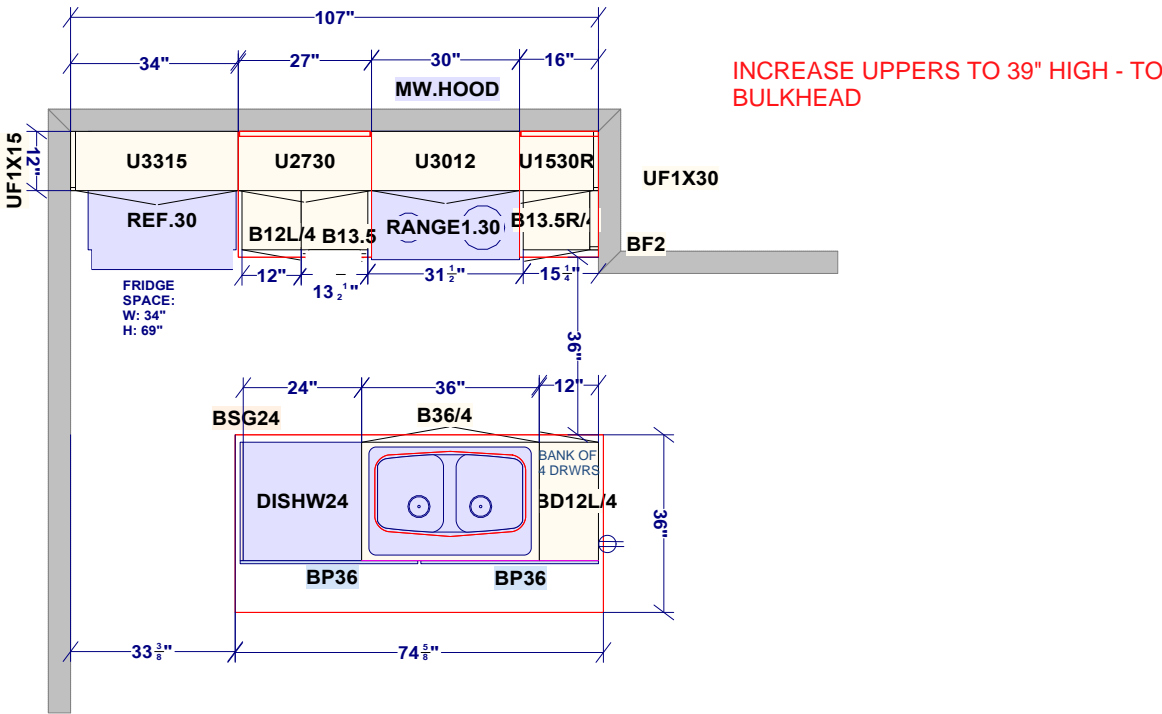

CUSTOMER APPROVAL

I have reviewed these drawings and understand the details of the design and the Cartier Kitchens specifications

Signature _____


Date _____

All dimensions size designations given are subject to verification on job site and adjustment to fit job conditions.



This is an original design and must not be released or copied unless applicable fee has been paid or job order placed.

Designed: 1/17/2023
Printed: 1/17/2023

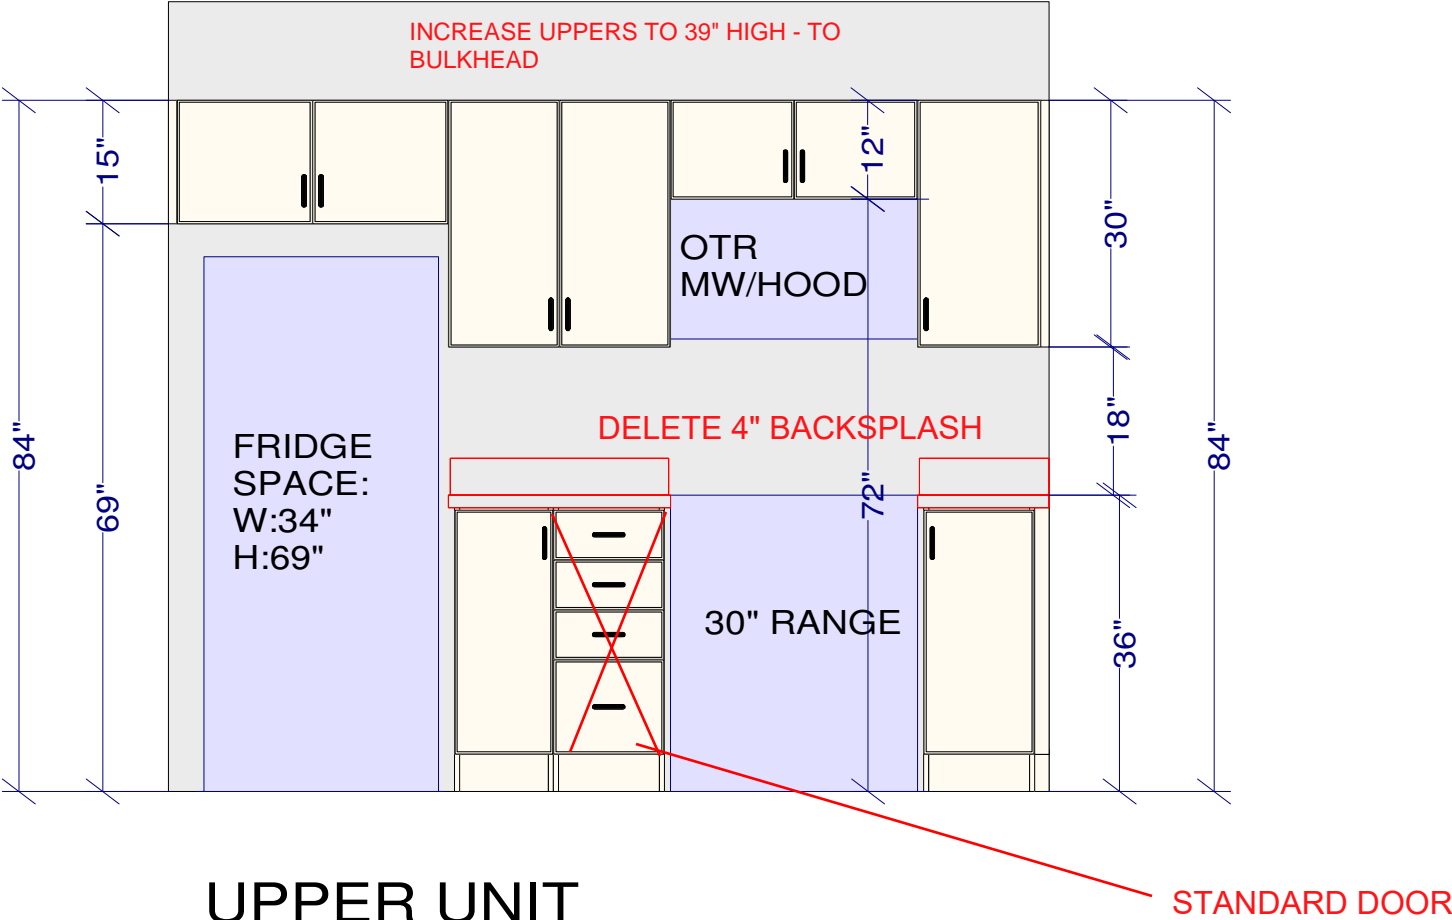


UPPER UNIT

FRIDGE/ RANGE WALL ELEVATION

Jan 17-23

| | | | | | |
|--|---|---|----------------------|--------------|-----------|
| <div><div>CUSTOMER APPROVAL</div><div>I have reviewed these drawings and understand the details of the design and the Cartier Kitchens specifications</div><div>Signature _____</div><div>Date _____</div></div> | <div>All dimensions _size designations given are subject to verification on job site and adjustment to fit job conditions.</div> <div></div> | <div>This is an original design and must not be released or copied unless applicable fee has been paid or job order placed.</div> | Designed: 2022-06-23 | | |
| | | | Printed: 2022-06-23 | | |
| | | | | | |
| DCR - Terrace Homes - Upper unit. | | | EI 1 | Drawing #: 1 | No Scale. |

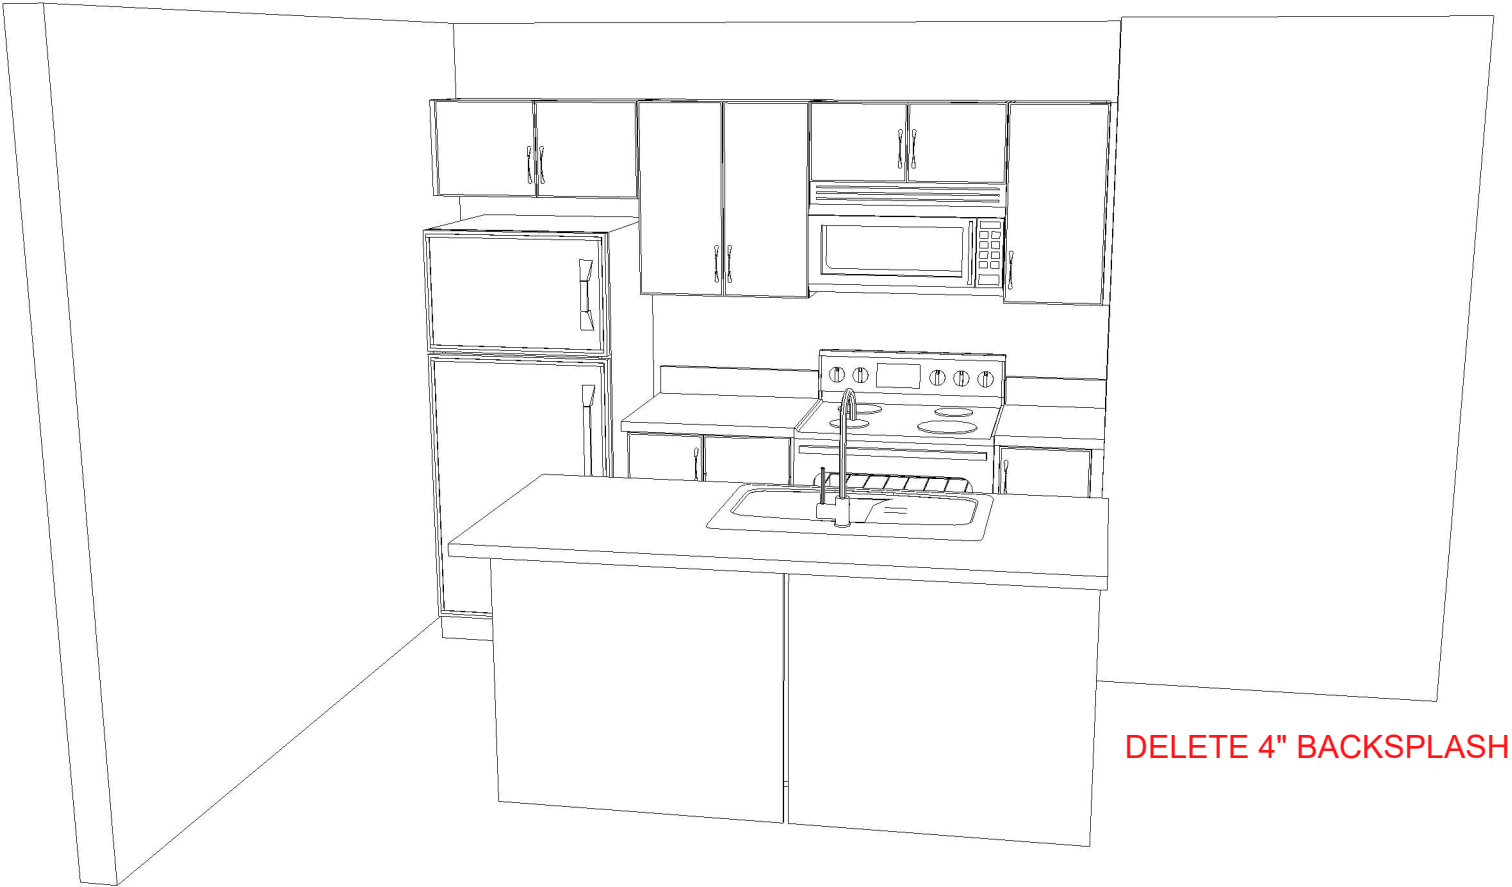


UPPER UNIT - KITCHEN - 3D VIEW

| | |
|---|--|
| <p>CUSTOMER APPROVAL</p> <p>I have reviewed these drawings and understand the details of the design and the Cartier Kitchens specifications</p> <p>Signature _____</p> <p>Date _____</p> | |
|---|--|

Note: This drawing is an artistic interpretation of the general appearance of the design. It is not meant to be an exact rendition.



| |
|---|
| Designed: 1/17/2023 Printed: 1/17/2023 |
|---|

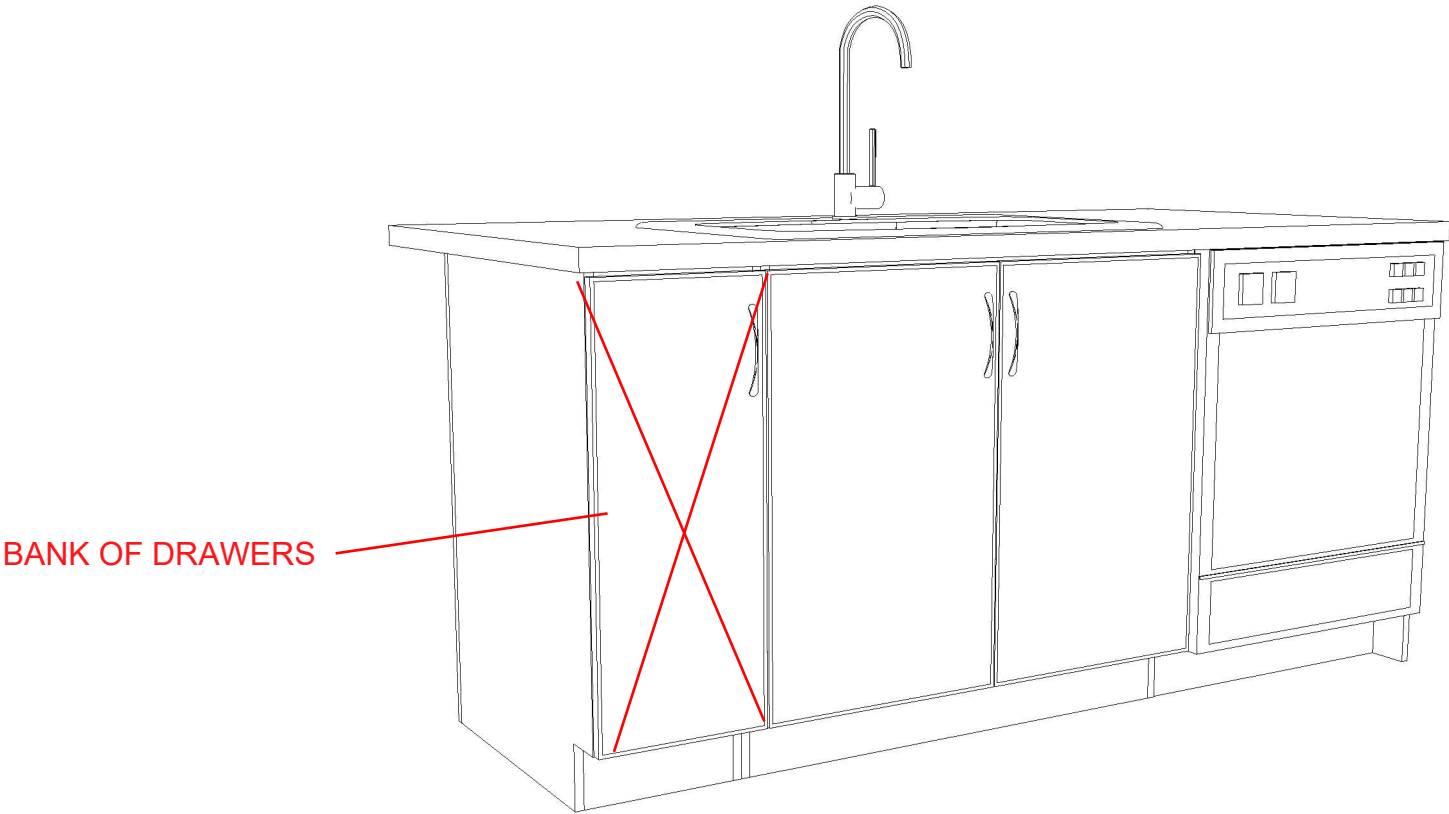

BANK OF DRAWERS


UPPER UNIT - KITCHEN ISLAND - 3D VIEW

| | |
|---|--|
| <p>CUSTOMER APPROVAL</p> <p>I have reviewed these drawings and understand the details of the design and the Cartier Kitchens specifications</p> <p>Signature _____</p> <p>Date _____</p> | |
|---|--|

Note: This drawing is an artistic interpretation of the general appearance of the design. It is not meant to be an exact rendition.




Designed: 1/17/2023
Printed: 1/17/2023

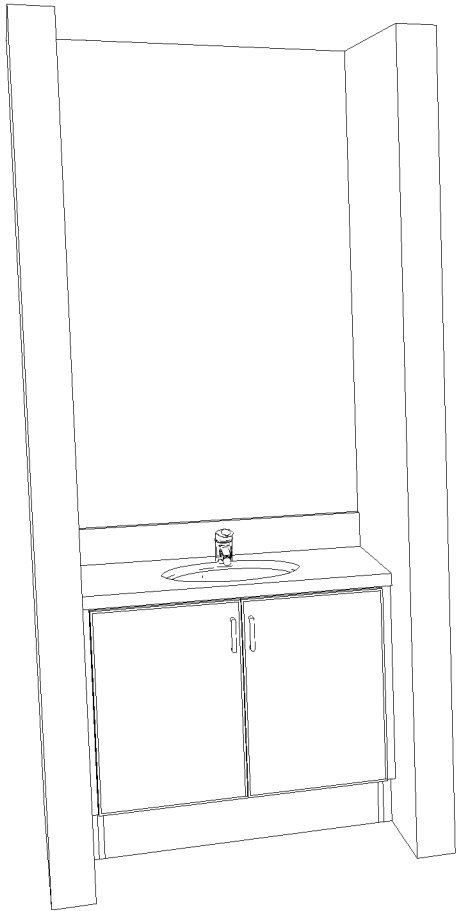

POWDER ROOM



MAIN BATH

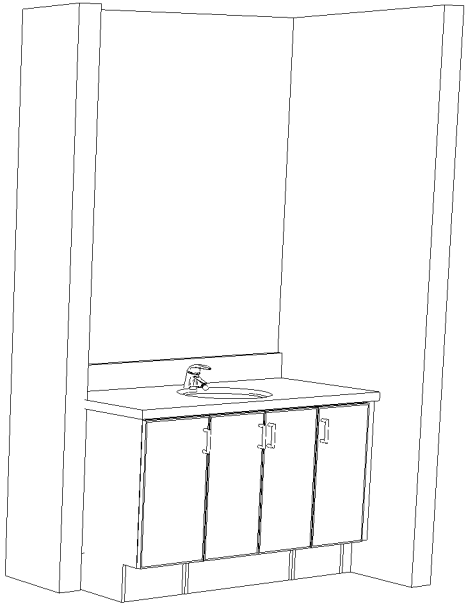

ENSUITE

UPPER UNIT - VANITIES - 3D VIEW

| | |
|---|--|
| <p>CUSTOMER APPROVAL</p> <p>I have reviewed these drawings and understand the details of the design and the Cartier Kitchens specifications</p> <p>Signature _____</p> <p>Date _____</p> | |
|---|--|

Note: This drawing is an artistic interpretation of the general appearance of the design. It is not meant to be an exact rendition.

SPECTRUM KITCHEN and BATH DESIGN

DCR - Terrace Homes - Upper unit



| |
|----------------------|
| Designed: 2020-06-29 |
| Printed: 2020-08-09 |
| |