


FOR CONTINUATION REFER TO DWG. E-3A

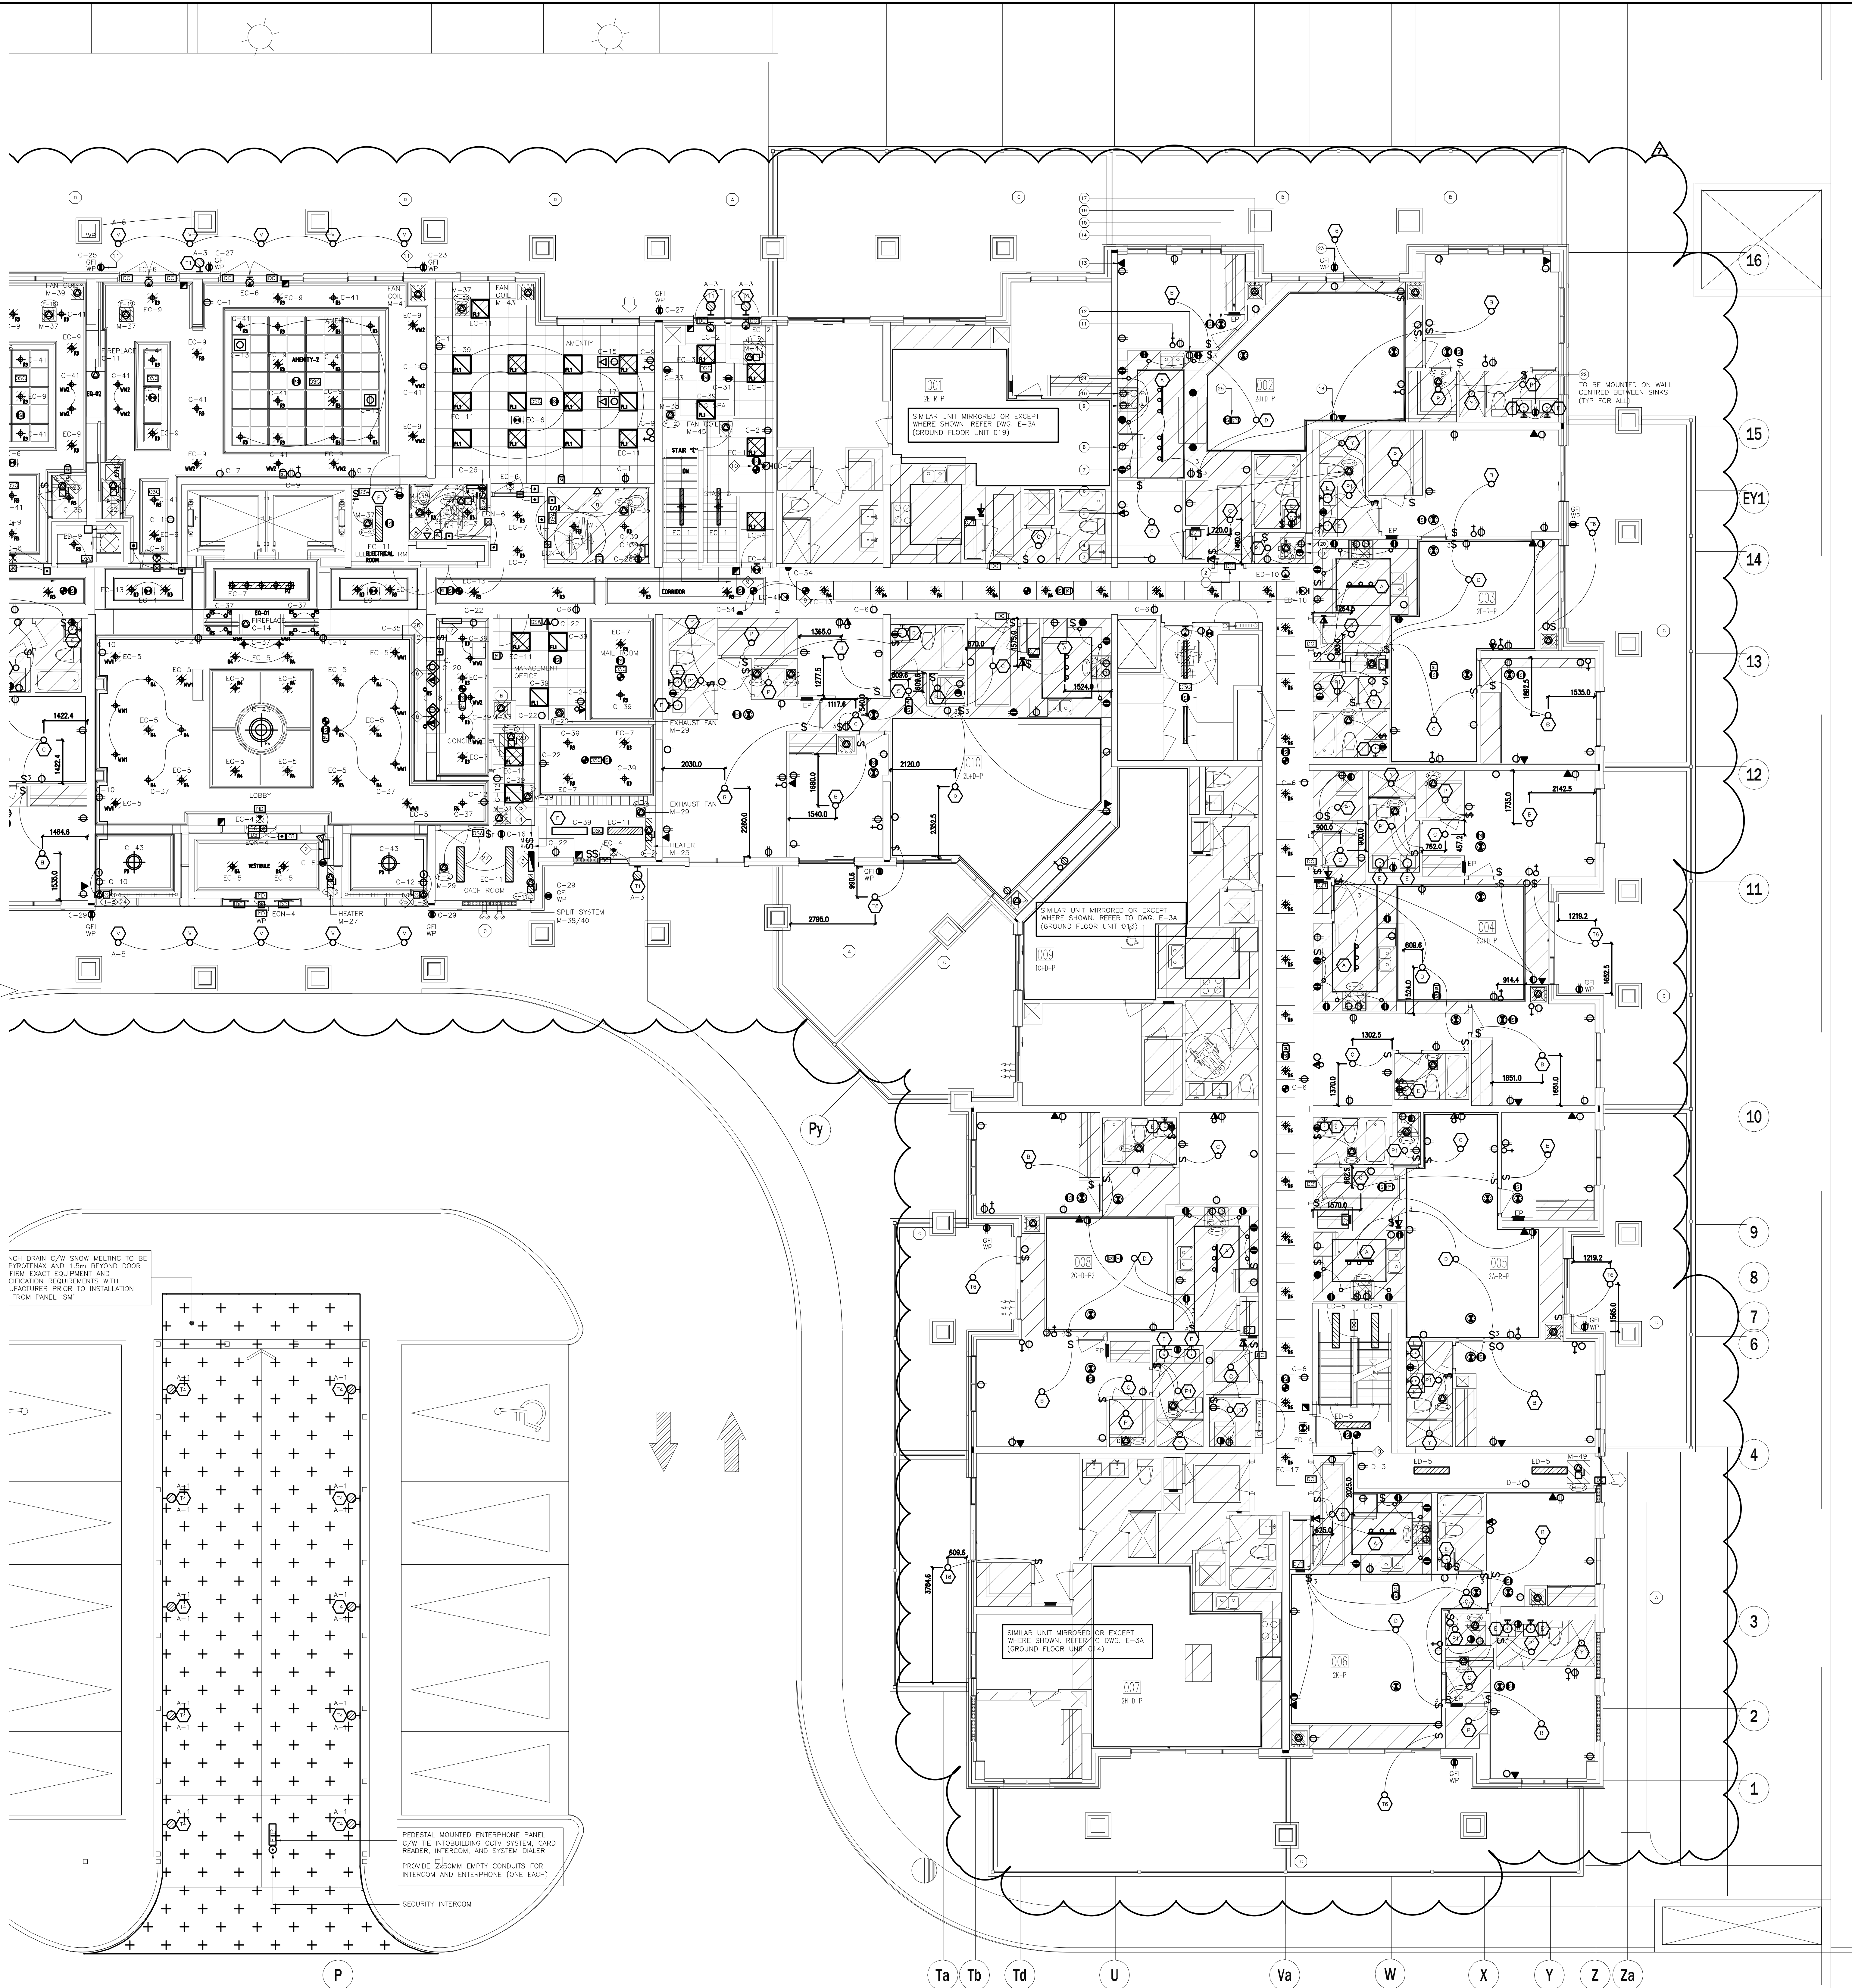

SUITES' KEY NOTES (TYPICAL)

- 1 DOOR CONTACT
- 2 SUITE INTRUSION ALARM AND KEYPAD WITH DIGITAL DISPLAY
- 3 120 V-GROUND DUPLEX RECEPTACLE FOR GENERAL PURPOSES
- 4 IN SUITE TELEPHONE/TV COMBO DISTRIBUTION PANEL
- 5 WALL MOUNTED COMBINATION TV/TELEPHONE OUTLET
- 6 DIRECT CONNECTION FOR WASHROOM EXHAUST FAN
- 7 120V, 20A, 1-SLOT RECEPTACLE MOUNTED ABOVE COUNTER TOP (ALL RECEPTACLES LOCATED WITHIN 1.5M OF KITCHEN SINKS ALONG THE WALL BEHIND THE COUNTERS SHALL BE PROTECTED BY GFI BREAKERS OF THE CLASS A TYPE)
- 8 120V, 15A, RECEPTACLE FOR FRIDGE
- 9 250V, 16, 4W, 50A, RECEPTACLE FOR RANGE, CONNECT WITH 3/8" BX OR 3/8" THW-19MM CONDUIT
- 10 RECEPTACLE FOR KITCHEN MICROWAVE AND EXHAUST FAN
- 11 WALL MOUNTED TV OUTLET
- 12 120V U-GROUND DUPLEX RECEPTACLE FOR DISHWASHER
- 13 WALL MOUNTED TELEPHONE OUTLET
- 14 CEILING MOUNTED FIRE ALARM SPEAKER
- 15 CEILING MOUNTED 120V SMOKE ALARM/CARBON MONOXIDE COMBO DETECTOR (FOR 1ST, 2ND AND 7TH FLOORS ONLY)
- 16 CEILING MOUNTED 120V SMOKE ALARM DETECTOR (FOR ALL OTHER FLOORS (3RD-6TH))
- 17 ALL DETECTORS WITHIN SAME SUITE TO BE INTERCONNECTED AND HAVE A VISUAL SIGNALING COMPONENT IN ACCORDANCE WITH CBC
- 18 FLUSH MOUNTED SUITE SERVICE PANEL, SEE DRAWING E-16 FOR SUITE PANEL SCHEDULE
- 19 DIRECT CONNECTION FOR VERTICAL FAN COIL UNIT (REFER TO MECHANICAL DRAWING FOR MORE DETAILS)
- 20 120V U-GROUND DUPLEX RECEPTACLE WITH ONE HALF SWITCH CONTROLLED
- 21 DIRECT CONNECTION FOR DRYER EXHAUST FAN
- 22 120V, 15A, RECEPTACLE FOR WASHER
- 23 250V, 10, 4W, 30A, RECEPTACLE FOR DRYER, CONNECT TO 3/4" BX OR 3/4" THW-19MM CONDUIT
- 24 120V U-GROUND DUPLEX GFI RECEPTACLE FOR WASHROOM
- 25 120V U-GROUND DUPLEX GFI, WEATHER PROOF RECEPTACLE IN BALCONY (TYPICAL FOR 1ST FLOOR AND EXTERIOR BALCONY ONLY)
- 26 120V U-GROUND DUPLEX WEATHER PROOF RECEPTACLE IN BALCONY (TYPICAL FOR 2ND TO 7TH FLOOR)
- 27 UNDER COUNTER LIGHTING TYPE TO BE CONFIRMED BY CLIENT
- 28 CEILING MOUNTED FIRE ALARM COMBINATION SPEAKER/STROBE LIGHT

NOTES:
ALSO REFER TO TYPICAL SUITES NOTES ON DRAWING E-9B. (ALL RECEPTACLES SHALL BE PROTECTED BY AFCI-AULT INTERRUPTERS)

GENERAL KEY NOTES


- 1 JUNCTION BOX FOR TRI-SORT GARBAGE SYSTEM
- 2 ENTERPHONE PANEL C/W TIE INTO BUILDING CCTV SYSTEM, CARD READER, INTERCOM, AND SYSTEM DIALER (FED FROM ECN-11)
- 3 CACF FIRE ALARM CONTROL PANEL (FED FROM DPE2)
- 4 KEY SWITCH ELEVATOR RECALL CO-ORDINATE EXACT LOCATION WITH ELEVATOR CONTRACTOR
- 5 FIRE ALARM MASTER OPERATION SWITCH FOR FIRE DEPARTMENT MASTER CONTROL (FED FROM ECN-13)
- 6 CONFIRM POWER AND COMMUNICATION REQUIREMENTS AT CONCIERGE DESK WITH CLIENT, PROVIDE 4x2" CONDUIT TO COMMUNICATION ROOM
- 7 BUILDING STATUS ANNUNCIATOR PANEL
- 8 EMERGENCY BUTTON C/W INTERCONNECTION TO CONCIERGE
- 9 DOOR HOLD OPEN DEVICE INTERCONNECTED TO FIRE ALARM SYSTEM TO RELEASE UPON ACTIVATION OF FIRE ALARM SYSTEM INTERCONNECTED TO LOCALIZED SMOKE DETECTORS
- 10 TOP OF STAIR SMOKE DETECTOR AND SPEAKER C/W FIRE ALARM ZONE
- 11 GFI WATERPROOF BRG RECEPTACLE TO BE INSTALLED AT LEAST 1M AWAY FROM GAS CONNECTION, COORDINATE EXACT LOCATION ON SITE. (TYPICAL FOR 2)
- 12 FIREPLACE 'S' CONTROL, REQUIREMENT AND LOCATION TBC
- 13 FRIDGE C-32
- 14 DISHWASHER C-42
- 15 SPLIT COUNTER RECEPTACLES C-34/36
- 16 SPLIT COUNTER RECEPTACLES C-38/40
- 17 COOKTOP C-44
- 18 MICRO/FAN C-46
- 19 STOVE C-48
- 20 SPLIT SYSTEM E-8 (STORAGE) M-42/44
- 21 SPLIT SYSTEM E-8 (WC) M-46/48
- 22 SPLIT SYSTEM E-8 (AMENITY) M-50/52
- 23 SPLIT SYSTEM E-8 (AMENITY) M-54/56
- 24 BASEBOARD HEATER M-23
- 25 BASEBOARD HEATER M-25
- 26 UNDER COUNTER LIGHTING TO BE CONFIRMED BY CLIENT/INTERIOR DESIGNER
- 27 CACF ROOM IS REQUIRED TO CONTAIN THE FOLLOWING CONTROLS:
 - 1. A MEANS TO CONTROL THE VOICE COMMUNICATION SYSTEM
 - 2. MEANS TO INDICATE AUDIBLE AND VISUAL ALARM SIGNALS
 - 3. MEANS TO INDICATE VISUALLY THAT ELEVATORS ARE ON EMERGENCY RECALL
 - 4. MEANS TO TRANSMIT ALARM SIGNALS TO THE FIRE DEPARTMENT
 - 5. MEANS TO RELEASE HOLD-OPEN DEVICES
 - 6. MEANS TO MANUALLY ACTIVATE ALARM SIGNALS
 - 7. MEANS TO SILENCE ALARM SIGNALS
 - 8. MEANS TO COMMUNICATE WITH EVERY ELEVATOR CAR
 - 9. MEANS TO INDICATE VISUALLY INDIVIDUAL SPRINKLER SYSTEM WATER FLOW SIGNALS
 - 10. A SWITCH TO SILENCE THE AUDIBLE PORTION OF A SUPERVISORY SIGNAL OR A TROUBLE SIGNAL
 - 11. CONTROLS TO STOP AIR HANDLING SYSTEMS
 - 12. CONTROLS TO INITIATE EMERGENCY PRESSURIZATION AIR SUPPLIES
 - 13. CONTROLS TO OPERATE POWERED DOOR OPERATORS AND/OR MOTORIZED FIRE DAMPERS FORMING PART OF A PRESSURIZATION/RELIEF SYSTEM
- 28 CONFIRM ALL DIMENSIONS OF LIGHTING FIXTURES ON SITE WITH CLIENT PRIOR TO ROUGH-IN.

1. ELECTRICAL DRAWINGS TO BE READ IN CONJUNCTION WITH THE INTERIOR DESIGNER'S DRAWINGS IN AREAS SUCH AS LOBBY, AMENITY, MANAGEMENT OFFICE, MAIL, CONCIERGE AND CORRIDORS, REFER TO THE INTERIOR DESIGNER'S DRAWINGS FOR EXACT LOCATION, REQUIREMENTS, MOUNTING HEIGHT AND LIGHTING SPECIFICATION.

NO.	BY	DESCRIPTION	DATE
07	CM	ISSUED FOR AS PER SI E-3	2017-08-11
06	CM	ISSUED FOR CONSTRUCTION	2017-08-09
05	CM	PROGRESS FOR CONSTRUCTION	2017-07-18
04	CM	ISSUED FOR PERMIT	2016-12-28
03	CM	REVISED AS PER ADD E-1	2016-12-12
02	CM	REVISED AS PER ESA COMMENTS AND FOR CLARIFICATION	2016-05-19
01	CM	ISSUED FOR TENDER	2016-03-15

REVISIONS

This drawing is an instrument of service, is provided by and is the property of United Engineering Inc. The contractor must verify and accept responsibility for all dimensions and conditions on site and must notify United Engineering Inc. of any discrepancy before proceeding. United Engineering Inc. is not responsible for the accuracy of Architectural, structural, interior design, etc. on this drawing. Refer to the appropriate trade drawings before proceeding with any work. Installation must conform to all applicable codes and requirements of the authorities having jurisdiction. This drawing is not to be scaled, all symbols are graphic representations only.

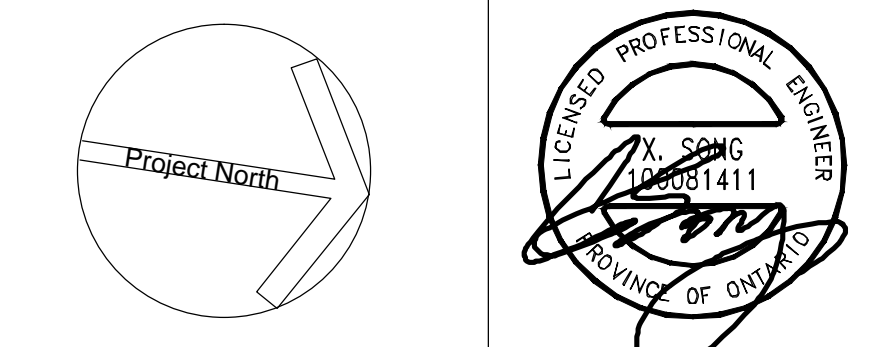

United Engineering Inc.
Mechanical Electrical Consulting Engineers
3445 Reels Street, Suite 105,
Toronto, Ontario, M3J 1M6
Tel: (416) 398 1999, Fax: (416) 398 1933

TITLE
**GROUND FLOOR PLAN - B
ELECTRICAL**

PROJECT
**PROPOSED RESIDENTIAL DEVELOPMENT
25 BAKER HILL BLVD.**

**ROYAL PINE HOMES
STOUFFVILLE, ONTARIO**

DRAWN	CM	CHECKED	MG	SCALE	1:75
DATE	SEPT. 2015	PROJECT	14-016	DRAWING	E-3B
				OF	12