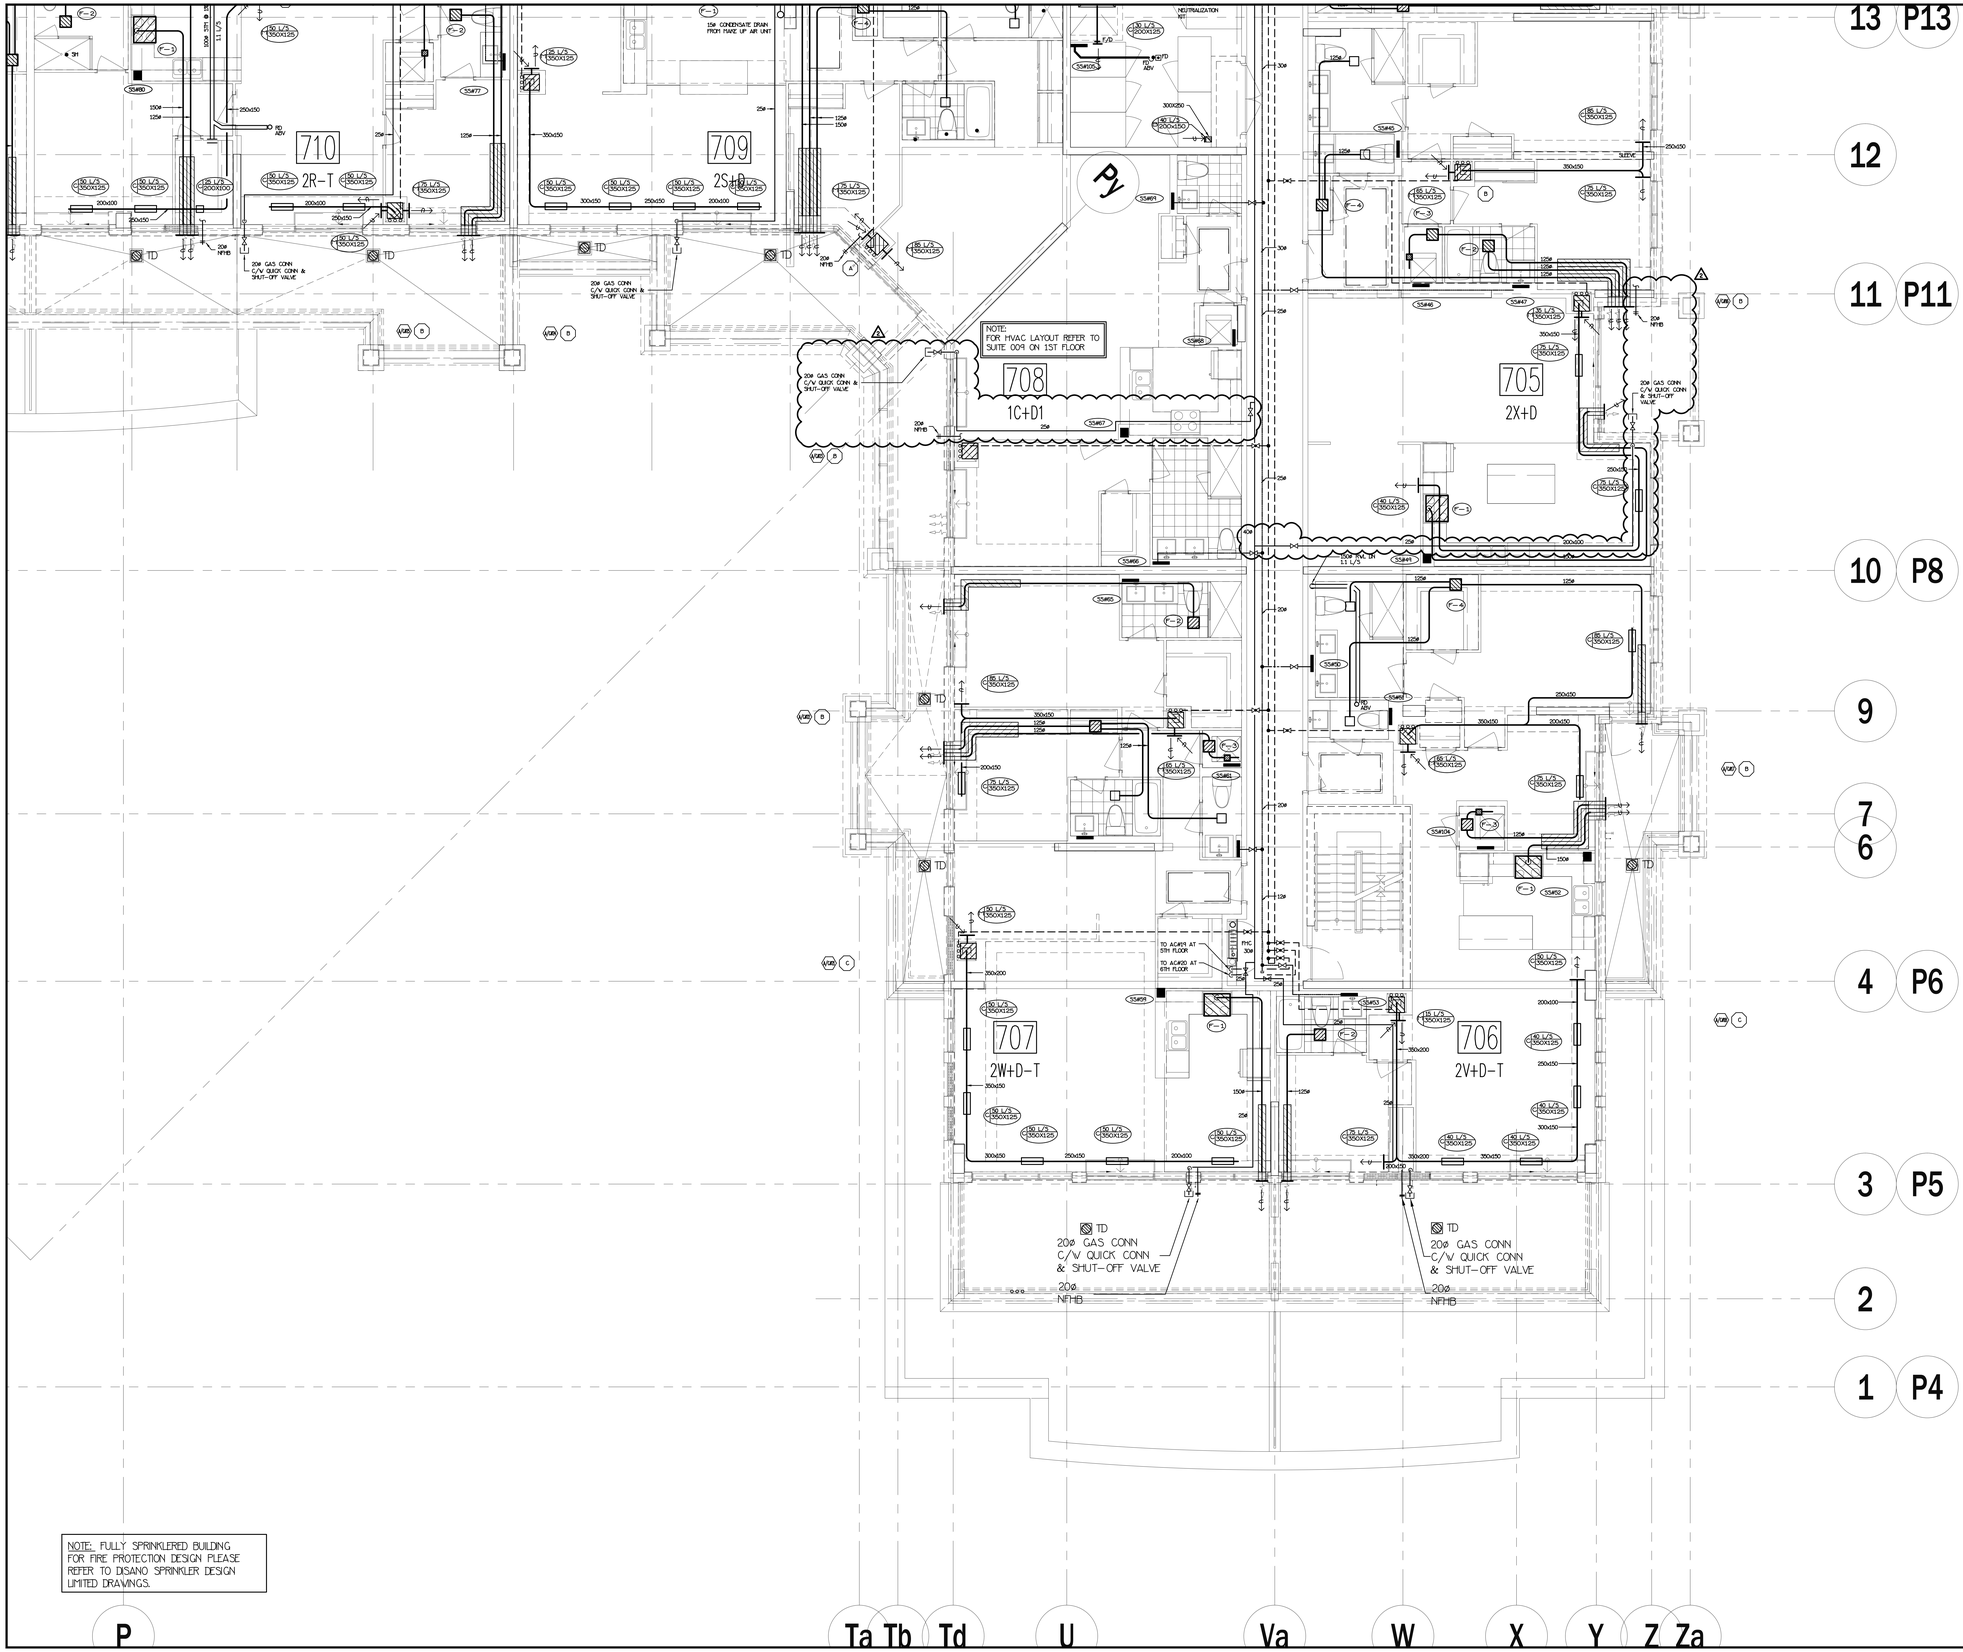

NOTE: FULLY SPRINKLERED BUILDING
FOR FIRE PROTECTION DESIGN PLEASE
REFER TO DISANO SPRINKLER DESIGN
LIMITED DRAWINGS.

P Ta Tb Td U Va W X Y Z Za

13 P13 12 11 P11 10 P8 9 7 6 4 P6 3 P5 2 1 P4

NO.	BY	DESCRIPTION	DATE
2	CP	REVISED AS PER SITE INSTRUCTION #1-2	AUG/16/2016
1	LM	ISSUED FOR TENDER	MAR/21/2016

REVISIONS

This drawing, is an instrument of service, is provided by and is the property of United Engineering Inc. The contractor must verify and accept responsibility for all dimensions and conditions on site and must notify United Engineering Inc. of any discrepancy before proceeding.
United Engineering Inc. is not responsible for the accuracy of Architectural, structural, interior design, etc. on this drawing.
Refer to the appropriate trade drawings before proceeding with any work. Installation must conform to all applicable codes and requirements of the authorities having jurisdiction.
This drawing is not to be scaled, all symbols are graphic representations only.

LICENCE PROFESSIONAL ENGINEER Y. HOU 100117097 PROVINCE OF ONTARIO

United Engineering Inc.
Mechanical Electrical Consulting Engineers
3645 Keele Street, Suite 105,
Toronto, Ontario, M3J 1M6
Tel: (416) 398 1999, Fax: (416) 398 1933

TITLE
PART 7TH FLOOR PLAN MECHANICAL

PROJECT
25 BAKER HILL BLVD.
ROYAL PINE HOMES
STOUFFVILLE, ONTARIO
PROPOSED RESIDENTIAL DEVELOPMENT

DRAWN	CHECKED	SCALE
GC	BT	1:50
DATE	PROJECT	DRAWING
JUNE 2015	14-016	M-33
		OF 42