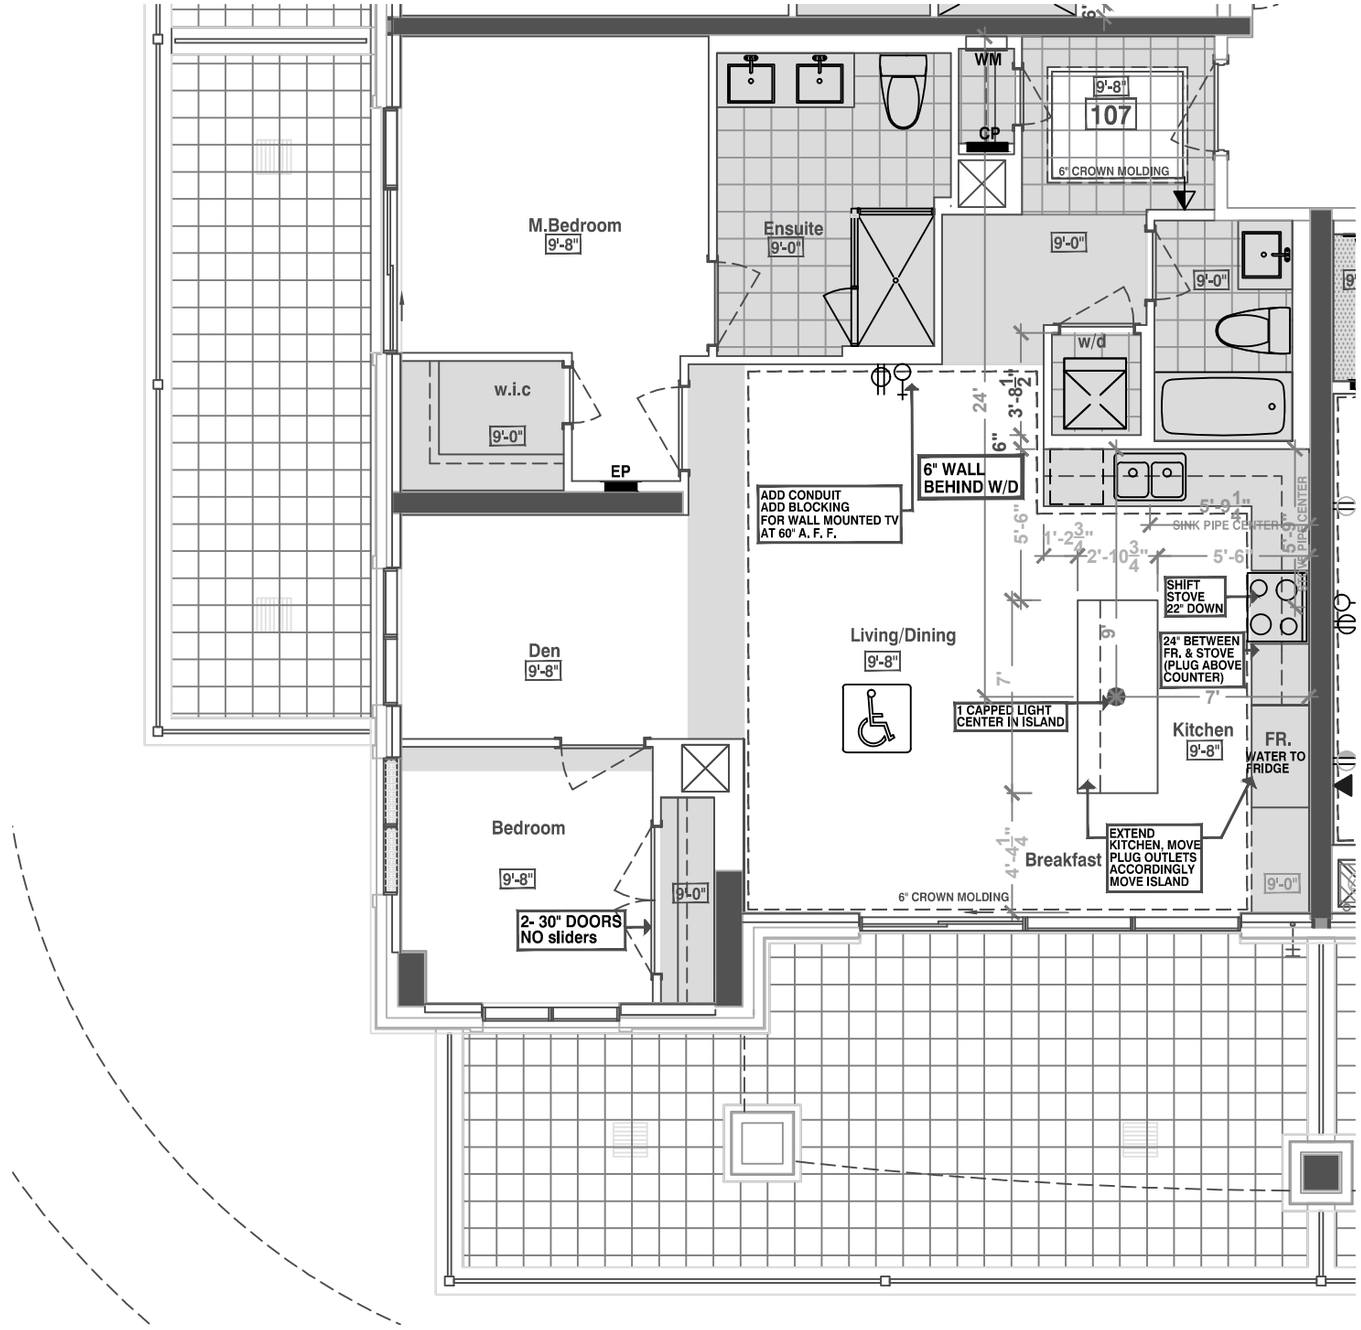

LEGEND:

- SECURITY PANEL
- EP — ELECTRICAL PANEL
- CP — COMMUNICATION PANEL
- WM — WATER METER
- F — FRIDGE
- DROPPED AREA
- 6" CROWN MOLDING
- BARRIER FREE SUITE

SUITE 107 – GLEN COVE – 2H + D – P

■ HAMPTON PLACE ■ 25 Baker Hill Blvd – Stouffville, ON ■ Jan 18, 2018

DRAWING AS PER AGREEMENT OF PURCHASE AND SALE (before decor appointment)