

---

**SITE INSTRUCTION #1R1****Project Name: Hampton Manor (25 Baker Hill Boulevard) - Stouffville****Project Number: 20140490****Vince Staffieri****July 18, 2017****Royal Pine Homes****3550 Langstaff Road, Suite 200****Woodbridge, Ontario L4L 9G3****via email: vince@royalpinehomes.com**

Distribution: Owner [ ]; Contractor [ ]; Consultant A [ ]; M [ ]; E [ ]; L [ ]; Other

- 
1. Site instructions are issued only for the purpose of recording any clarification or interpretation of the contract documents or giving direction on problems resulting from field conditions.
  2. These instructions are subject to the provisions of the contract documents and unless stated herein and specifically co-authorized by the Client, will not affect the contract.
  3. Should the Contractor require a change in the contract price or project schedule, he shall submit an itemized proposal to the Architect within 14 calendar days of the date hereof.
  4. If the proposal is accepted by the Client, this site instruction will be superseded by a Change Order.
- 

Note: this instruction supersedes previously issued SI#1.

**A. REFERENCE:**

- .1 Drawing S1-01.

**B. INSTRUCTION:**

- .1 Revise foundation plan as indicated to include crane pad.

**C. REASON:**

- .1 Coordination.

Yours very truly,  
STEPHENSON ENGINEERING LIMITEDper Mauricio Nieto, MAsc., P.Eng.  
Senior Engineer, Project Manager  
mnieto@stephenson-eng.comper Sandra Cullen, P.Eng.  
Principal  
scullen@stephenson-eng.com

Distribution cc:

|                 |                              |
|-----------------|------------------------------|
| Lenny Simonelli | rexcon.construxion@gmail.com |
| Gino Colangelo  | gcolangelo@gc-architects.com |
| Hrvoje Vukic    | hvukic@stephenson-eng.com    |



|   |             |                                     |
|---|-------------|-------------------------------------|
| 1 | MAR 18 2016 | ISSUED FOR TENDER                   |
| 2 | DEC 28 2016 | ISSUED FOR BUILDING PERMIT          |
| 3 | MAY 03 2017 | ISSUED FOR FOUNDATION PERMIT        |
| 4 | JUN 15 2017 | STRUCTURAL APPROVAL #1              |
| 5 | JUN 19 2017 | COORDINATION                        |
| 6 | JUL 07 2017 | IFC - BELOW GRADE LEVEL             |
| 7 | JUL 11 2017 | IFC - BELOW GRADE LEVEL (RE-ISSUED) |
| 8 | JUL 18 2017 | ISSUED FOR SITE INSTRUCTION #1      |
| 9 | JUL 18 2017 | ISSUED FOR SITE INSTRUCTION #1-R1   |

**stephenson**  
ENGINEERING

2550 Victoria Park Ave., Suite 602  
Toronto ON M2J 5A9 | Tel: (416) 435 9970  
[www.stephenson-eng.com](http://www.stephenson-eng.com) | [info@stephenson-eng.com](mailto:info@stephenson-eng.com)

PROPOSED RESIDENTIAL DEVELOPMENT

25 BAKER HILL BLVD.


STOUFFVILLE ROYAL PINES HOMES ONTARIO

|            |               |
|------------|---------------|
| Down By    | RS            |
| Checked By | NH/PZ/AS      |
| Plot Date: | DECEMBER 2016 |
| Job #      | 20140490      |

## FOUNDATION PLAN

AS  
invariant

S1-01

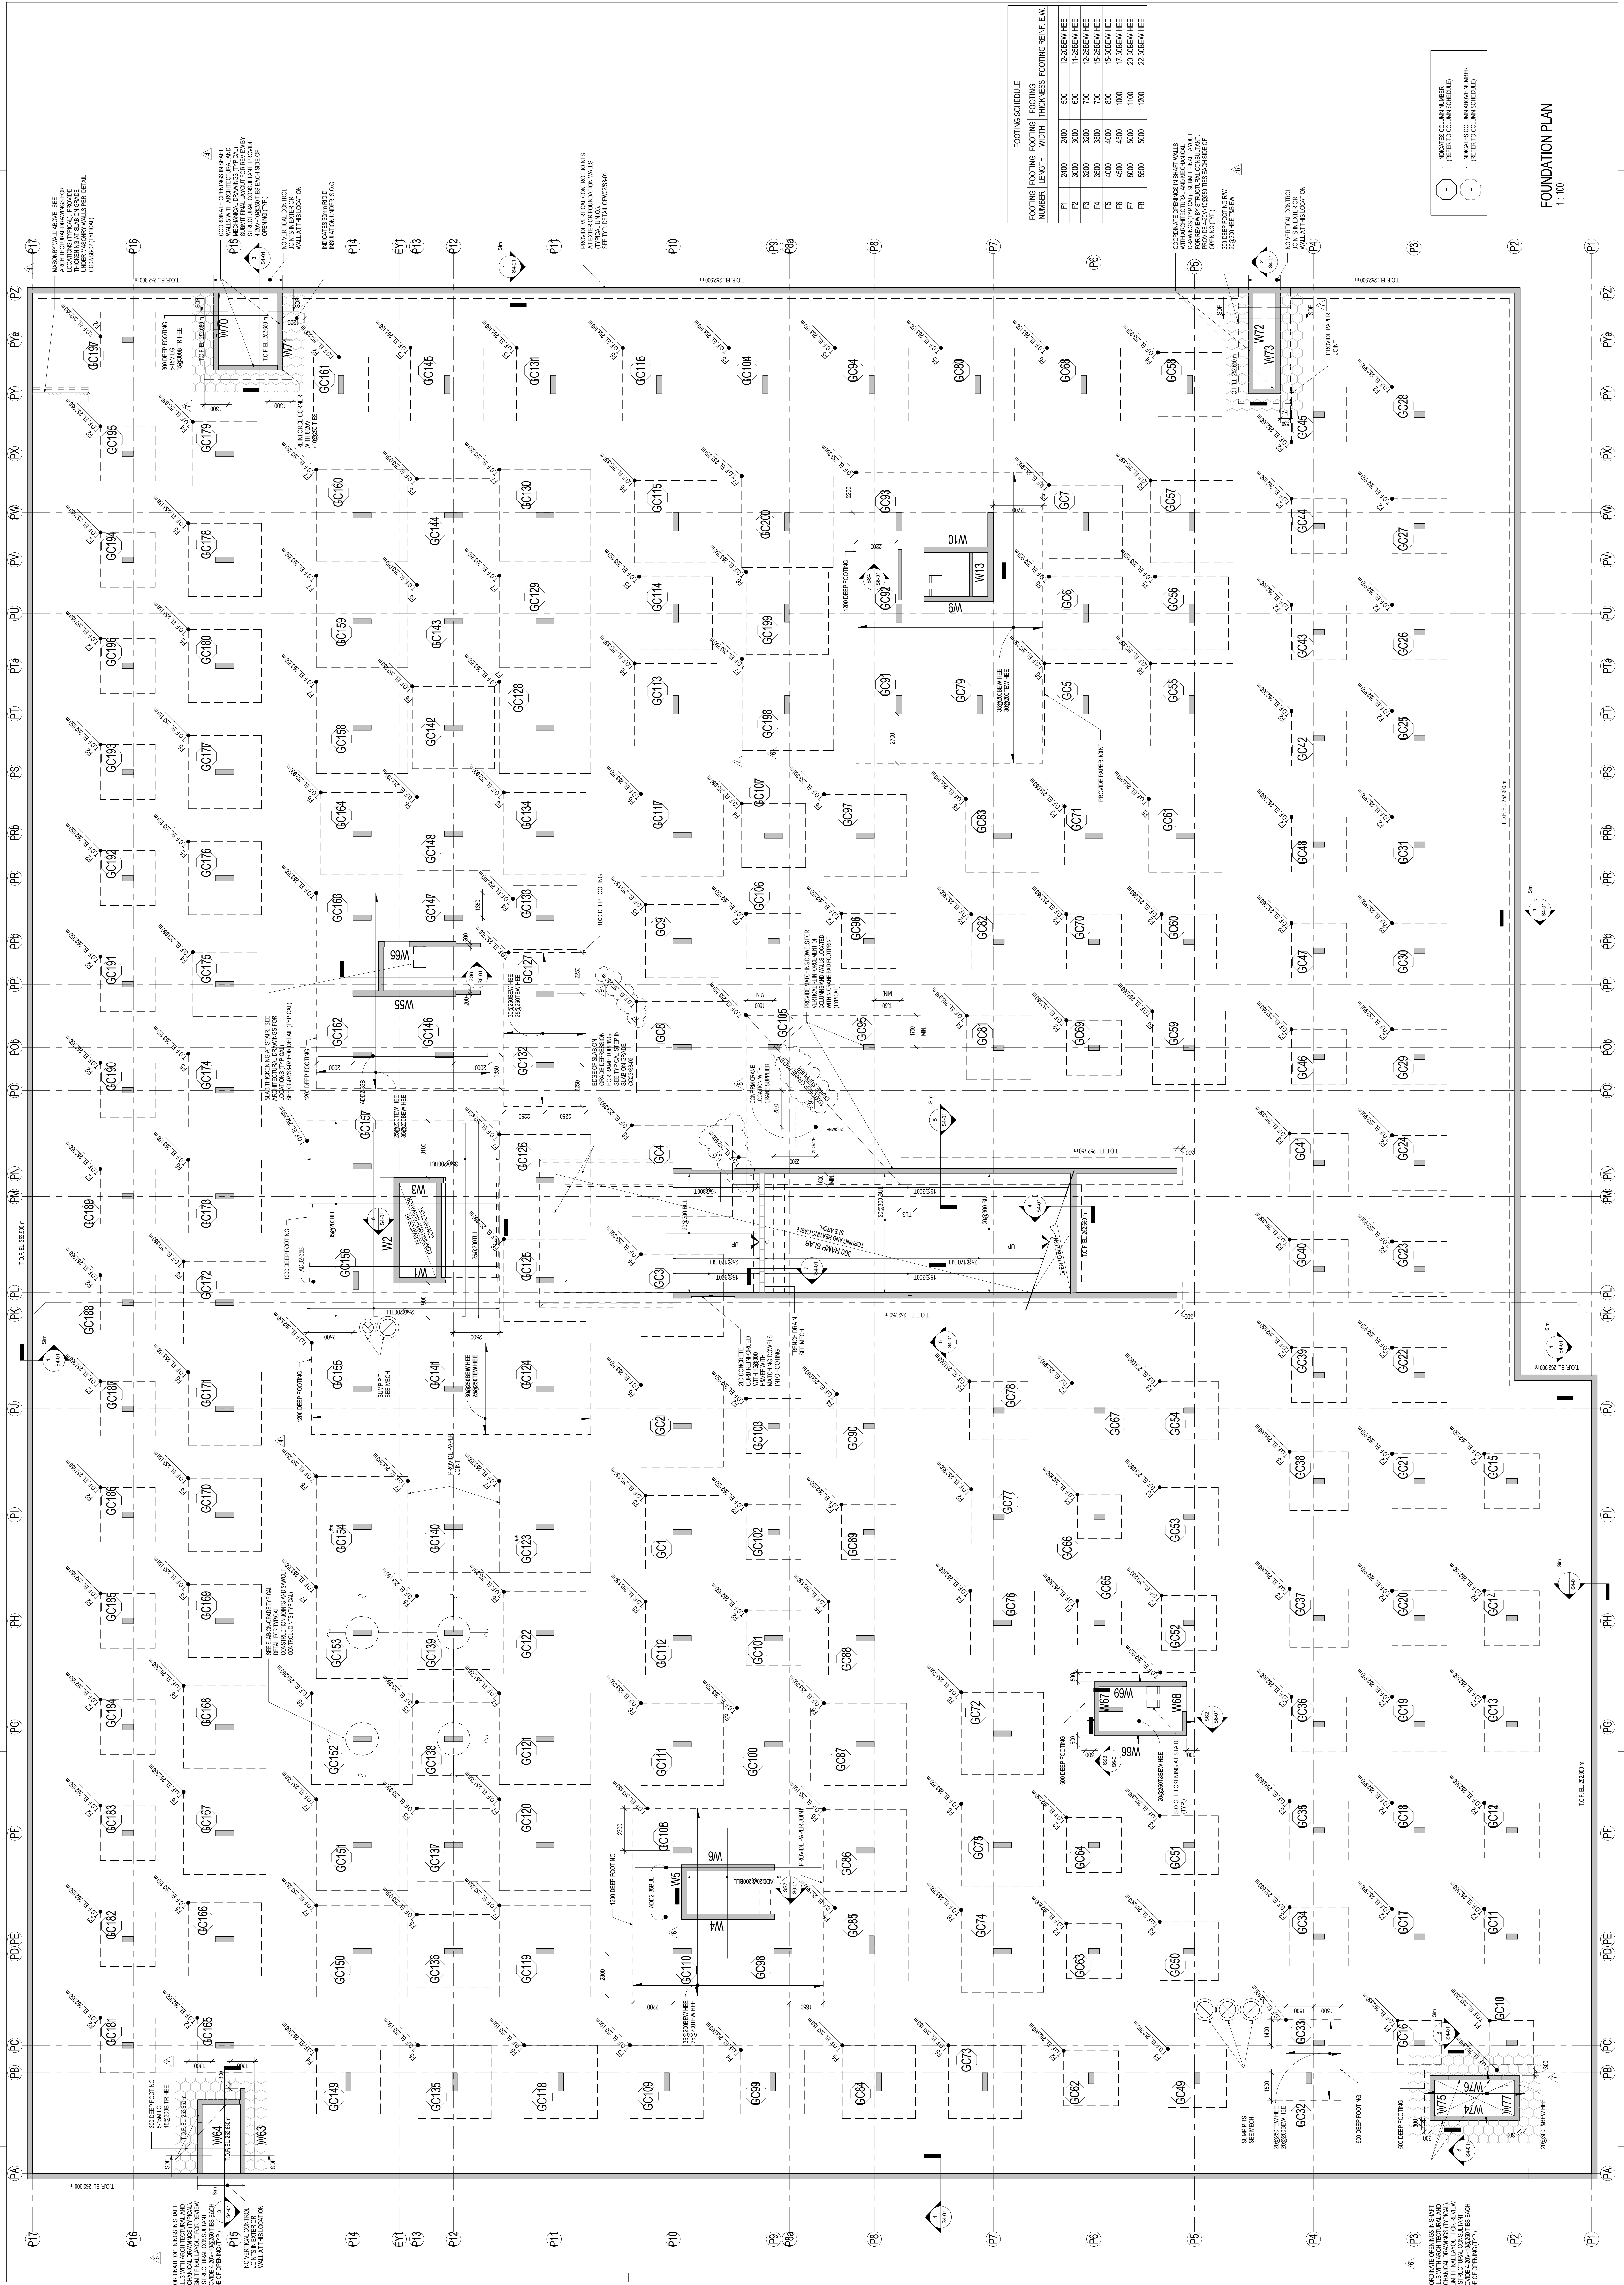

FOUNDATION PLAN  
1 : 100