
SITE INSTRUCTION #7**Project Name: Hampton Manor (25 Baker Hill Boulevard) - Stouffville****Project Number: 20140490****Vince Staffieri****December 21, 2017****Royal Pine Homes****3550 Langstaff Road, Suite 200****Woodbridge, Ontario L4L 9G3****via email: vince@royalpinehomes.com**

Distribution: Owner []; Contractor []; Consultant A []; M []; E []; L []; Other

-
1. Site instructions are issued only for the purpose of recording any clarification or interpretation of the contract documents or giving direction on problems resulting from field conditions.
 2. These instructions are subject to the provisions of the contract documents and unless stated herein and specifically co-authorized by the Client, will not affect the contract.
 3. Should the Contractor require a change in the contract price or project schedule, he shall submit an itemized proposal to the Architect within 14 calendar days of the date hereof.
 4. If the proposal is accepted by the Client, this site instruction will be superseded by a Change Order.
-

A. REFERENCE:

- .1 Drawings S5-01

B. INSTRUCTION:

- .1 Extend existing midlanding for stair C (P1 level to Ground floor level) between gridlines PPb-PP and P12-P13. Cut existing slab on grade below and provide 200x600mm new reinforced concrete column to support additional loading from extended midlanding.

C. REASON:

- .1 Forming contractor's request.

Yours very truly,
STEPHENSON ENGINEERING LIMITED

per Mauricio Nieto

Mauricio Nieto, MAsC., P.Eng.
Senior Engineer, Project Manager
mnieto@stephenson-eng.com


per S Cullen

Saundra Cullen, P.Eng.
Principal
scullen@stephenson-eng.com

Distribution cc:

Jeffrey Ellis	jellis@dineen.com
Gino Colangelo	gcolangelo@gc-architects.com
Carmen Taranu	CTaranu@gc-architects.com
Shari Grant	SGrant@gc-architects.com
Mrvoje Vukic	hvukic@stephenson-eng.com

1	MAR 18 2016	ISSUED FOR TENDER
2	DEC 28 2016	ISSUED FOR BUILDING PERMIT
3	MAY 09 2017	ISSUED FOR FOUNDATION PERMIT
4	JUN 15 2017	STRUCTURAL ADDENDUM #1
5	JUL 07 2017	IFC - BELOW GRADE LEVELS
6	JUL 19 2017	IFC - ABOVE GRADE LEVELS
15	DEC 14 2017	ISSUED FOR SITE INSTRUCTION #7

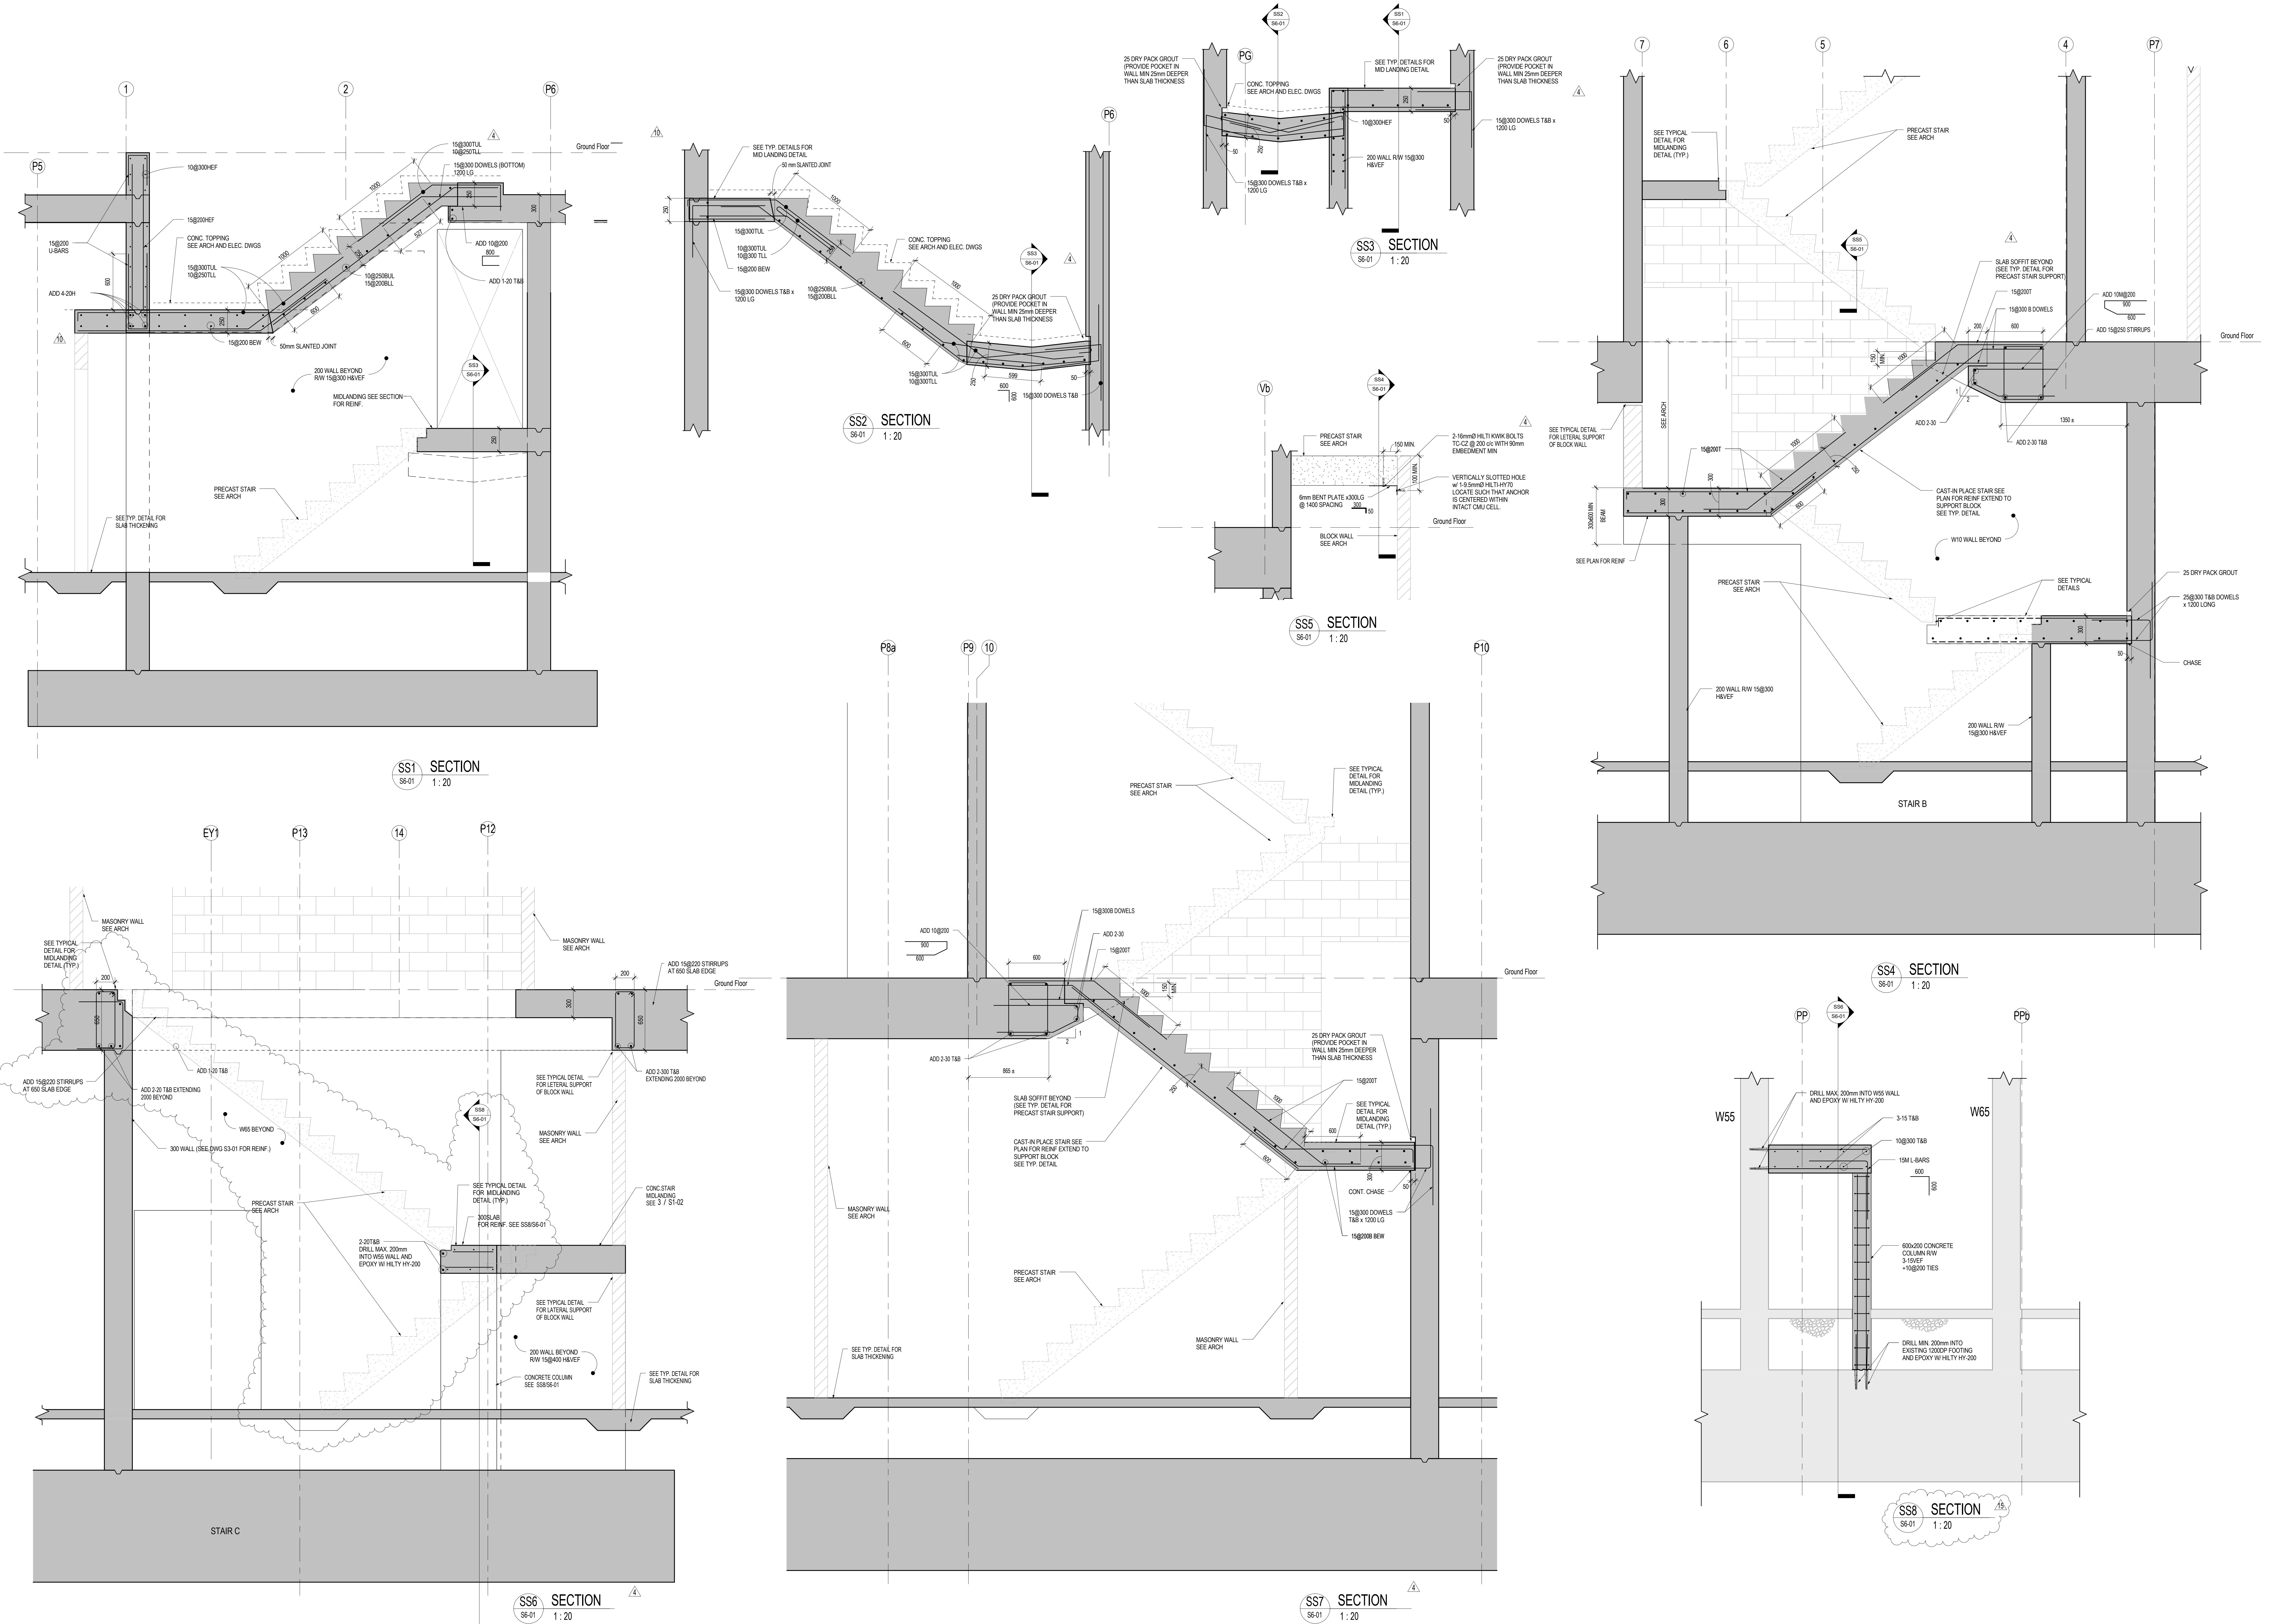

stephenson
ENGINEERING

2550 Victoria Park Ave., Suite 402
Toronto, ON M2G 6A7 | Tel: 416.416.5599
www.stephenson-eng.com | info@stephenson-eng.com

PROPOSED RESIDENTIAL DEVELOPMENT

25 BAKER HILL BLVD.

ROYAL PINES HOMES

STOUFFVILLE ONTARIO

Drawn By: RS

Checked By: NH/PZ/AS

Plot Date: DECEMBER 2016

Job #: 20140490